


SAFCO PRODUCTS • NEW HOPE, MINNESOTA
REPORT BY PART NUMBER 8552
SAFCO PRODUCTS • NEW HOPE, MINNESOTA
REPORT BY PART NUMBER 8552
SAFCO PRODUCTS • NEW HOPE, MINNESOTA
REPORT BY PART NUMBER 8552
SAFCO PRODUCTS • NEW HOPE, MINNESOTA
REPORT BY PART NUMBER 8552

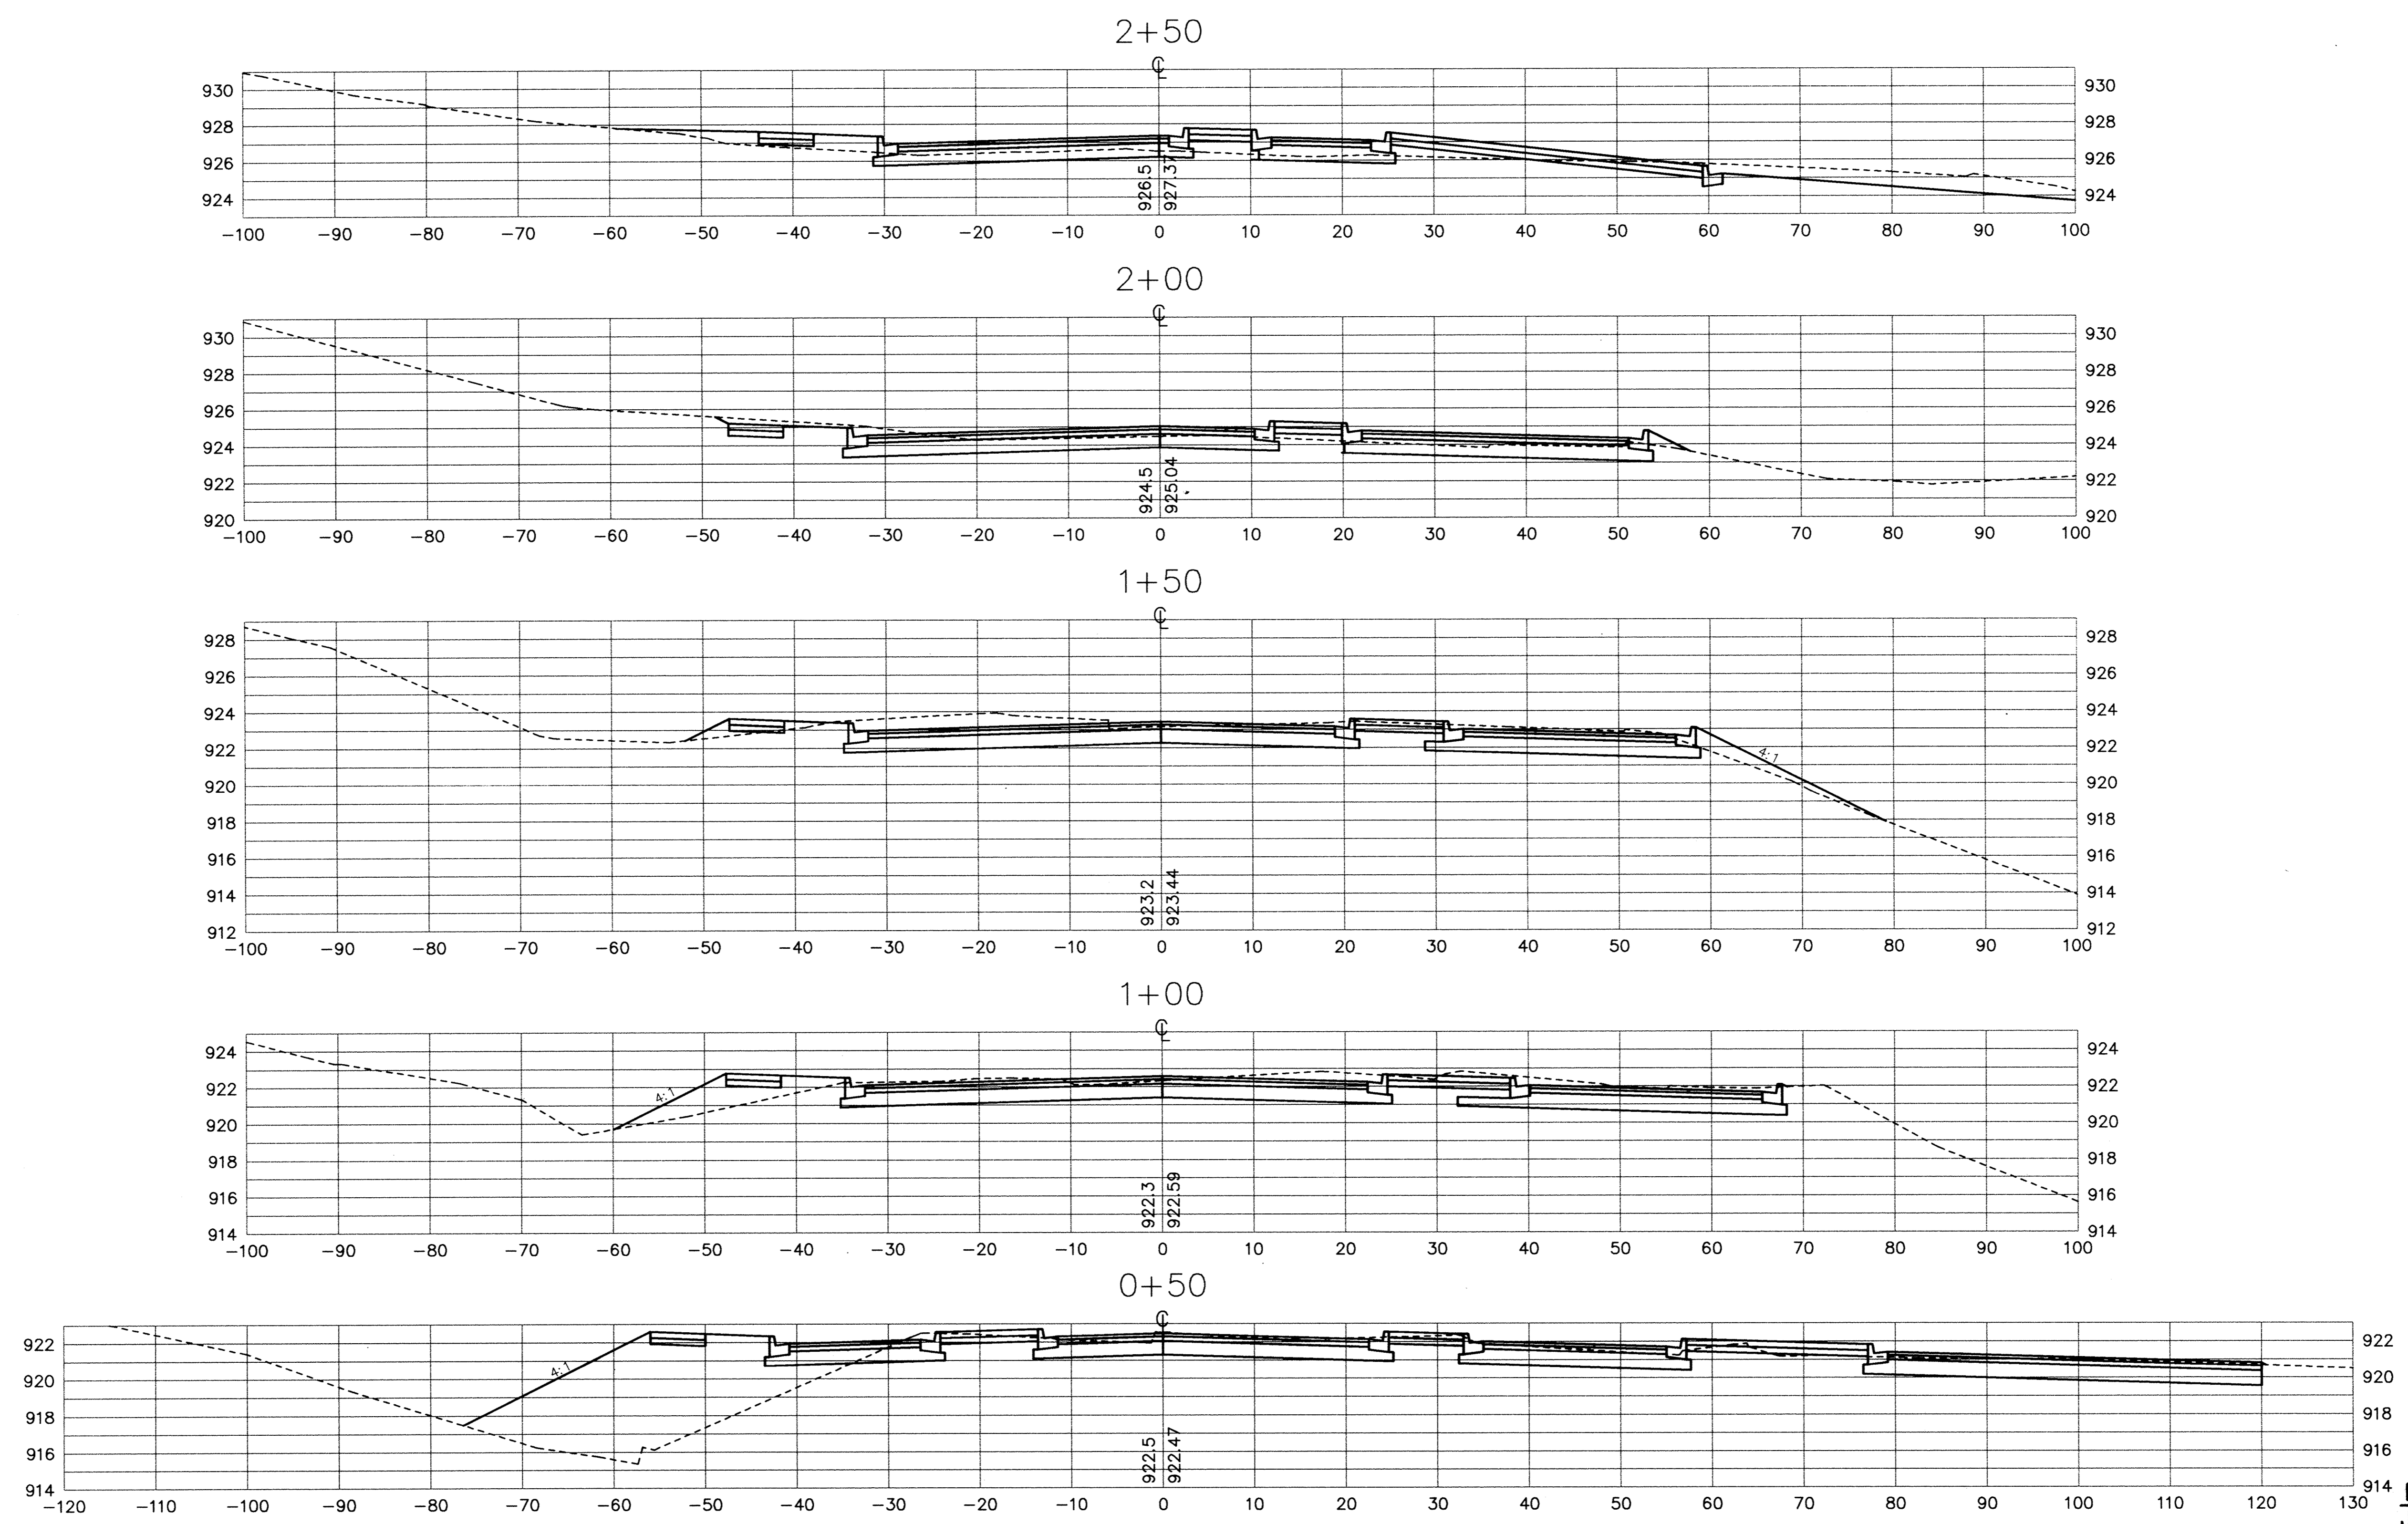

RECORD PLAN
JANUARY 1996

I HEREBY CERTIFY THAT THIS PLAN, SPECIFICATION, OR REPORT WAS PREPARED BY ME OR UNDER MY DIRECT SUPERVISION AND THAT I AM A DULY REGISTERED PROFESSIONAL ENGINEER UNDER THE LAWS OF THE STATE OF MINNESOTA. <i>Cynthia J. Blomah</i> DATE <u>7/3/95</u> REG. NO. <u>24082</u>		1326 ENERGY PARK DRIVE ST. PAUL, MINNESOTA 55108 (612) 644-4389	5075 WAYZATA BLVD. SUITE #225 MINNEAPOLIS, MINNESOTA 55416 (612) 546-0432	DATE _____ DESCRIPTION _____ DESIGNED _____ CHECKED <i>[Signature]</i> DRAWN _____ GRAPHIC SCALE 0 _____ 10 0 VERT. _____ 5	CITY OF ELK RIVER ELK HILLS DRIVE/DODGE STREET IMPROVEMENTS ELK HILLS DRIVE CROSS SECTIONS	0+50 TO 2+50
		REVISIONS _____ _____ _____	DATE JULY 1995 SHEET 12 OF 22 SHEETS PROJECT NO. 230-246			
		879 <i>[Signature]</i>				