
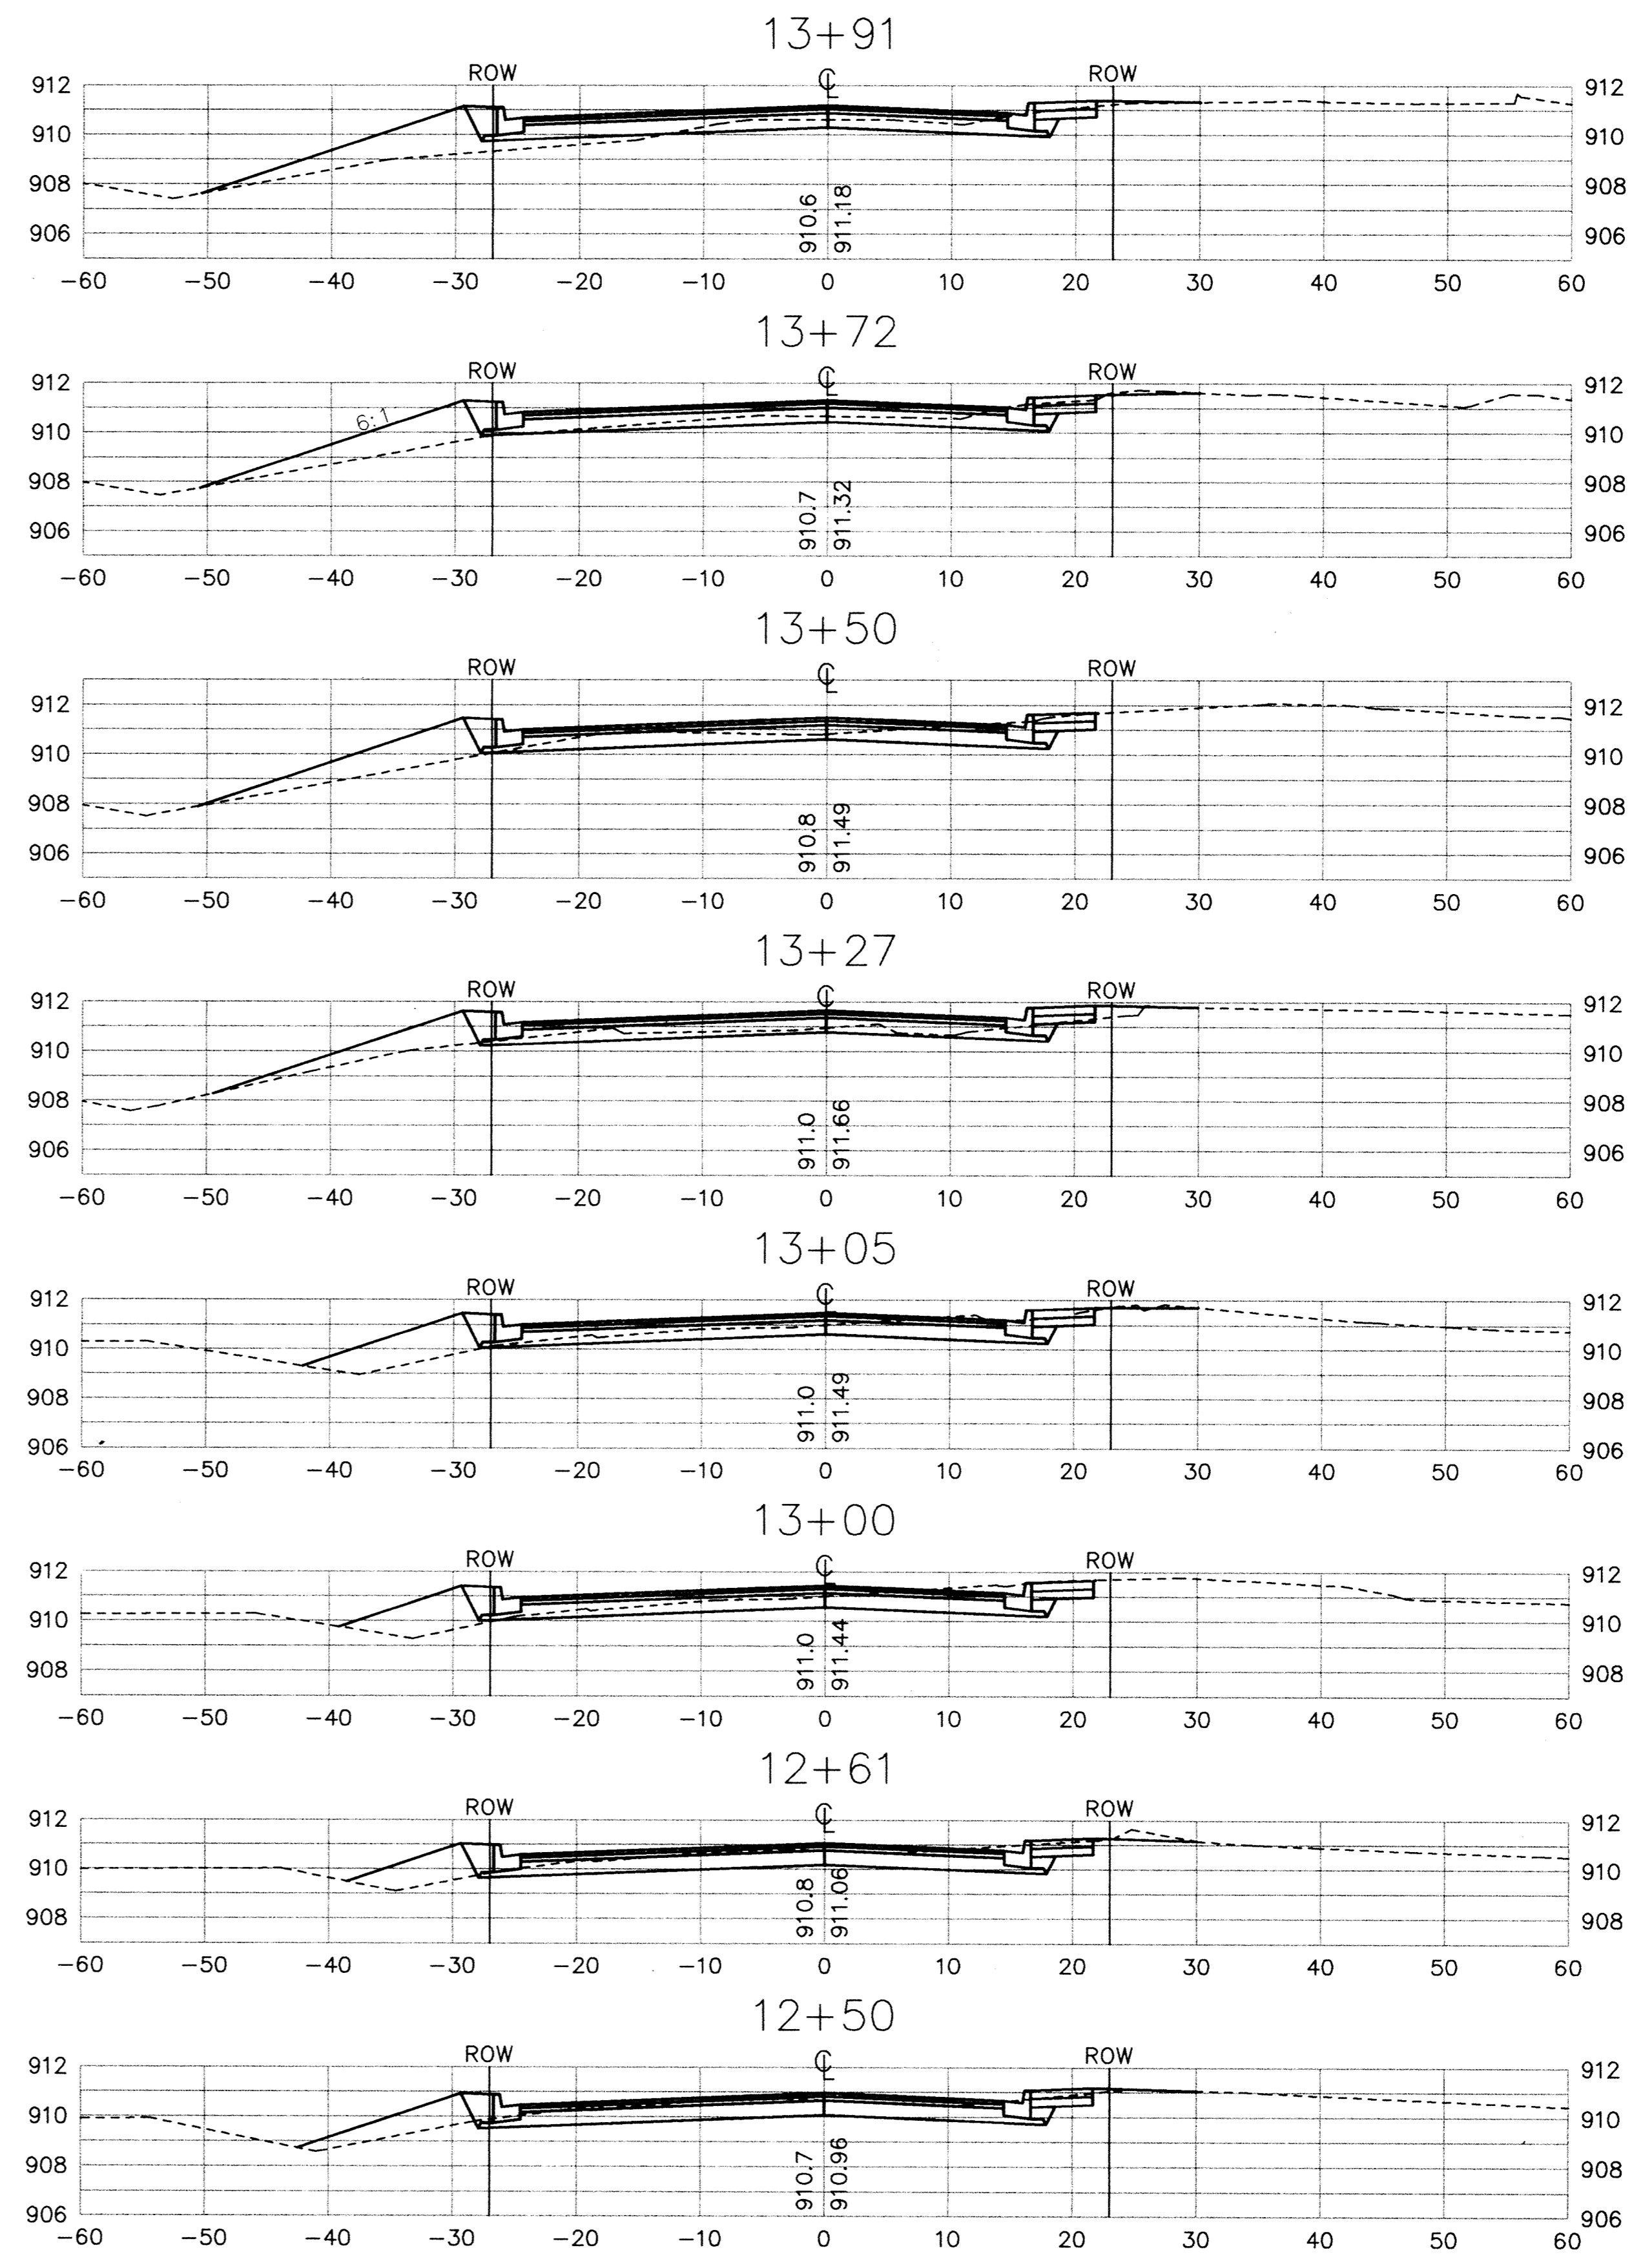


SAFCO PRODUCTS • NEW HOPE, MINNESOTA  
REVISION BY PART NUMBER 6502  
SAFCO PRODUCTS • NEW HOPE, MINNESOTA  
REVISION BY PART NUMBER 6502  
SAFCO PRODUCTS • NEW HOPE, MINNESOTA  
REVISION BY PART NUMBER 6502

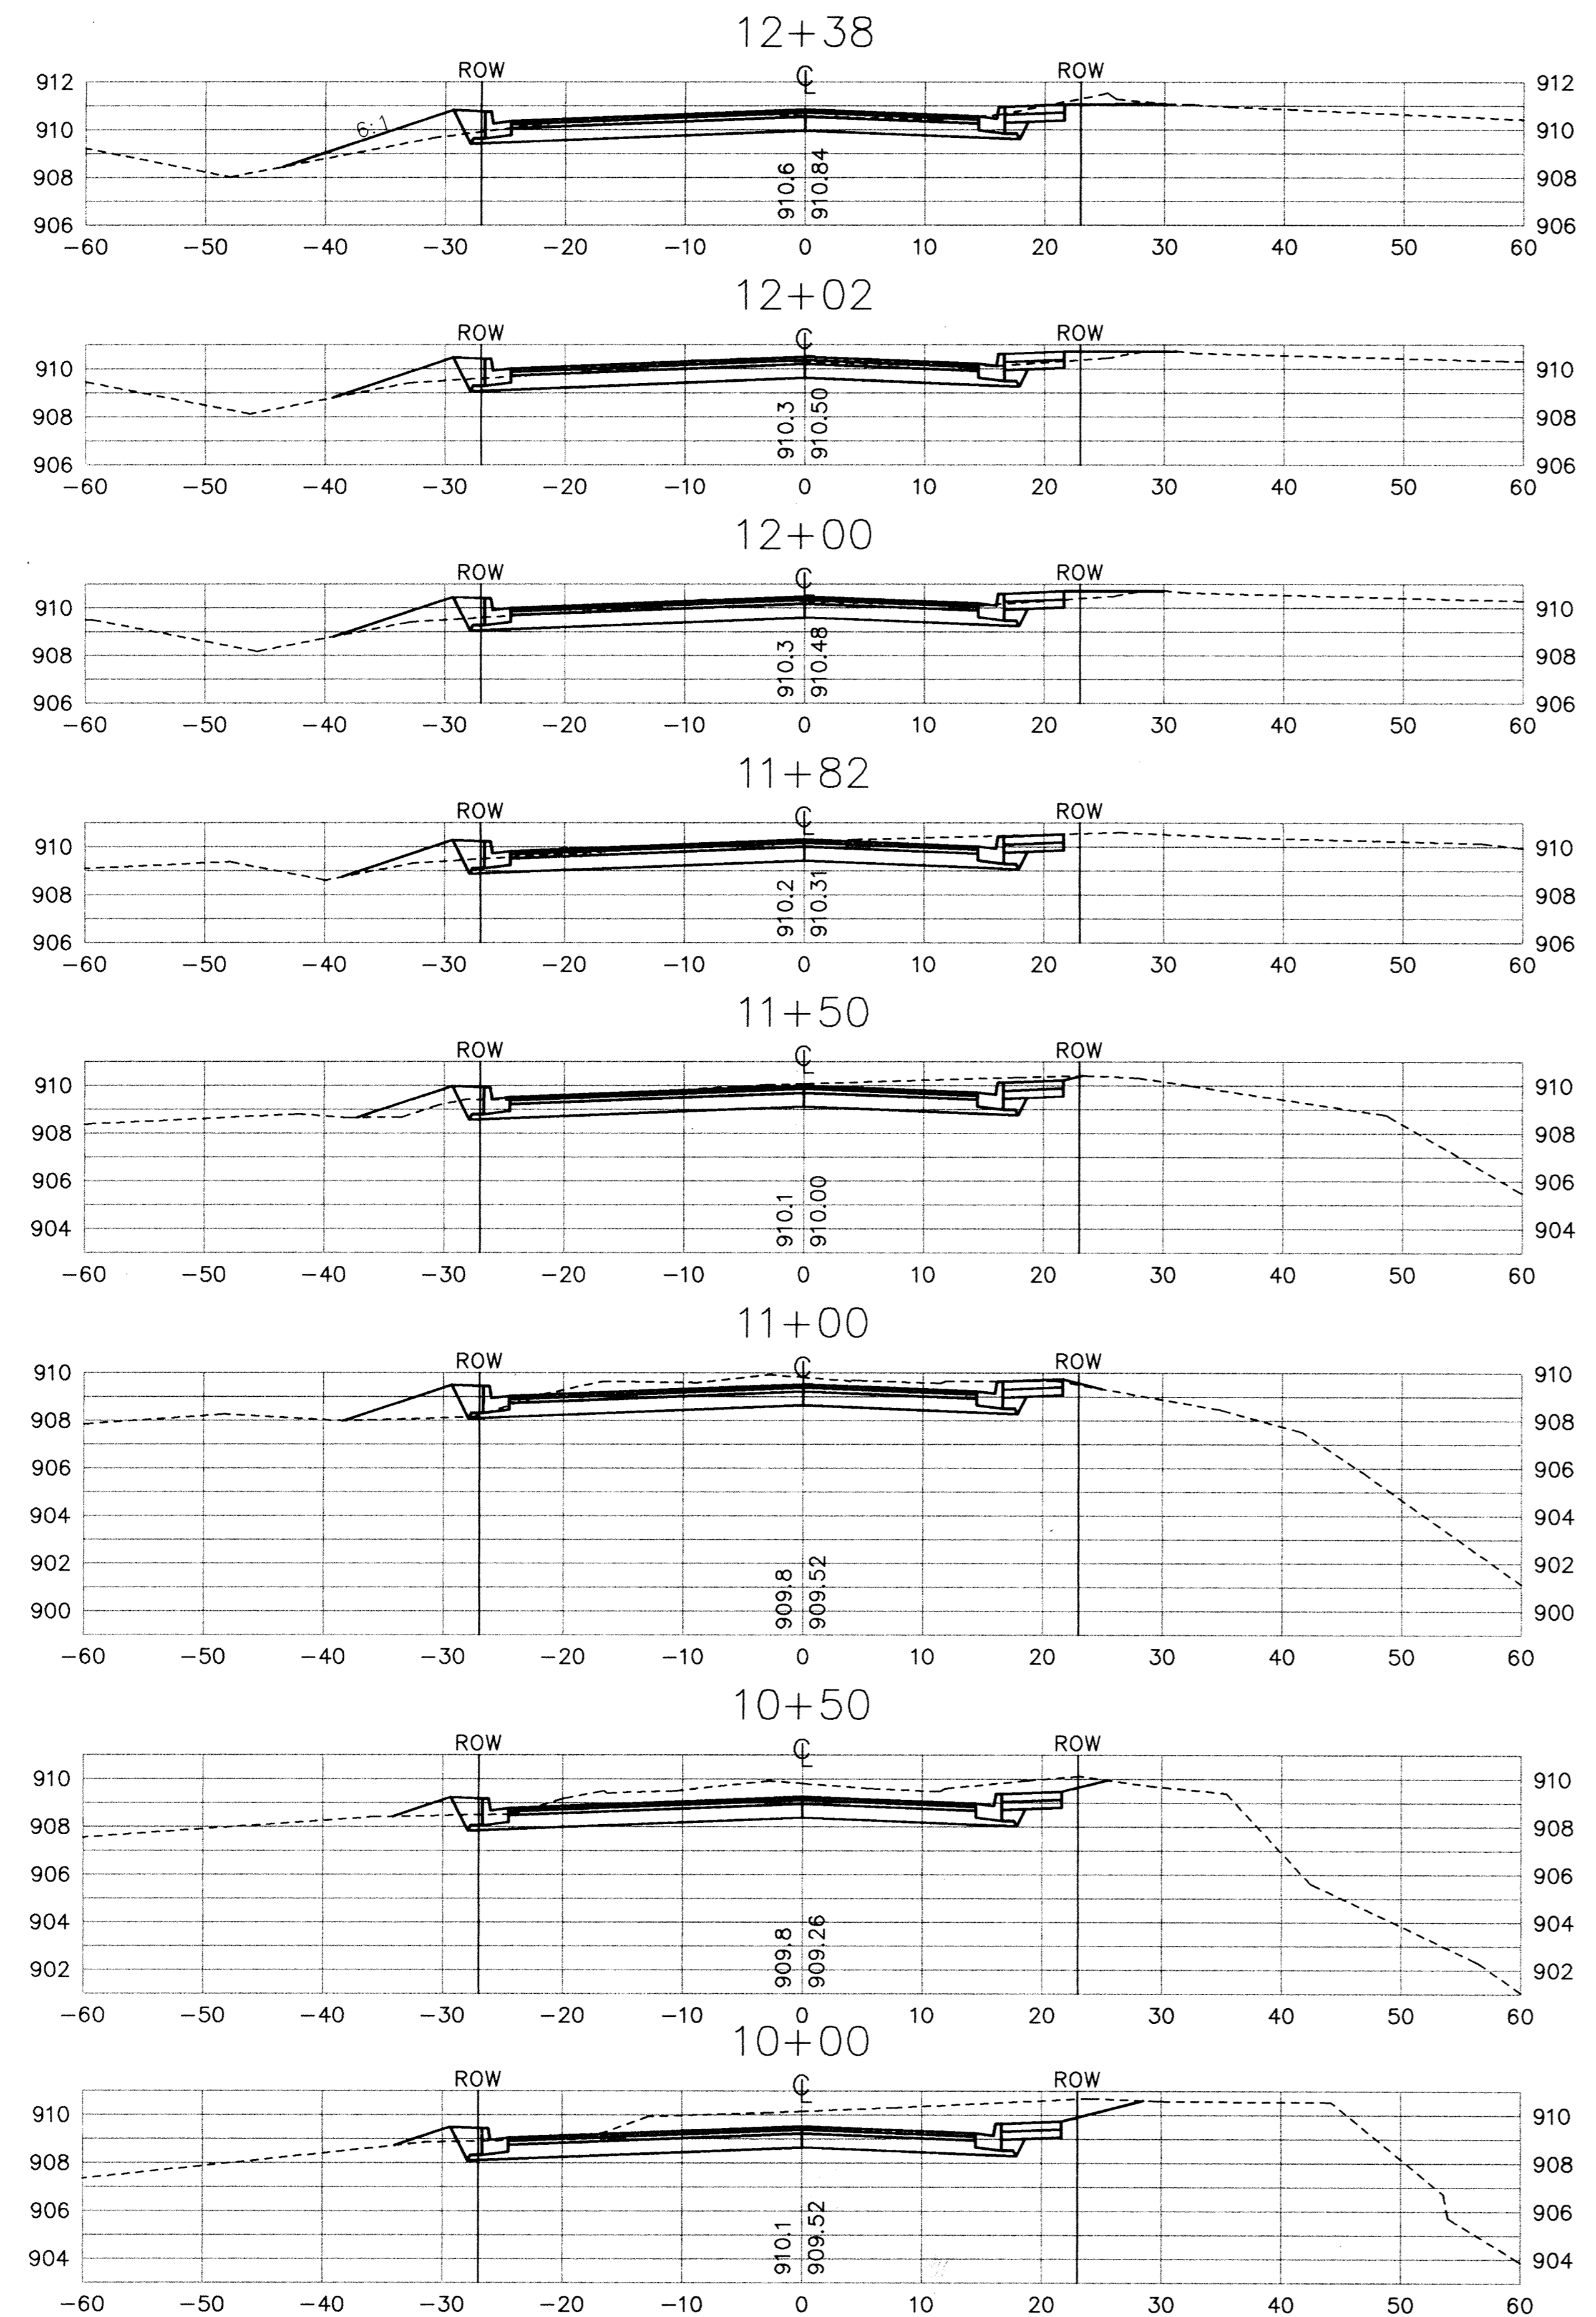

RECORD PLAN  
JANUARY 1996

CITY OF ELK RIVER  
ELK HILLS DRIVE/DODGE STREET IMPROVEMENTS  
DODGE STREET  
CROSS SECTIONS  
CHANGE ORDER NO. 1  
10+00 to 13+91  
DATE SEPT 1995 SHEET 15A OF 22 SHEETS PROJECT NO. 230-246

DATE	DESCRIPTION	DESIGNED	CHECKED	DRAWN
9-27-95	CHANGE ORDER NO. 2	JL	JL	JL
REVISIONS		GRAPHIC SCALE 0 10 VERT. 5		

1326 ENERGY PARK DRIVE  
ST. PAUL, MINNESOTA 55108  
(612) 644-4389  
5075 WAYZATA BLVD. SUITE #225  
MINNEAPOLIS, MINNESOTA 55416  
(612) 546-0432



I HEREBY CERTIFY THAT THIS PLAN, SPECIFICATION, OR REPORT WAS PREPARED BY ME OR UNDER MY DIRECT SUPERVISION AND THAT I AM A DULY REGISTERED PROFESSIONAL ENGINEER UNDER THE LAWS OF THE STATE OF MINNESOTA.  
*Cynthia J. Blameli*  
DATE 9-29-95 REG. NO. 24082