



SAFCO PRODUCTS • NEW HOPE, MINNESOTA
REORDER BY PART NUMBER 8552
SAFCO PRODUCTS • NEW HOPE, MINNESOTA
REORDER BY PART NUMBER 8552
SAFCO PRODUCTS • NEW HOPE, MINNESOTA
REORDER BY PART NUMBER 8552
SAFCO PRODUCTS • NEW HOPE, MINNESOTA
REORDER BY PART NUMBER 8552

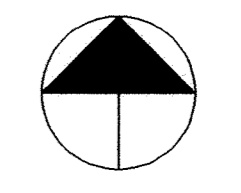

0 300
SCALE: 1" = 300'

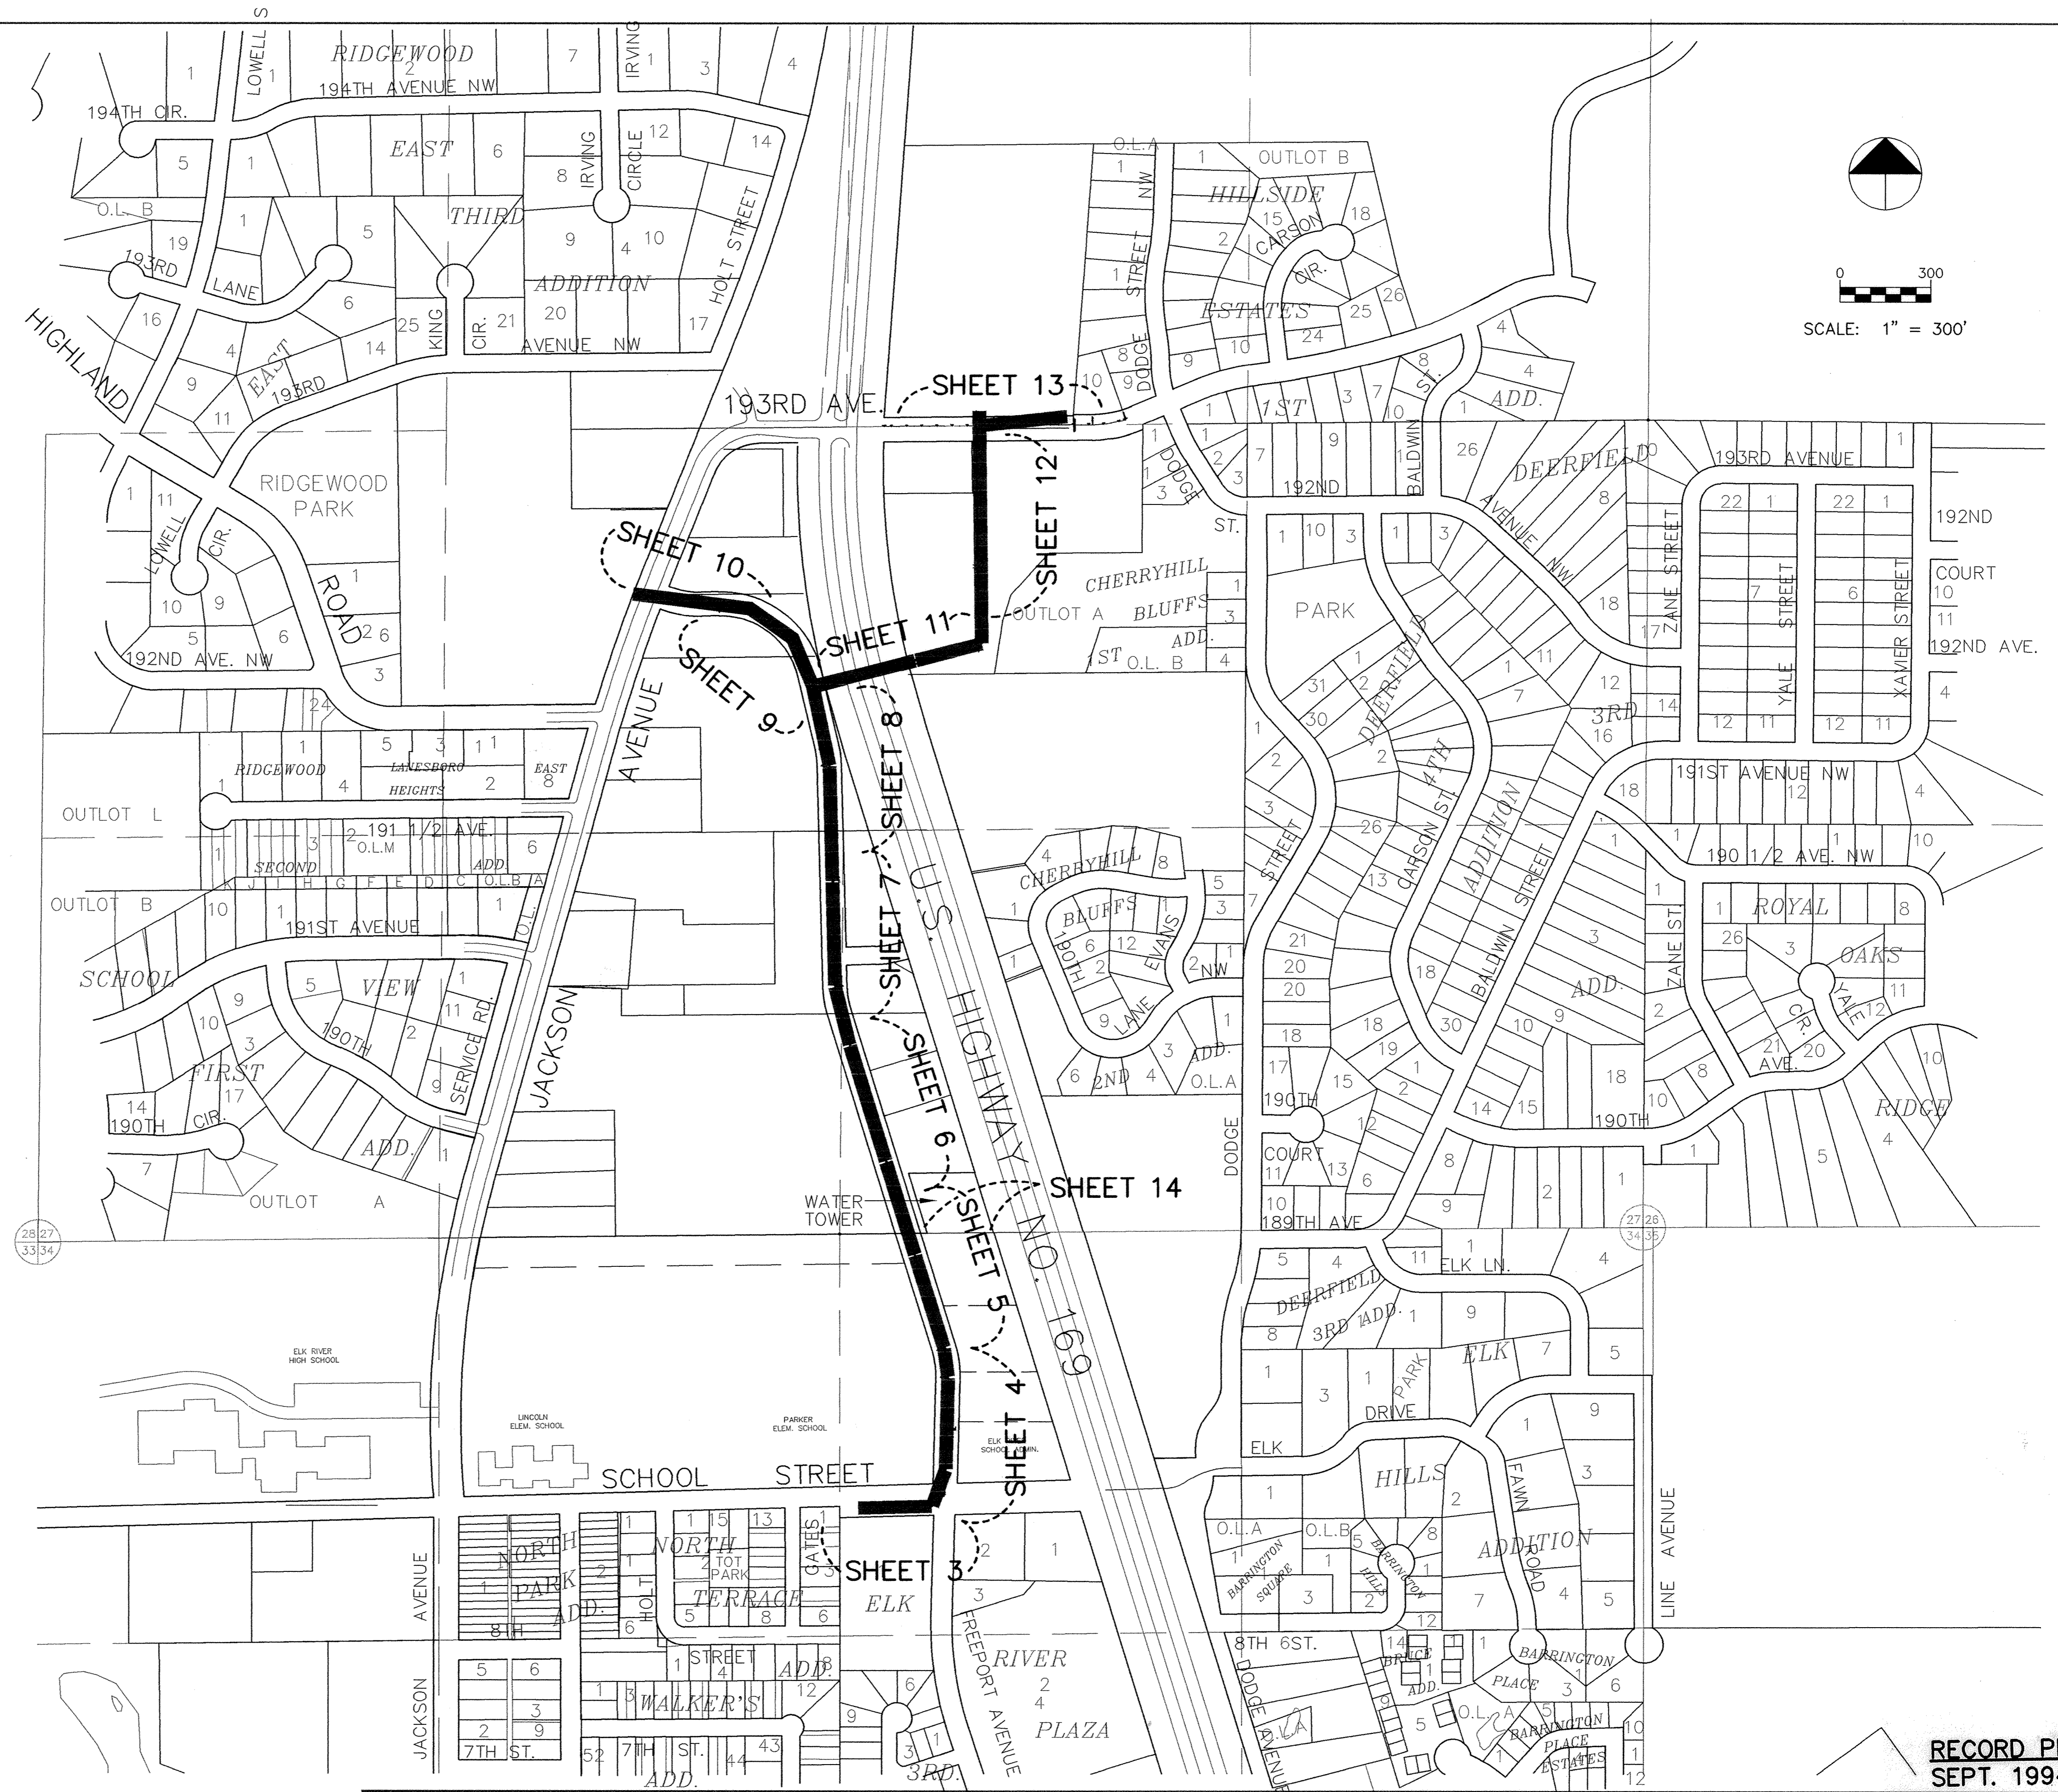

RECORD PLAN
SEPT. 1994

CITY OF ELK RIVER
ELK PARK CENTER
INDEX MAP

DATE MARCH 1994 SHEET 2 OF 17 SHEETS PROJECT NO. 230-215

DATE	DESCRIPTION	DESIGNED PER
		CHECKED SDG
		DRAWN CLS
GRAPHIC SCALE		
0 HORIZ.		
0 VERT.		

1326 ENERGY PARK DRIVE
ST. PAUL, MINNESOTA 55108
(612) 644-4389

9800 SHELDAR PARKWAY
MINNEAPOLIS, MINNESOTA 55441
(612) 546-0432



I HEREBY CERTIFY THAT THIS PLAN, SPECIFICATION, OR REPORT WAS PREPARED BY ME OR UNDER MY DIRECT SUPERVISION AND THAT I AM A DULY REGISTERED PROFESSIONAL ENGINEER UNDER THE LAWS OF THE STATE OF MINNESOTA.

Paul Bretzel
DATE 3-28-94 REG. NO. 13929

862 708 [Signature]