

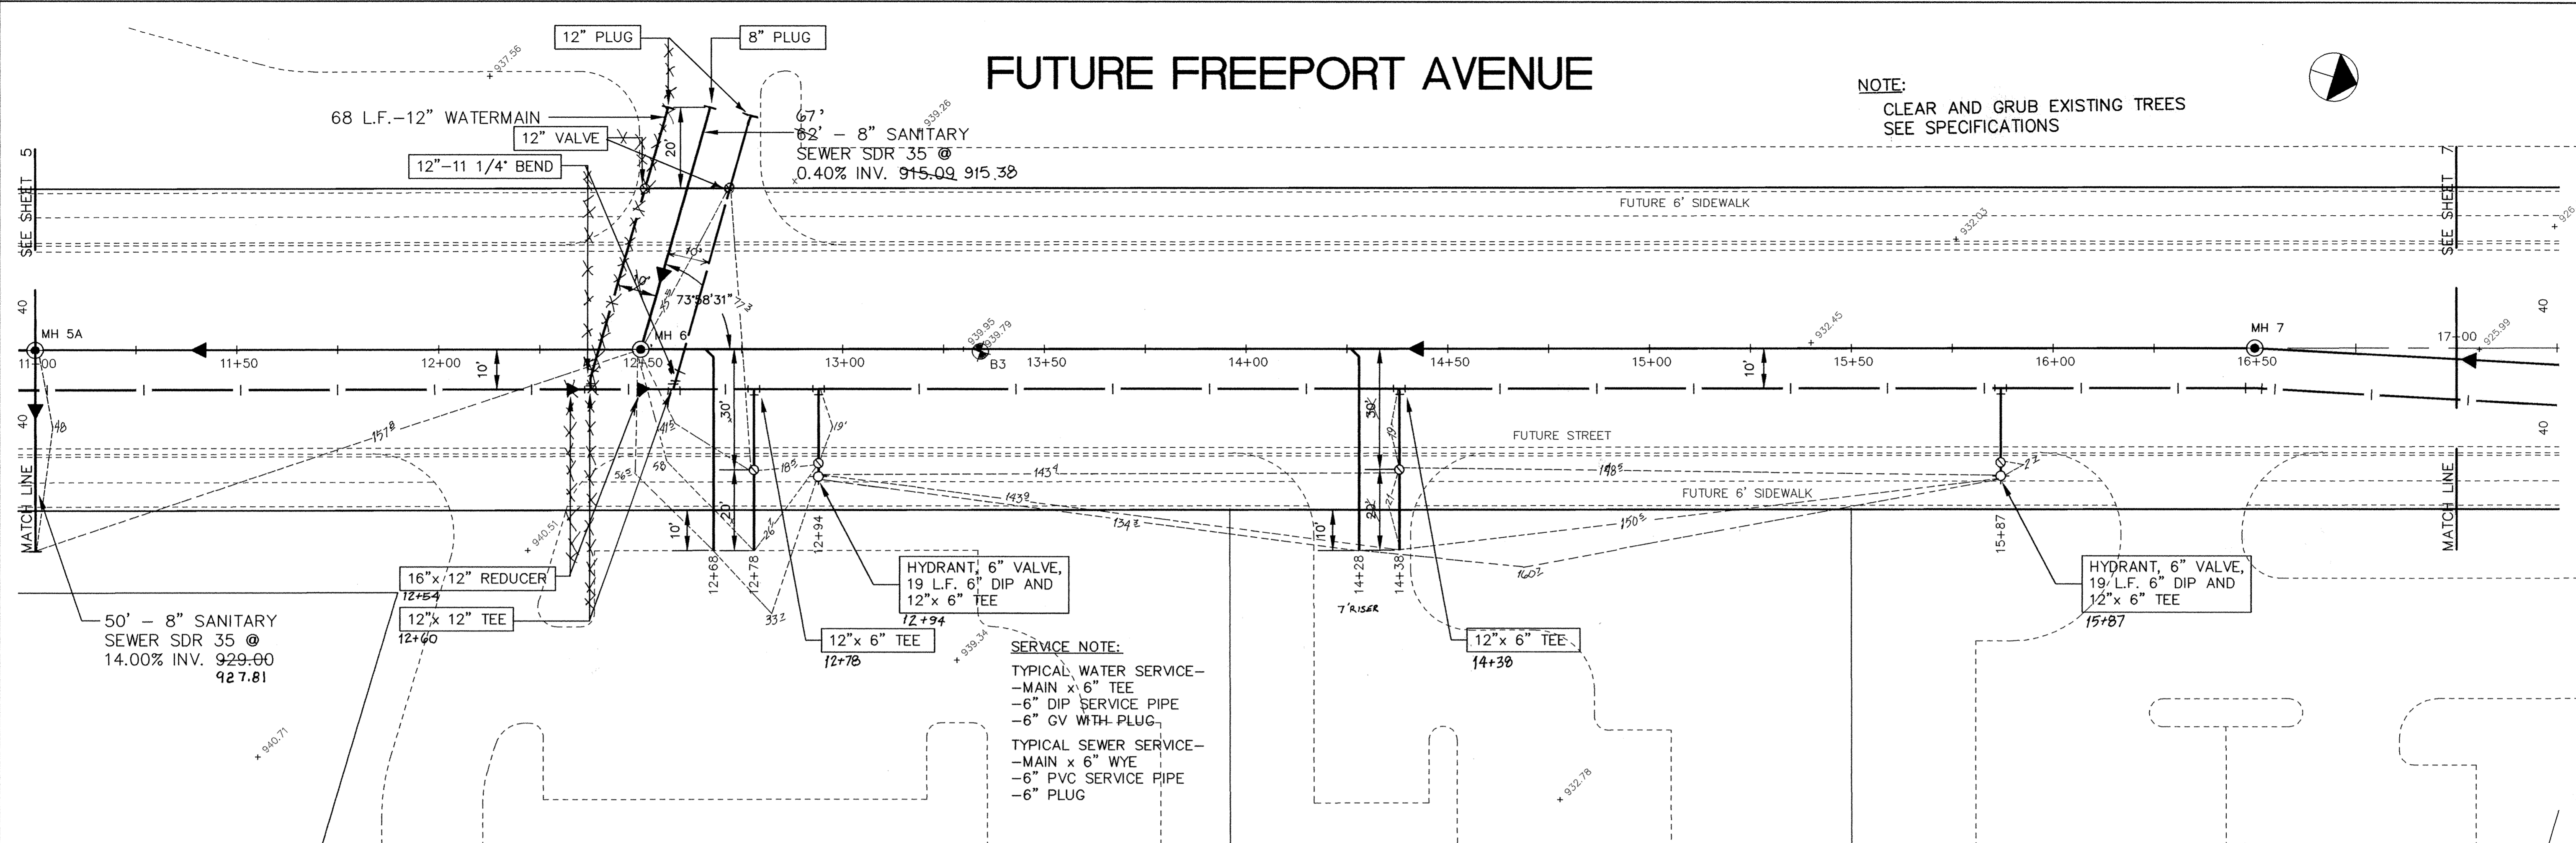


FUTURE FREEPORT AVENUE

NOTE:
CLEAR AND GRUB EXISTING TREES
SEE SPECIFICATIONS

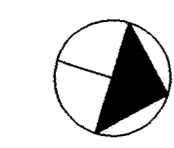

SERVICE NOTE:
TYPICAL WATER SERVICE—
—MAIN x 6" TEE
—6" DIP SERVICE PIPE
—6" GV WITH PLUG
TYPICAL SEWER SERVICE—
—MAIN x 6" WYE
—6" PVC SERVICE PIPE
—6" PLUG

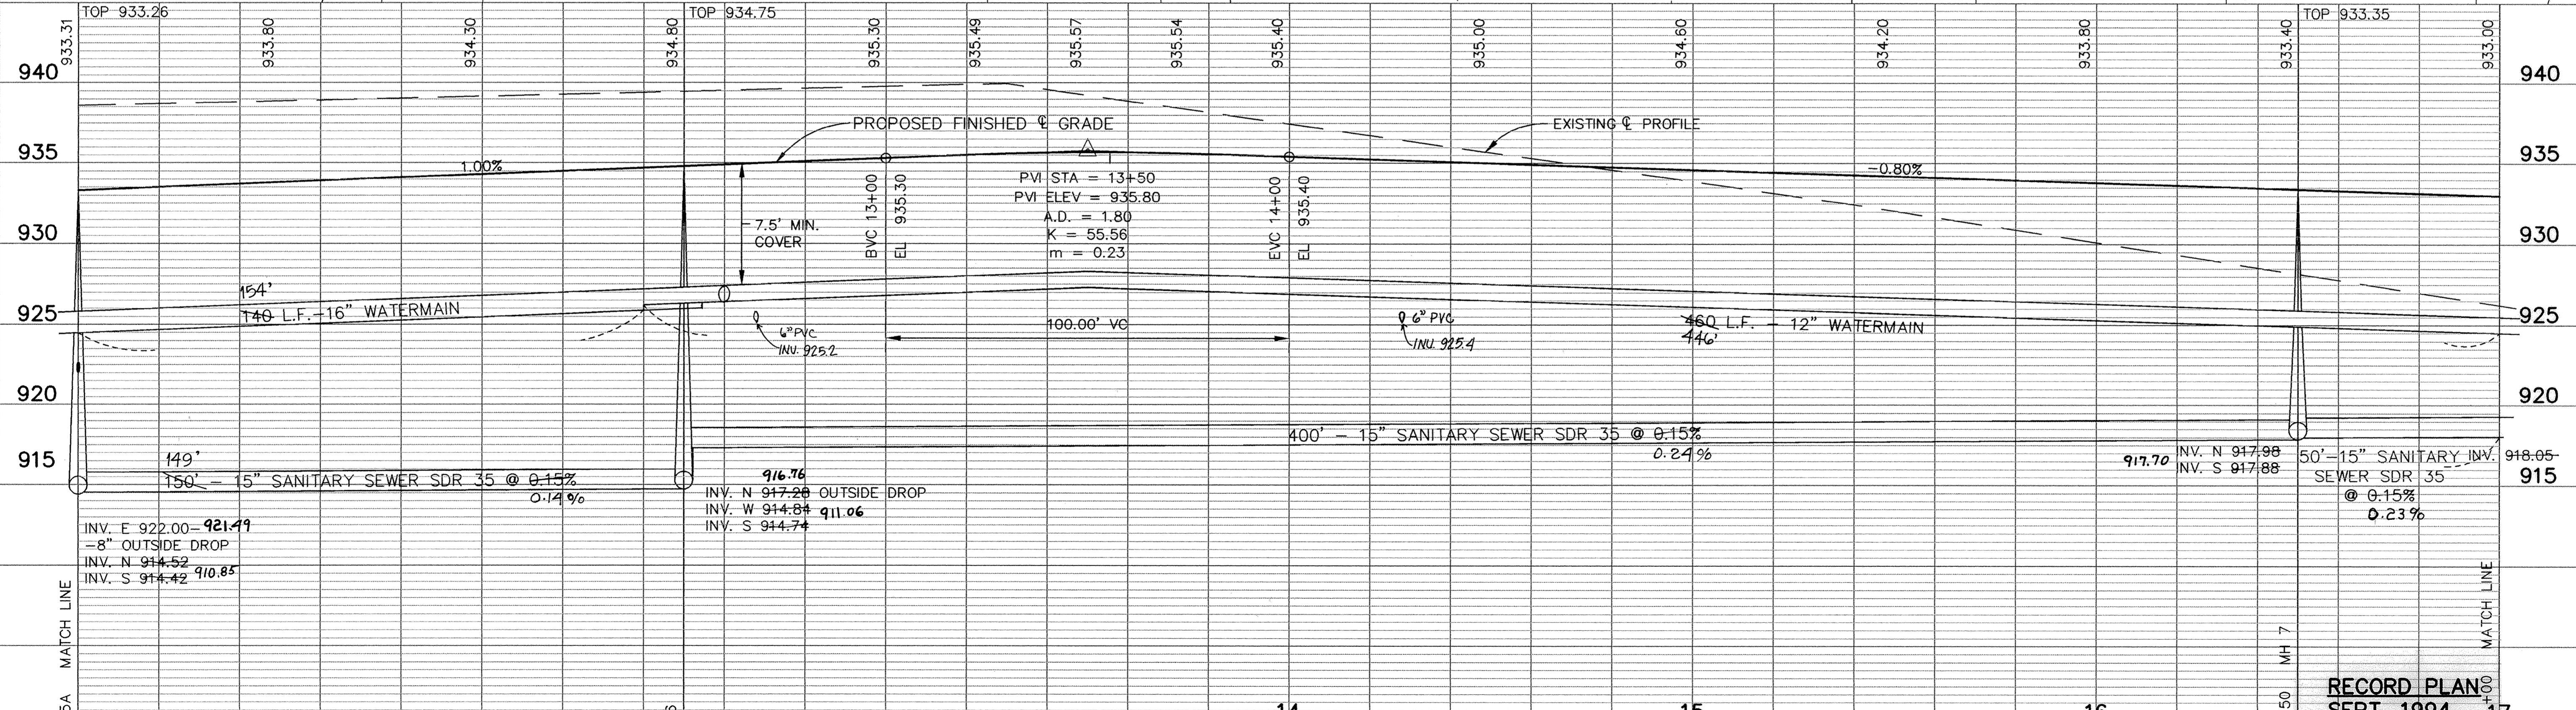

ER215-4 11	12	13	14	15	16	17	17
<p>RECORD PLAN SEPT. 1994</p>							<p>DATE MARCH 1994</p>
<p>DESIGNED <u>PEB</u> CHECKED <u>SDC</u> DRAWN <u>CLS</u></p>							<p>DATE MARCH 1994</p>
<p>GRAPHIC SCALE 0 HORIZ. 20 0 VERT. 5</p>							<p>PROJECT NO. 230-215</p>
<p>CITY OF ELK RIVER TRUNK SANITARY AND WATERMAIN-ELK PARK CENTER FUTURE FREEPORT AVENUE</p>							<p>STATION 11+00 TO 17+00</p>
<p>1326 ENERGY PARK DRIVE ST. PAUL, MINNESOTA 55108 (612) 644-4389</p>							<p>SHEET 6 OF 17 SHEETS</p>
<p>9800 SHELARD PARKWAY MINNEAPOLIS, MINNESOTA 55441 (612) 546-0432</p>							<p>DRAWING NUMBER ELKPAT 94</p>
<p>I HEREBY CERTIFY THAT THIS PLAN, SPECIFICATION, OR REPORT WAS PREPARED BY ME OR UNDER MY DIRECT SUPERVISION AND THAT I AM A DULY REGISTERED PROFESSIONAL ENGINEER UNDER THE LAWS OF THE STATE OF MINNESOTA <i>Paul Boettcher</i> DATE 3-28-94 REG. NO. 13929</p>							<p>DRAWING NUMBER 6</p>

DRAWING NUMBER
 SAICO PRODUCTS • NEW HOPE, MINNESOTA
 REVISION BY PART NUMBER 0502
 DRAWING NUMBER
 SAICO PRODUCTS • NEW HOPE, MINNESOTA
 REVISION BY PART NUMBER 0502
 DRAWING NUMBER
 SAICO PRODUCTS • NEW HOPE, MINNESOTA
 REVISION BY PART NUMBER 0502
 DRAWING NUMBER
 SAICO PRODUCTS • NEW HOPE, MINNESOTA
 REVISION BY PART NUMBER 0502
 DRAWING NUMBER

Mon Mar 28 05:51:58 1994

758 858