
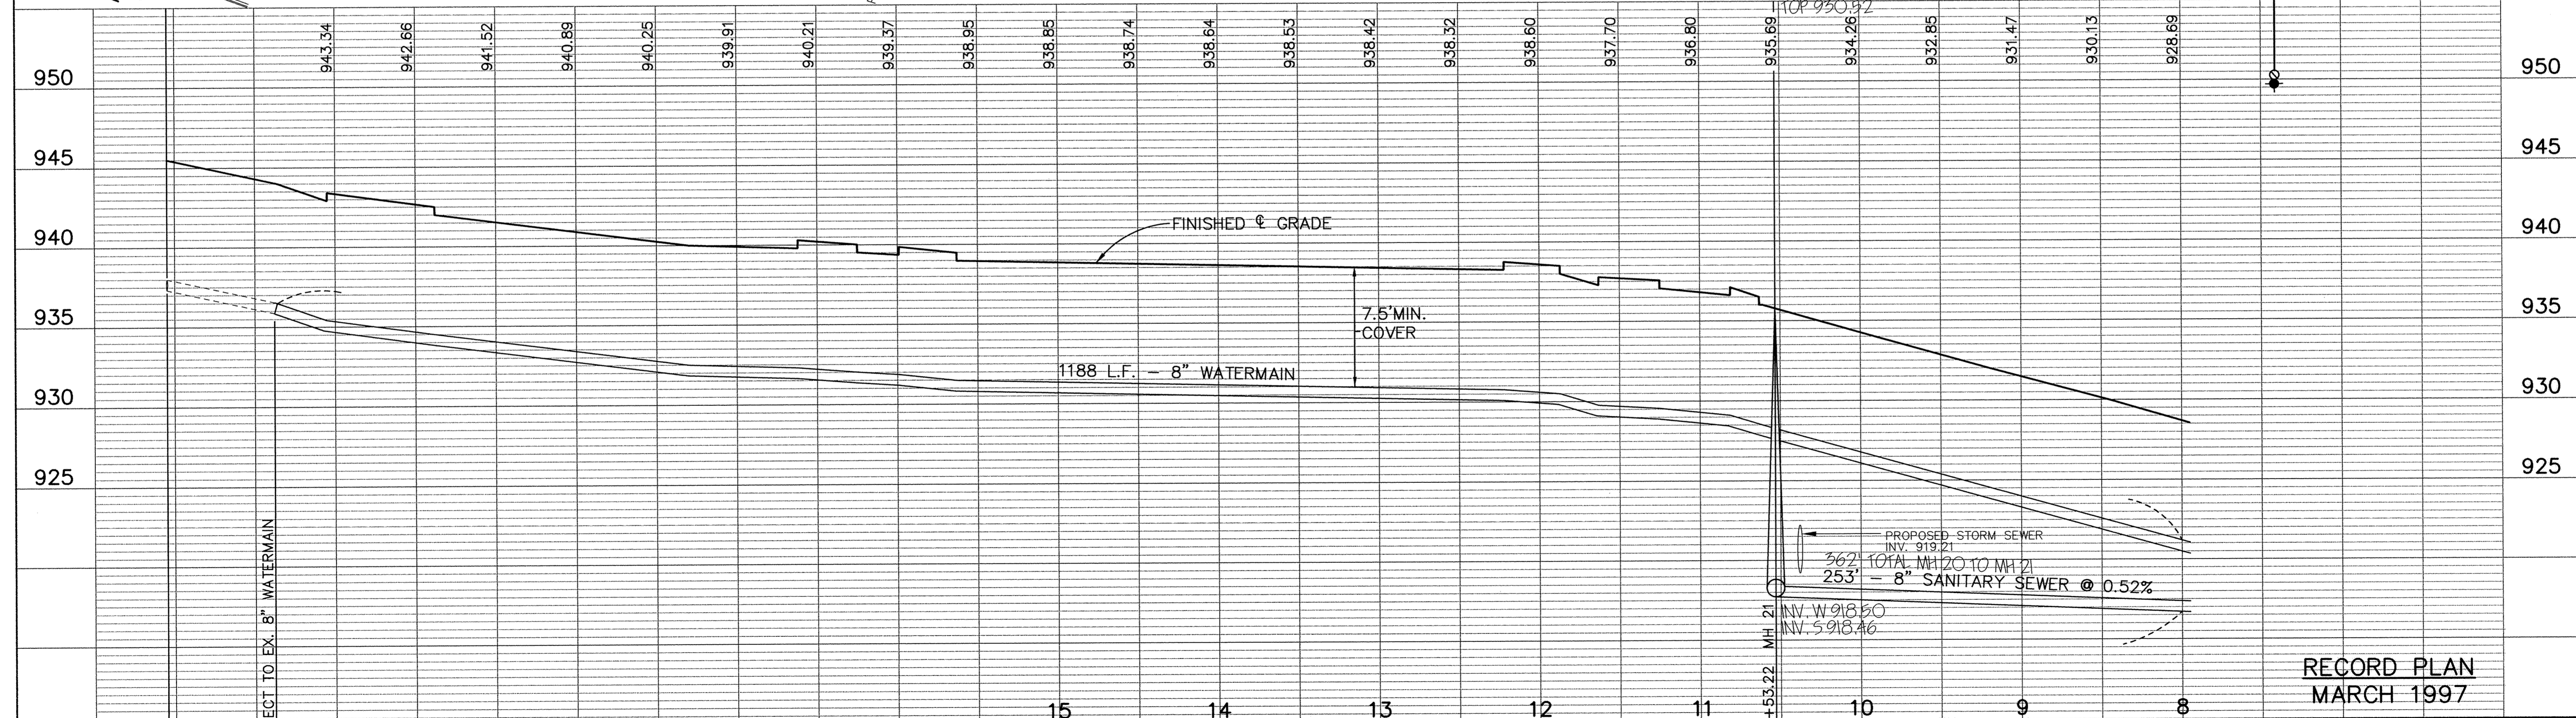


SARCO PRODUCTS • NEW HOPK, MINNESOTA  
MEMBER BY PART NUMBER 6592  
SARCO PRODUCTS • NEW HOPK, MINNESOTA  
MEMBER BY PART NUMBER 6592  
SARCO PRODUCTS • NEW HOPK, MINNESOTA  
MEMBER BY PART NUMBER 6592

# INTERNAL UTILITIES

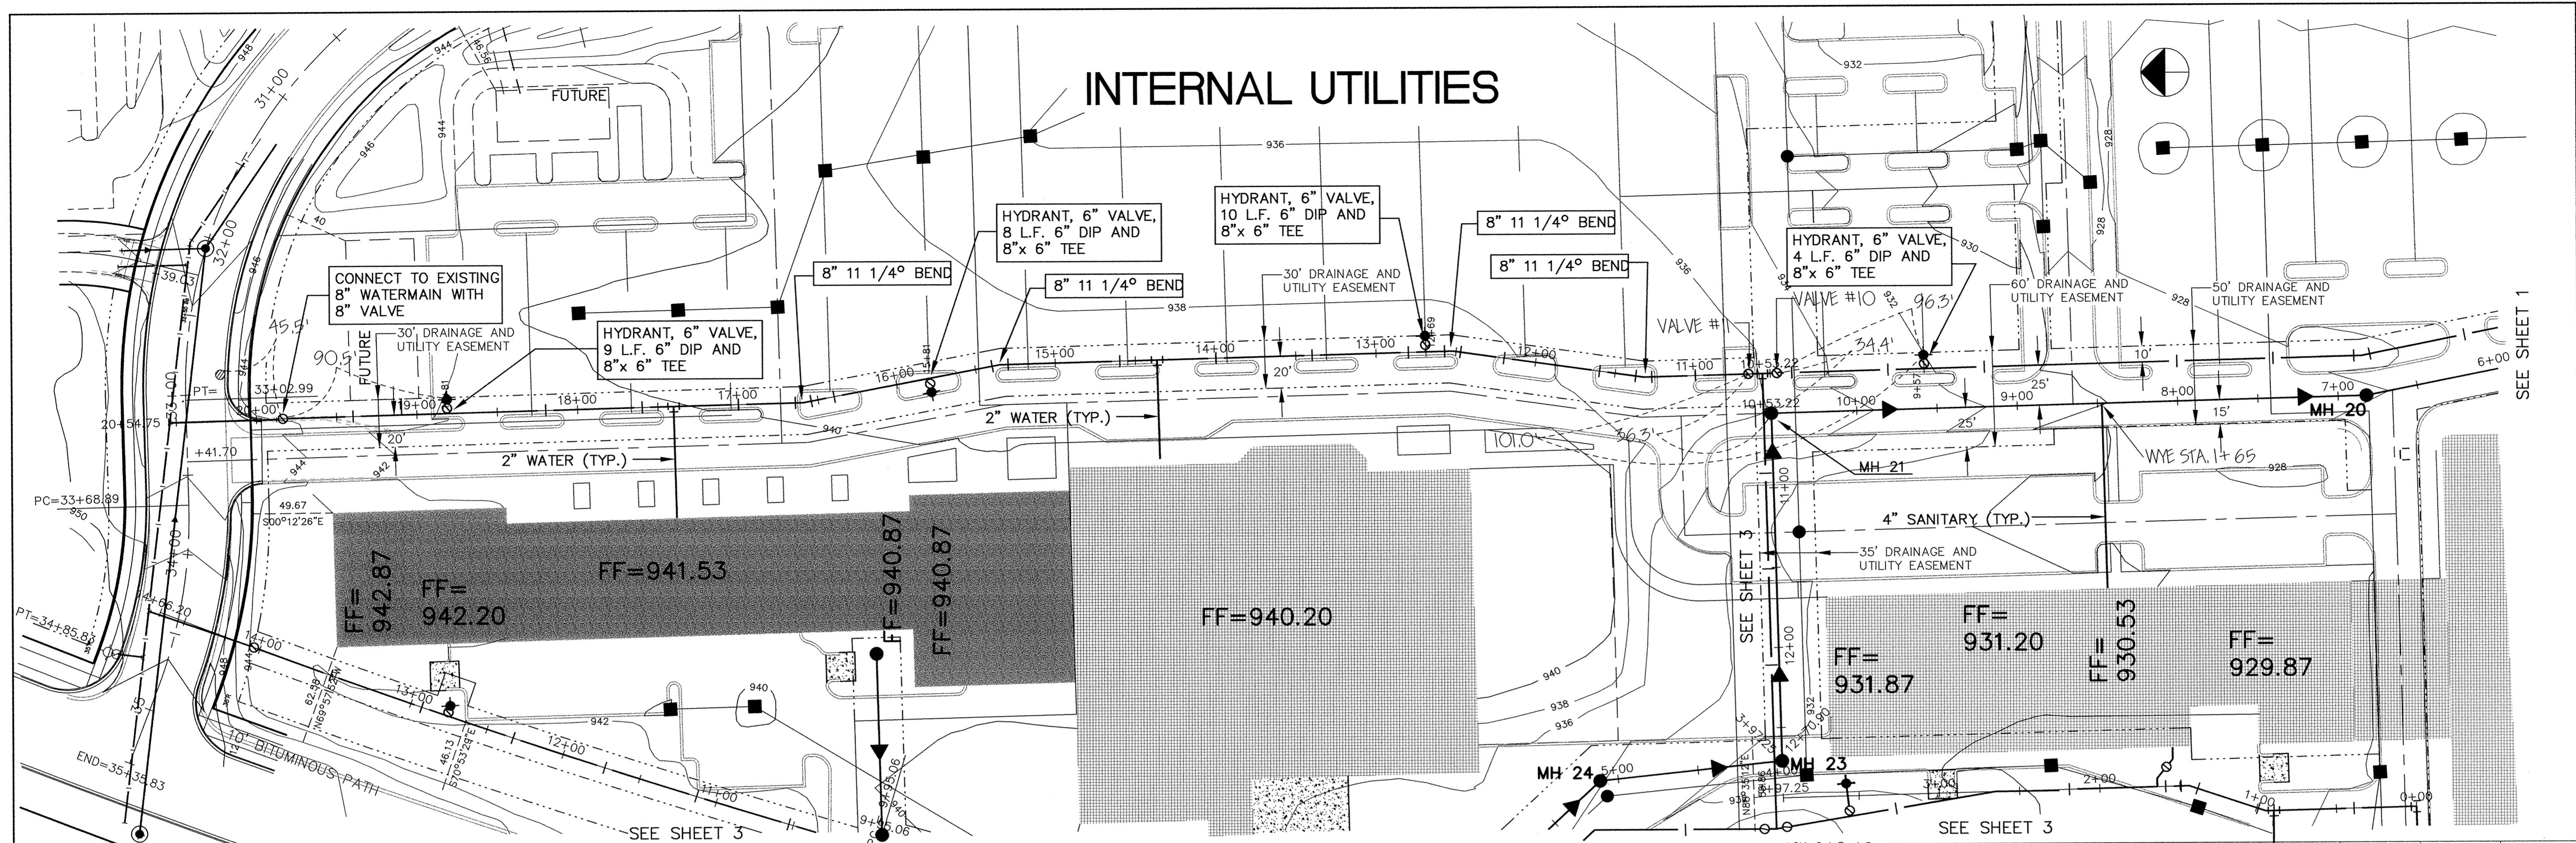

RECORD PLAN  
MARCH 1997

I HEREBY CERTIFY THAT THIS PLAN, SPECIFICATION, OR REPORT WAS PREPARED BY ME OR UNDER MY DIRECT SUPERVISION AND THAT I AM A DULY REGISTERED PROFESSIONAL ENGINEER UNDER THE LAWS OF THE STATE OF MINNESOTA. <i>Randy Mann</i> DATE _____ REG. NO. 15316	1326 ENERGY PARK DRIVE ST. PAUL, MINNESOTA 55108 (612) 644-4389  9800 SHELDARD PARKWAY MINNEAPOLIS, MINNESOTA 55441 (612) 546-0432	DATE _____ DESCRIPTION _____	DESIGNED _____ CHECKED _____ DRAWN CJS GRAPHIC SCALE 0' HORIZ. 50' 0' VERT. 5'	CITY OF ELK RIVER ELK PARK CENTER SANITARY SEWER AND WATERMAIN INTERNAL UTILITIES STA. 8+00 TO 20+54.75 DATE MAY 1994 SHEET 2 OF 6 SHEETS PROJECT NO. 230-218
		REVISIONS	PROJECT NO. 230-218	