
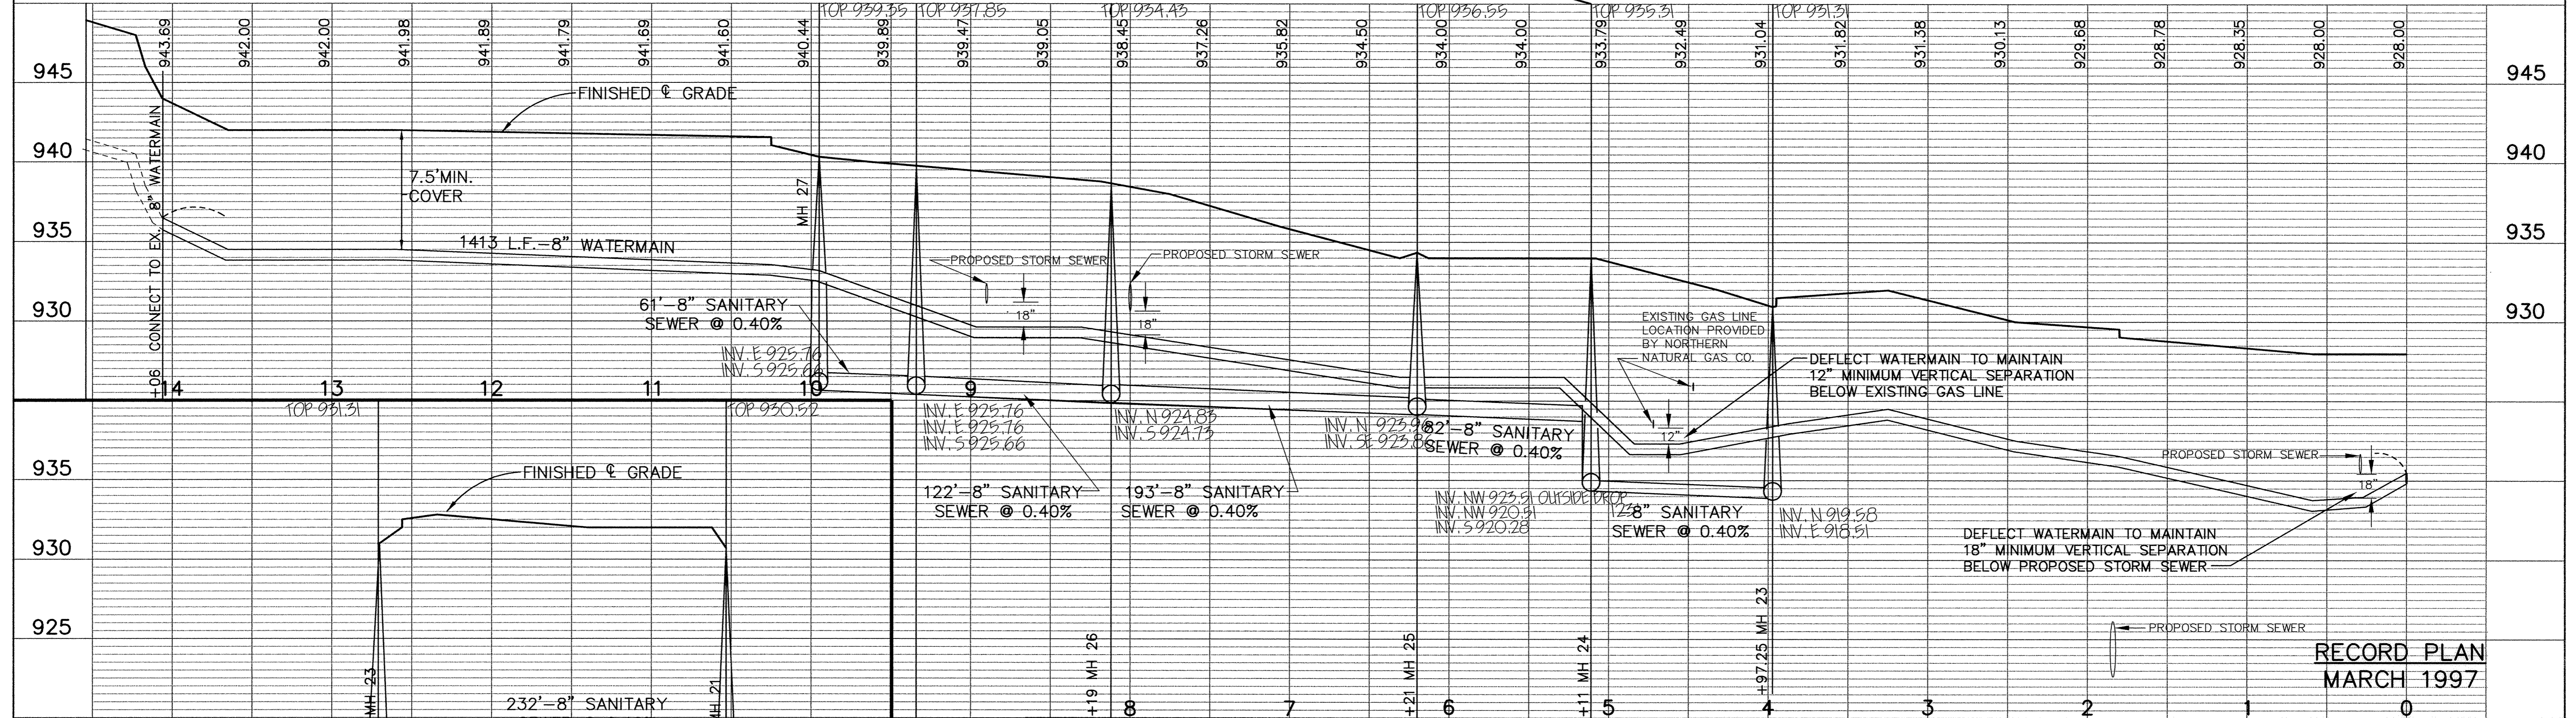



# INTERNAL UTILITIES

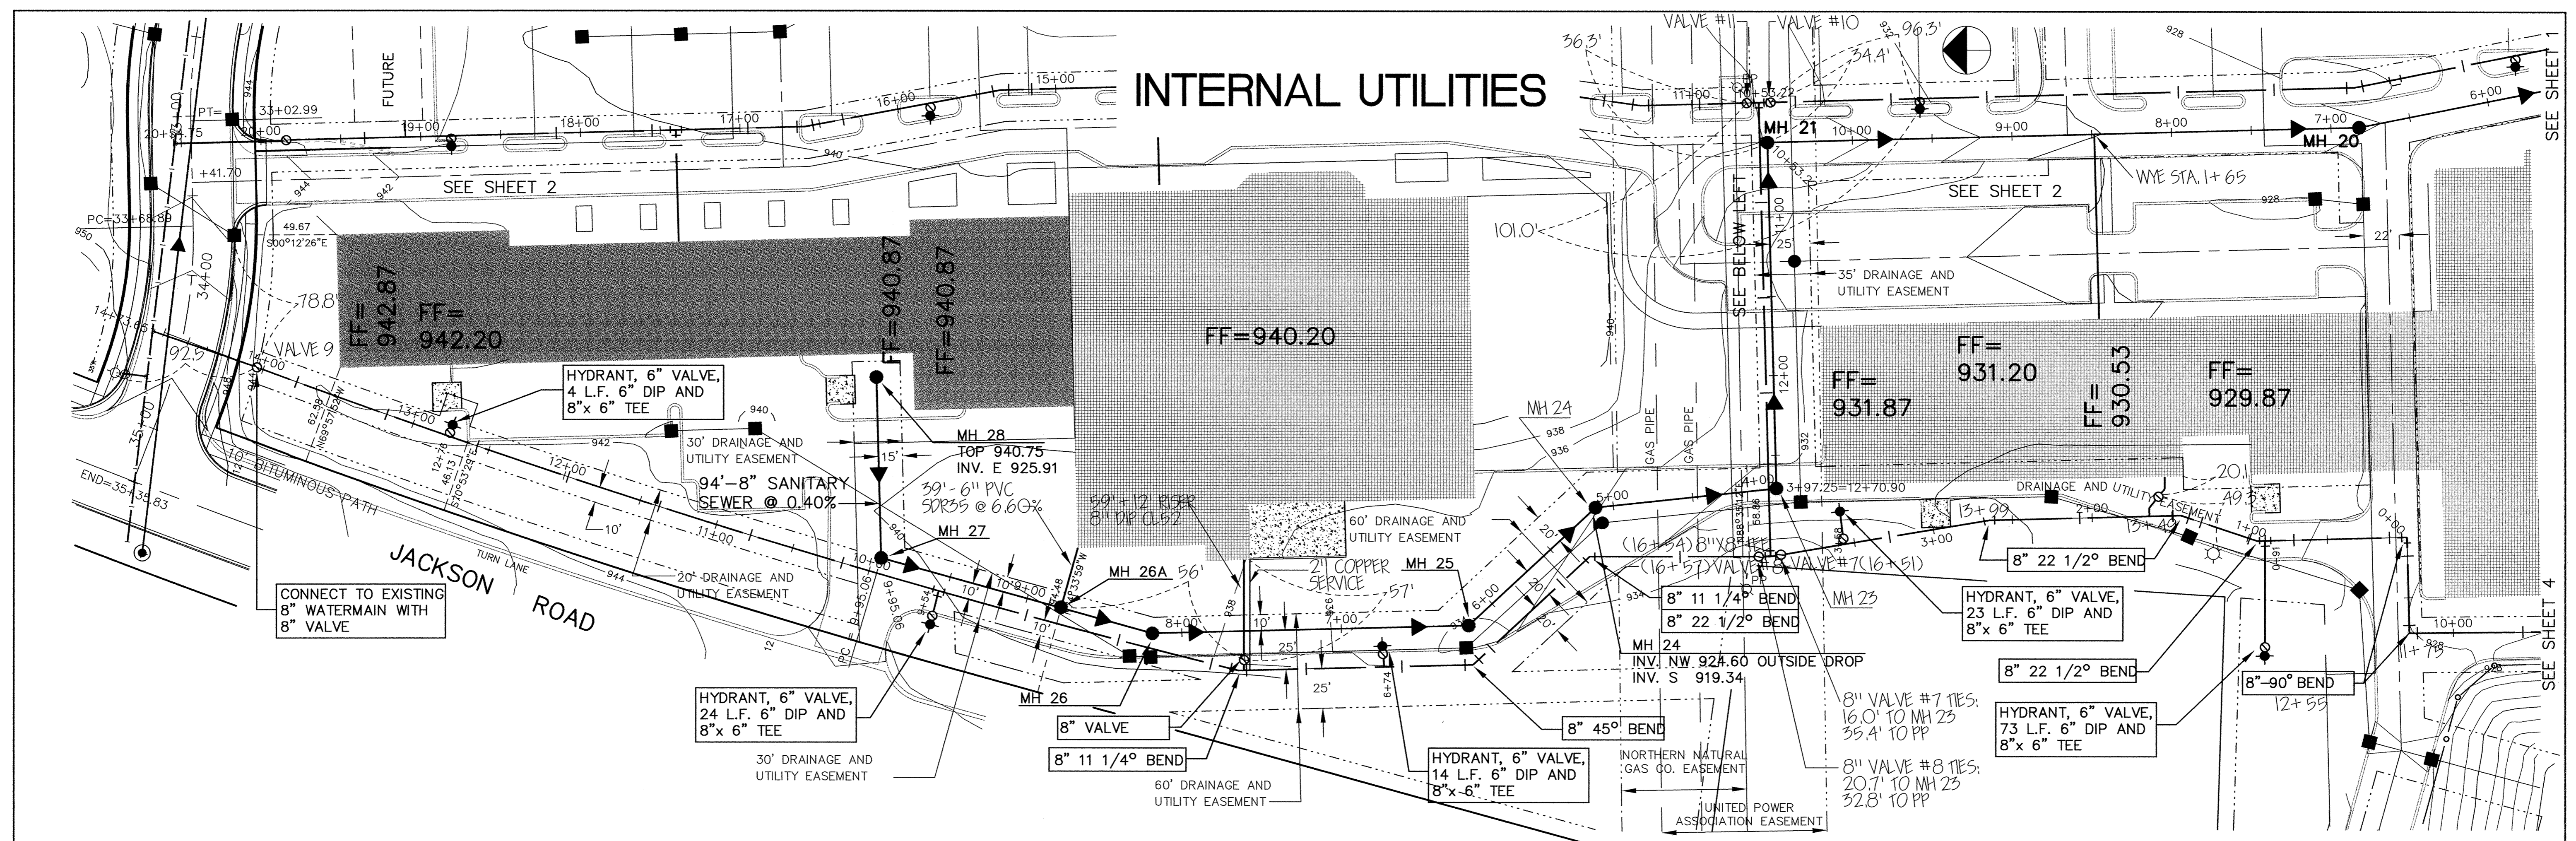

RECORD PLAN  
MARCH 1997

I HEREBY CERTIFY THAT THIS PLAN, SPECIFICATION, OR REPORT WAS PREPARED BY ME OR UNDER MY DIRECT SUPERVISION AND THAT I AM A DULY REGISTERED PROFESSIONAL ENGINEER UNDER THE LAWS OF THE STATE OF MINNESOTA.

*Leif J. Mauer*  
DATE \_\_\_\_\_ REG. NO. 15316

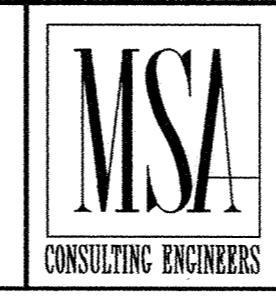

1326 ENERGY PARK DRIVE  
ST. PAUL, MINNESOTA 55108  
(612) 644-4389

9800 SHELARD PARKWAY  
MINNEAPOLIS, MINNESOTA 55441  
(612) 546-0432

DATE	DESCRIPTION	DESIGNED	CHECKED	DRAWN

GRAPHIC SCALE	
0 HORIZ. 50	
0 VERT. 5	

CITY OF ELK RIVER  
ELK PARK CENTER  
SANITARY SEWER AND WATERMAIN  
INTERNAL UTILITIES

DATE MAY 1994 SHEET 3 OF 6 SHEETS PROJECT NO. 230-218