

DRAWING NUMBER



DRAWING NUMBER

DRAWING NUMBER

DRAWING

SAFCO PRODUCTS • NEW HIRE, MINNESOTA  
REVISIONS  
DATE DESCRIPTION  
DESIGNED  
CHECKED  
DRAWN CLS  
GRAPHIC SCALE  
0 HORIZ 50  
CITY OF ELK RIVER  
ELK PARK CENTER  
SANITARY SEWER AND WATERMAIN

# INTERNAL UTILITIES

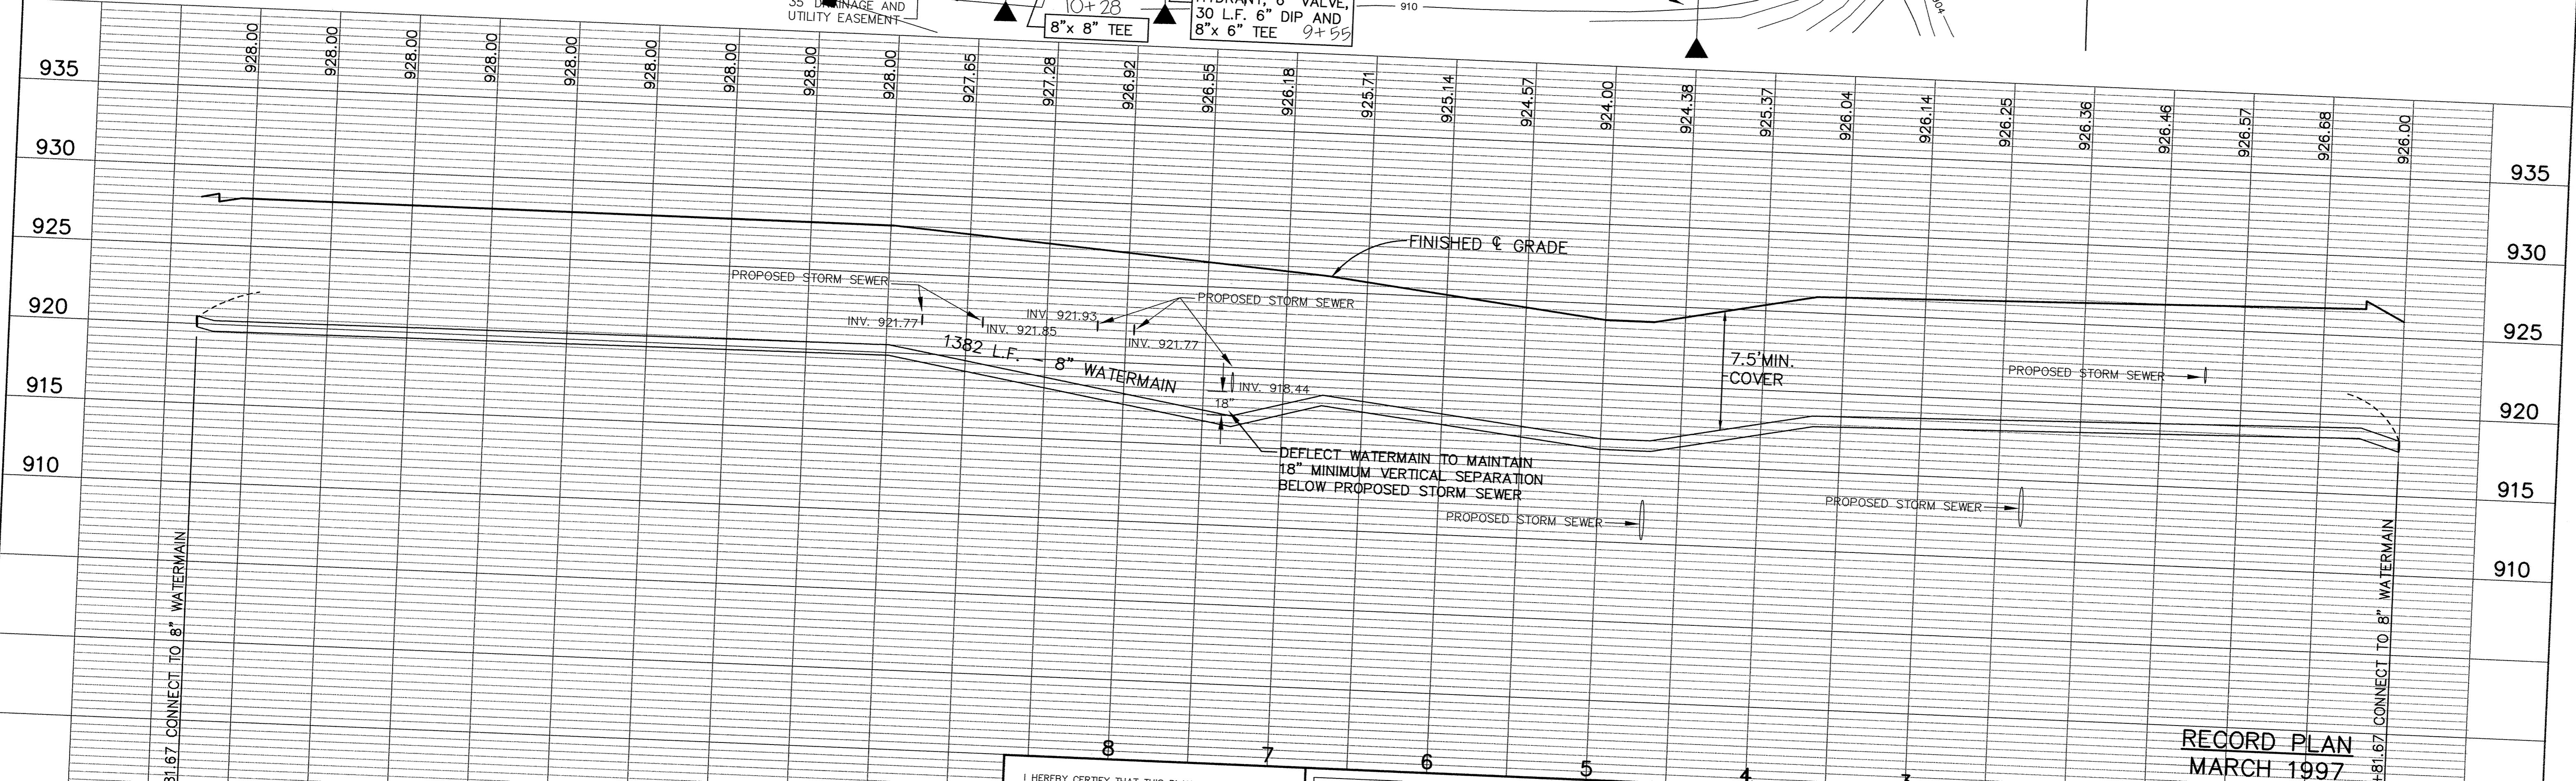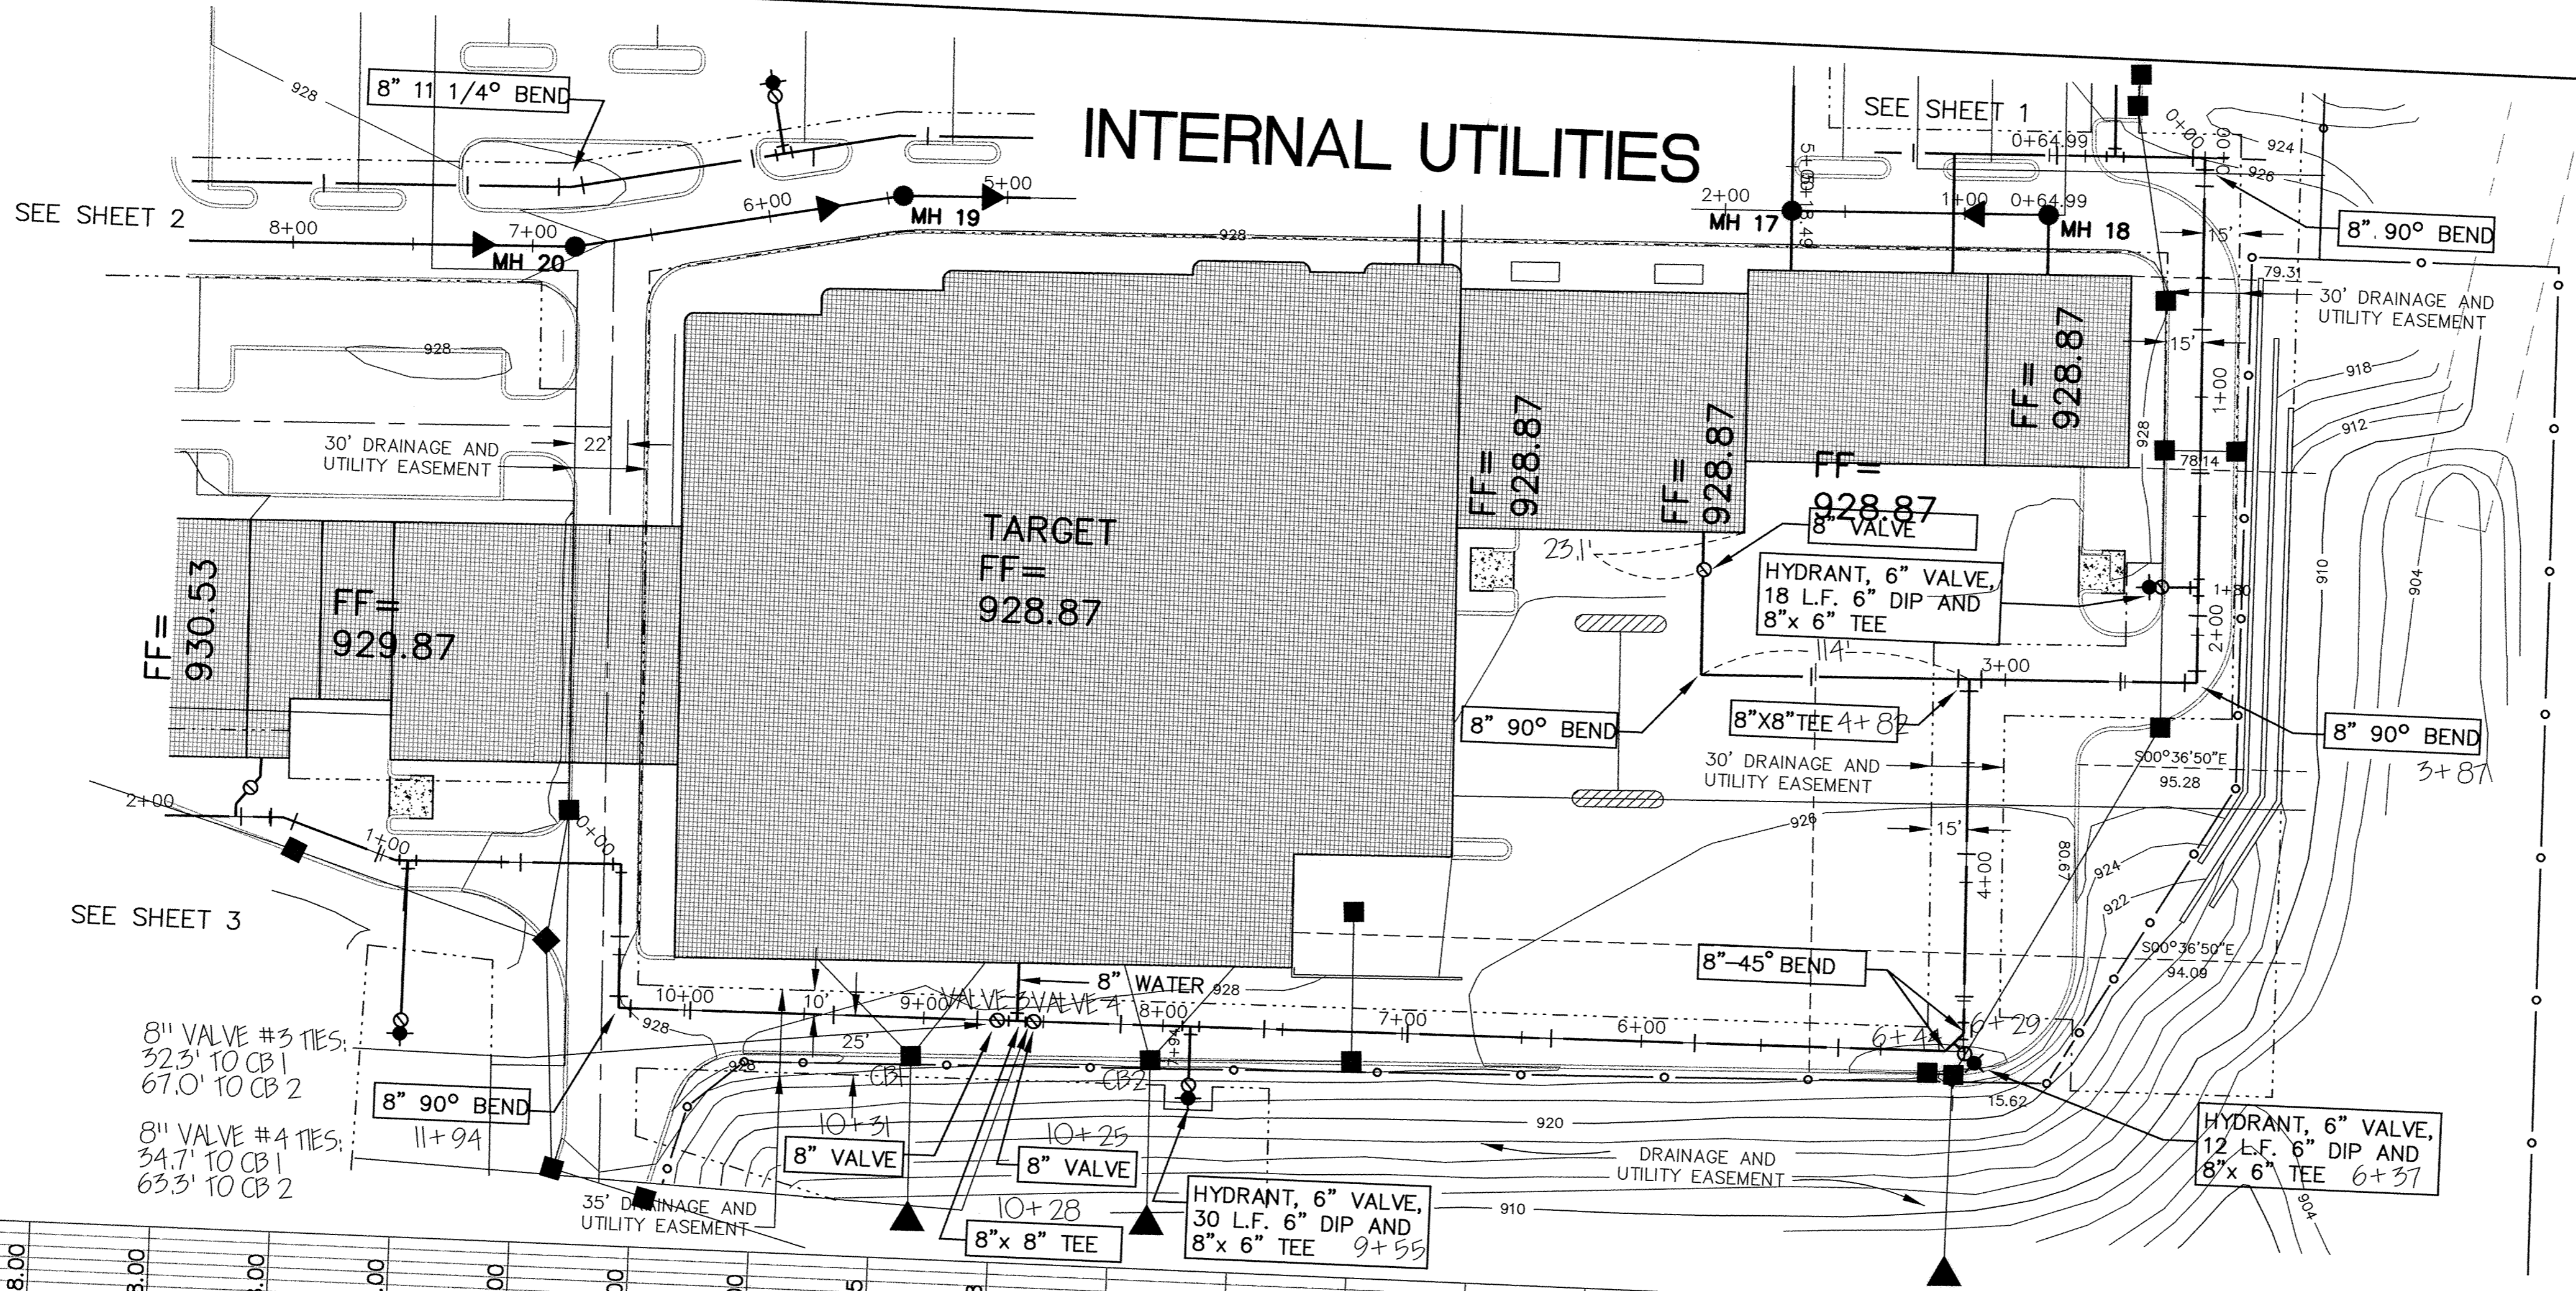

I HEREBY CERTIFY THAT THIS PLAN, SPECIFICATION, OR REPORT WAS PREPARED BY ME OR UNDER MY DIRECT SUPERVISION AND THAT I AM A DULY REGISTERED PROFESSIONAL ENGINEER UNDER THE LAWS OF THE STATE OF MINNESOTA.

*Kevin M. Mann*  
DATE: \_\_\_\_\_ REG. NO. 15366



1326 ENERGY PARK DRIVE  
ST. PAUL, MINNESOTA 55108  
(612) 644-4389

9800 SHELARD PARKWAY  
MINNEAPOLIS, MINNESOTA 55441

REVISIONS	DATE	DESCRIPTION

RECORD PLAN  
MARCH 1997

CITY OF ELK RIVER  
ELK PARK CENTER  
SANITARY SEWER AND WATERMAIN

ER218-6

14 13 12 11 10 9 8 7 6 5 4 3 2 1 0

ELKPA 94  
5 (4 of 6)