

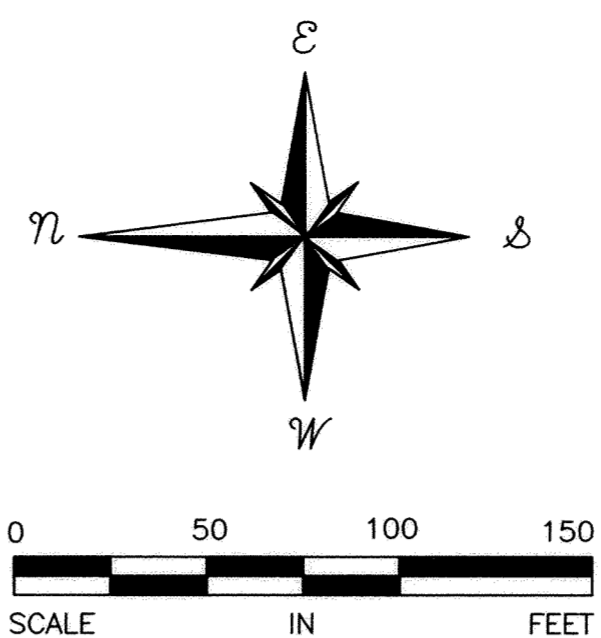
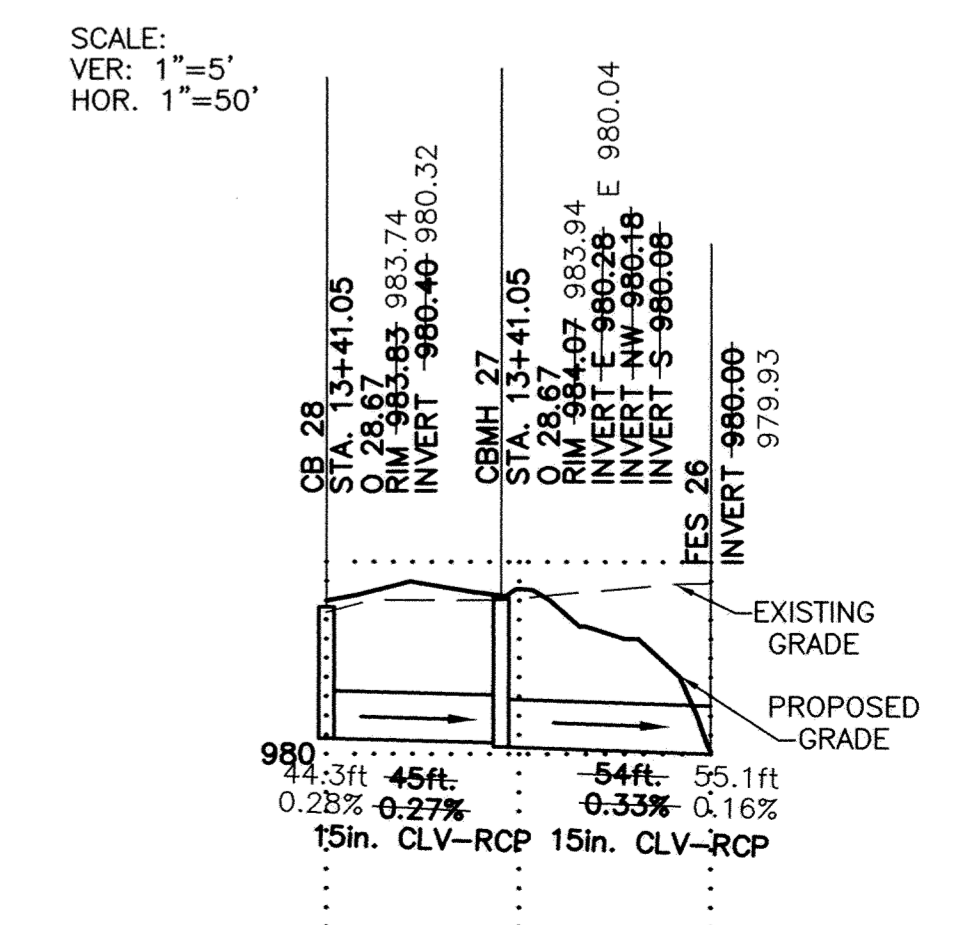
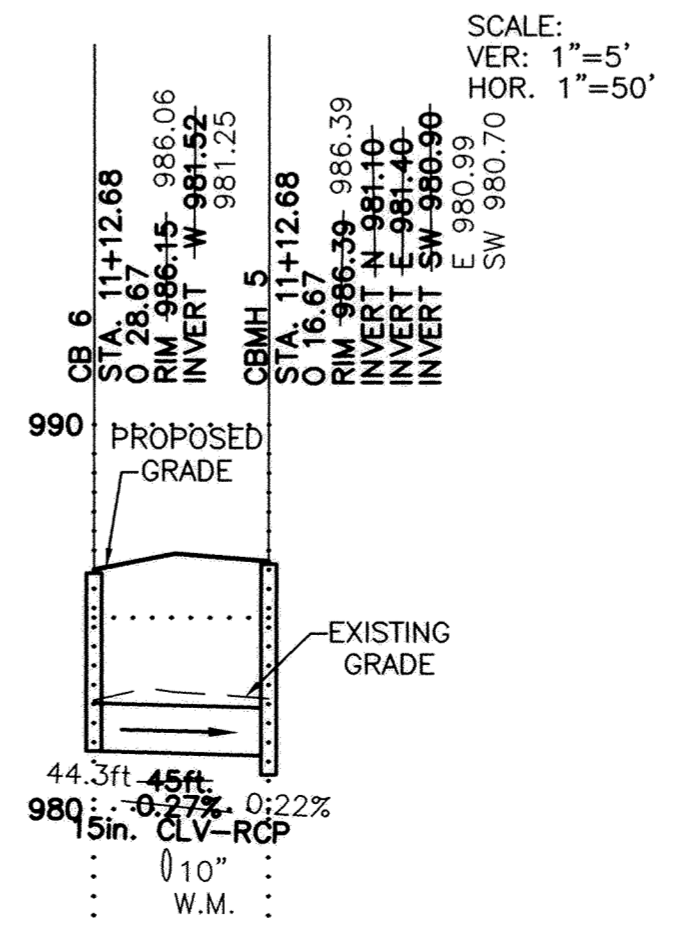
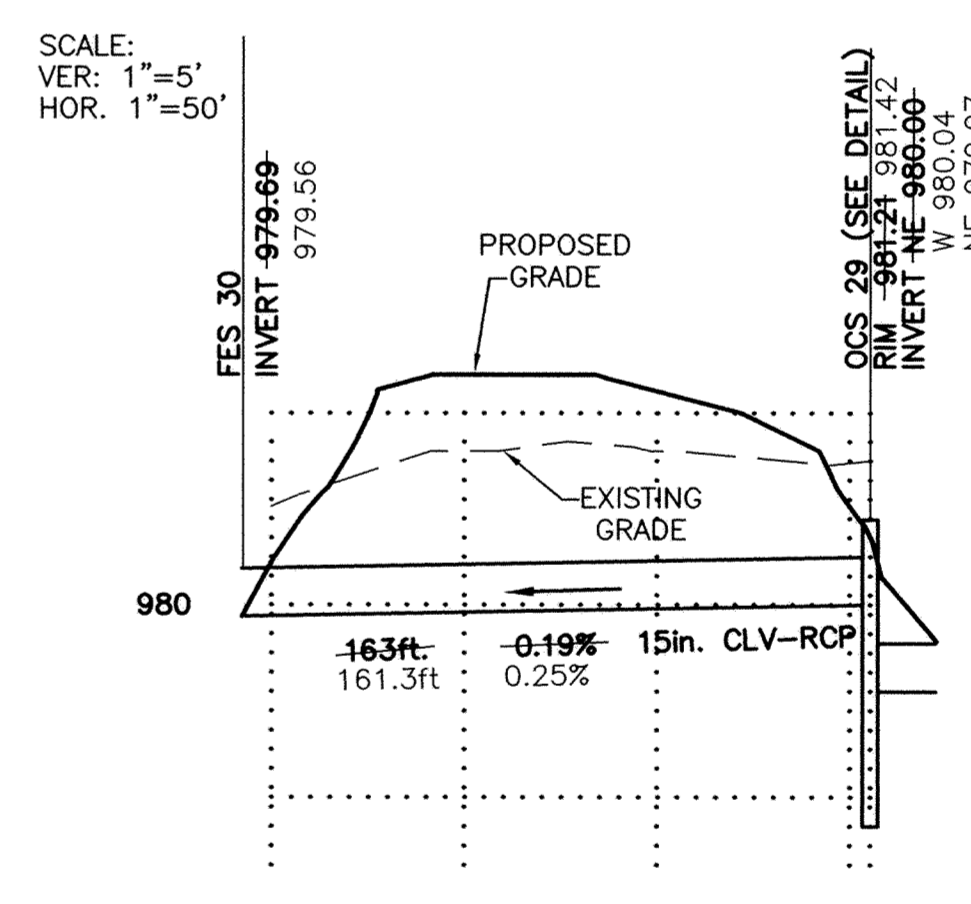
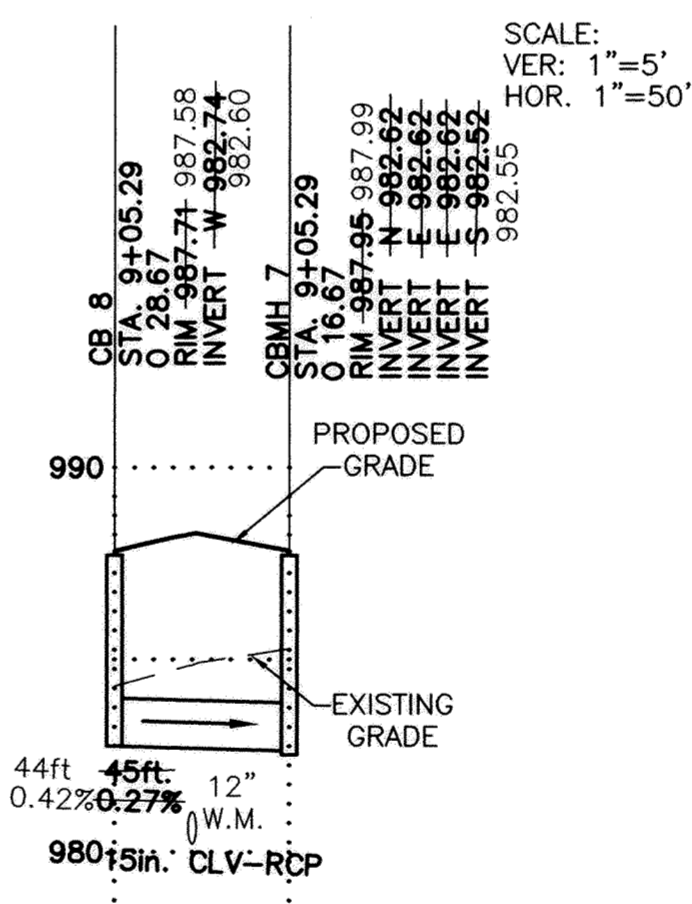
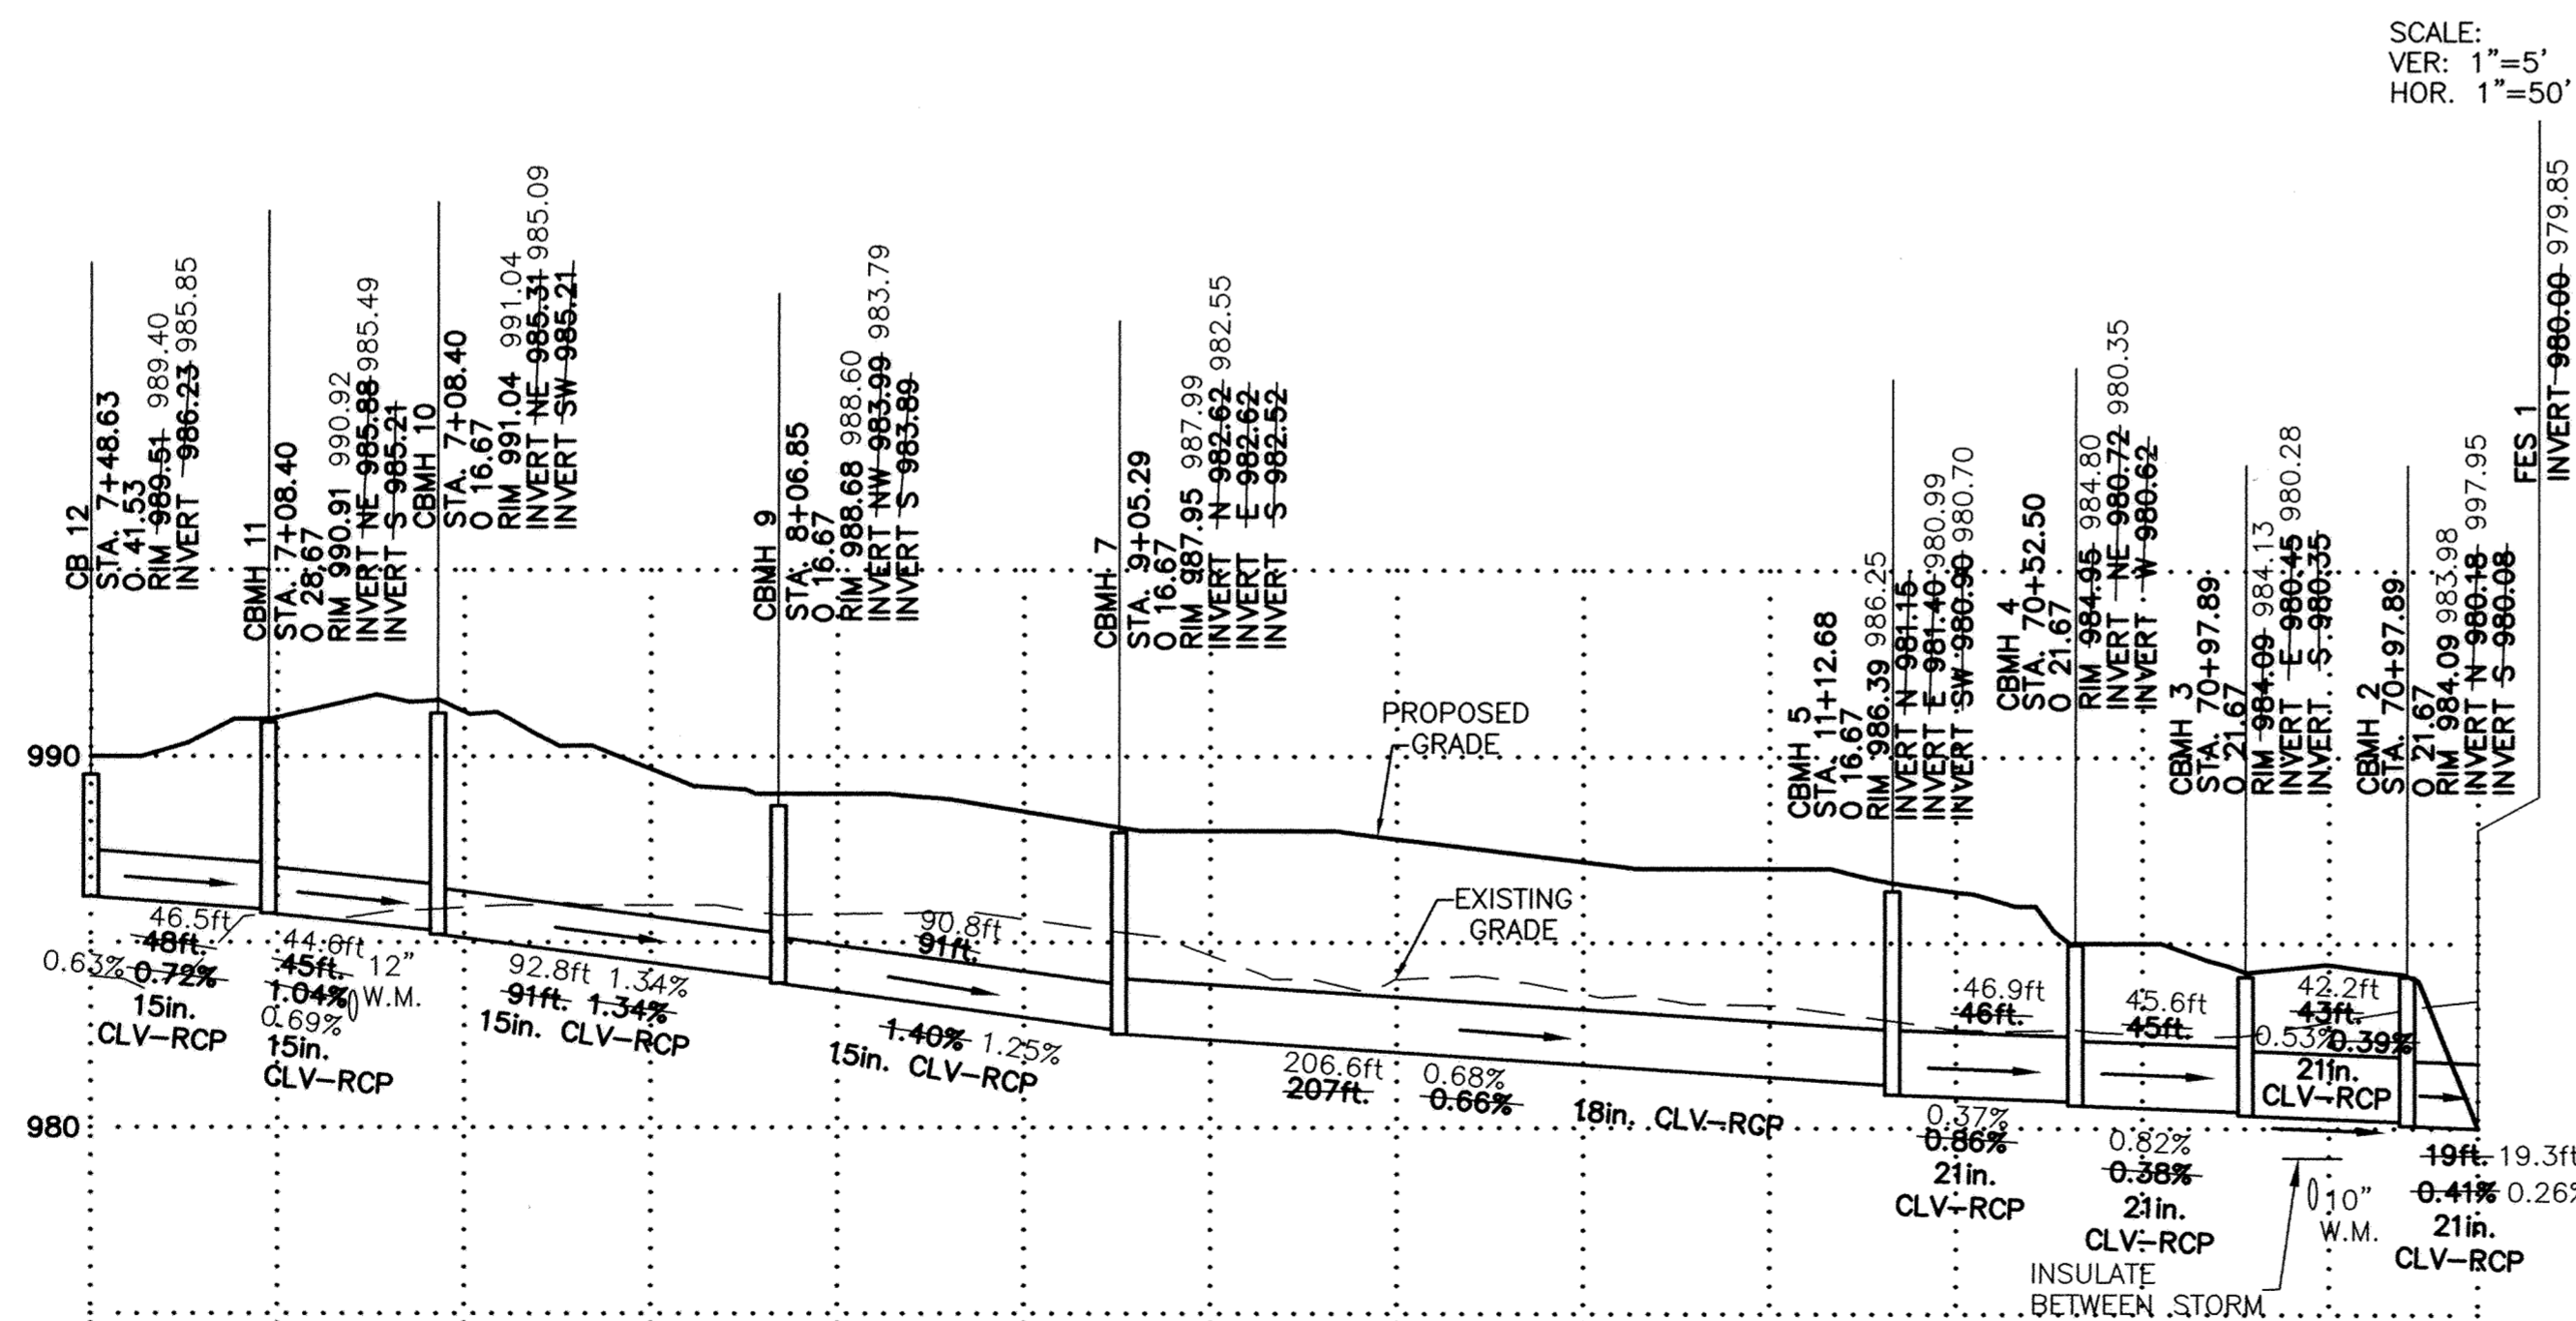


WARNING

THE CONTRACTOR SHALL CONTACT ALL PUBLIC UTILITIES FOR LOCATIONS OF ALL UNDERGROUND WIRES, CABLES, CONDUITS, PIPES, MANHOLES, VALVES, OR OTHER BURIED STRUCTURES BEFORE DIGGING. HE SHALL REPAIR OR REPLACE THE ABOVE WHEN DAMAGED DURING CONSTRUCTION AT NO COST TO OWNER.

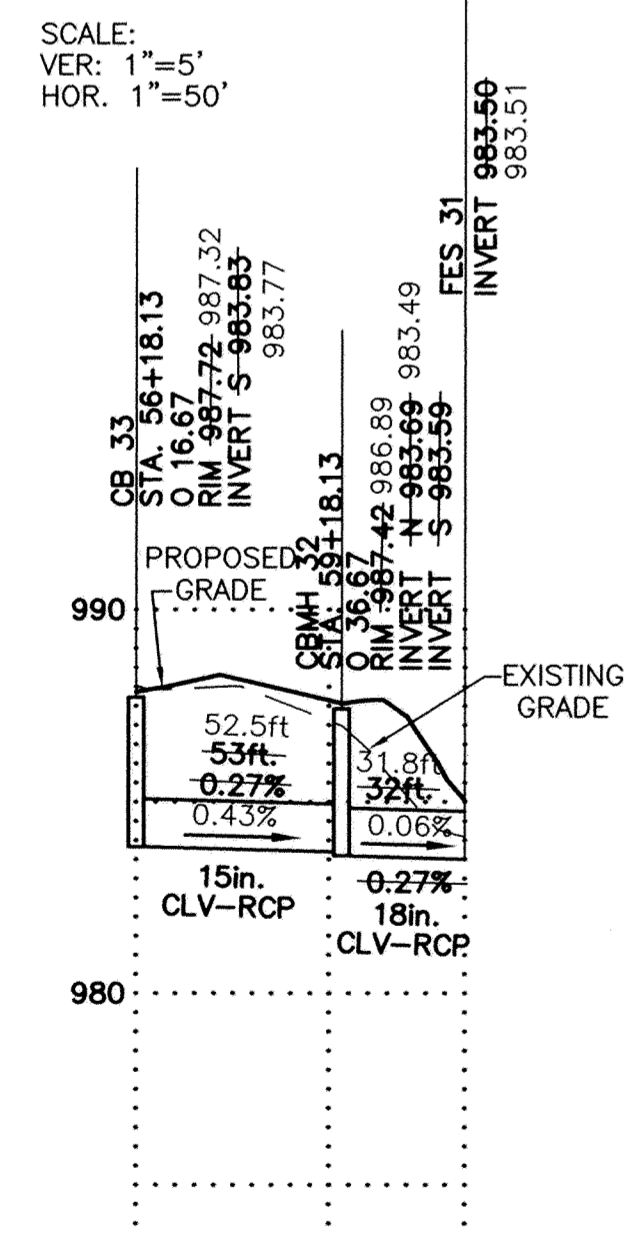

CASTING SCHEDULE		
STRUCTURE	DESCRIPTION	CASTING
FES 1	FES	
CBMH 2	CB-MH (4' DIA.)	NEENAH R-3067V
CBMH 3	CB-MH (4' DIA.)	NEENAH R-3067V
CBMH 4	CB-MH (4' DIA.)	NEENAH R-3067V
CBMH 5	CB-MH (4' DIA.)	NEENAH R-3067V
CB 6	2'x3'	NEENAH R-3067V
CBMH 7	CB-MH (4' DIA.)	NEENAH R-3067V
CB 8	2'x3'	NEENAH R-3067V
CBMH 9	CB-MH (4' DIA.)	NEENAH R-3067V
CBMH 10	CB-MH (4' DIA.)	NEENAH R-3067V
CBMH 11	CB-MH (4' DIA.)	NEENAH R-3067V
CB 12	2'x3'	NEENAH R-3067V
FES 13	FES	
CBMH 14	CB-MH (4' DIA.)	NEENAH R-3067V
CBMH 15	CB-MH (4' DIA.)	NEENAH R-3067V
CBMH 16	CB-MH (4' DIA.)	NEENAH R-3067V
CBMH 17	CB-MH (4' DIA.)	NEENAH R-3067V
CBMH 18	CB-MH (4' DIA.)	NEENAH R-3067V
CBMH 19	CB-MH (4' DIA.)	NEENAH R-3067V
CBMH 20	CB-MH (4' DIA.)	NEENAH R-3067V
CBMH 21	CB-MH (4' DIA.)	NEENAH R-3067V
OCS 22	DETAIL	DETAIL
FES 23	FES	
CBMH 24	CB-MH (4' DIA.)	NEENAH R-3067V
CB 25	2'x3'	NEENAH R-3067V
FES 26	FES	
CBMH 27	CB-MH (4' DIA.)	NEENAH R-3067V
CB 28	2'x3'	NEENAH R-3067V
OCS 29	DETAIL	DETAIL
FES 30	FES	
FES 31	FES	
CBMH 32	CB-MH (4' DIA.)	NEENAH R-3067V
CB 33	2'x3'	NEENAH R-3067V
CBMH 34	CB-MH (4' DIA.)	NEENAH R-4341A
CBMH 35	CB-MH (4' DIA.)	NEENAH R-3067V
CB 36	2'x3'	NEENAH R-3067V
CB 37	FES	
CBMH 38	CB-MH (4' DIA.)	NEENAH R-4341A

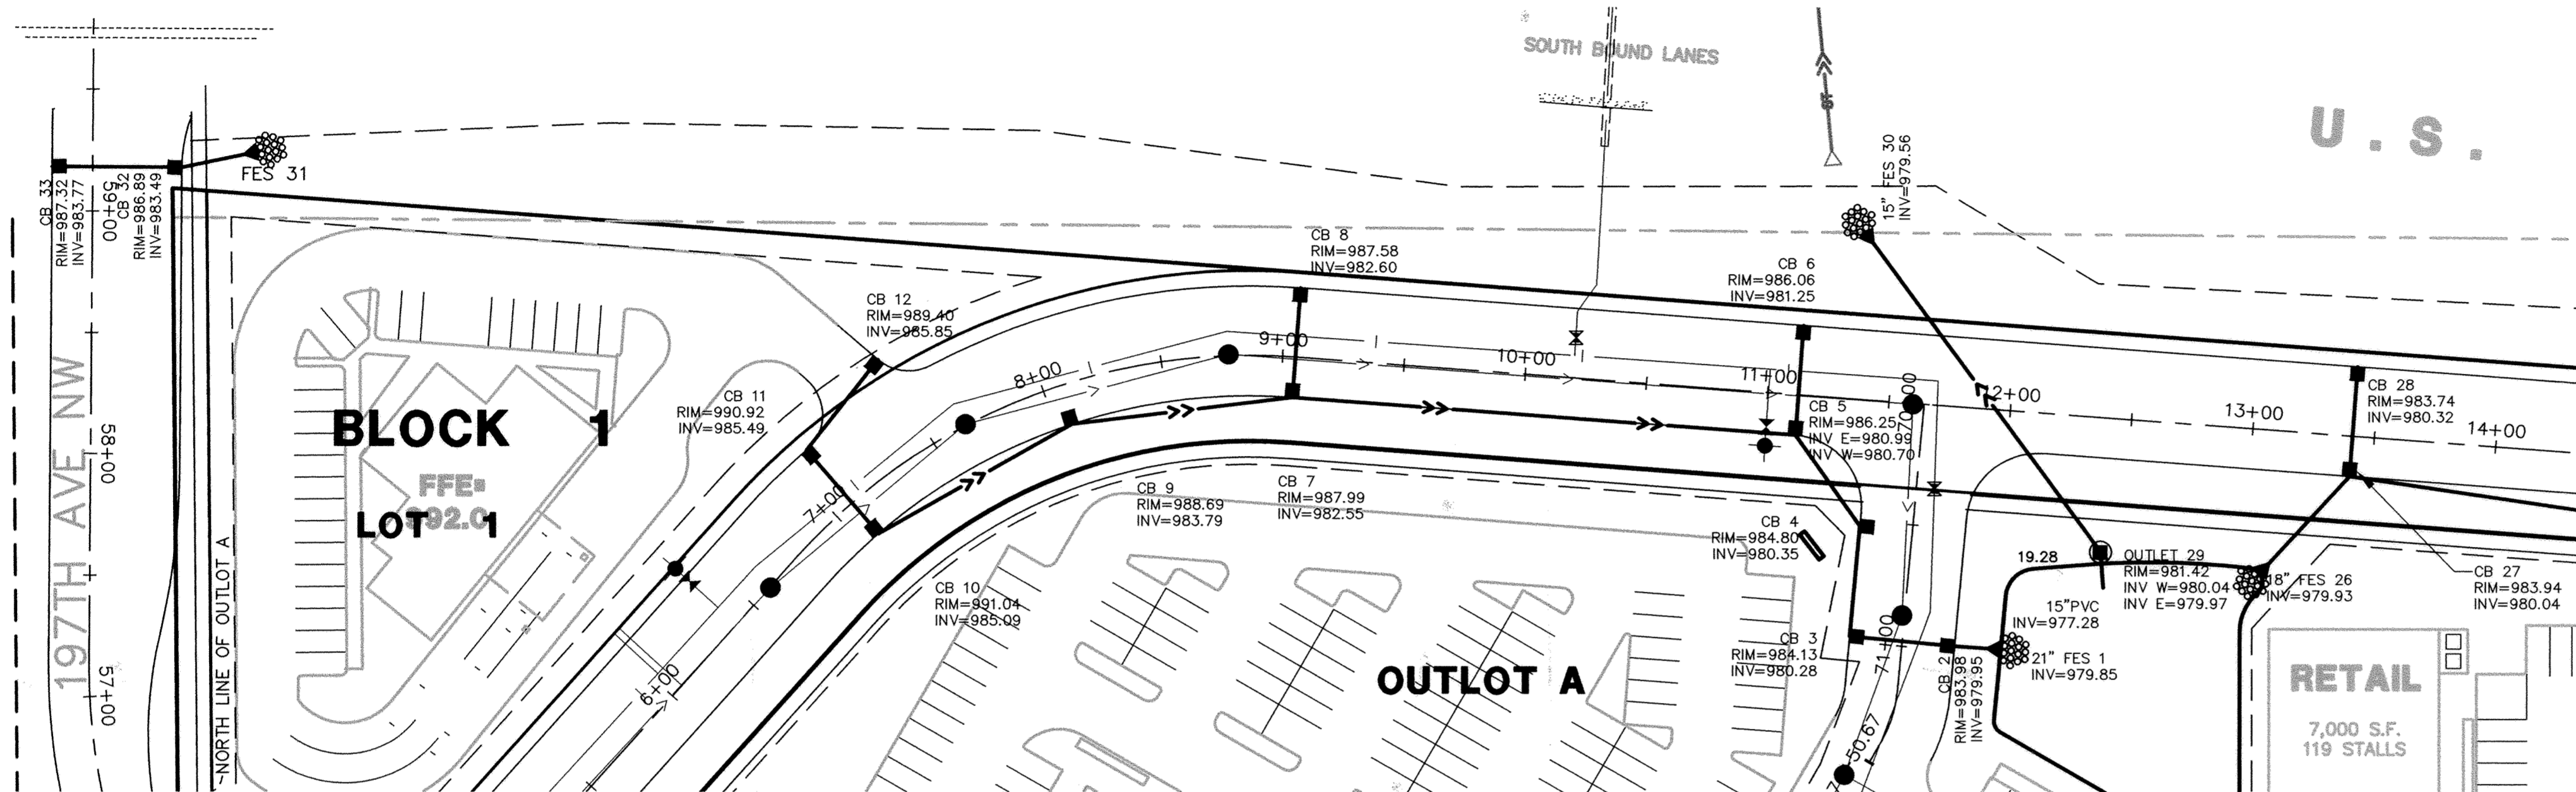

**RECORD PLANS
UTILITY CONTRACTOR
BELAIR
MARCH 2005**

HEREBY CERTIFY THAT THIS PLAN, SPECIFICATION OR REPORT WAS PREPARED BY ME OR UNDER MY DIRECT SUPERVISION AND THAT I AM A DULY LICENSED ARCHITECT OR ENGINEER UNDER THE LAWS OF THE STATE OF MINNESOTA.

Kenneth Adolf
Kenneth Adolf

06-02-04
Date
12048
Reg No:

PROJECT:

**ELK RIDGE
CENTER
PHASE 1**

197th Avenue N.W. @ T.H. 169
Elk River, Minnesota

Mark	Date	Description
PW	8-18-04	CITY COMMENTS
PW	9-16-04	CITY COMMENTS
PW	11-09-04	FES 30 ADJUSTMENT
CB	09-13-06	AS-BUILT

COMM. NO.: MDC0301
DATE: MARCH, 16 2005
DRAWN: RTW
CHECKED: DP

DRAWING TITLE:

**STORM SEWER
PLAN & PROFILE
RECORD PLANS**

DRAWING NUMBER:

C - 14