
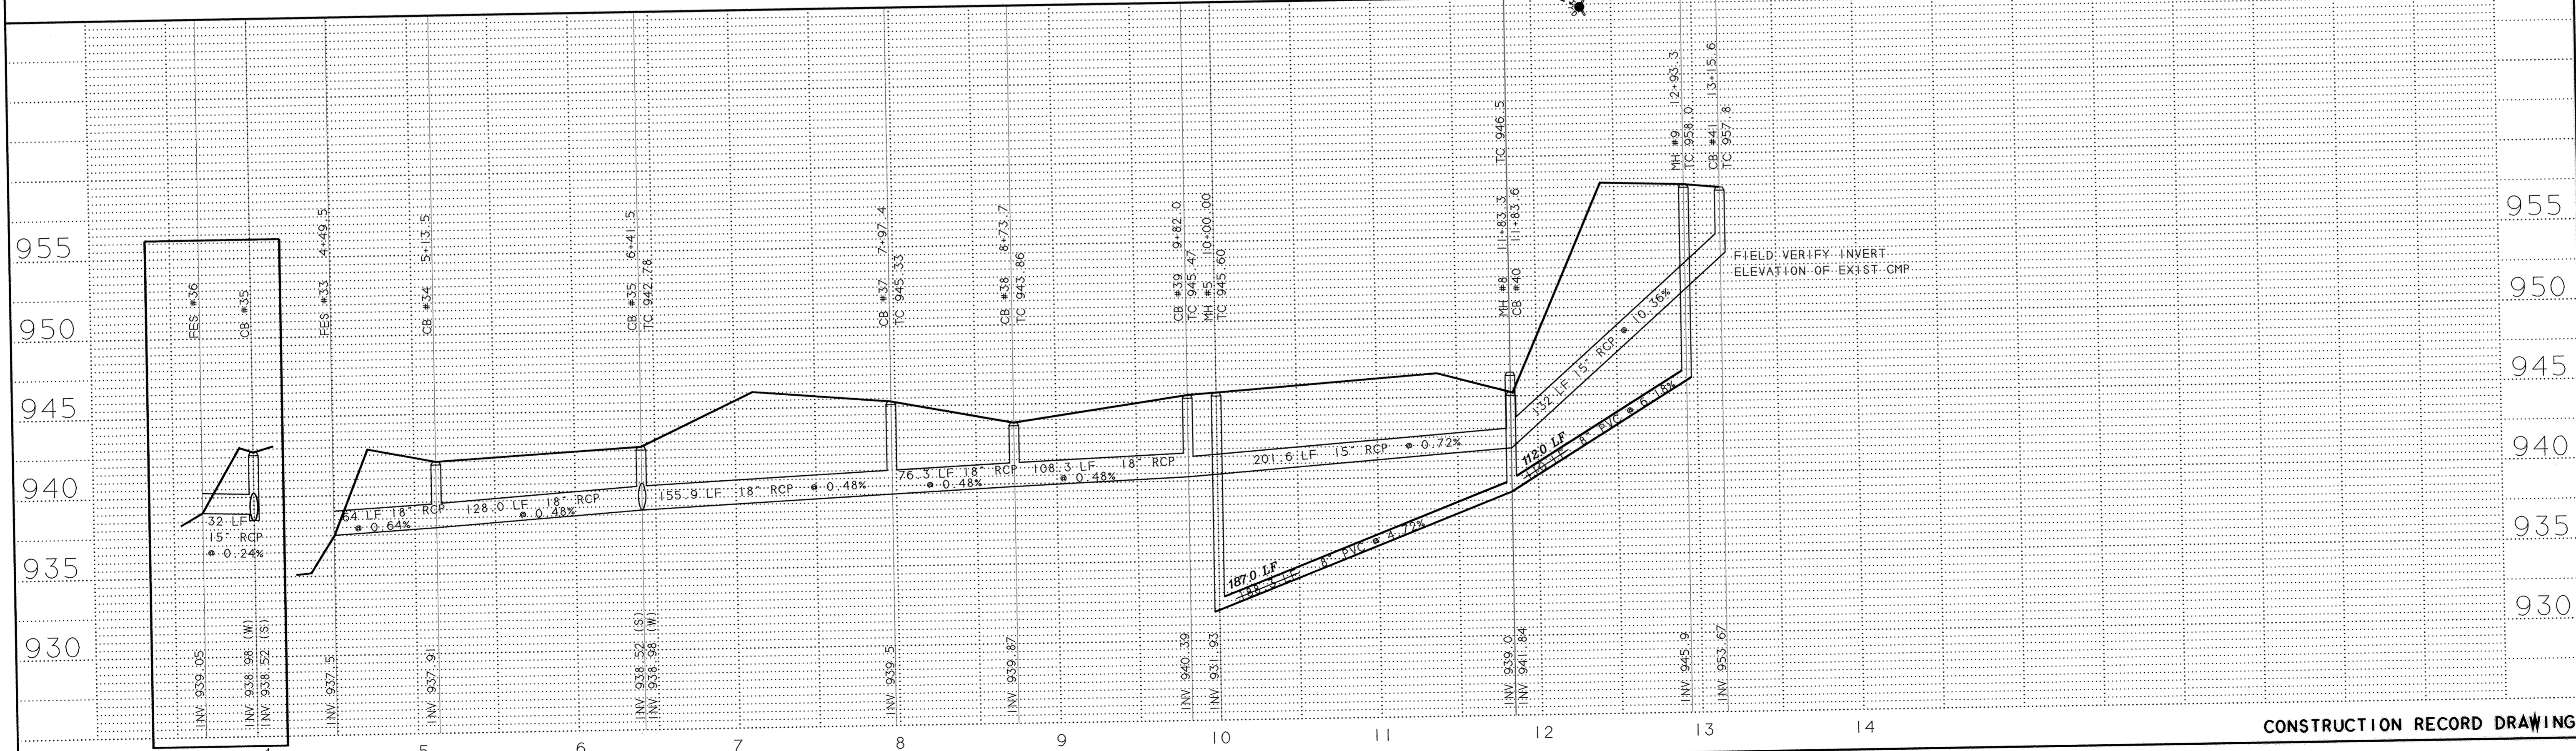
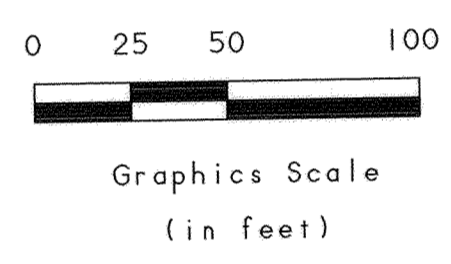
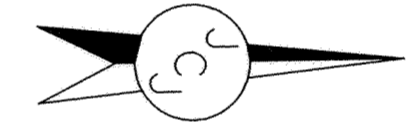


# DETAIL 2

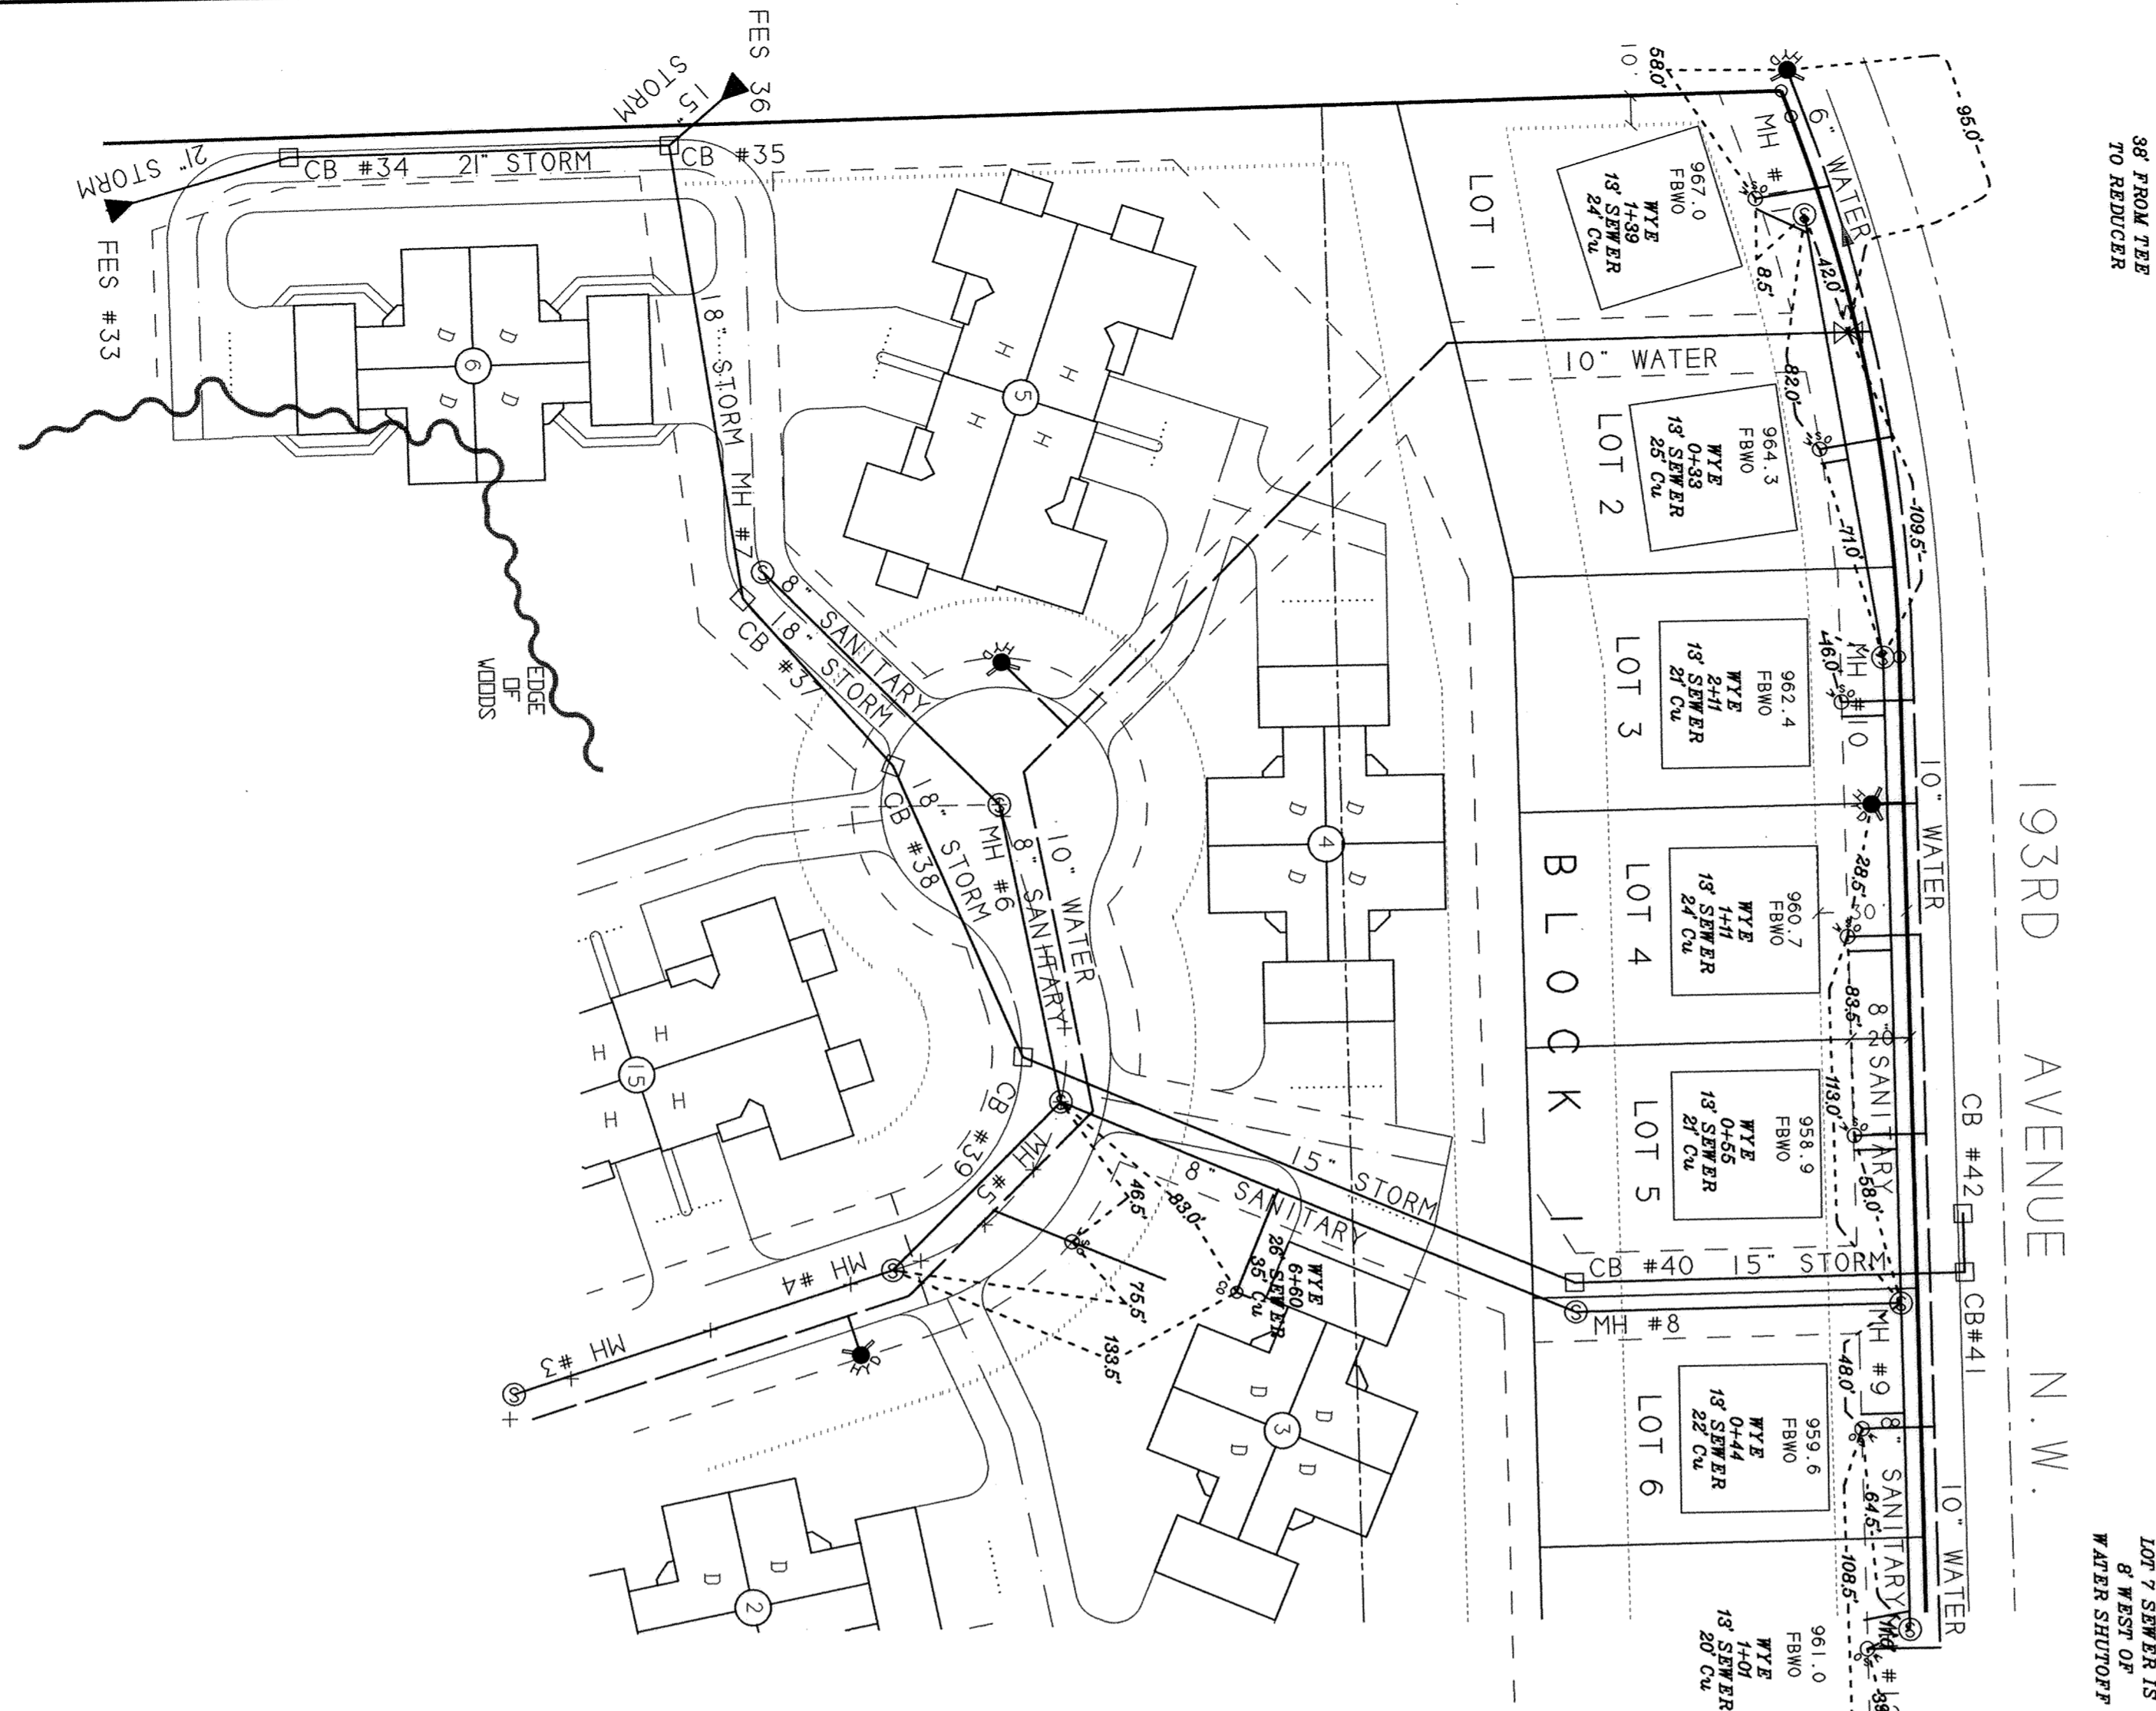

CONSTRUCTION RECORD DRAWING

<b>J C JOHNSON CONSULTANTS, INC.</b>	<b>ELK RIVER</b>	<b>DATE:</b> 10/17/96	<b>PROJECT NO.:</b> 950302	<b>PRO-3</b>	<b>5</b>
<b>SITE PLANNING AND DESIGN</b>	<b>COTTAGE HOMESTEADS OF ELK RIVER, INC.</b>	<b>PRO-3</b>	<b>PRO-3</b>	<b>PRO-3</b>	<b>PRO-3</b>
8618 Maryland Ave N Brooklyn Park, MN 55445 Phone: (612) 391-0243 FAX: (612) 391-0245	<b>DETAIL 2</b>				

**1358**