
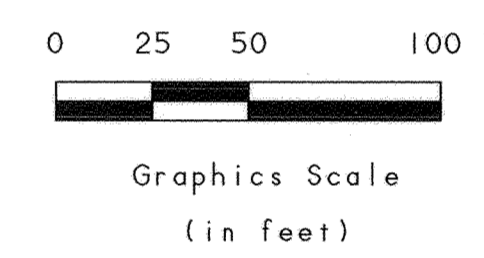


NO.	DATE	DESCRIPTION	BY
3	9/20/99	ADD 'AS BUILT' NOTES	JCL

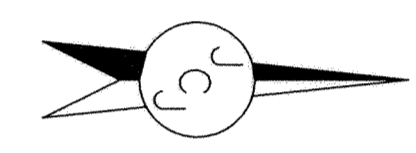

J C JOHNSON CONSULTANTS, INC.
 SITE PLANNING AND DESIGN
 8618 Maryland Ave N
 Brooklyn Park, MN 55445
 Phone: (612) 391-0243 FAX: (612) 391-0245

IRVING COURT AND DETAIL 5
COTTAGE HOMESTEADS OF ELK RIVER, INC.
 30+00.00 - 39+38

ELK RUN
 PROFILE
 COTTAGE HOMESTEADS OF ELK RIVER, INC.

SHEET	4
DATE:	10/1/96
PROJECT NO.:	950302
CADD FILE:	PRO-4

1356

I hereby certify that this plan, specification or report was prepared by me or under my direct supervision and that I am a duly registered Professional Engineer under the laws of the State of Minnesota.
 John C. Johnson
 Reg. No. 11546 Date 7/20/99
 J.C. JOHNSON CONSULTANTS, INC. • 300 FORD DRIVE • ELK RIVER, MN 55445 • (612) 391-0243