



CITY OF ELK RIVER

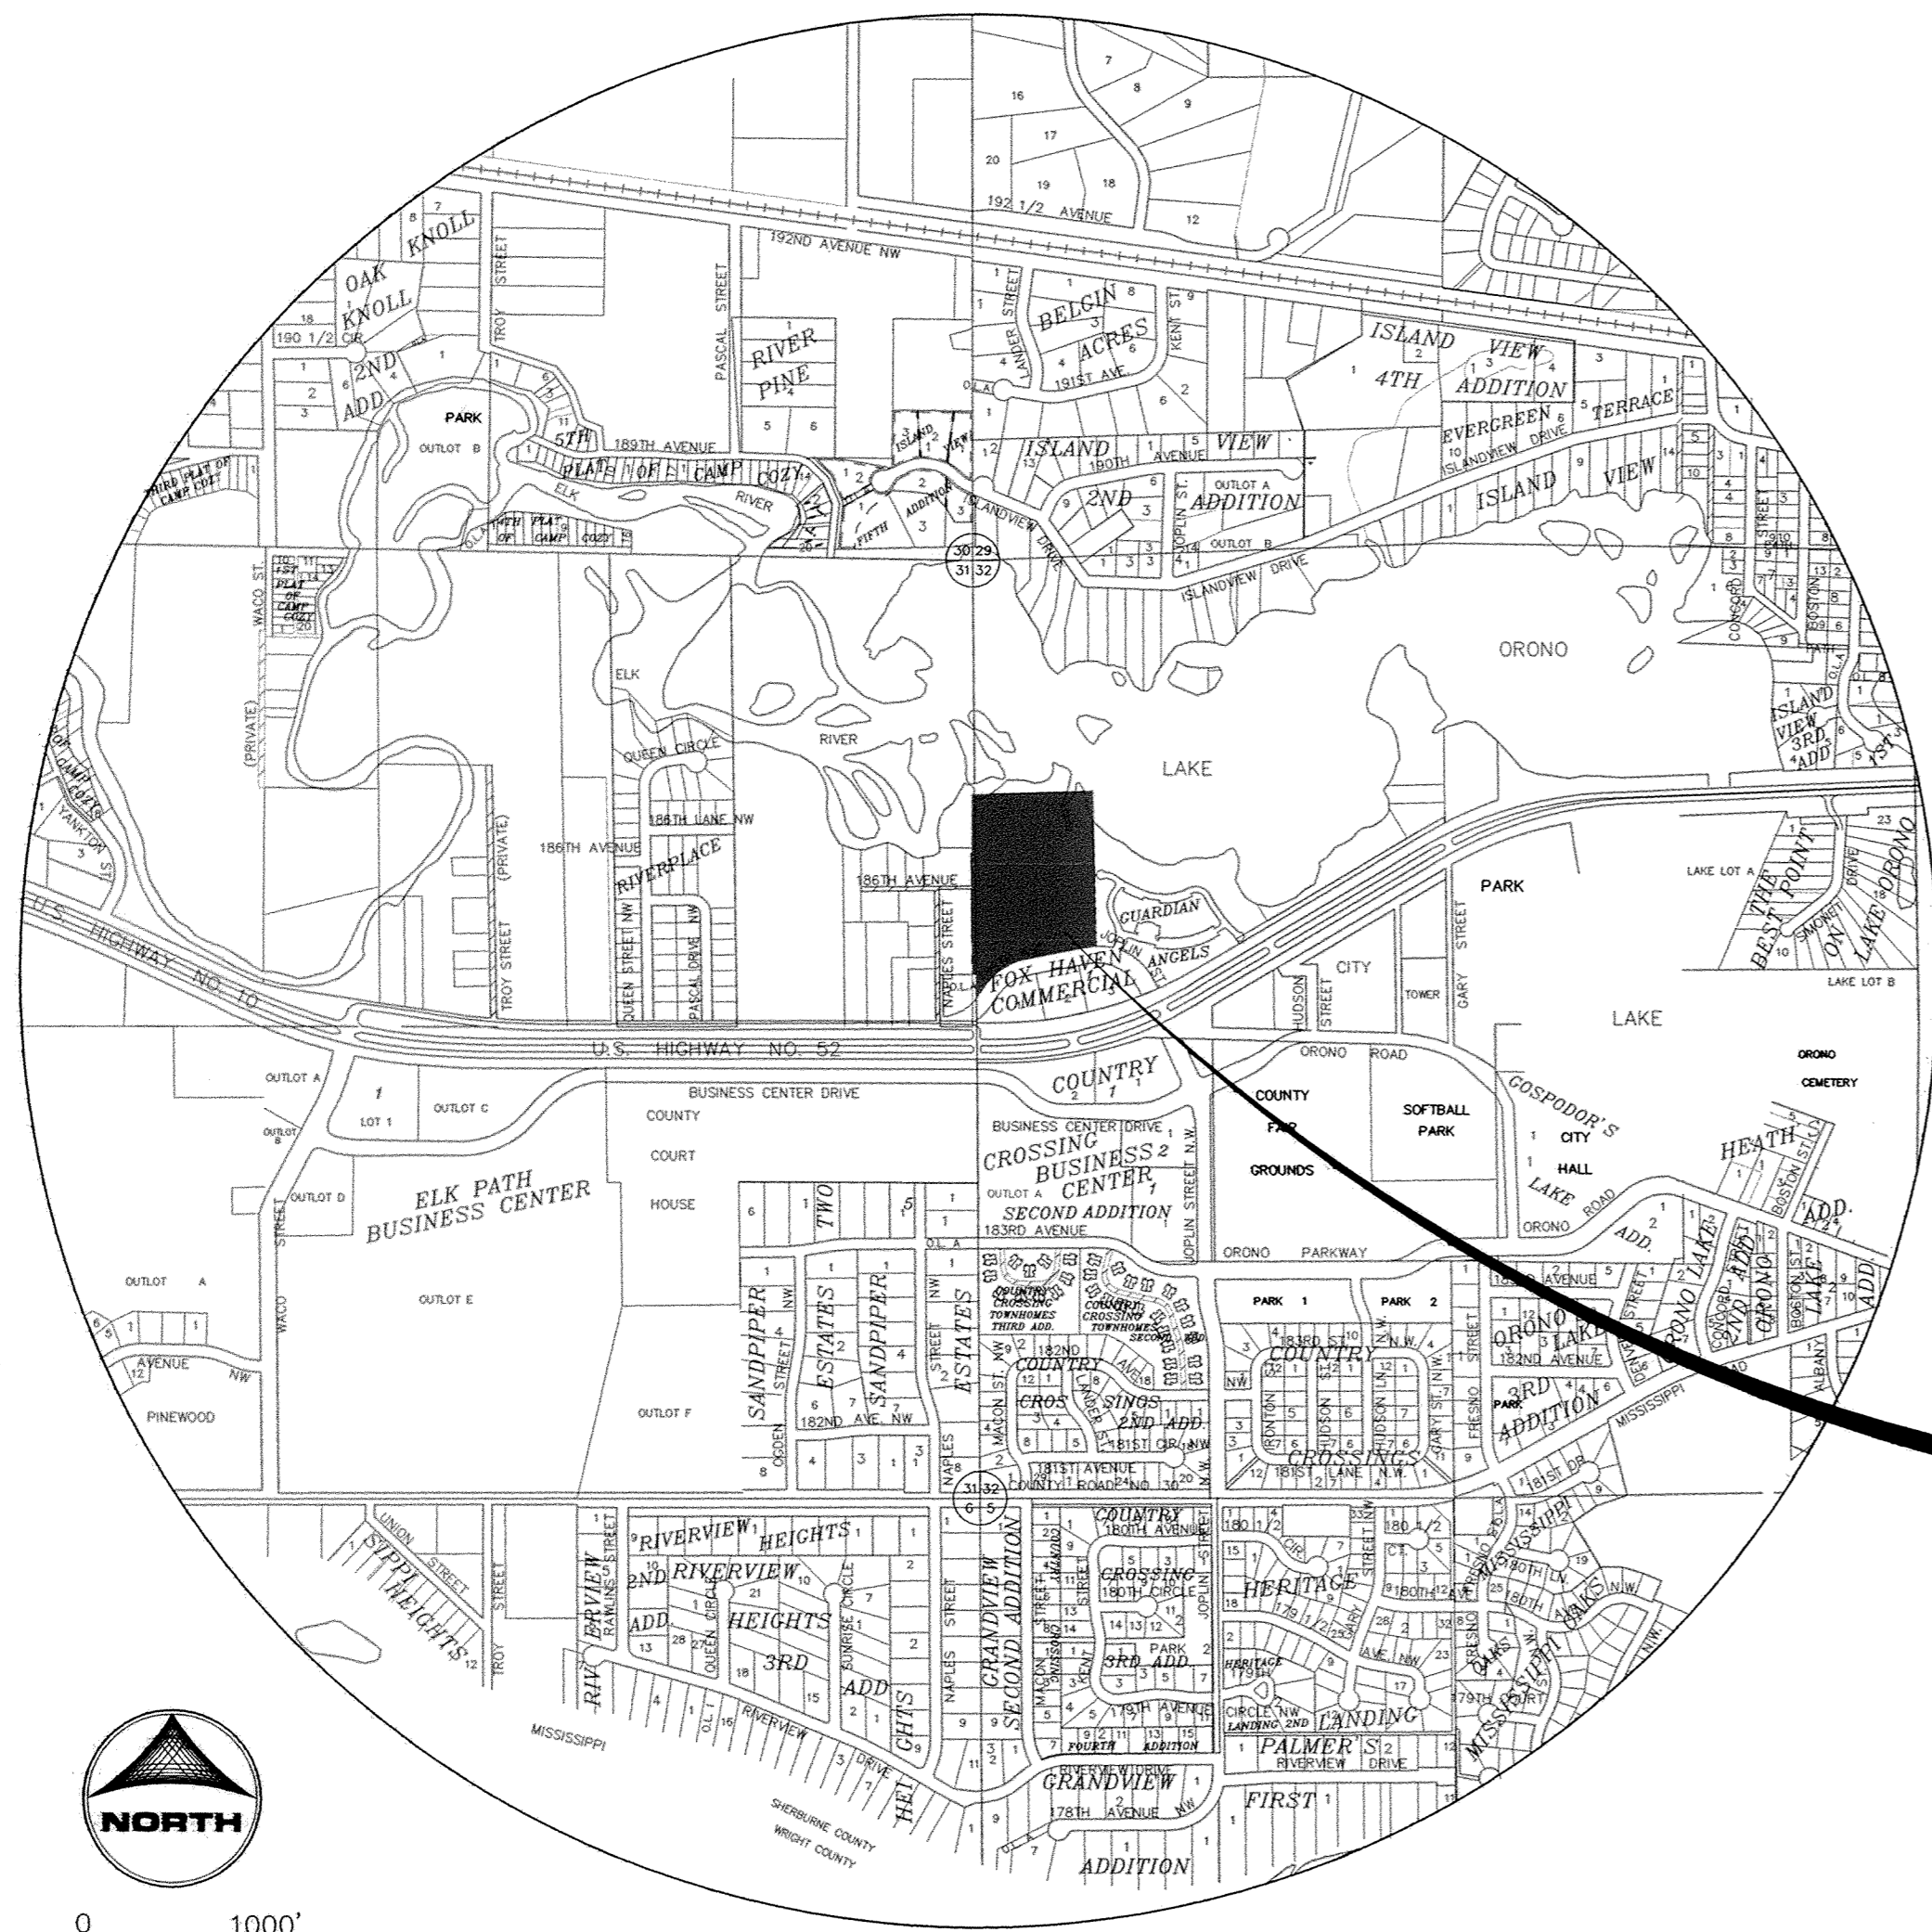

0 1 2 3 4 5 6  
MILES

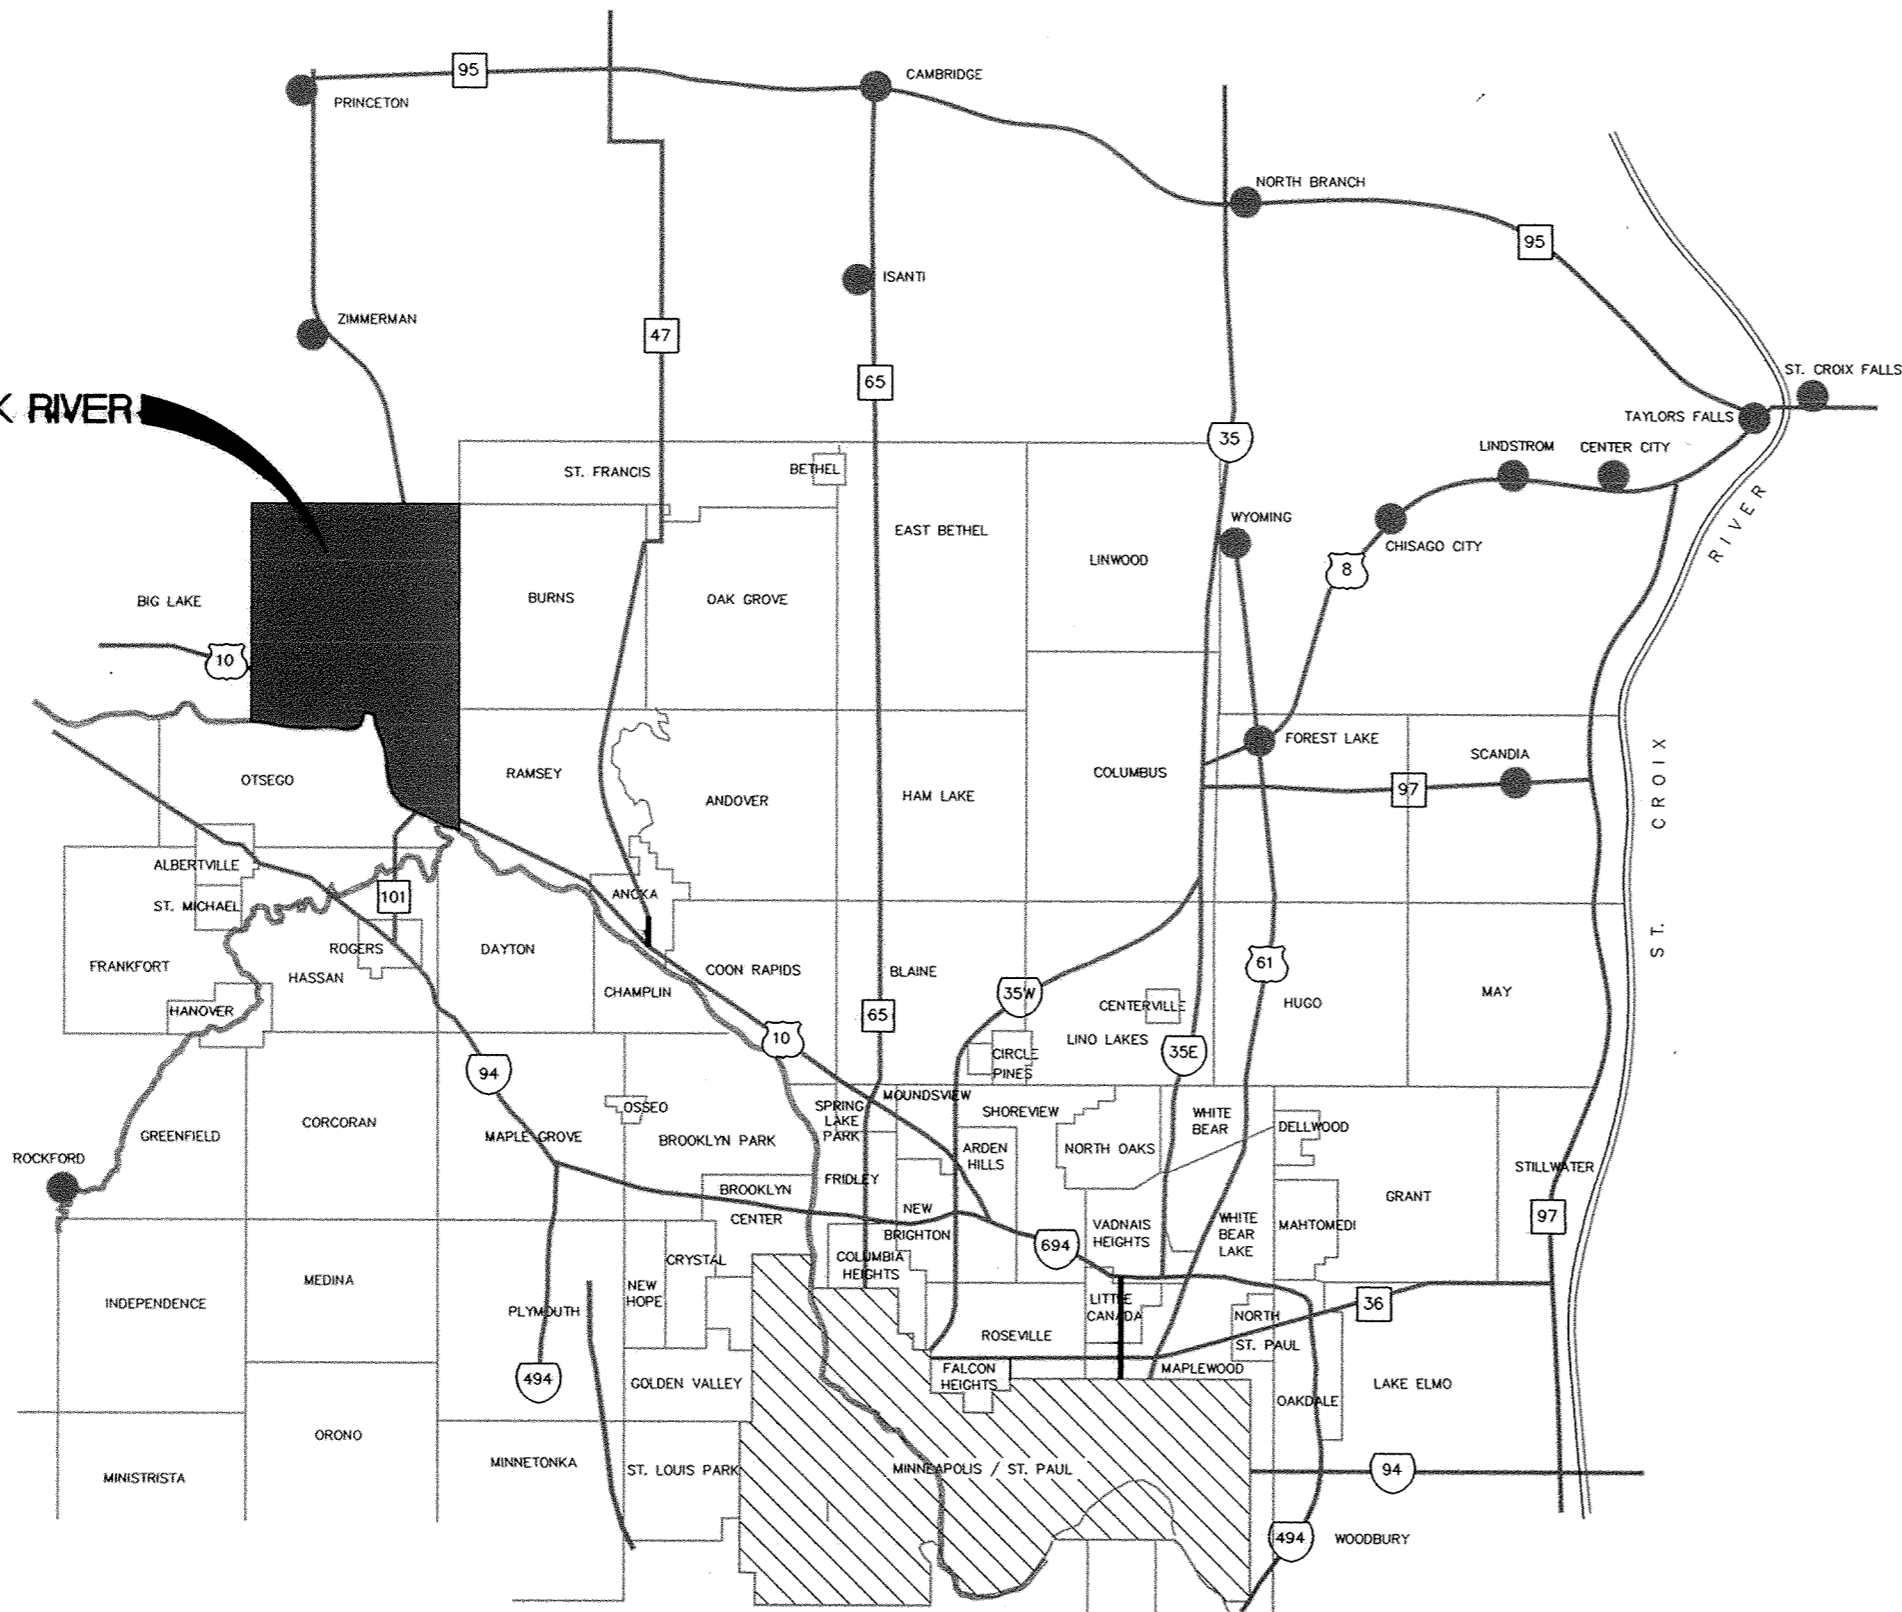

LOCATION MAP

January 20, 2005 7:32:11 a.m.  
810641J\asbuilts\810641-TITLEA.DWG (JCUNNIN)


# FOX HAVEN

## SANITARY SEWER, WATERMAIN, STORM SEWER AND STREET CONSTRUCTION

RECORD PLAN  
JUNE, 2003

I HEREBY CERTIFY THAT THIS PLAN, SPECIFICATION,  
OR REPORT WAS PREPARED BY ME OR UNDER MY DIRECT  
SUPERVISION AND THAT I AM A DULY LICENSED  
PROFESSIONAL ENGINEER UNDER THE LAWS OF THE  
STATE OF MINNESOTA.

*John M. Anderson* JOHN M. ANDERSON  
DATE 3/2/05 LIC. NO. 25889

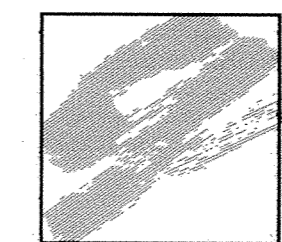

1326 ENERGY PARK DRIVE  
ST. PAUL, MINNESOTA 55108  
(651) 644-4389  
Howard R. Green Company  
CONSULTING ENGINEERS

PREPARED FOR:

DYNAMIC'S DESIGN  
AND LAND CO.

JUNE 2001

SHEET 1 OF 15