
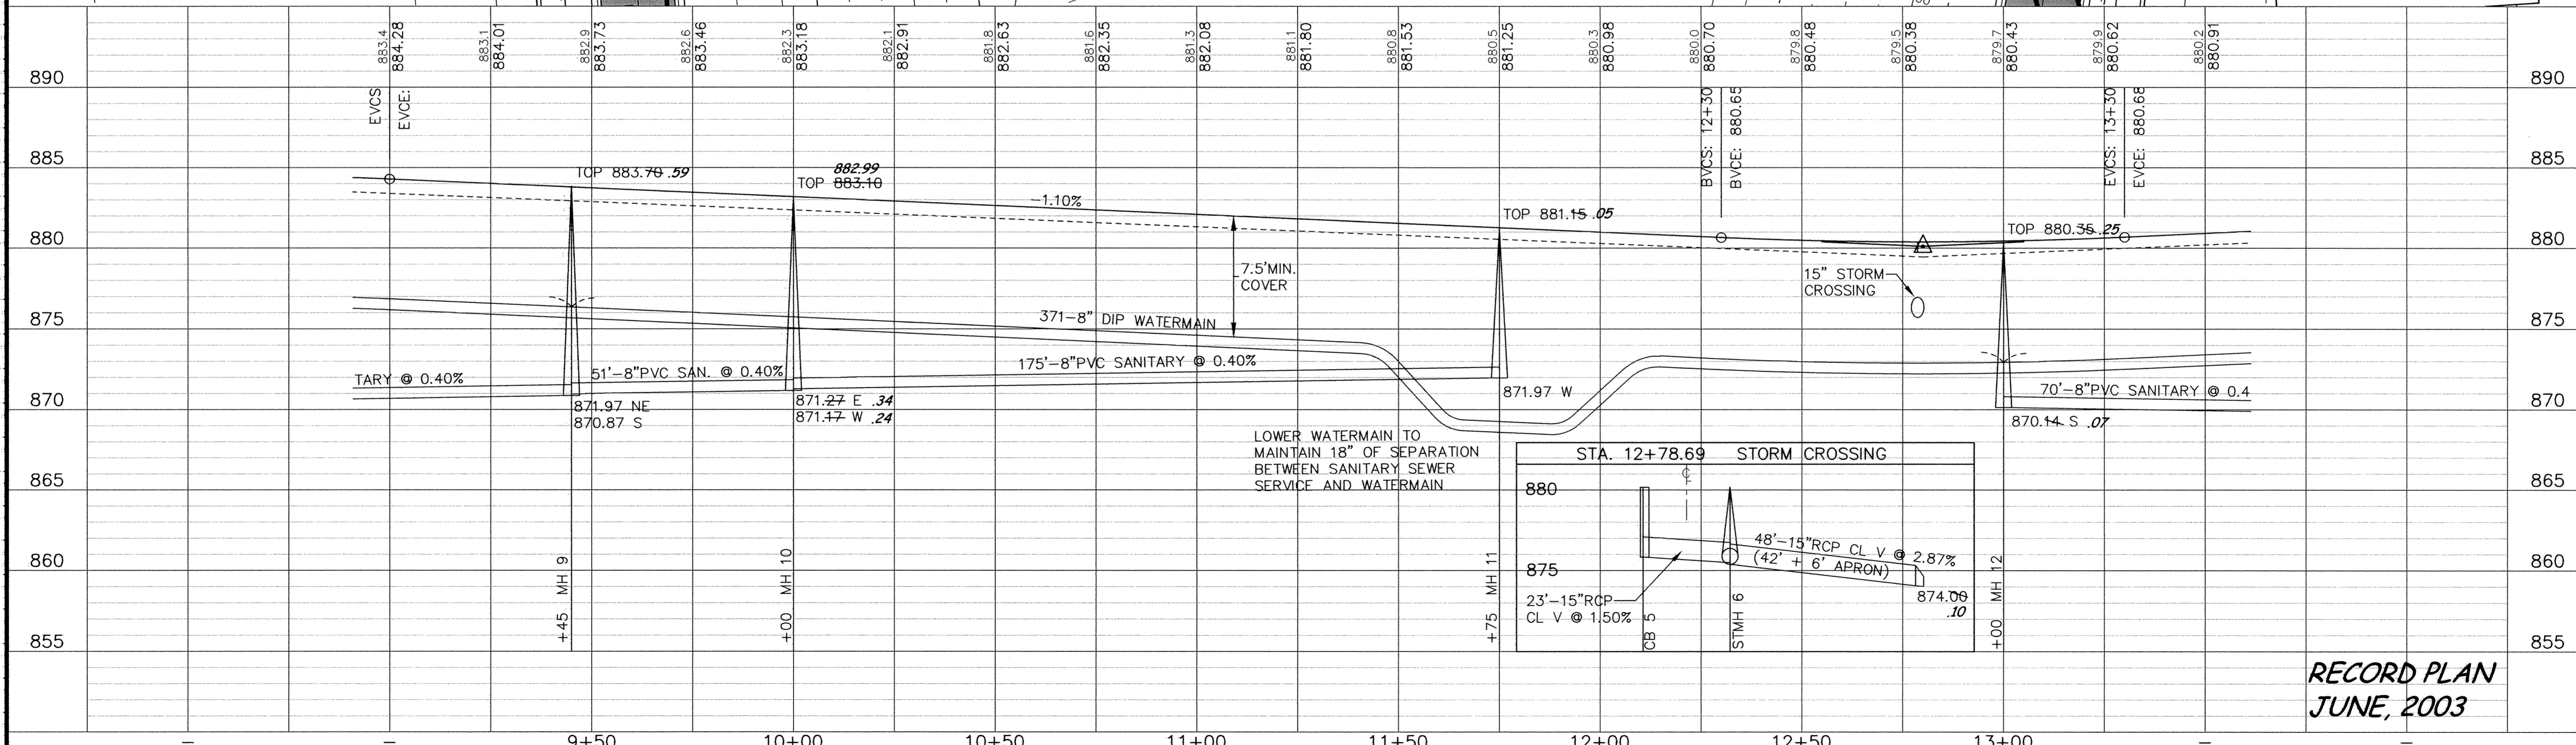


# JOPLIN STREET

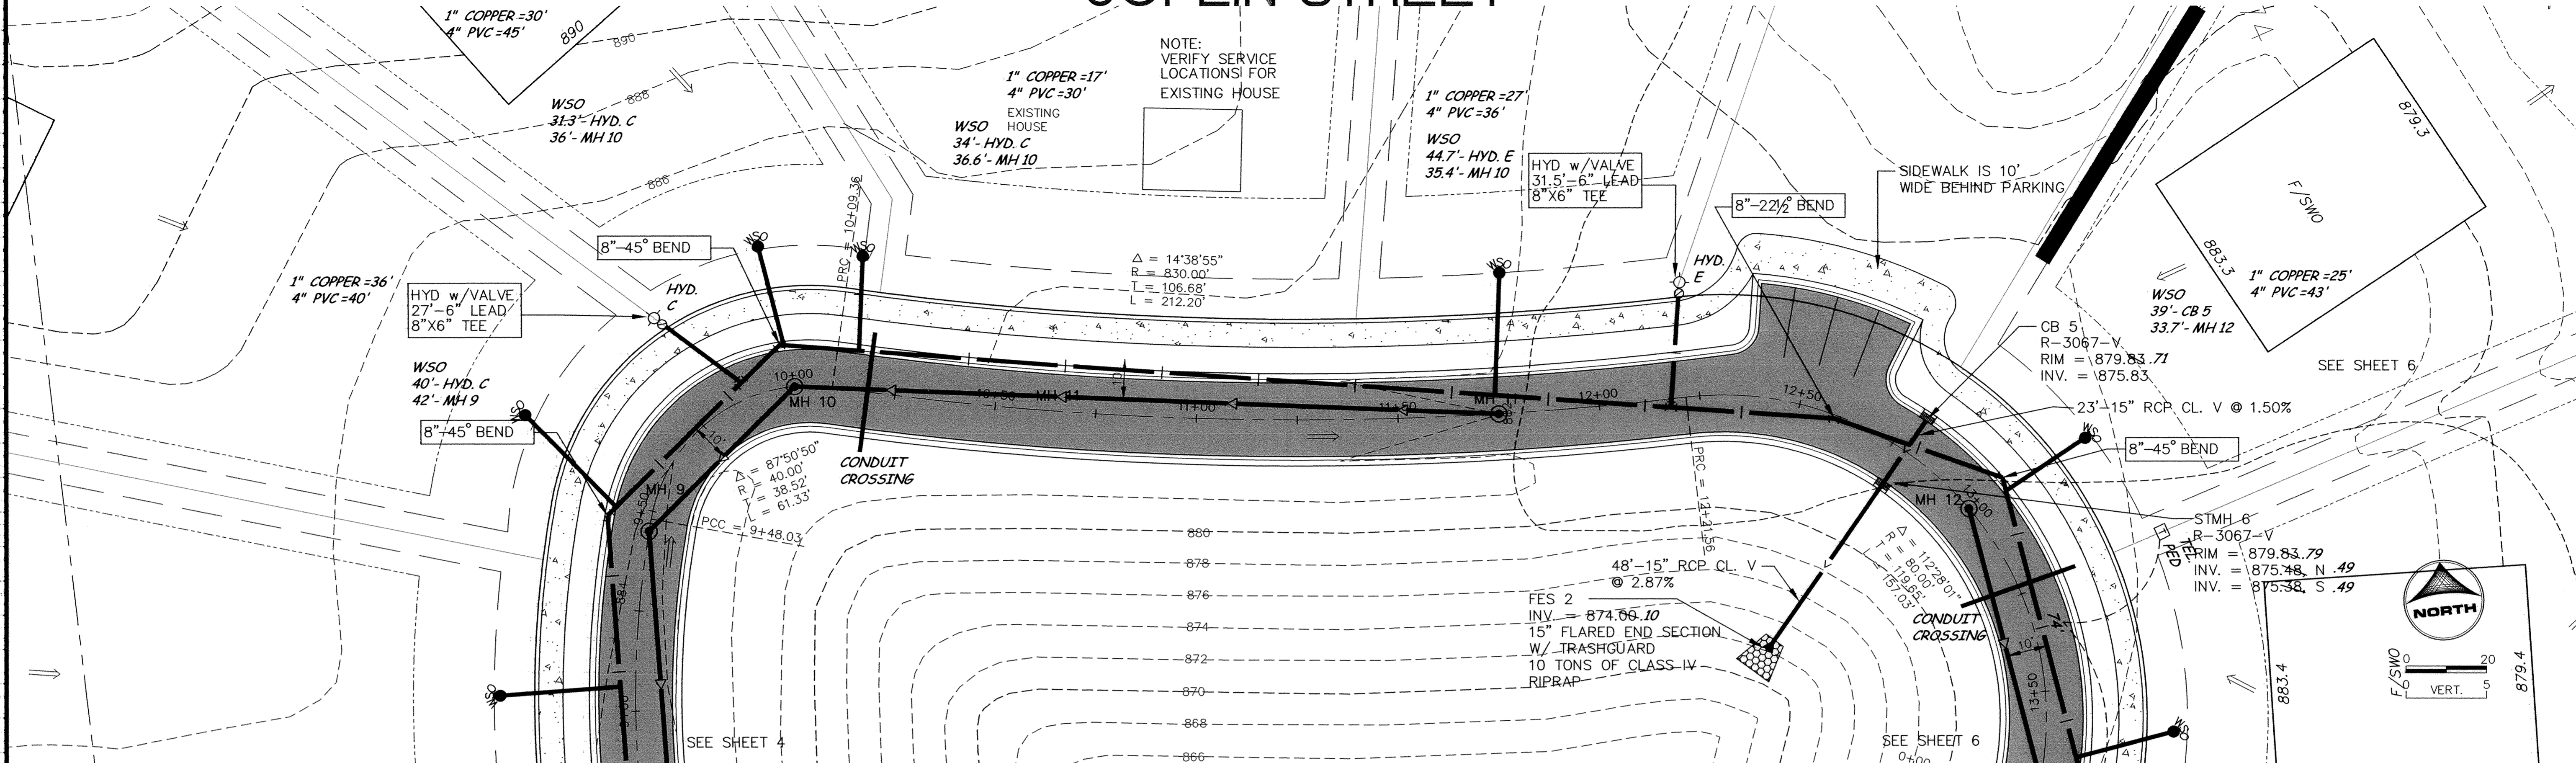

**RECORD PLAN  
JUNE, 2003**

DESIGNED BY: \_\_\_\_\_ DRAWN BY: LK  
 APPROVED BY: \_\_\_\_\_ JOB NUMBER 810641J  
 CAD DATE: January 20, 2005 7:30:35 a.m.  
 CAD FILE: 810641J\asbuilts\810641P4A.DWG (JCUNNIN)

I HEREBY CERTIFY THAT THIS PLAN, SPECIFICATION, OR REPORT WAS PREPARED BY ME OR UNDER MY DIRECT SUPERVISION AND THAT I AM A DULY LICENSED PROFESSIONAL ENGINEER UNDER THE LAWS OF THE STATE OF MINNESOTA.  
 SIGNATURE: *John M. Anderson* DATE: 2/2/05  
 PRINTED NAME: JOHN M. ANDERSON LIC. NO. 25889

NO.	DATE	BY	REVISION DESCRIPTION

**Howard R. Green Company**  
 CONSULTING ENGINEERS  
 1326 ENERGY PARK DRIVE  
 ST. PAUL, MINNESOTA 55108  
 (612) 644-4389

**FOX HAVEN**  
 CITY OF ELK RIVER

PLAN AND PROFILE  
**JOPLIN STREET**  
 STA. 9+45 TO 13+00

SHEET NO.  
**5**

SACD PRODUCTS • NEW HARBUR, MINNESOTA  
 PROJECT NO. 810641  
 SHEET NO. 5 OF 5  
 PRINTED DATE: 02/02/05 10:00 AM