
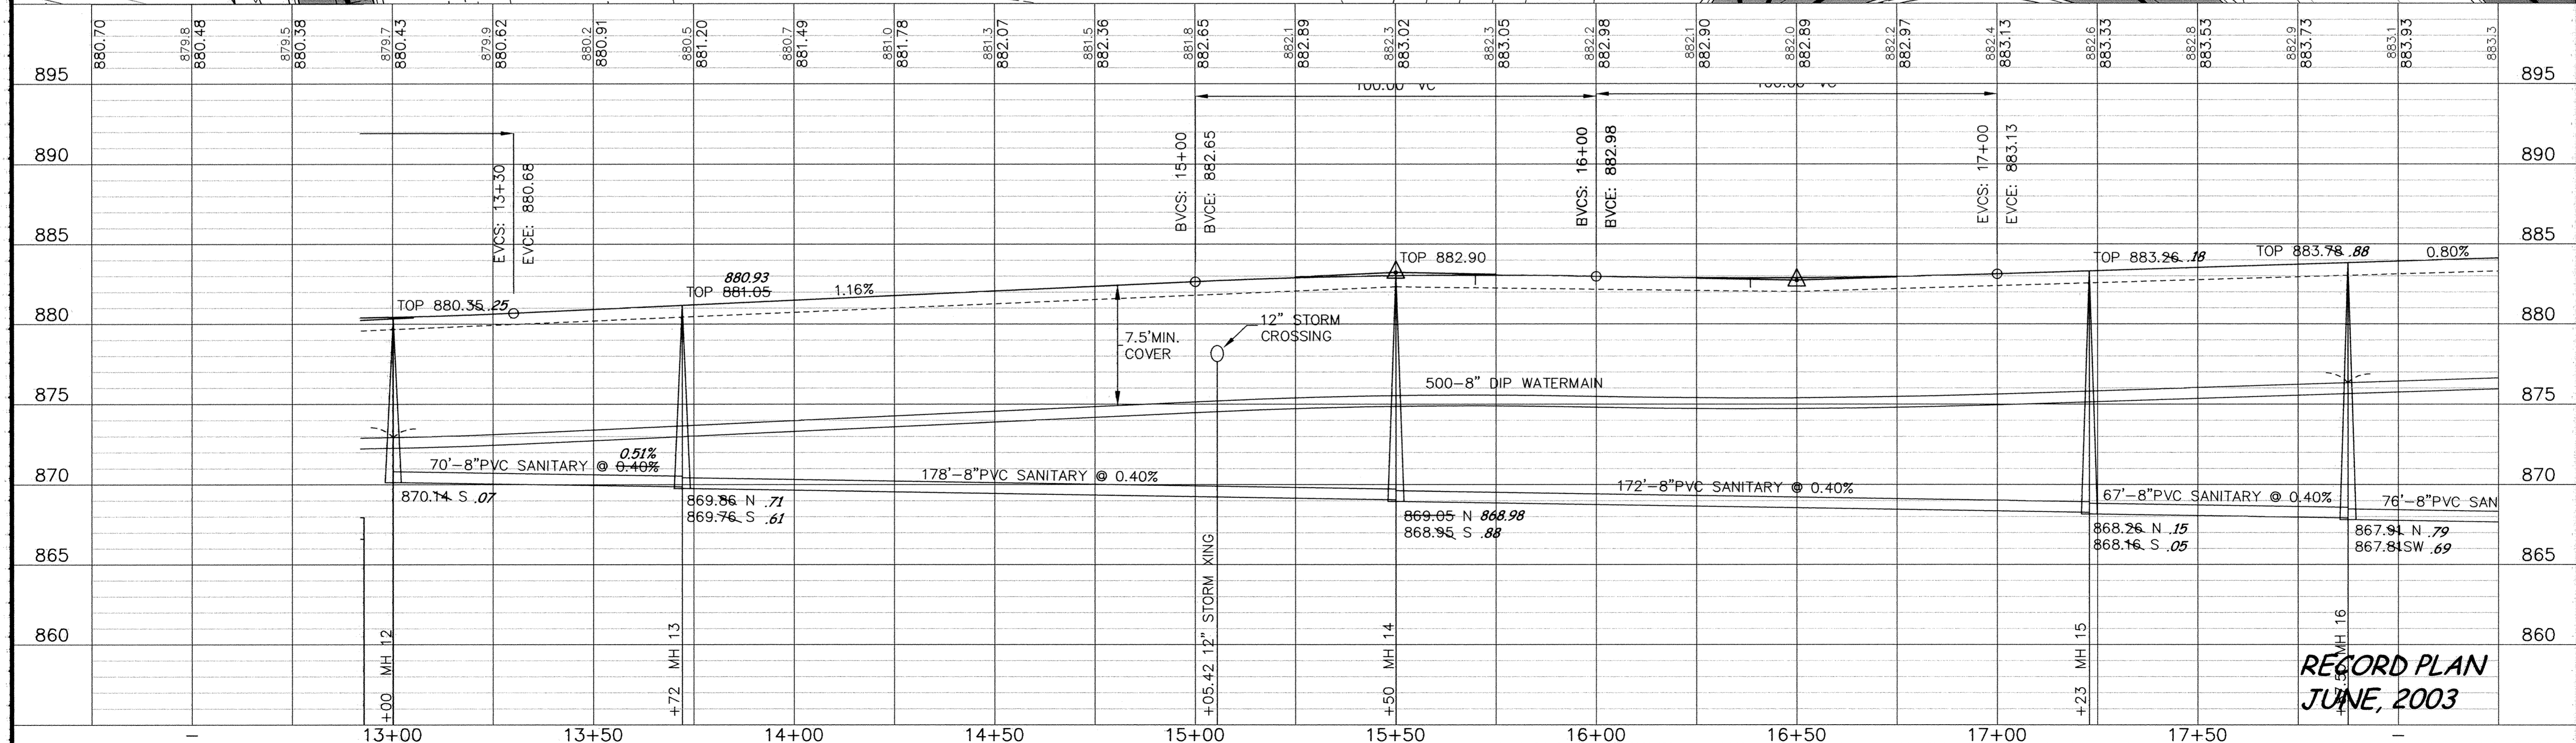


# JOPLIN STREET

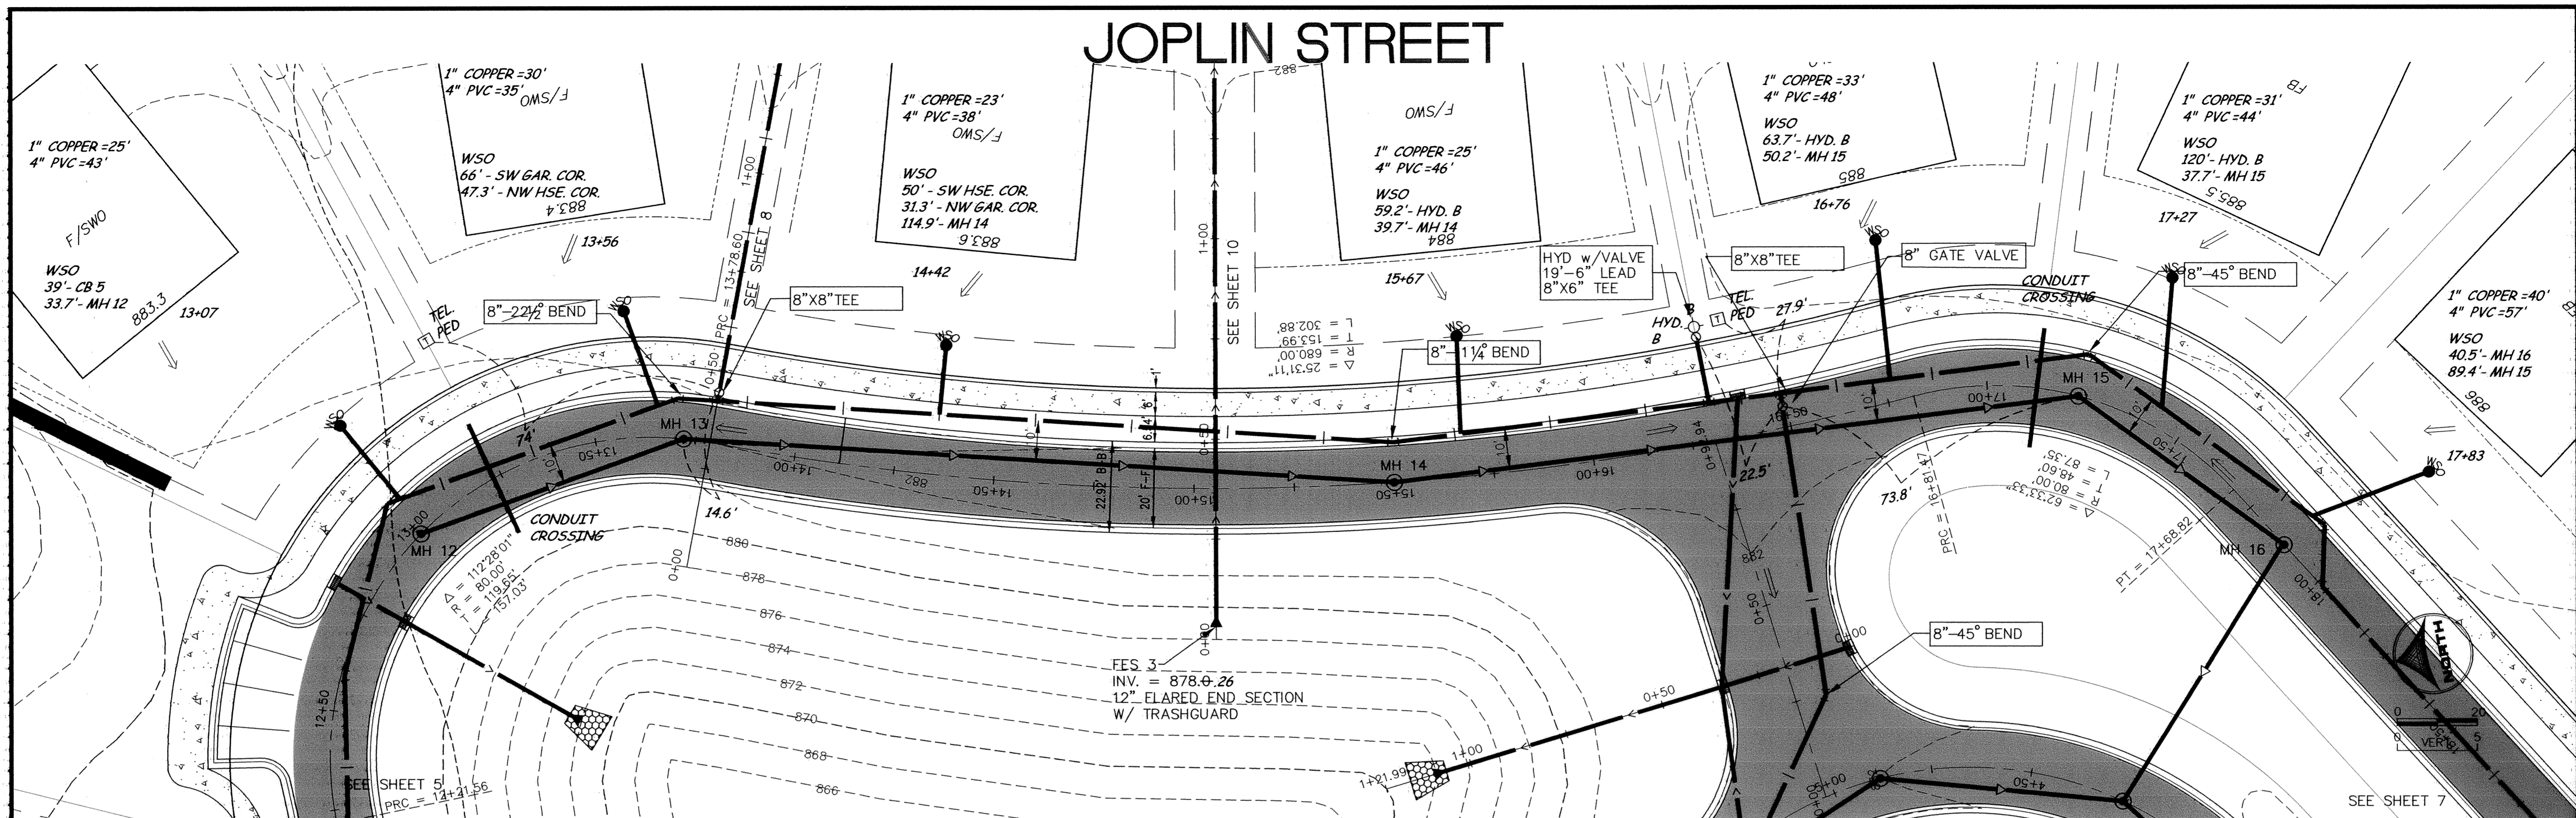

RECORD PLAN  
JUNE, 2003

DESIGNED BY: \_\_\_\_\_ DRAWN BY: LK  
 APPROVED BY: \_\_\_\_\_ JOB NUMBER 810641J  
 CAD DATE: January 20, 2005 2:15:51 p.m.  
 CAD FILE: 810641J\asbuit\810641P5A.DWG (JCUNNIN)

I HEREBY CERTIFY THAT THIS PLAN, SPECIFICATION, OR REPORT WAS PREPARED BY ME OR UNDER MY DIRECT SUPERVISION AND THAT I AM A DULY LICENSED PROFESSIONAL ENGINEER UNDER THE LAWS OF THE STATE OF MINNESOTA.  
 SIGNATURE: *John M. Anderson* DATE: 2/2/05  
 PRINTED NAME: JOHN M. ANDERSON LIC. NO. 25889

NO.	DATE	BY	REVISION DESCRIPTION

1326 ENERGY PARK DRIVE  
 ST. PAUL, MINNESOTA 55108  
 (612) 644-4389  
**Howard R. Green Company**  
 CONSULTING ENGINEERS

FOX HAVEN  
 CITY OF ELK RIVER

PLAN AND PROFILE  
 JOPLIN STREET  
 STA. 13+00 TO 17+87.50

SHEET NO.  
**6**

FOXHAVA05  
 6  
 SAPIO PRODUCTS • NEW JERSEY, MINNESOTA  
 REPRODUCED BY PART NUMBER 8552  
 SAPIO PRODUCTS • NEW JERSEY, MINNESOTA  
 REPRODUCED BY PART NUMBER 8552  
 SAPIO PRODUCTS • NEW JERSEY, MINNESOTA  
 REPRODUCED BY PART NUMBER 8552