
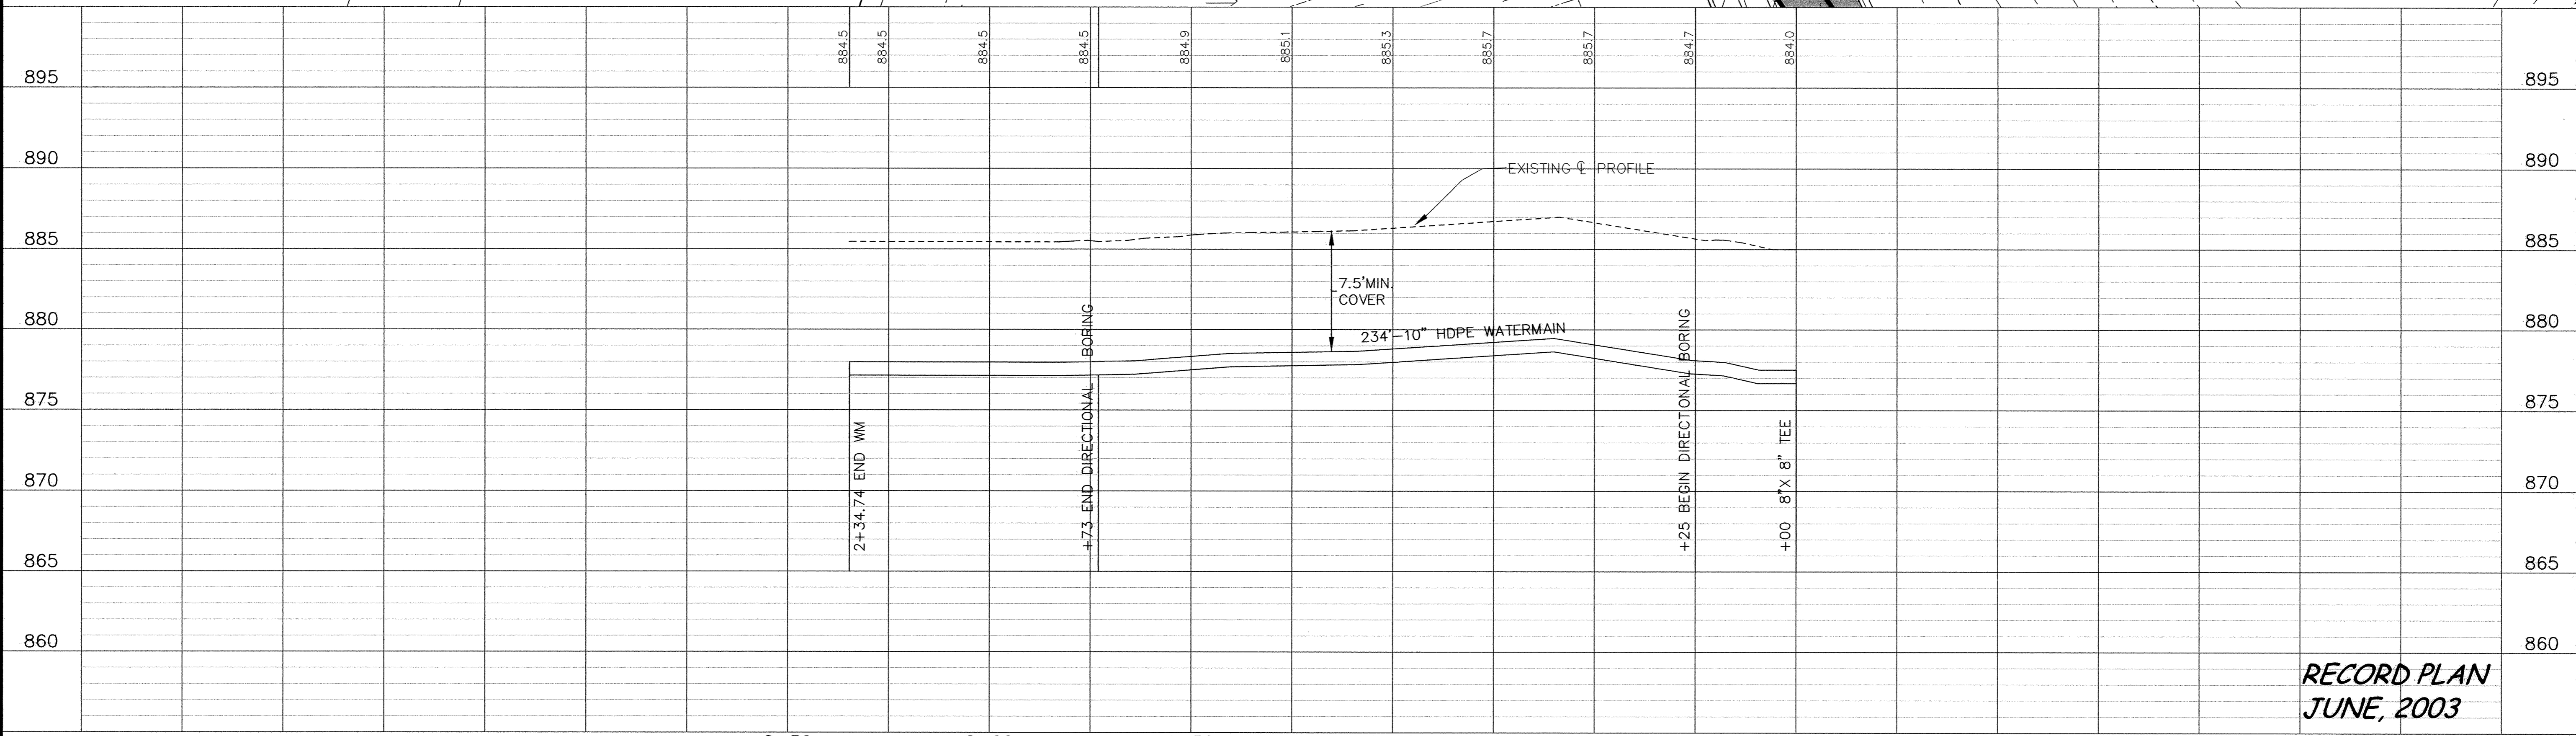


WATERMAIN WEST

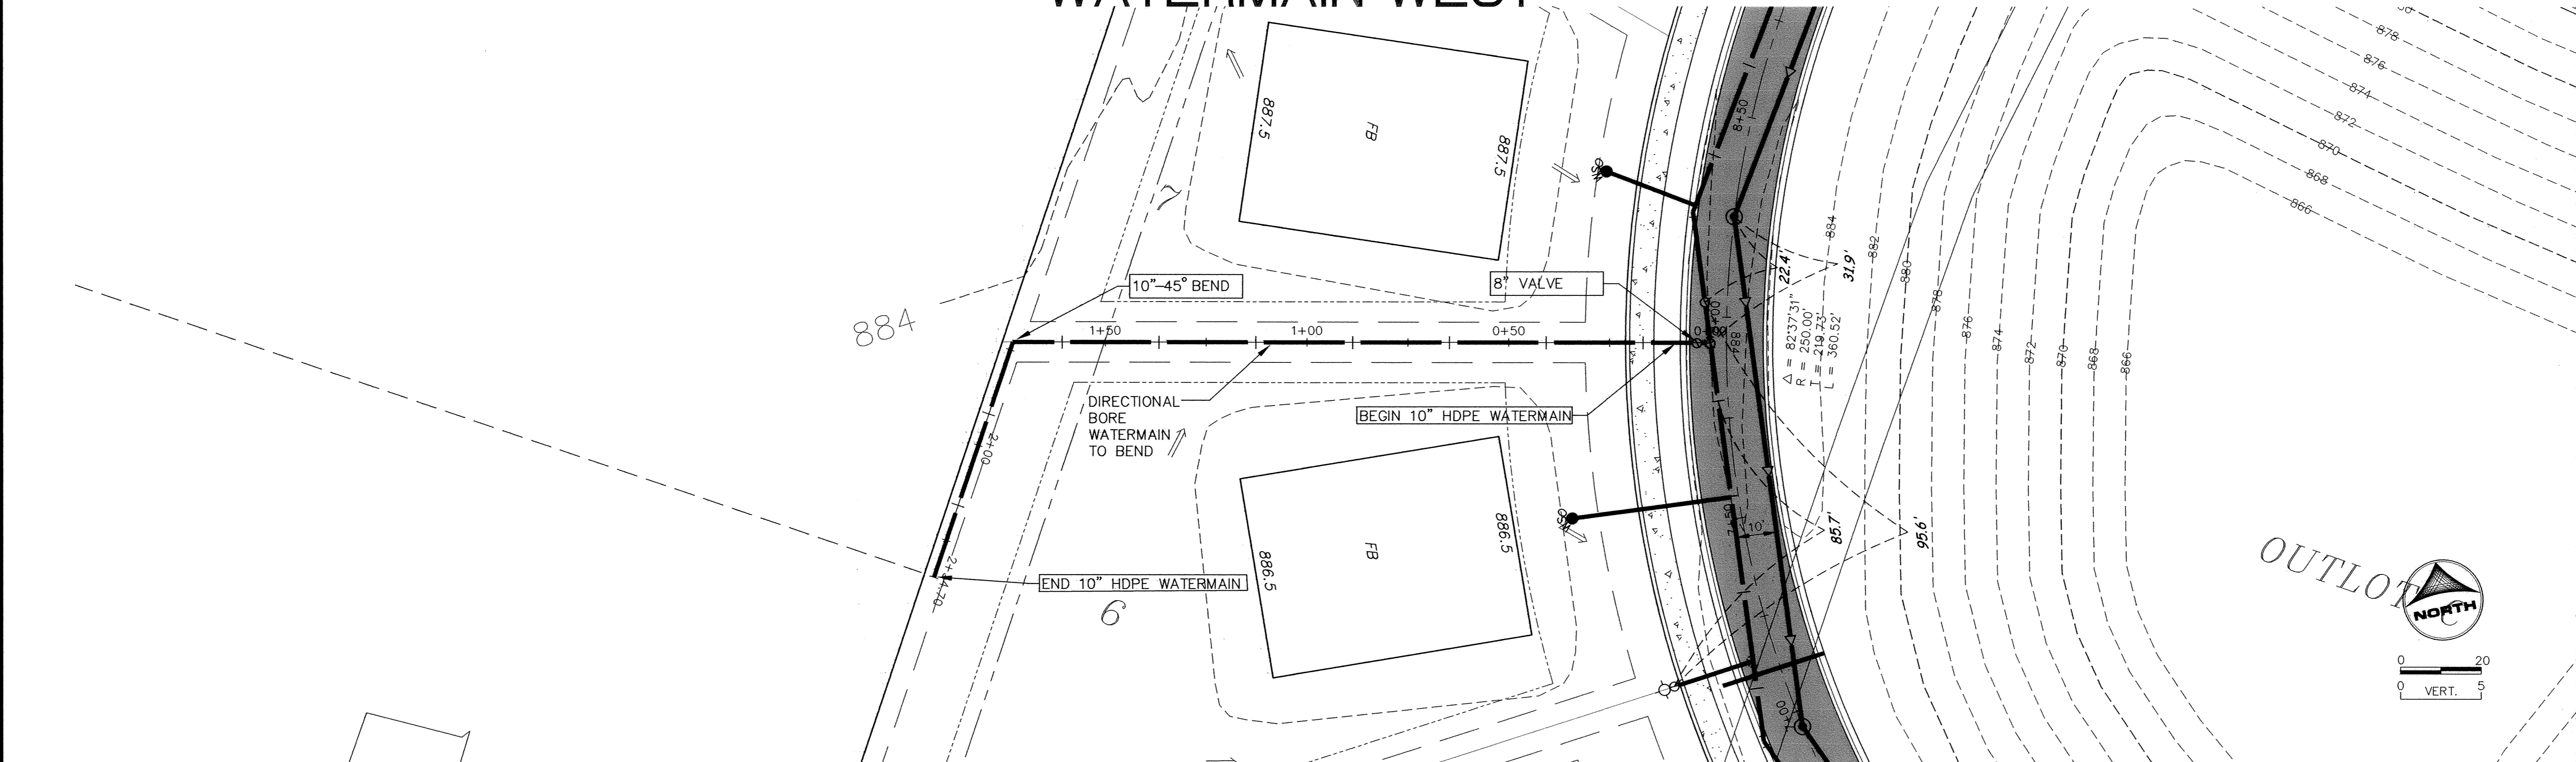

**RECORD PLAN
JUNE, 2003**

DESIGNED BY: _____ DRAWN BY: LK
 APPROVED BY: _____ JOB NUMBER 810641J
 CAD DATE: January 20, 2005 2:21:47 p.m.
 CAD FILE: 810641J\asbuilts\810641PBA.DWG (JCUNNIN)

I HEREBY CERTIFY THAT THIS PLAN, SPECIFICATION, OR REPORT WAS PREPARED BY ME OR UNDER MY DIRECT SUPERVISION AND THAT I AM A DULY LICENSED PROFESSIONAL ENGINEER UNDER THE LAWS OF THE STATE OF MINNESOTA.
 SIGNATURE: *John M. Anderson* DATE: 2/2/05
 PRINTED NAME: JOHN M. ANDERSON LIC. NO. 25889

NO.	DATE	BY	REVISION DESCRIPTION

1326 ENERGY PARK DRIVE
ST. PAUL, MINNESOTA 55108
(612) 644-4389

Howard R. Green Company
CONSULTING ENGINEERS

FOX HAVEN
CITY OF ELK RIVER

PLAN AND PROFILE
WATERMAIN WEST
STA. 0+00 TO 1+93.50

SHEET NO.
9

SDACD PRODUCTS - NEW HOPE, MINNESOTA
 REORDER BY PART NUMBER 8552
 FOXHAVA.05
 9