


WATERMAIN

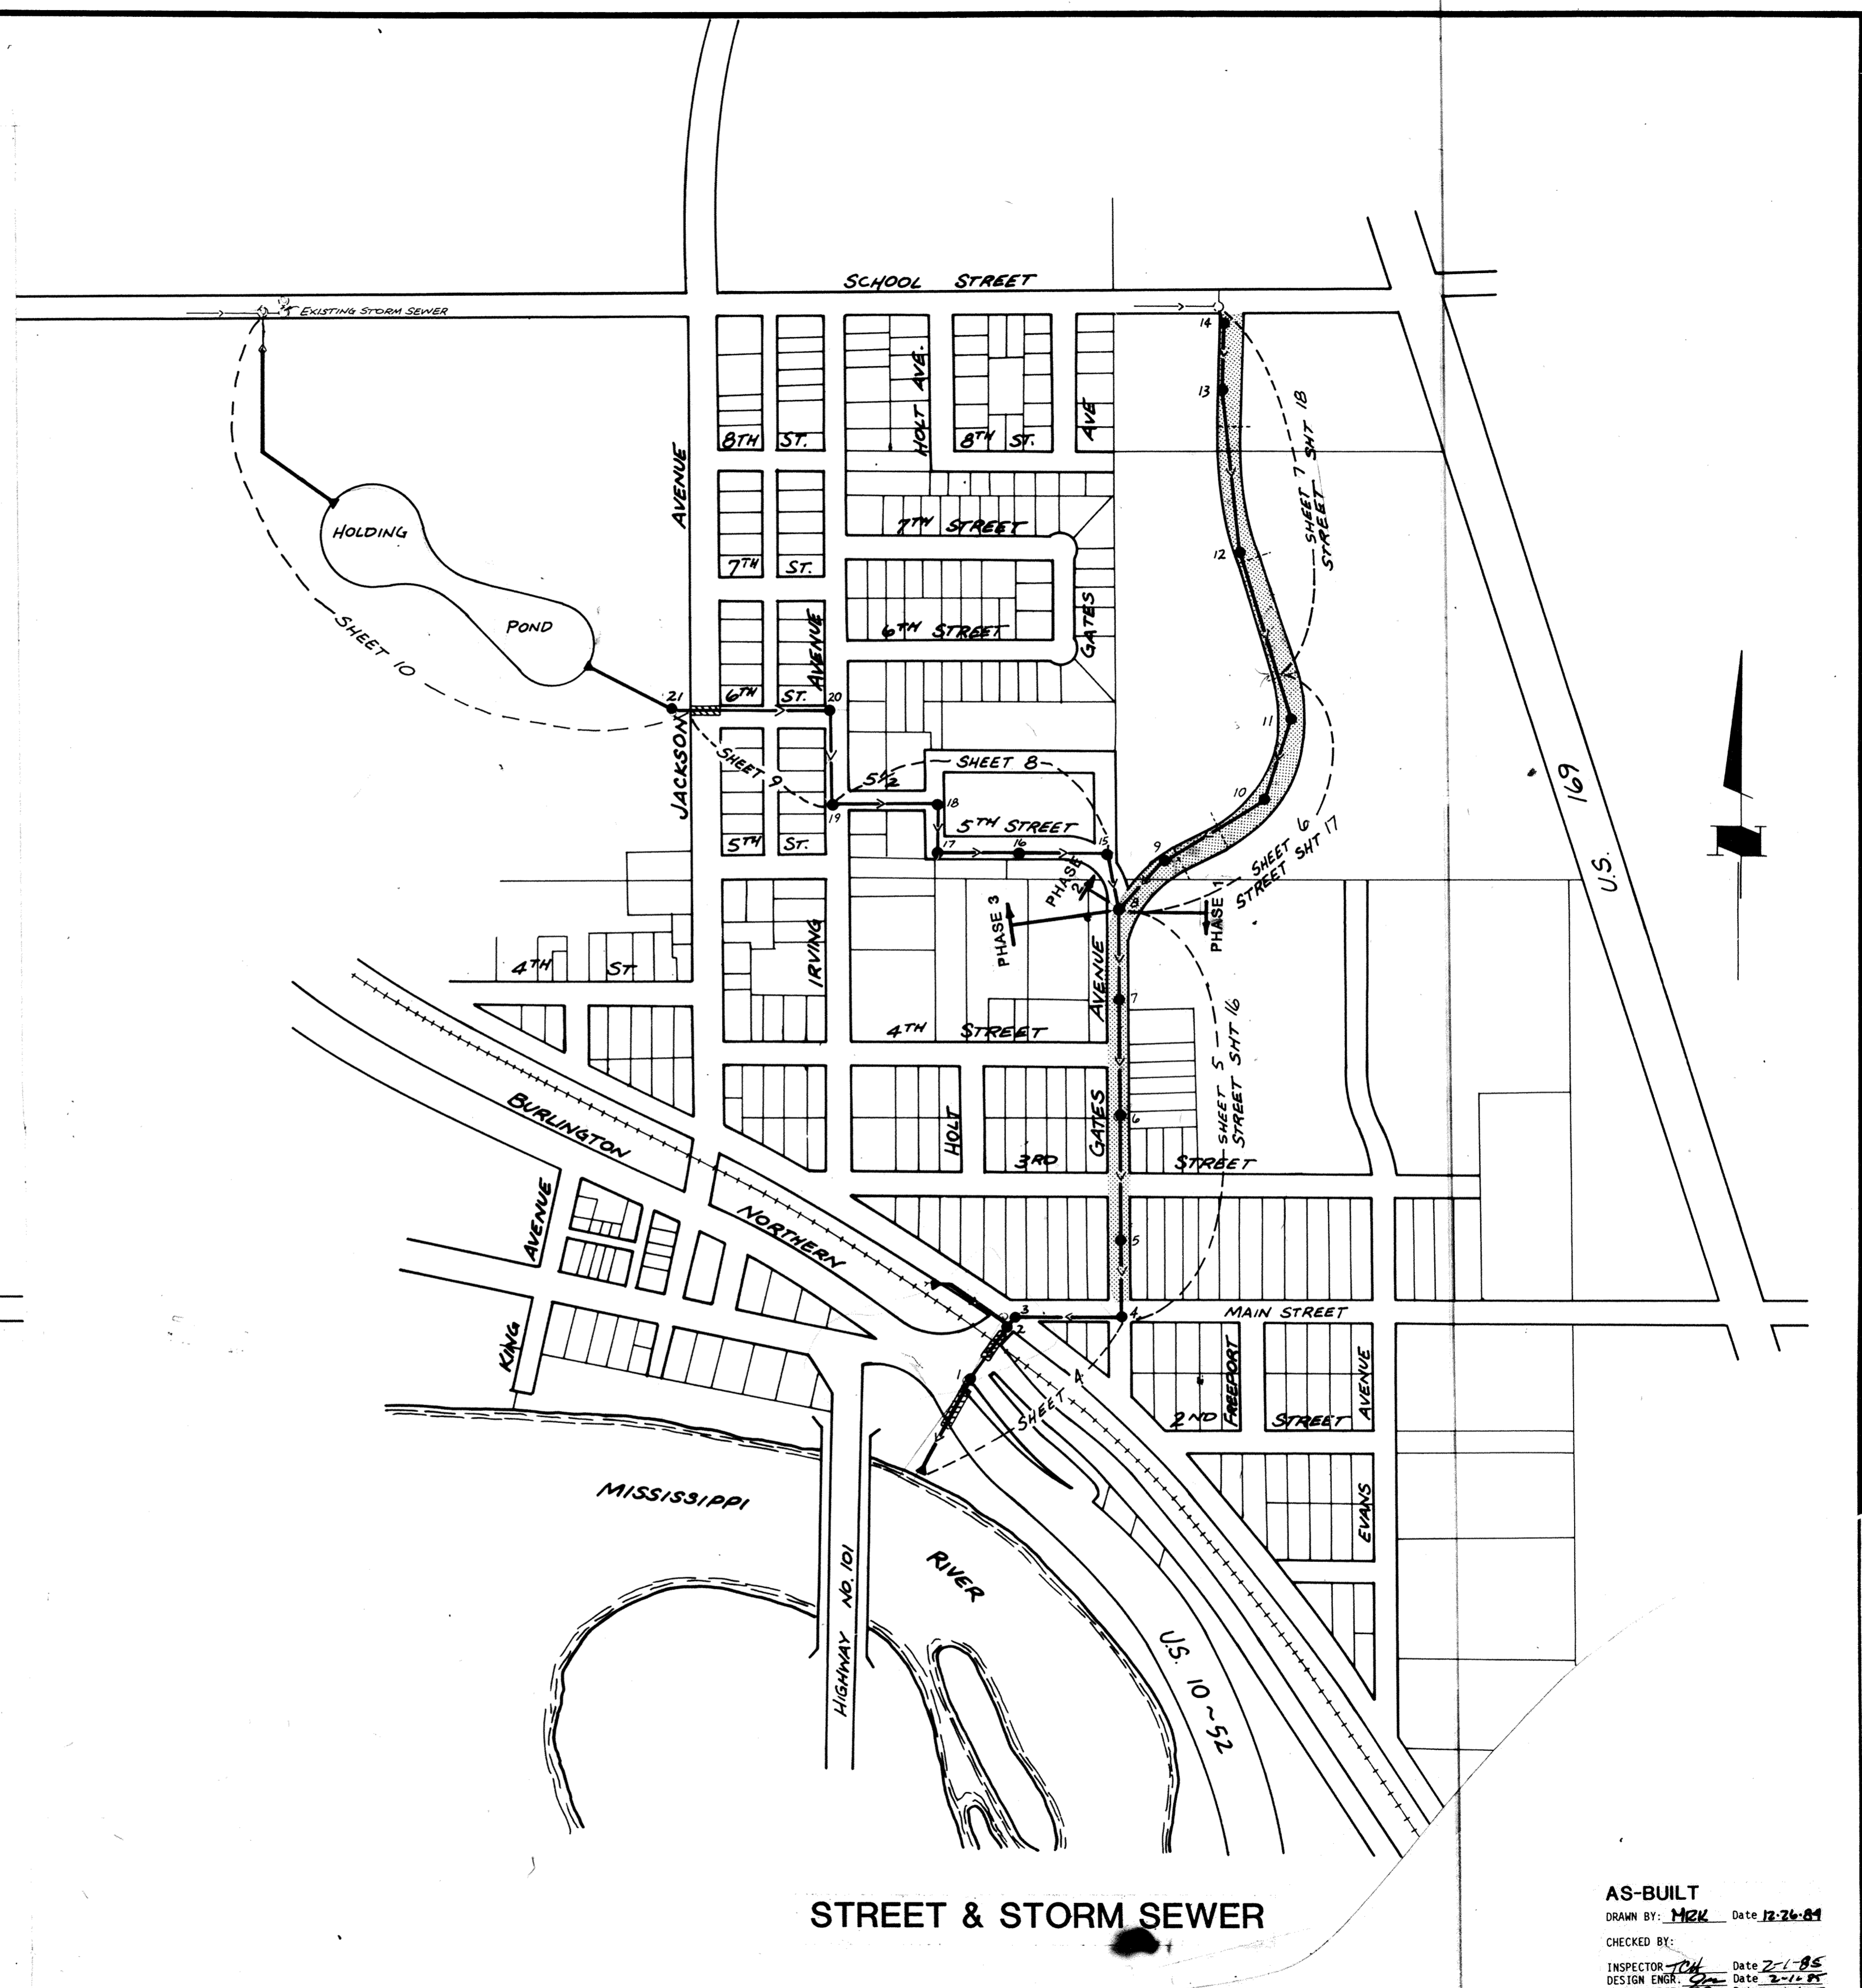

STREET & STORM SEWER

AS-BUILT  
 DRAWN BY: MRK Date: 12-26-84  
 CHECKED BY:  
 INSPECTOR: TCH Date: 2-1-85  
 DESIGN ENGR: GR Date: 2-1-85  
 PARTY CHIEF: SS Date: 2-1-85

I hereby certify that this plan, specification or report was prepared by me or under my direct supervision and that I am a duly Registered Professional Engineer under the State of Minn. Statutes Sections 326.02 to 326.16.  
Terry J. Maurer  
 Date: 3/1/83 Minn. Reg. No. 15316

consulting engineers diversified inc. **ED**  
 po box 10880 minneapolis 55436-0880 • (612) 425-2181

REVISIONS  
 DESIGNED BY  
 CHECKED BY  
 DRAWN BY: MRK  
 DATE: DEC 1982

CITY OF ELK RIVER  
 STORM SEWER PROJECT  
 LOCATION MAP  
 BK. \_\_\_\_\_ PG. \_\_\_\_\_ DATE: DEC 1982 SHEET 3 OF 27 SHEETS FILE NO. ER402.02