



# GATES AVENUE

DRAWING NUMBER

DRAWING NUMBER

DRAWING NUMBER

DRAWING NUMBER

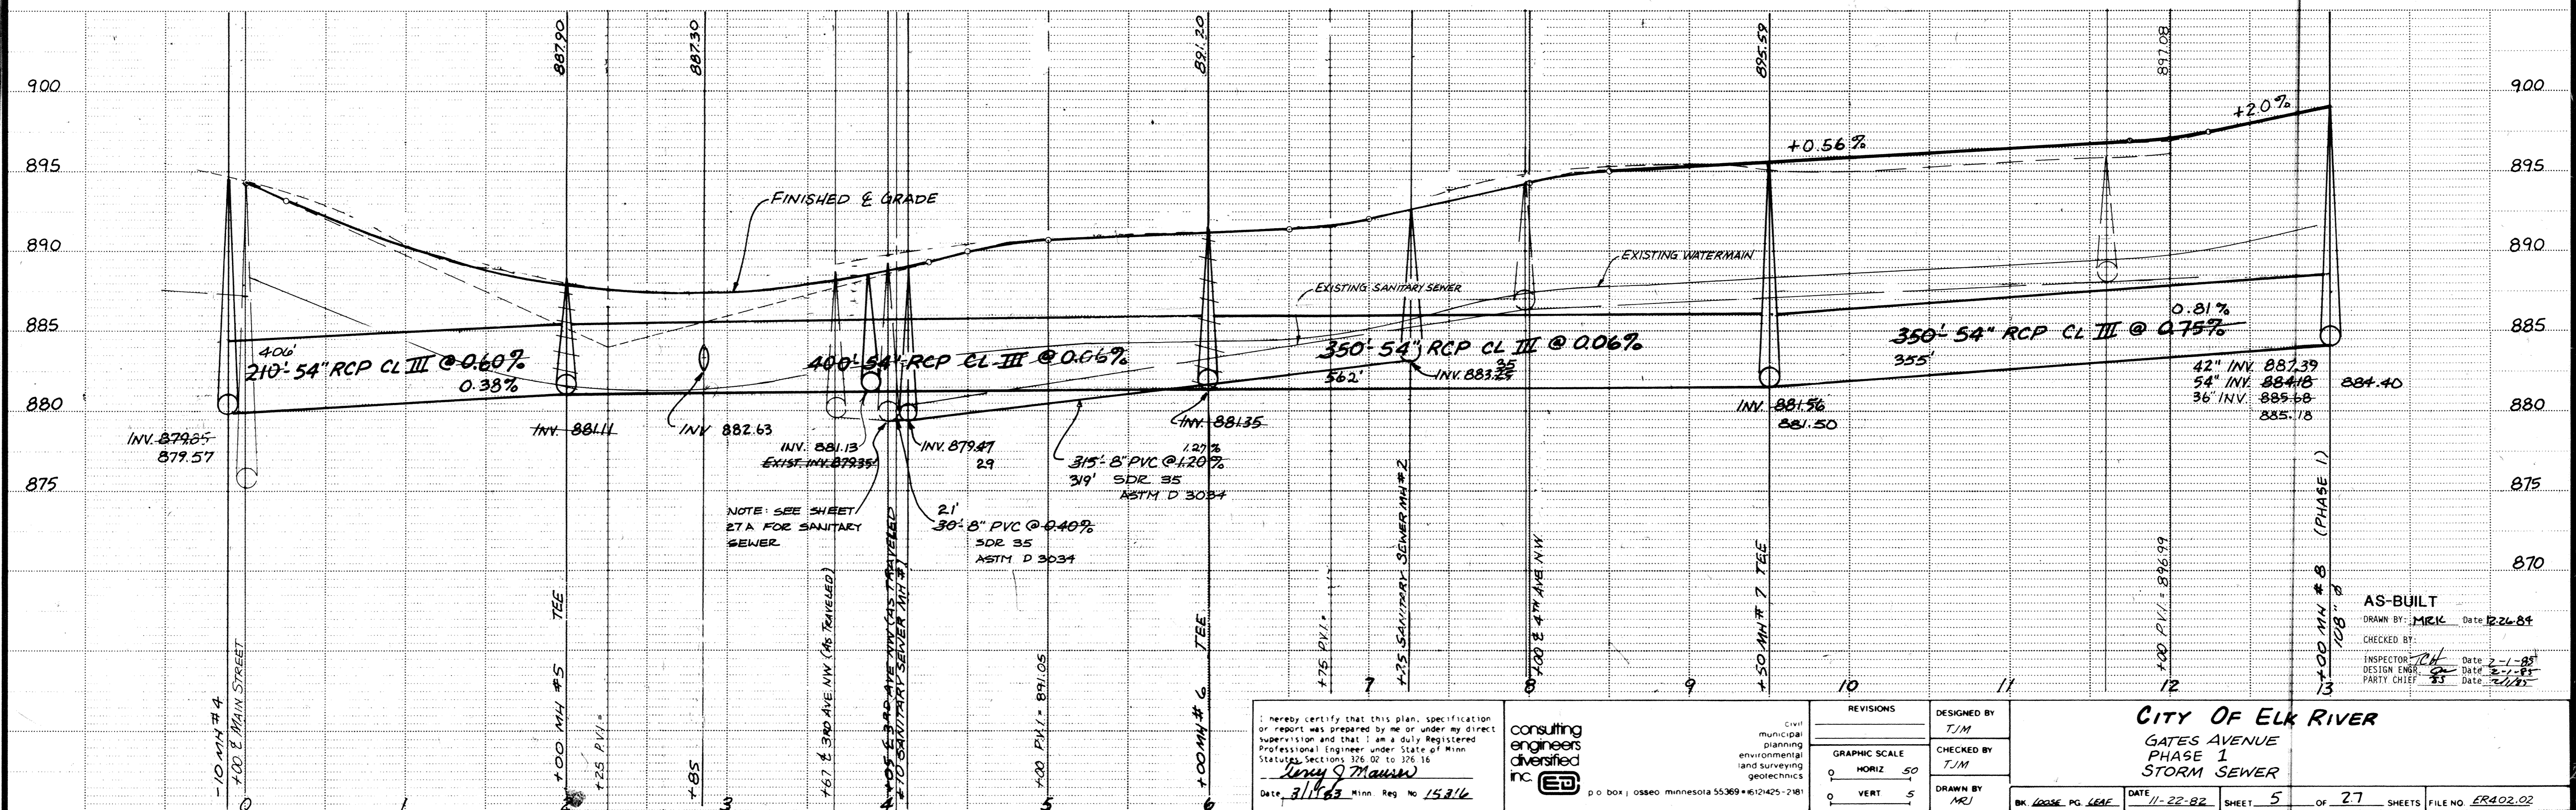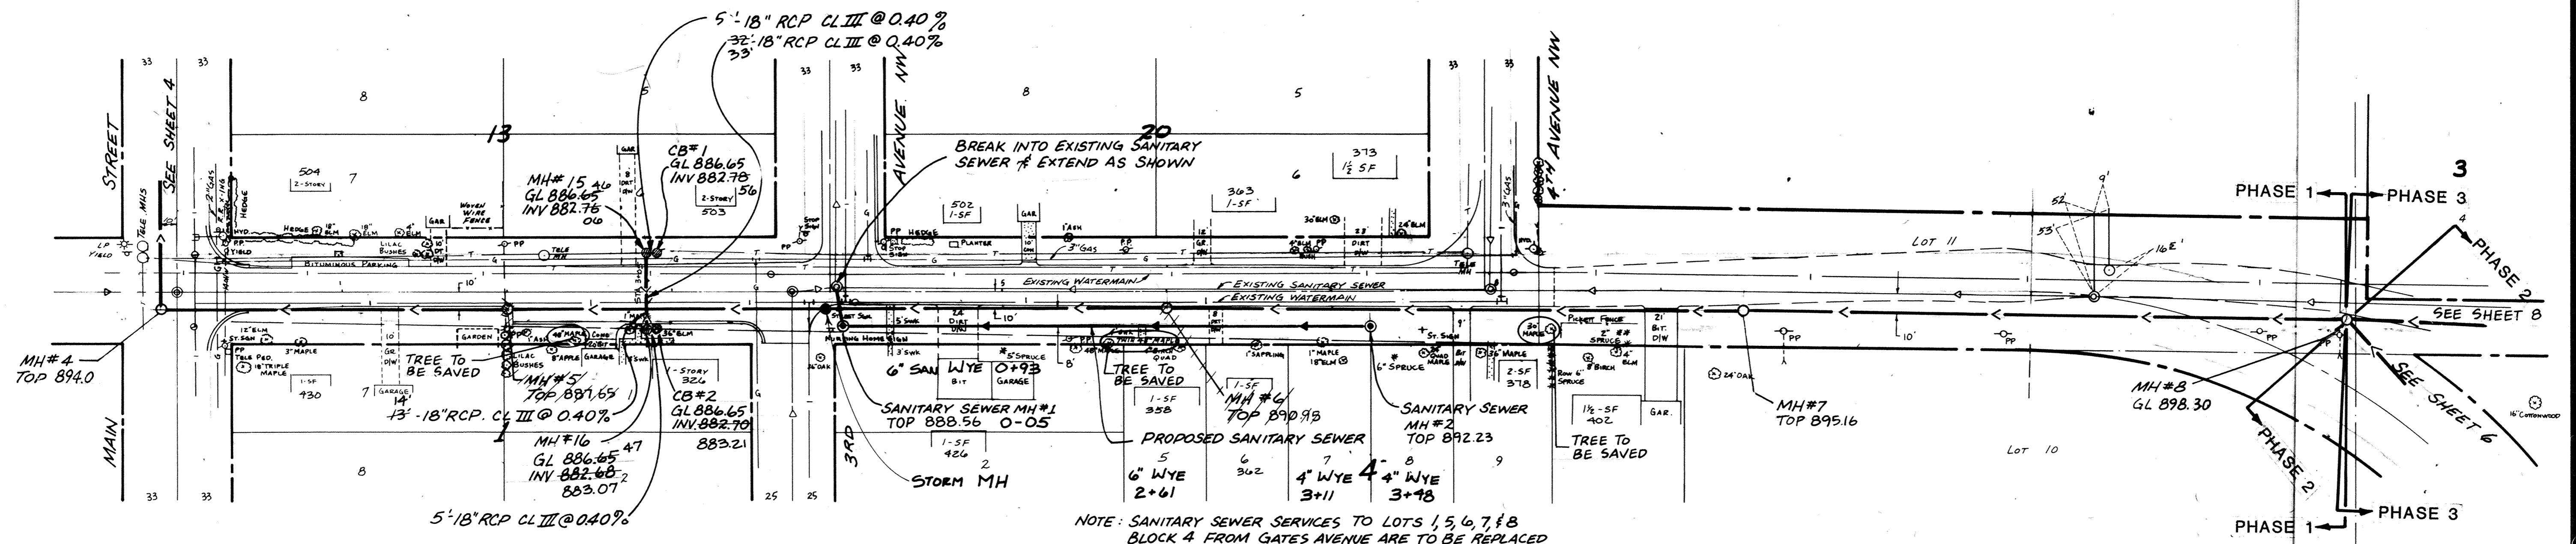

I hereby certify that this plan, specification or report was prepared by me or under my direct supervision and that I am a duly Registered Professional Engineer under State of Minnesota Statutes Sections 326.02 to 326.16

*Jerry J. Mawhin*  
Date: 3/1/83 Minn. Reg. No. 15316

consulting engineers diversified inc. [Logo]

REVISIONS

DESIGNED BY: TJM  
CHECKED BY: TJM  
DRAWN BY: MRJ

CITY OF ELK RIVER  
GATES AVENUE  
PHASE 1  
STORM SEWER

DATE: 11-22-82 SHEET 5 OF 27 SHEETS FILE NO. ERA02.02