

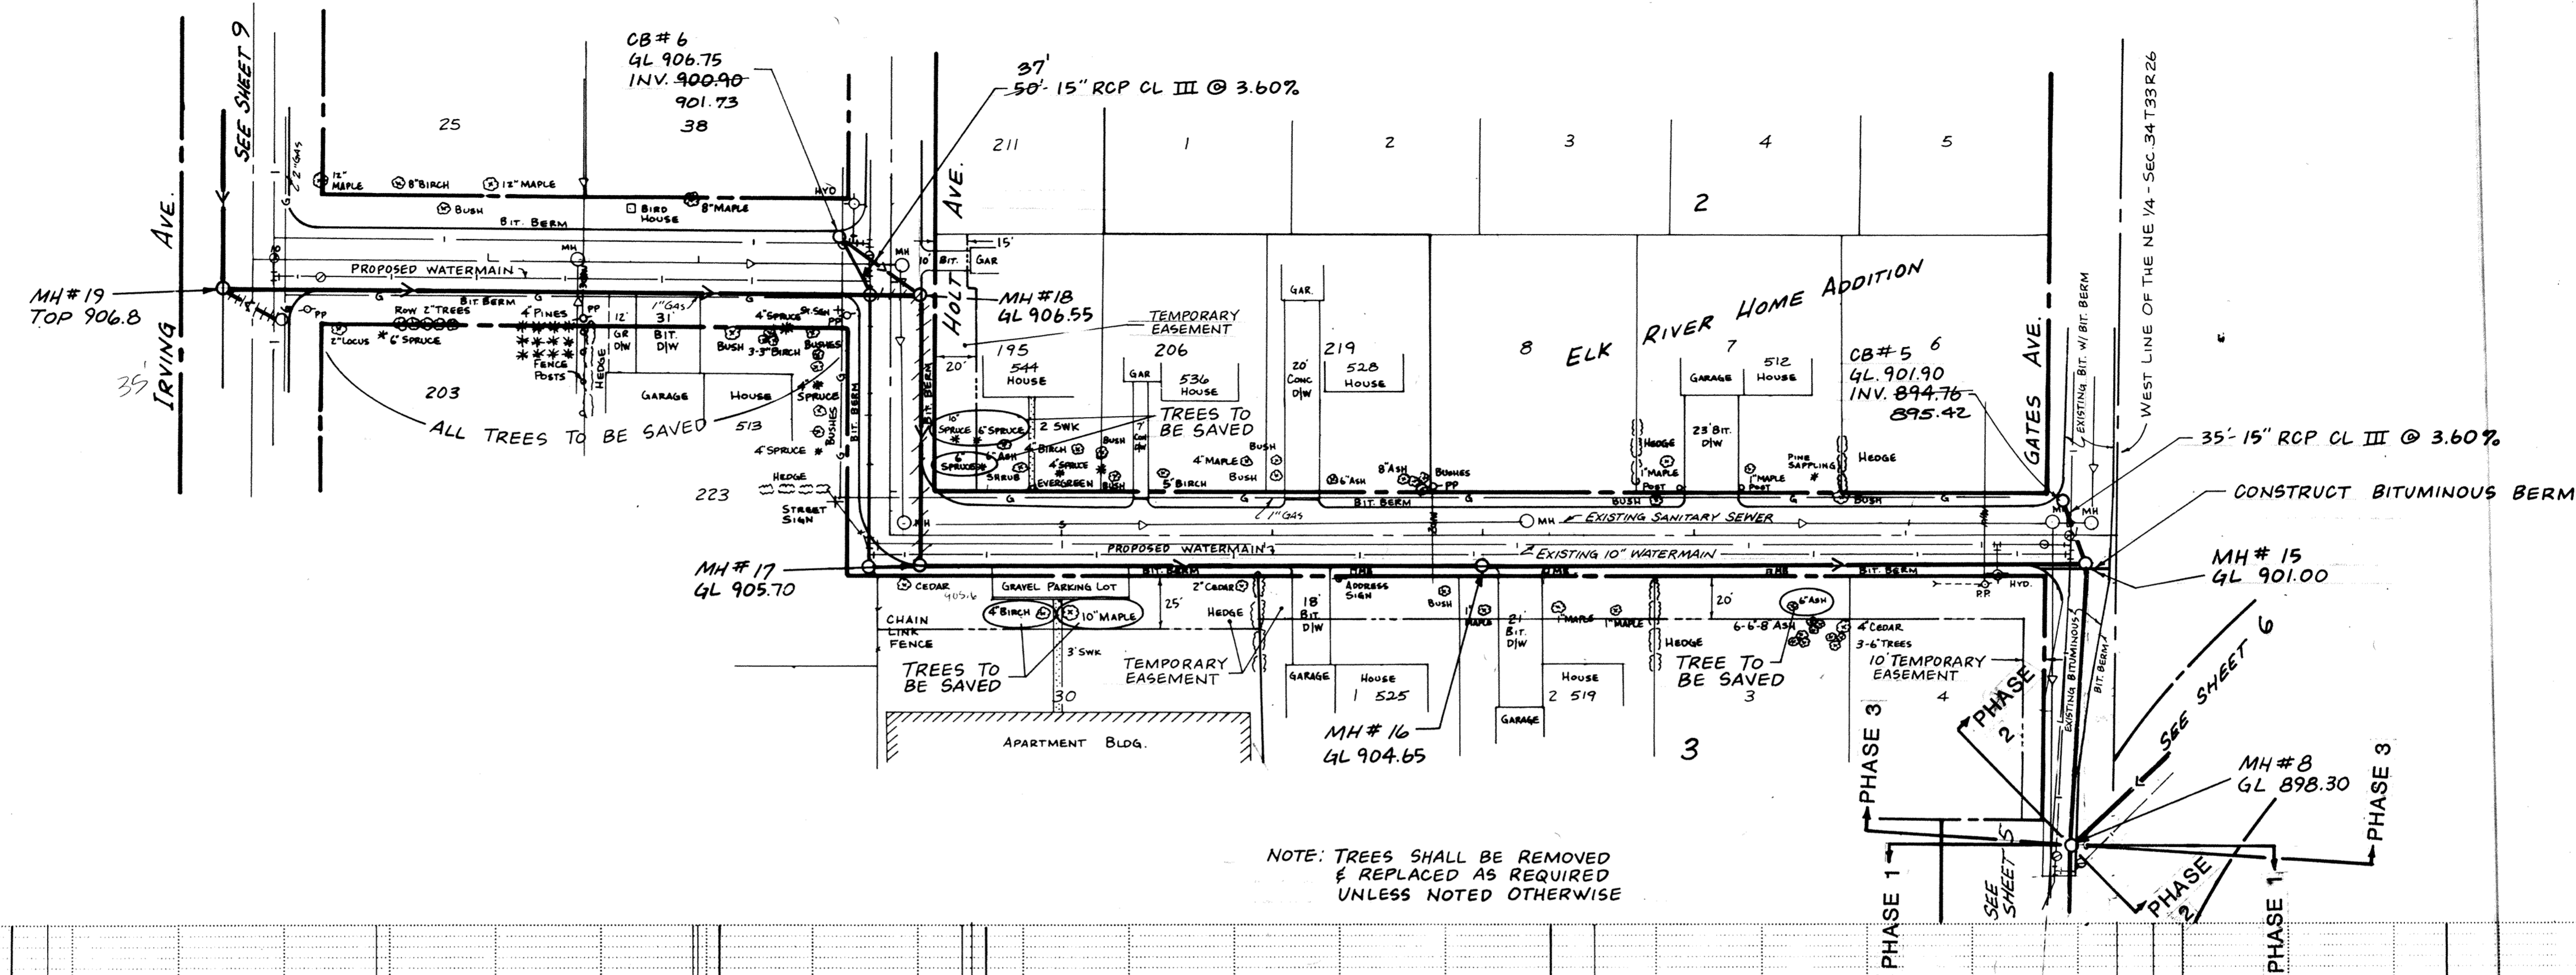


5TH STREET

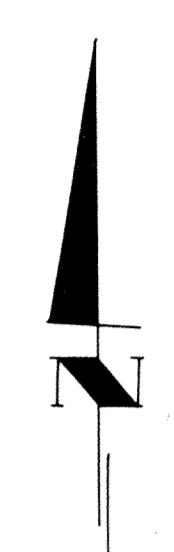

NOTE: TREES SHALL BE REMOVED & REPLACED AS REQUIRED UNLESS NOTED OTHERWISE

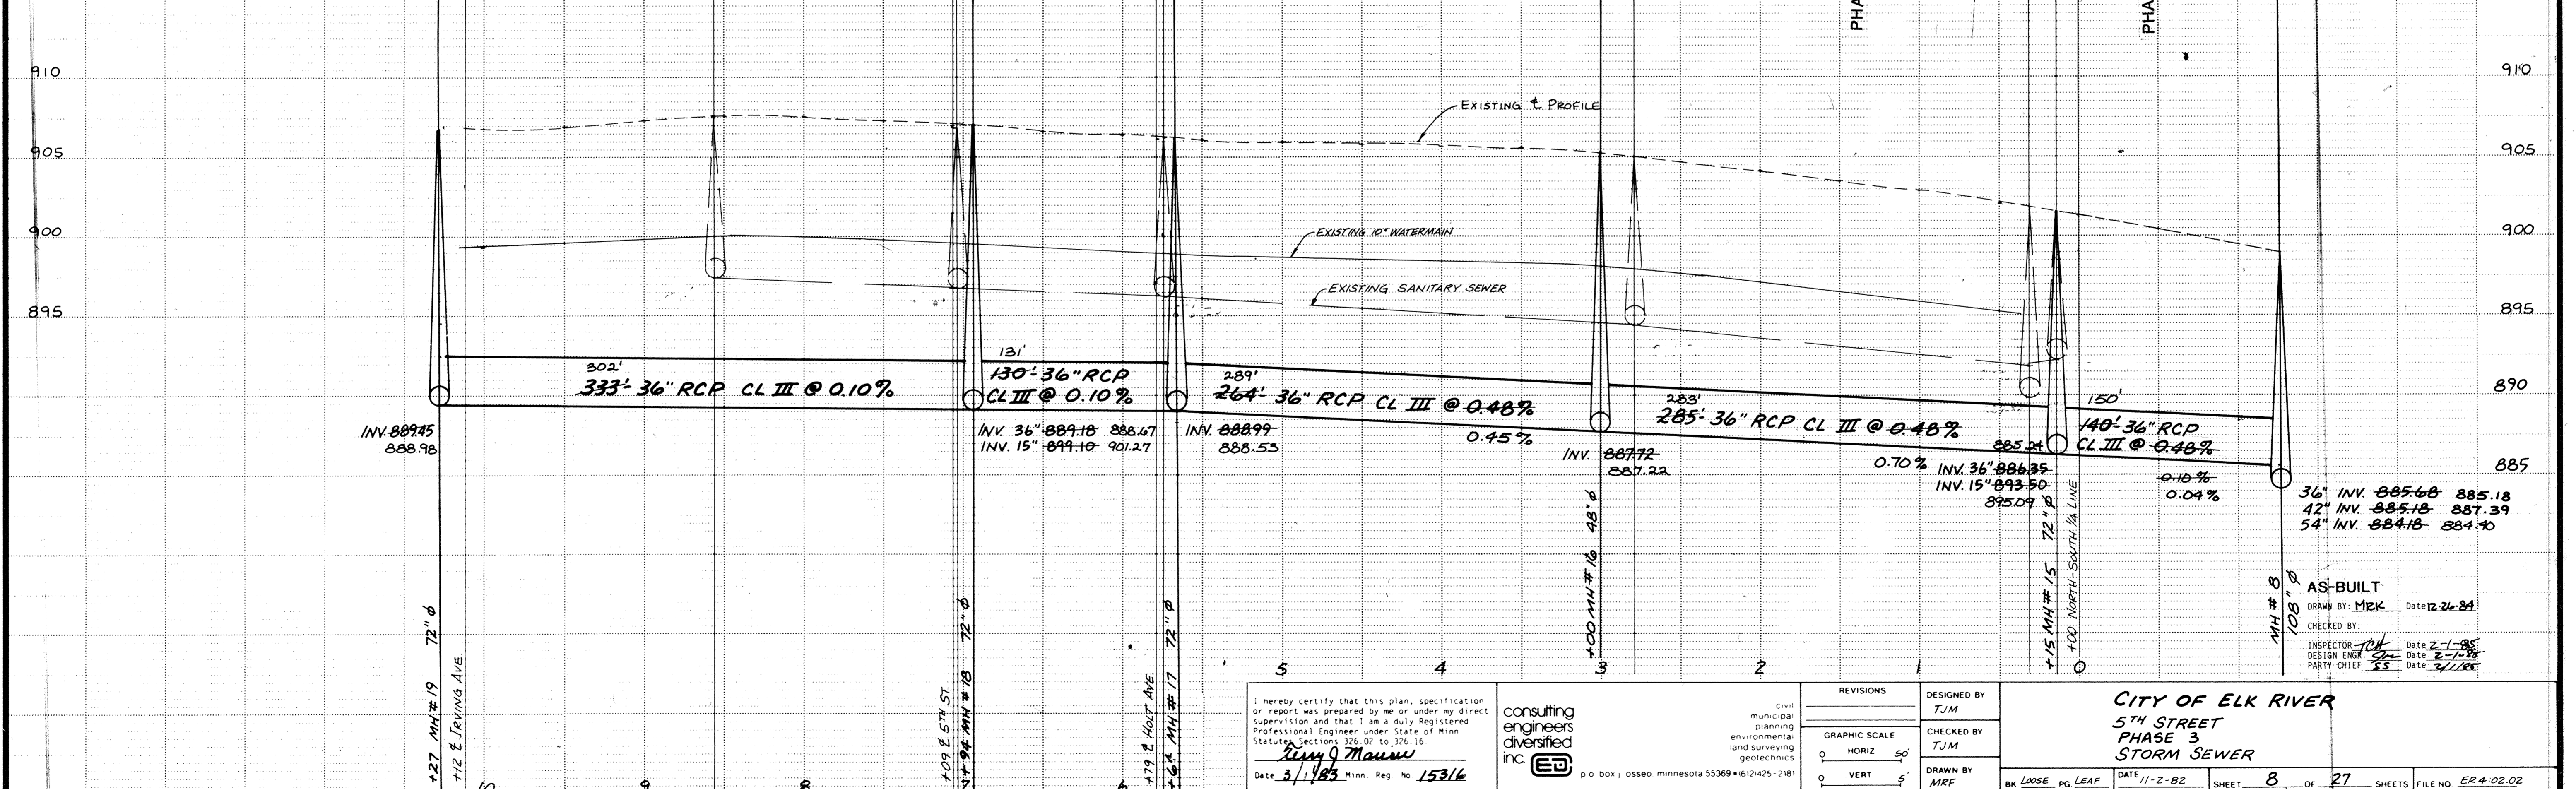

I hereby certify that this plan, specification or report was prepared by me or under my direct supervision and that I am a duly Registered Professional Engineer under State of Minn. Statute sections 326.02 to 326.16
Randy J. Maurer
 Date 3/1/83 Minn. Reg. No. 15316

consulting engineers diversified inc. P.O. Box 1, Osseo, Minnesota 55369 • 612-425-2181

REVISIONS	

DESIGNED BY: TJM
 CHECKED BY: TJM
 DRAWN BY: MRF

CITY OF ELK RIVER
 5TH STREET
 PHASE 3
 STORM SEWER

DATE 11-2-82 SHEET 8 OF 27 SHEETS FILE NO. ER-4-02-02

AS-BUILT
 DRAWN BY: MKK Date 12-26-84
 CHECKED BY: [Signature] Date 2-1-85
 DESIGN ENGR: [Signature] Date 2-1-85
 PARTY CHIEF: [Signature] Date 2-1-85

DRAWING NUMBER 9 GATES 83