
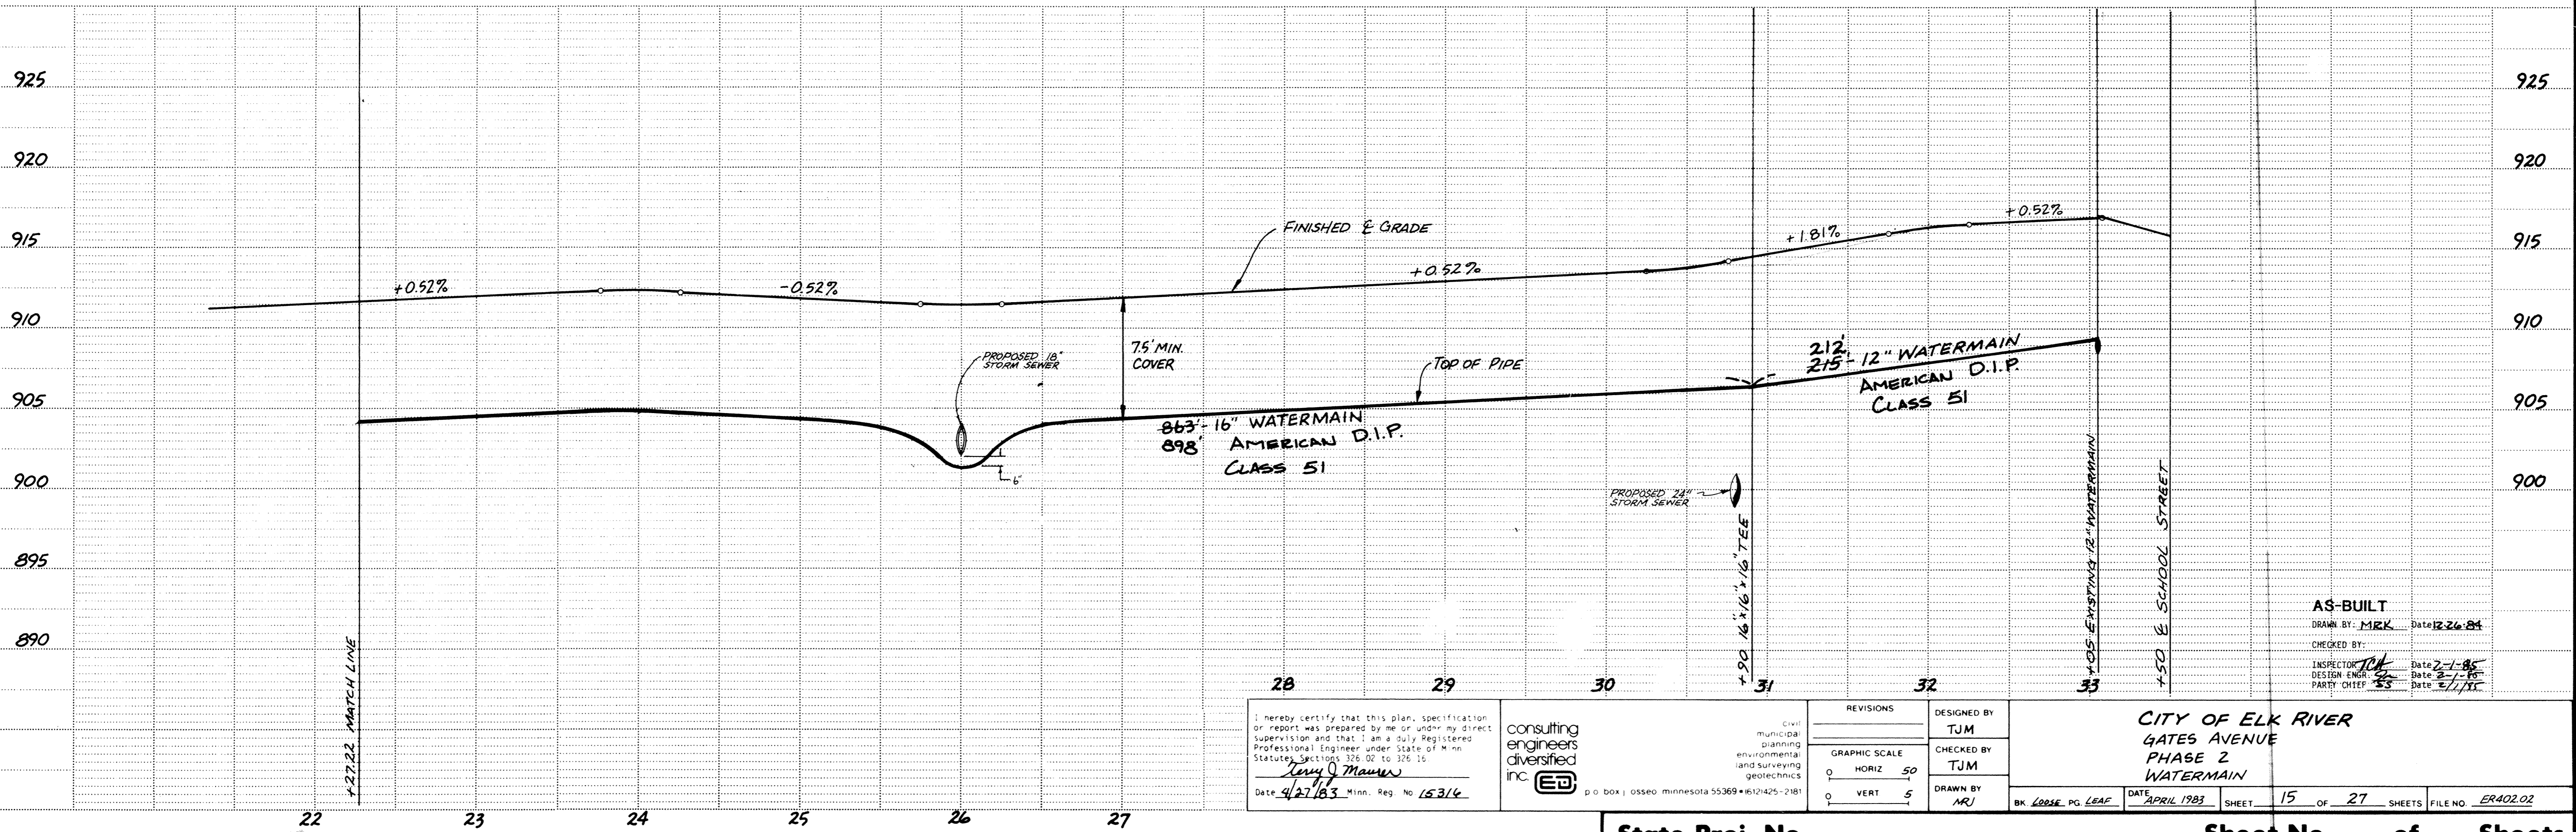


GATES AVENUE

Fed. Proj. No.

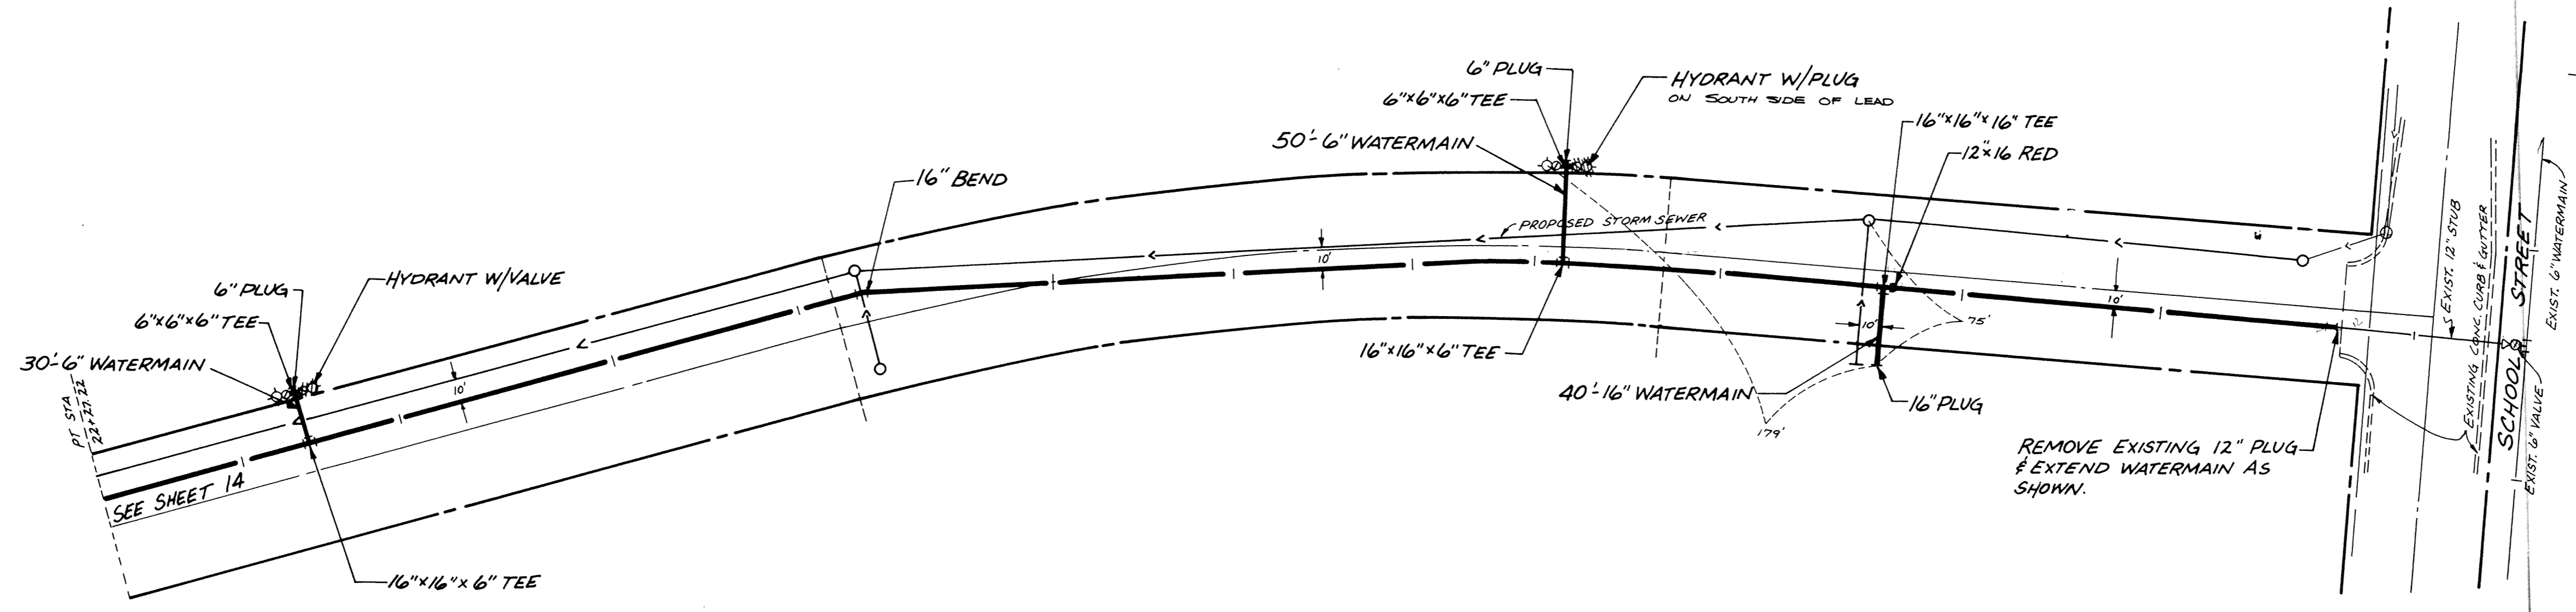

AS-BUILT
 DRAWN BY: MKK Date: 2-26-84
 CHECKED BY:
 INSPECTOR: TJM Date: 2-1-85
 DESIGN ENGR: SS Date: 2-1-85
 PARTY CHIEF: SS Date: 2/1/85

I hereby certify that this plan, specification or report was prepared by me or under my direct supervision and that I am a duly Registered Professional Engineer under the State of Minnesota Statutes, sections 326.02 to 326.16.
 Jerry J. Mauer
 Date: 4/27/83 Minn. Reg. No. 16314

consulting engineers diversified inc.
 civil municipal planning environmental land surveying geotechnics
 p.o. box 10560 minnesota 55369 • 612-425-2181

REVISIONS	

DESIGNED BY: TJM
 CHECKED BY: TJM
 DRAWN BY: NRJ

CITY OF ELK RIVER
 GATES AVENUE
 PHASE 2
 WATERMAIN
 BK. LOSS. PG. LEAF DATE: APRIL 1983 SHEET: 15 OF 27 SHEETS FILE NO.: ER402.02

State Proj. No. Sheet No. of Sheets

DRAWING NUMBER GATES 83 15