
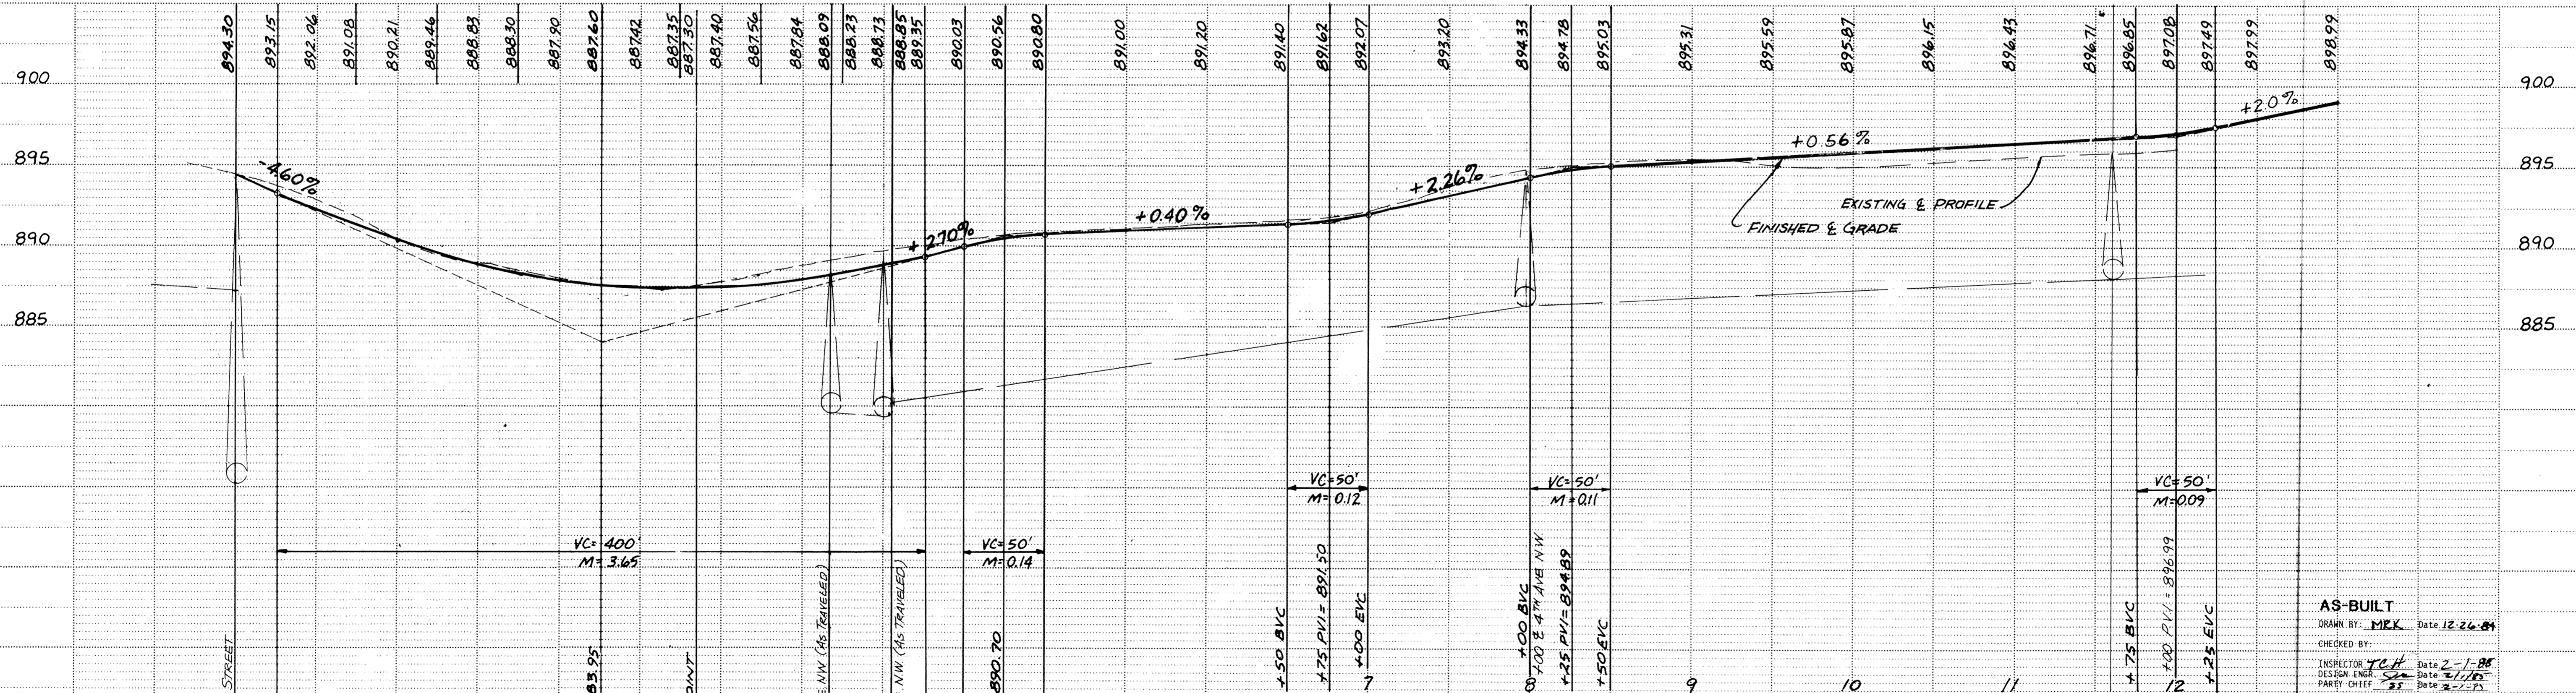
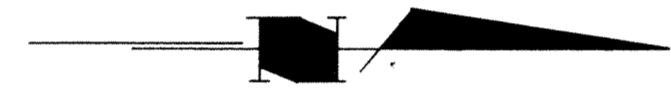


# GATES AVENUE

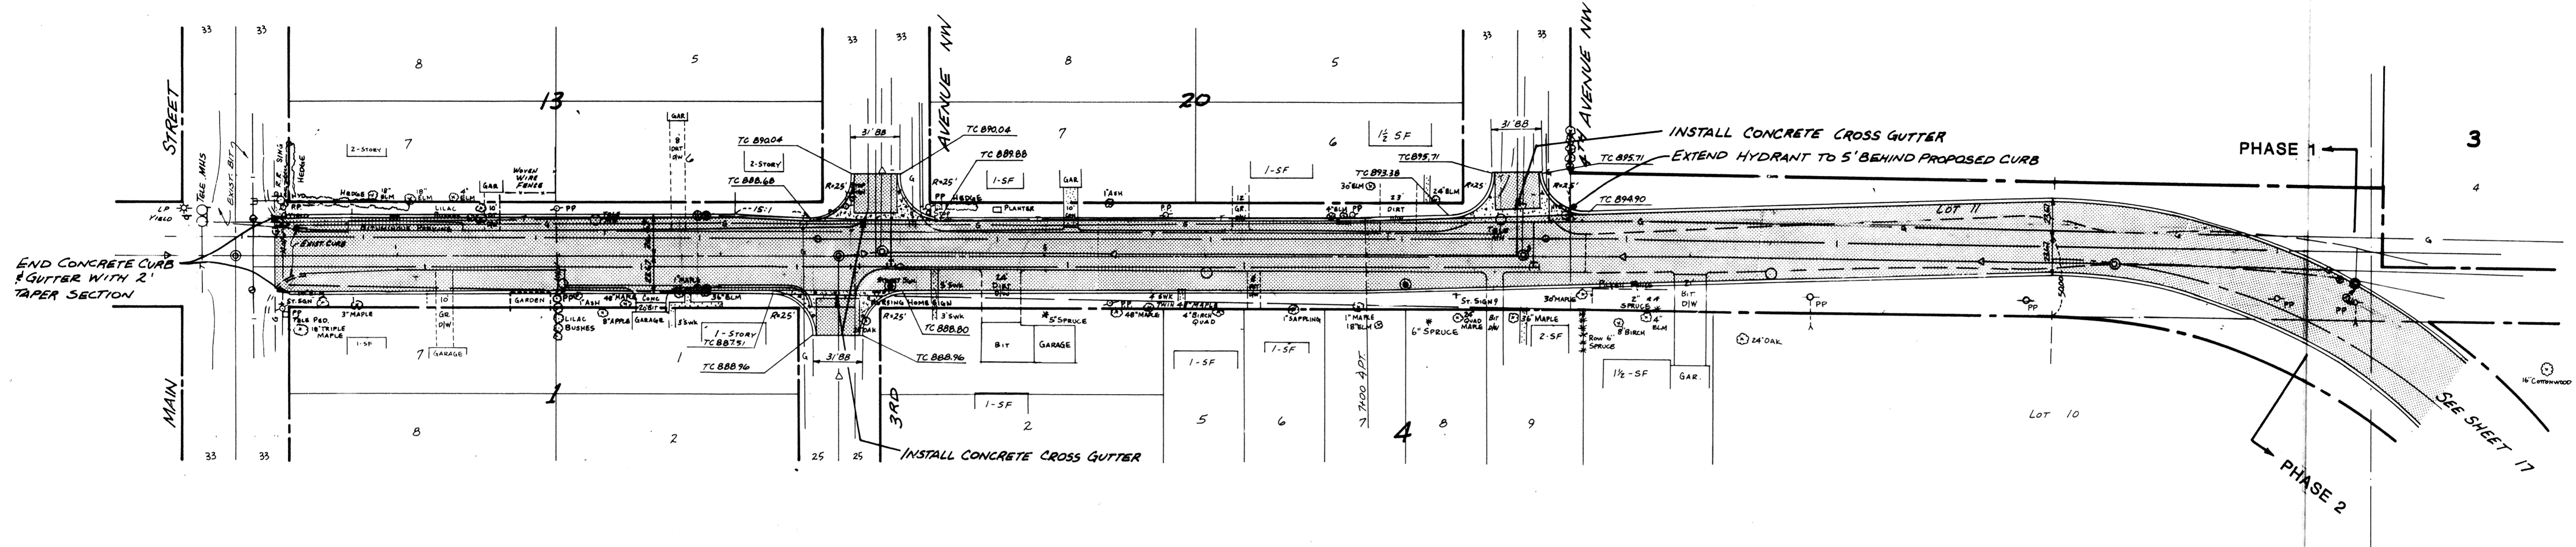

**AS-BUILT**  
 DRAWN BY: MKK Date 12-26-84  
 CHECKED BY:  
 INSPECTOR: JCH Date 2-1-88  
 DESIGN ENGR: JCH Date 2-1-88  
 PAREY CHIEF: JCH Date 2-1-88

I hereby certify that this plan, specification or report was prepared by me or under my direct supervision and that I am a duly Registered Professional Engineer under the State of Minnesota, Sections 326.02 to 326.16.  
**Larry J. Maurer**  
 Date 3/1/83 Minn. Reg. No. 15314

consulting engineers diversified inc.  
 600 box 1, osseo minnesota 55369 • 612-425-2181

REVISIONS	

DESIGNED BY: TJM  
 CHECKED BY: TJM  
 DRAWN BY: MRJ

**CITY OF ELK RIVER**  
**GATES AVENUE IMPROVEMENT PROJECT**  
**PHASE 1**  
**STREET GRADES**

DATE: FEB 1982  
 SHEET: 16 OF 27 SHEETS  
 FILE NO: ER31102

DRAWING NUMBER

DRAWING NUMBER

DRAWING NUMBER

DRAWING NUMBER