
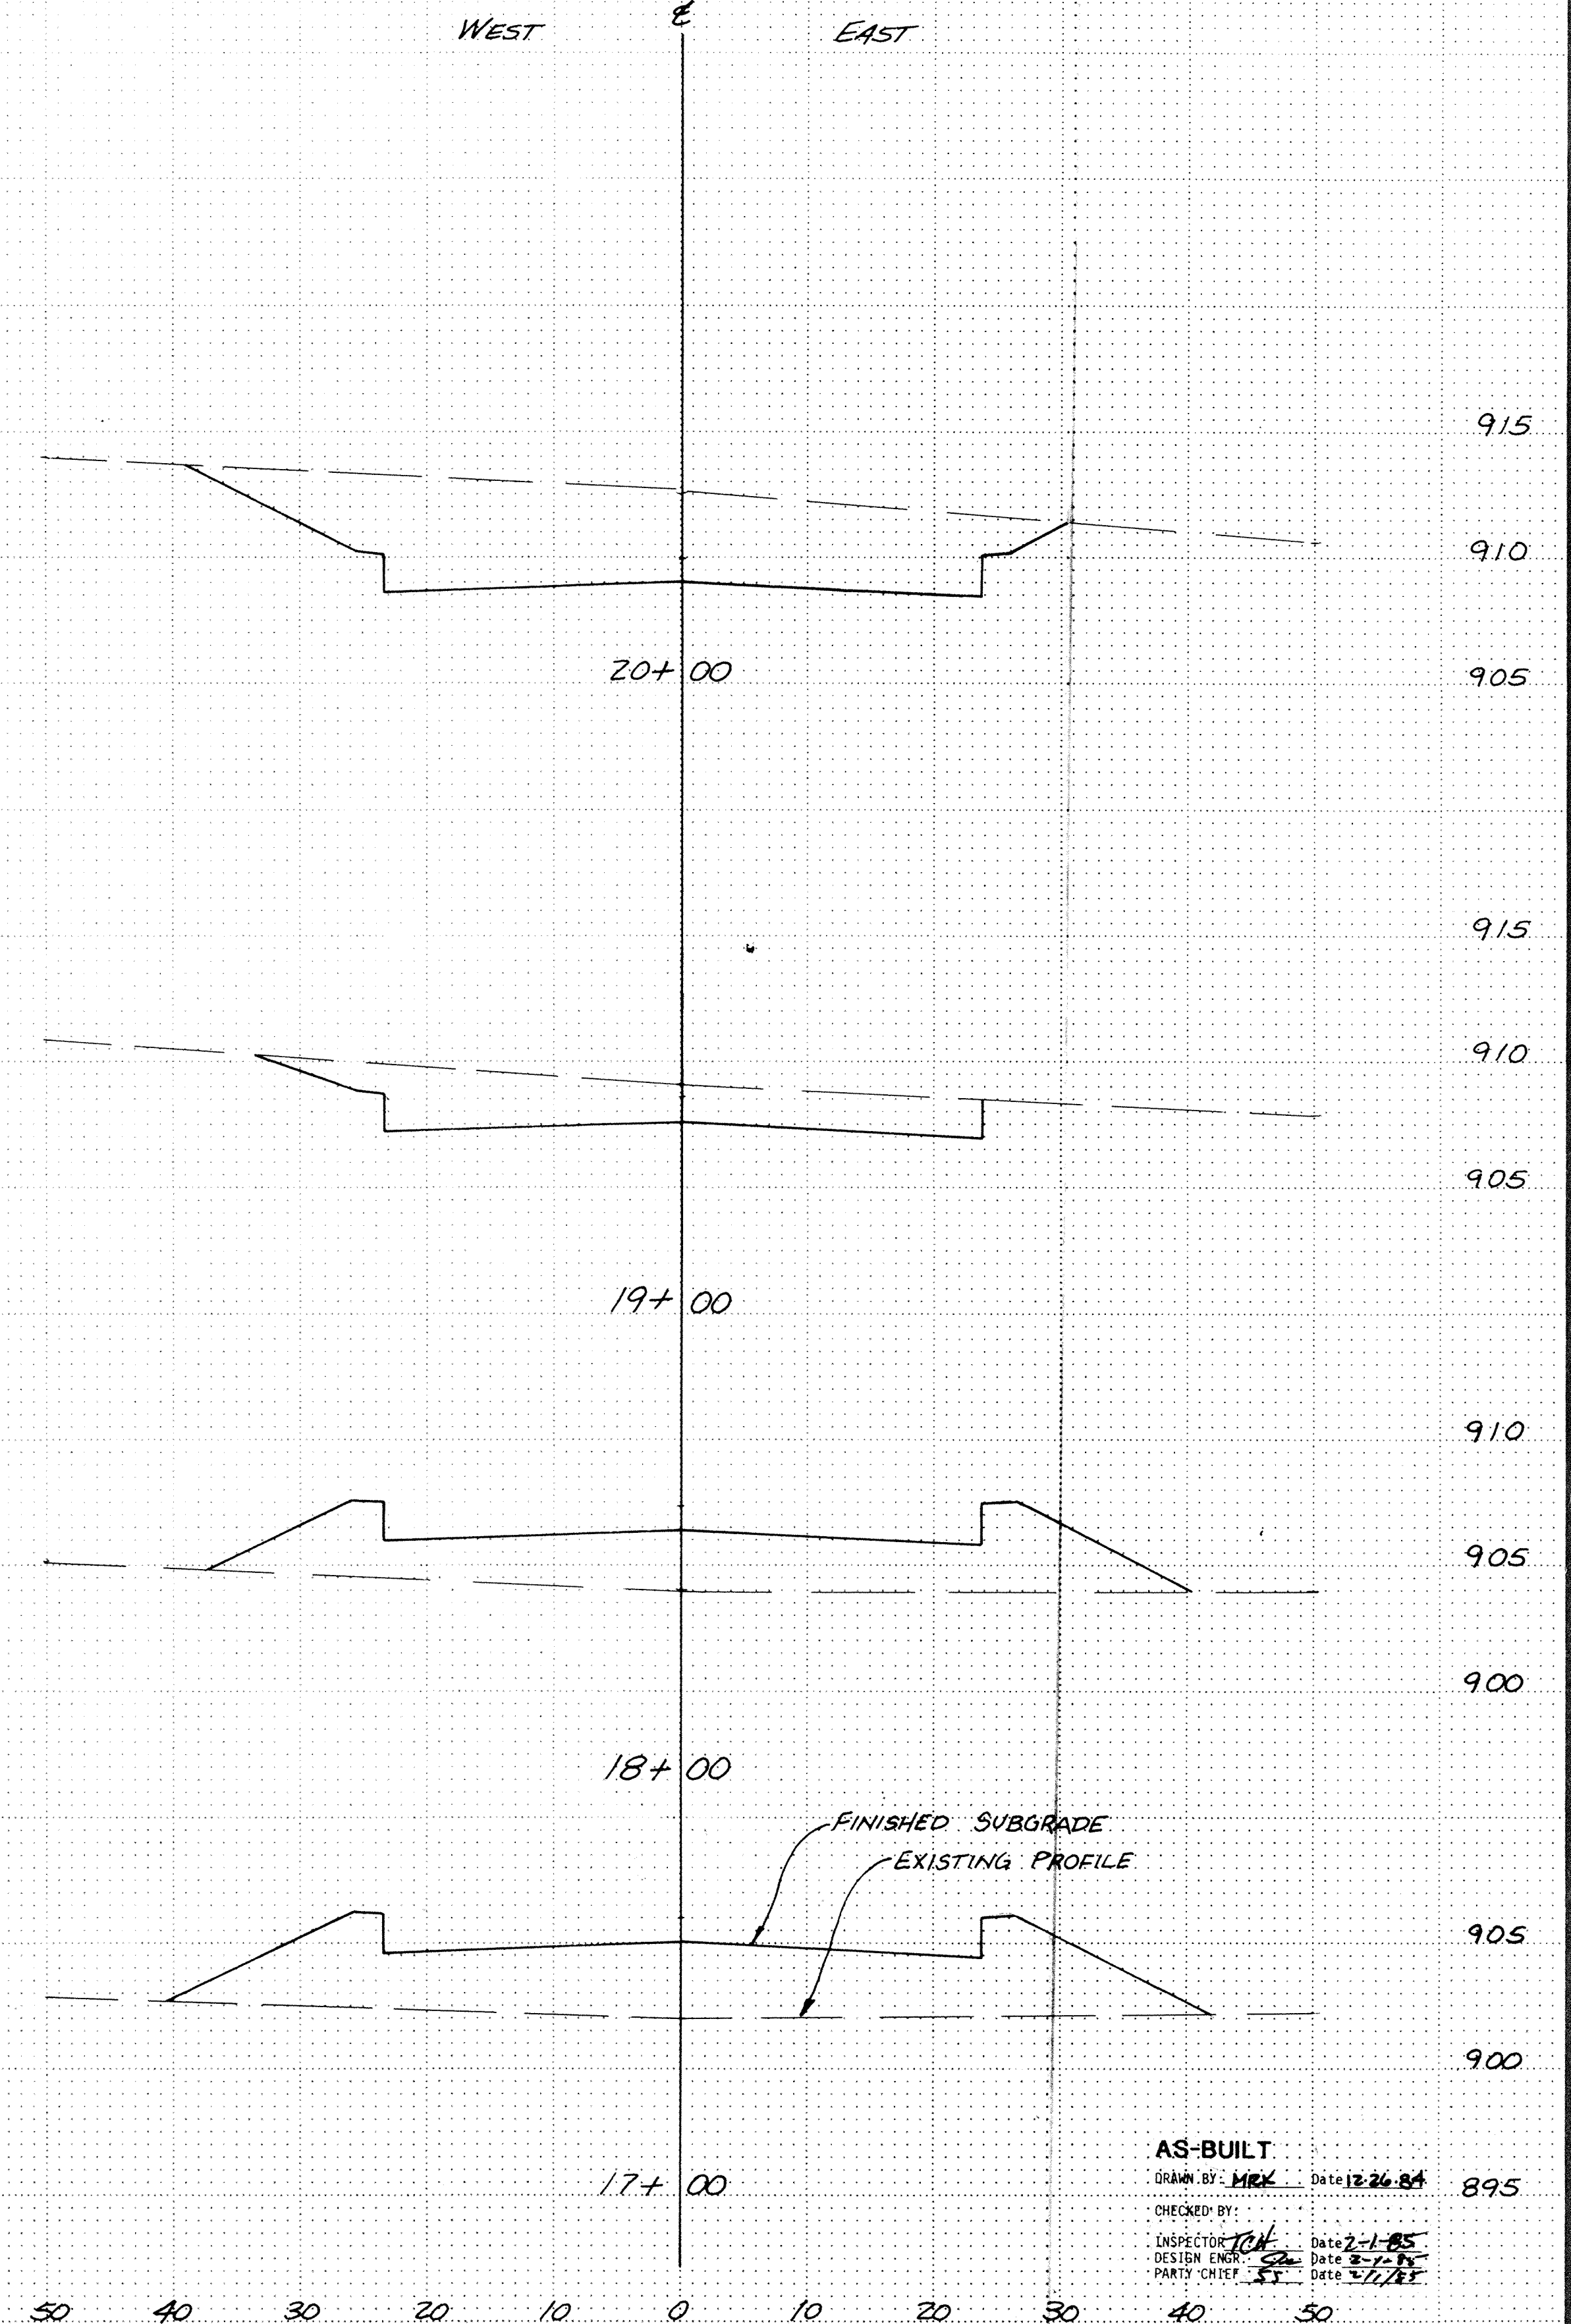


Fed. Proj. No.

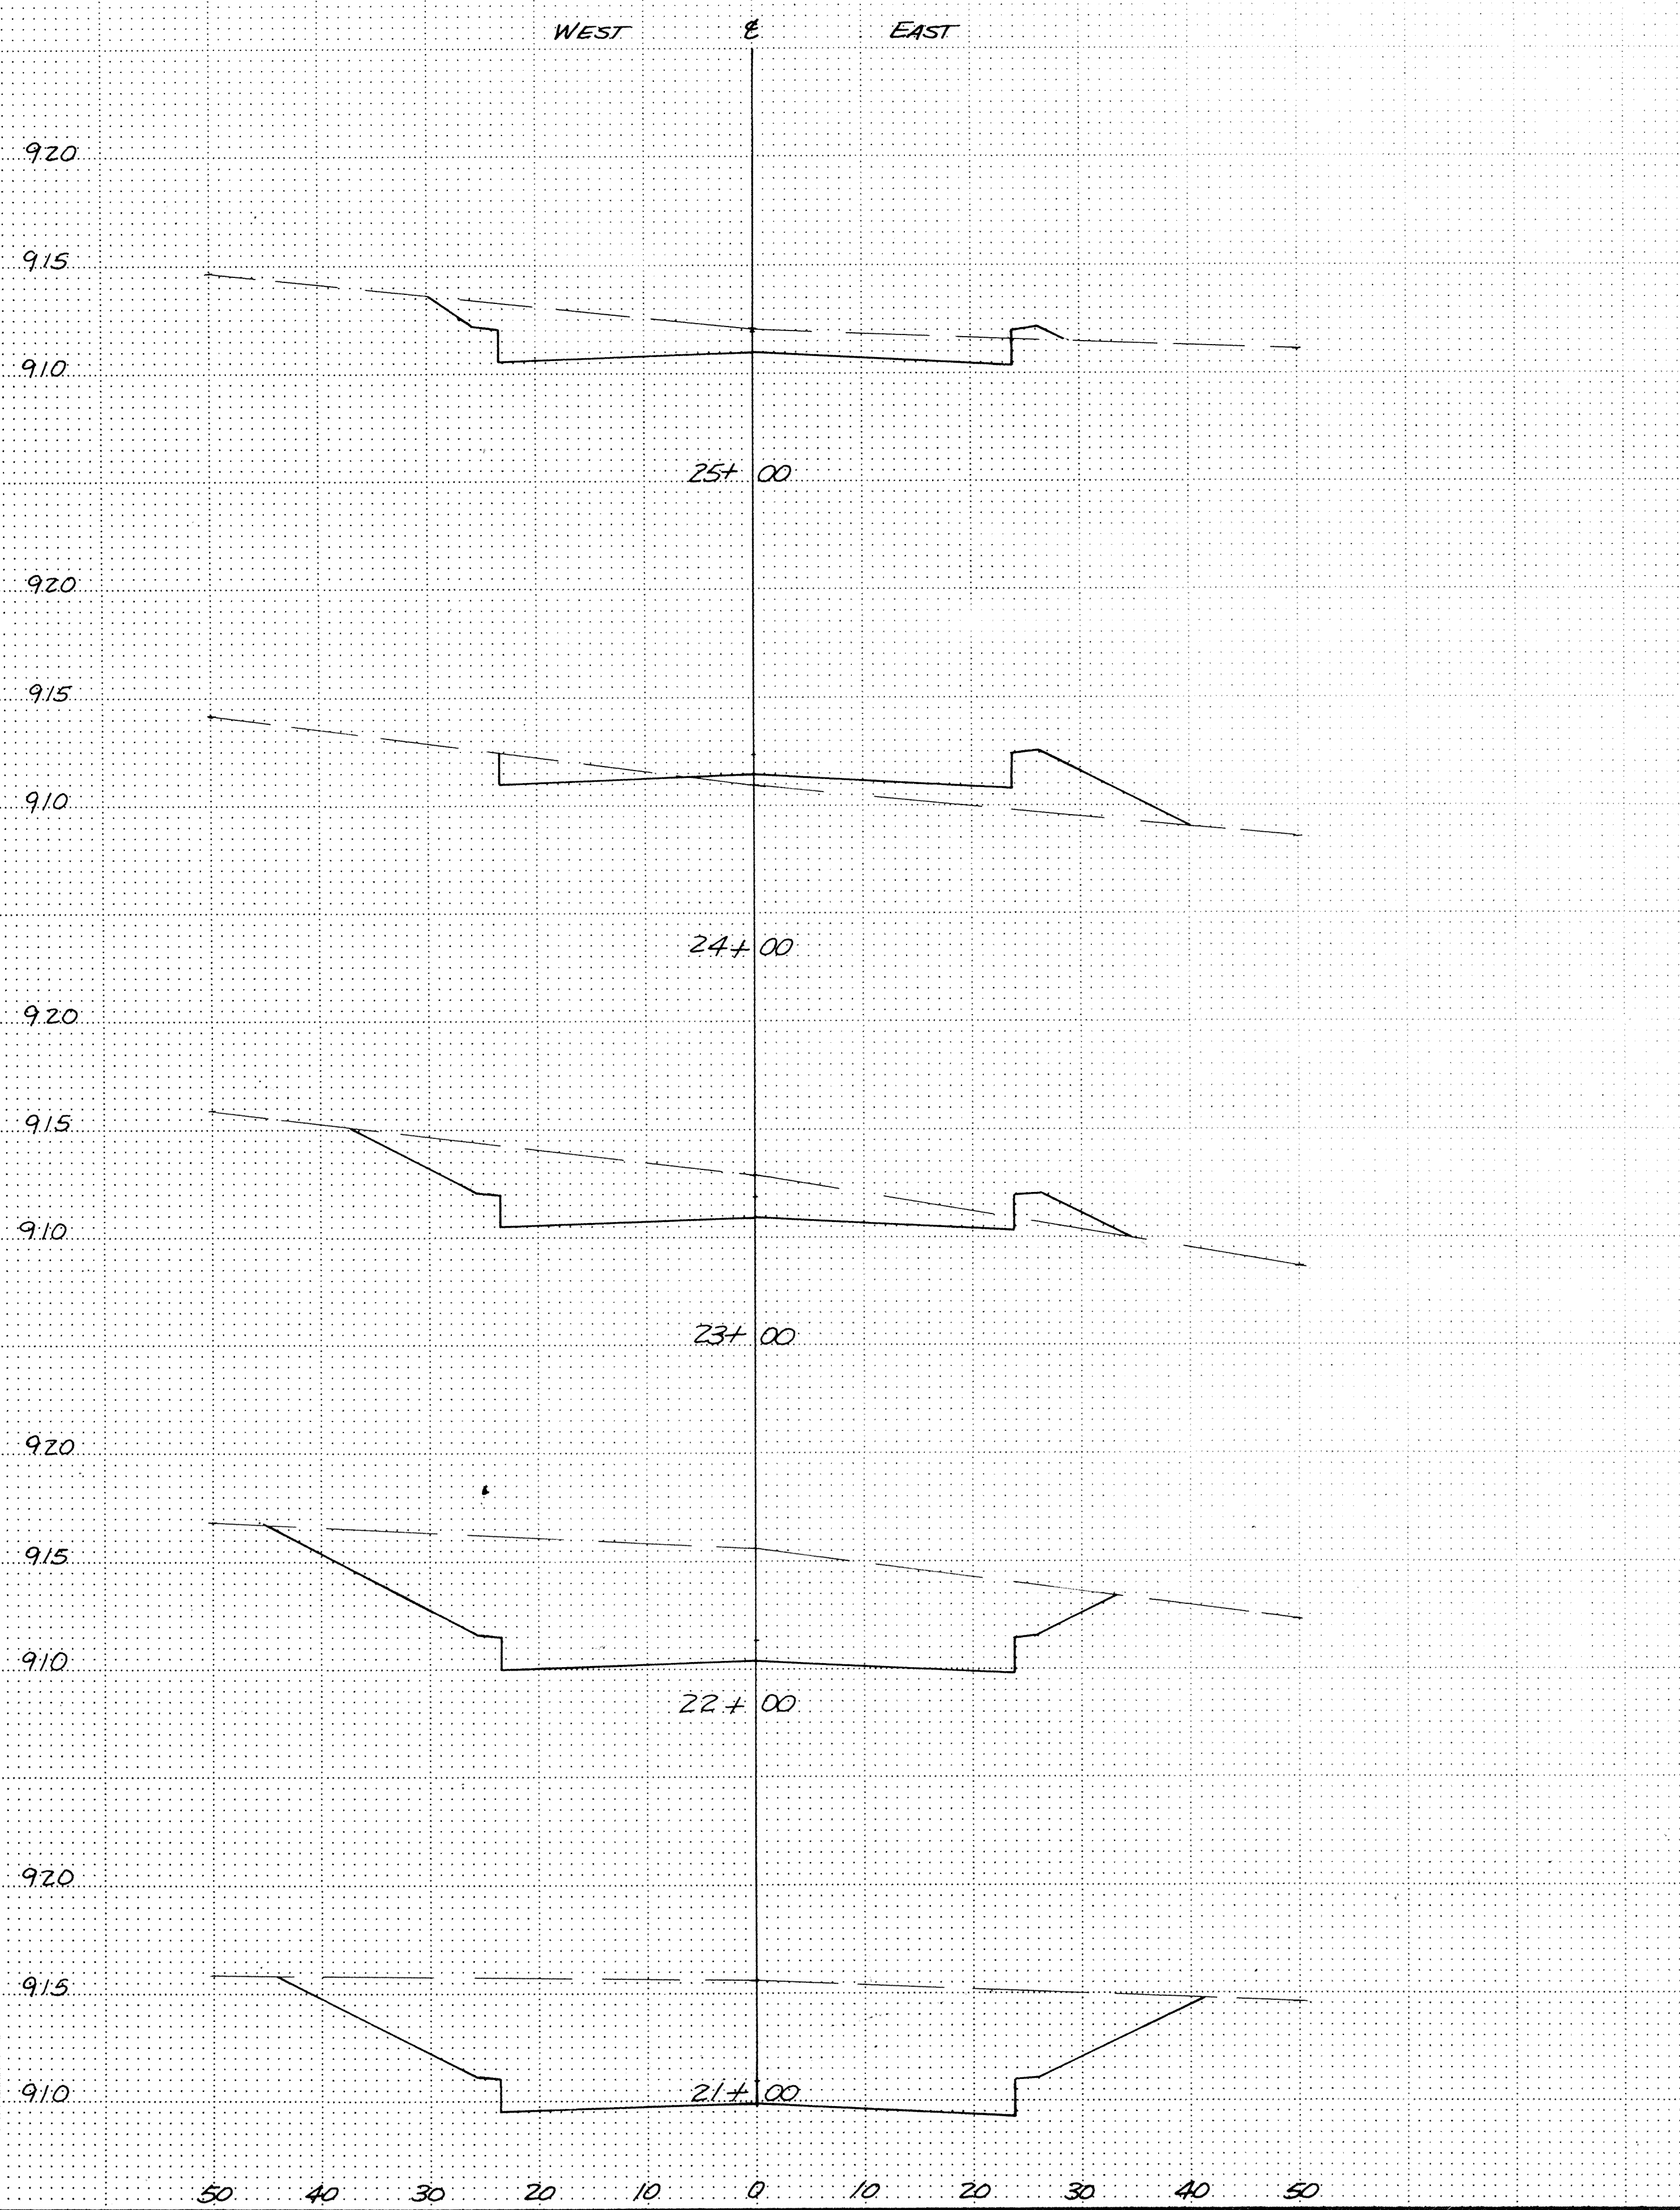

AS-BUILT
 DRAWN BY: MRF Date 12-26-84
 CHECKED BY: [Signature] Date 2-1-85
 INSPECTOR: [Signature] Date 2-1-85
 DESIGN ENGINEER: [Signature] Date 2-1-85
 PARTY CHIEF: [Signature] Date 2-1-85

I hereby certify that this plan, specification or report was prepared by me or under my direct supervision and that I am a duly Registered Professional Engineer under State of Minn. Statutes Sections 326.02 to 326.16.
 Date 8/1/85 Minn. Reg. No. 15314
 [Signature]

consulting engineers diversified inc. [Logo]
 civil municipal planning environmental land surveying geotechnics
 p.o. box 1, osseo, minnesota 55369 • 612/425-2181

DESIGNED BY	TJM
CHECKED BY	TJM
DRAWN BY	MRF

CITY OF ELK RIVER
 GATES AVENUE IMPROVEMENT PROJECT
 CROSS SECTIONS
 17+00 TO 25+00
 DATE 11-29-82 SHEET 26 OF 27 SHEETS FILE NO. ER-4-02-02

State Proj. No. 204-124-01 Sheet No. of Sheets

DRAWING NUMBER GATES 83 26