
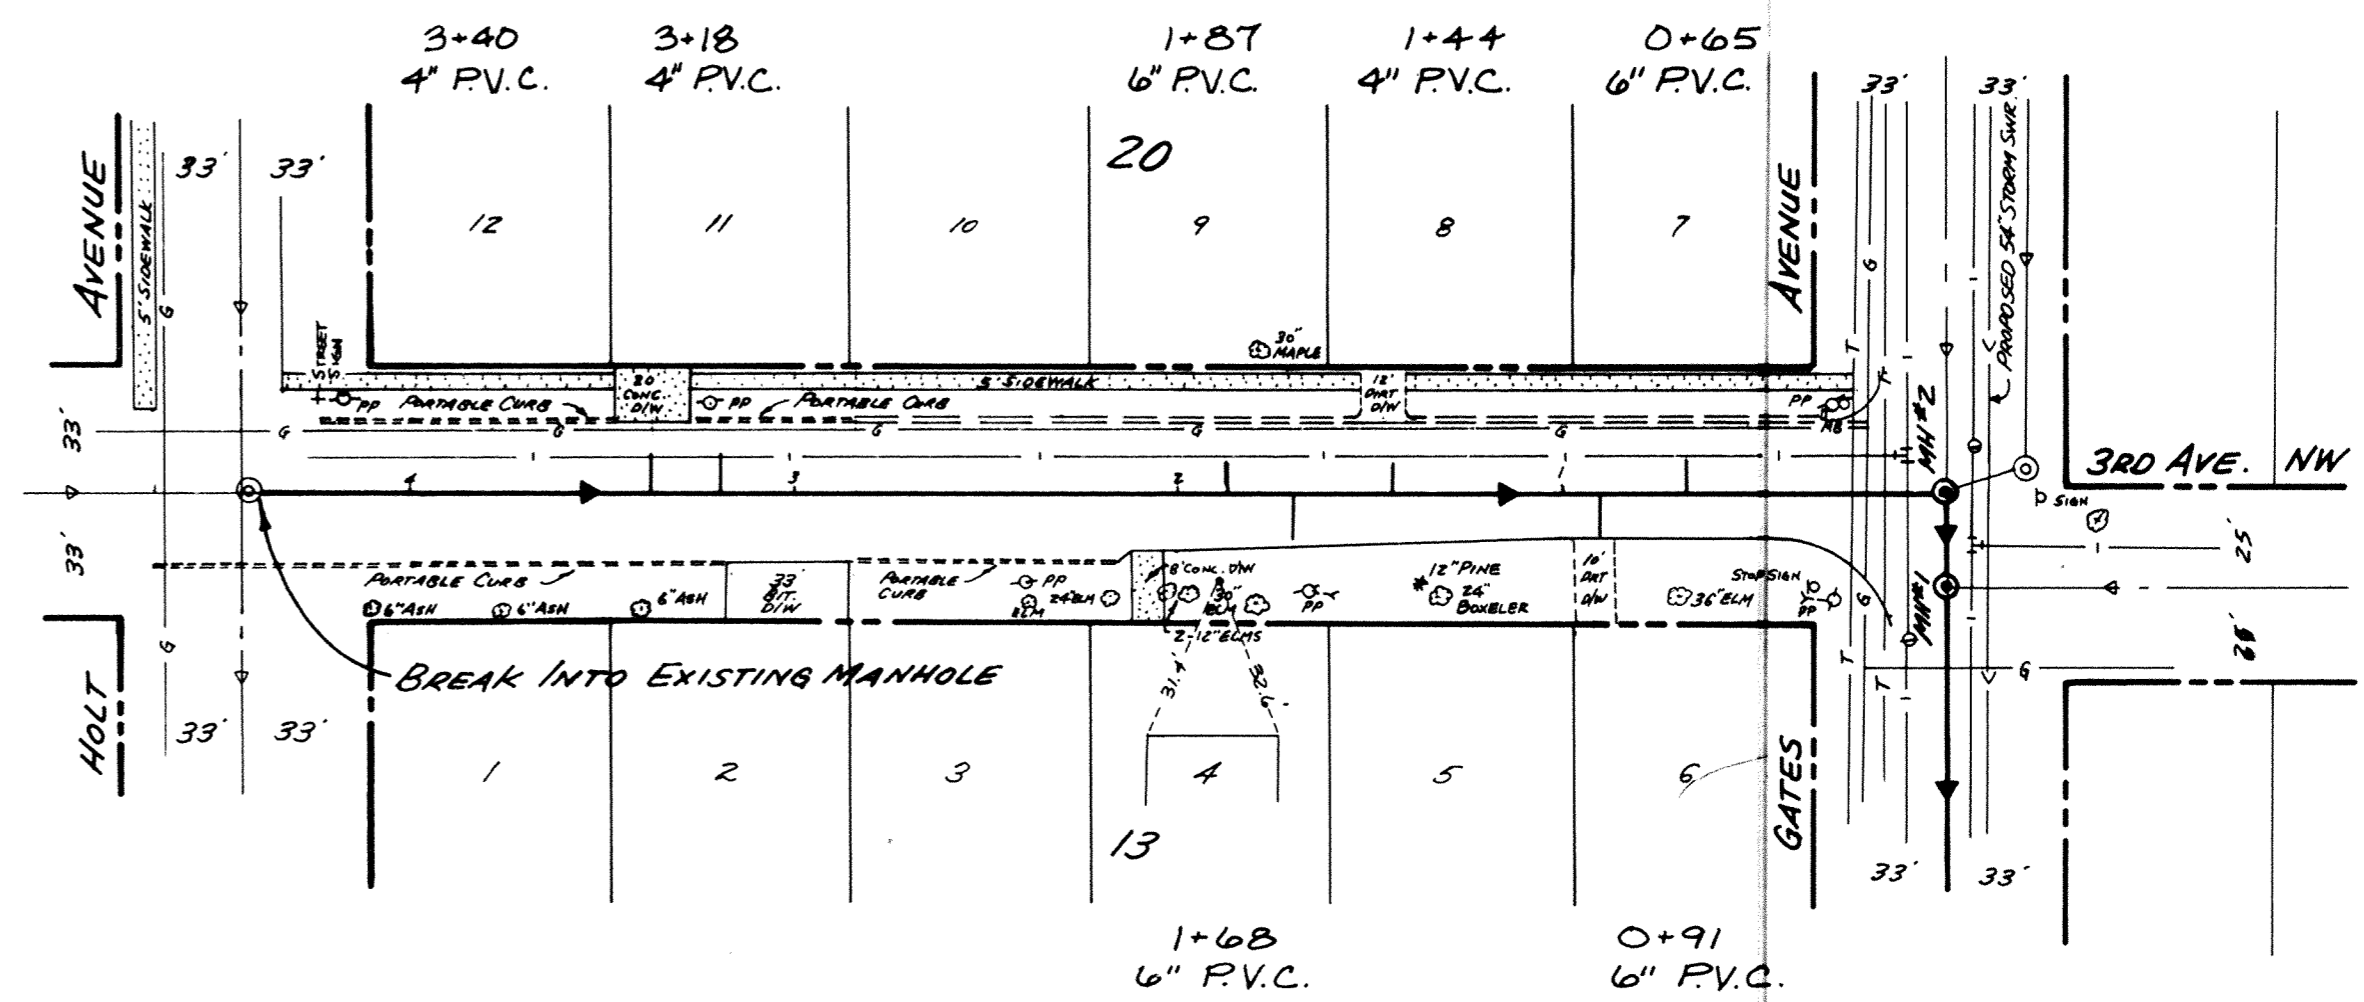


# GATES AVENUE


# 3RD AVENUE NW

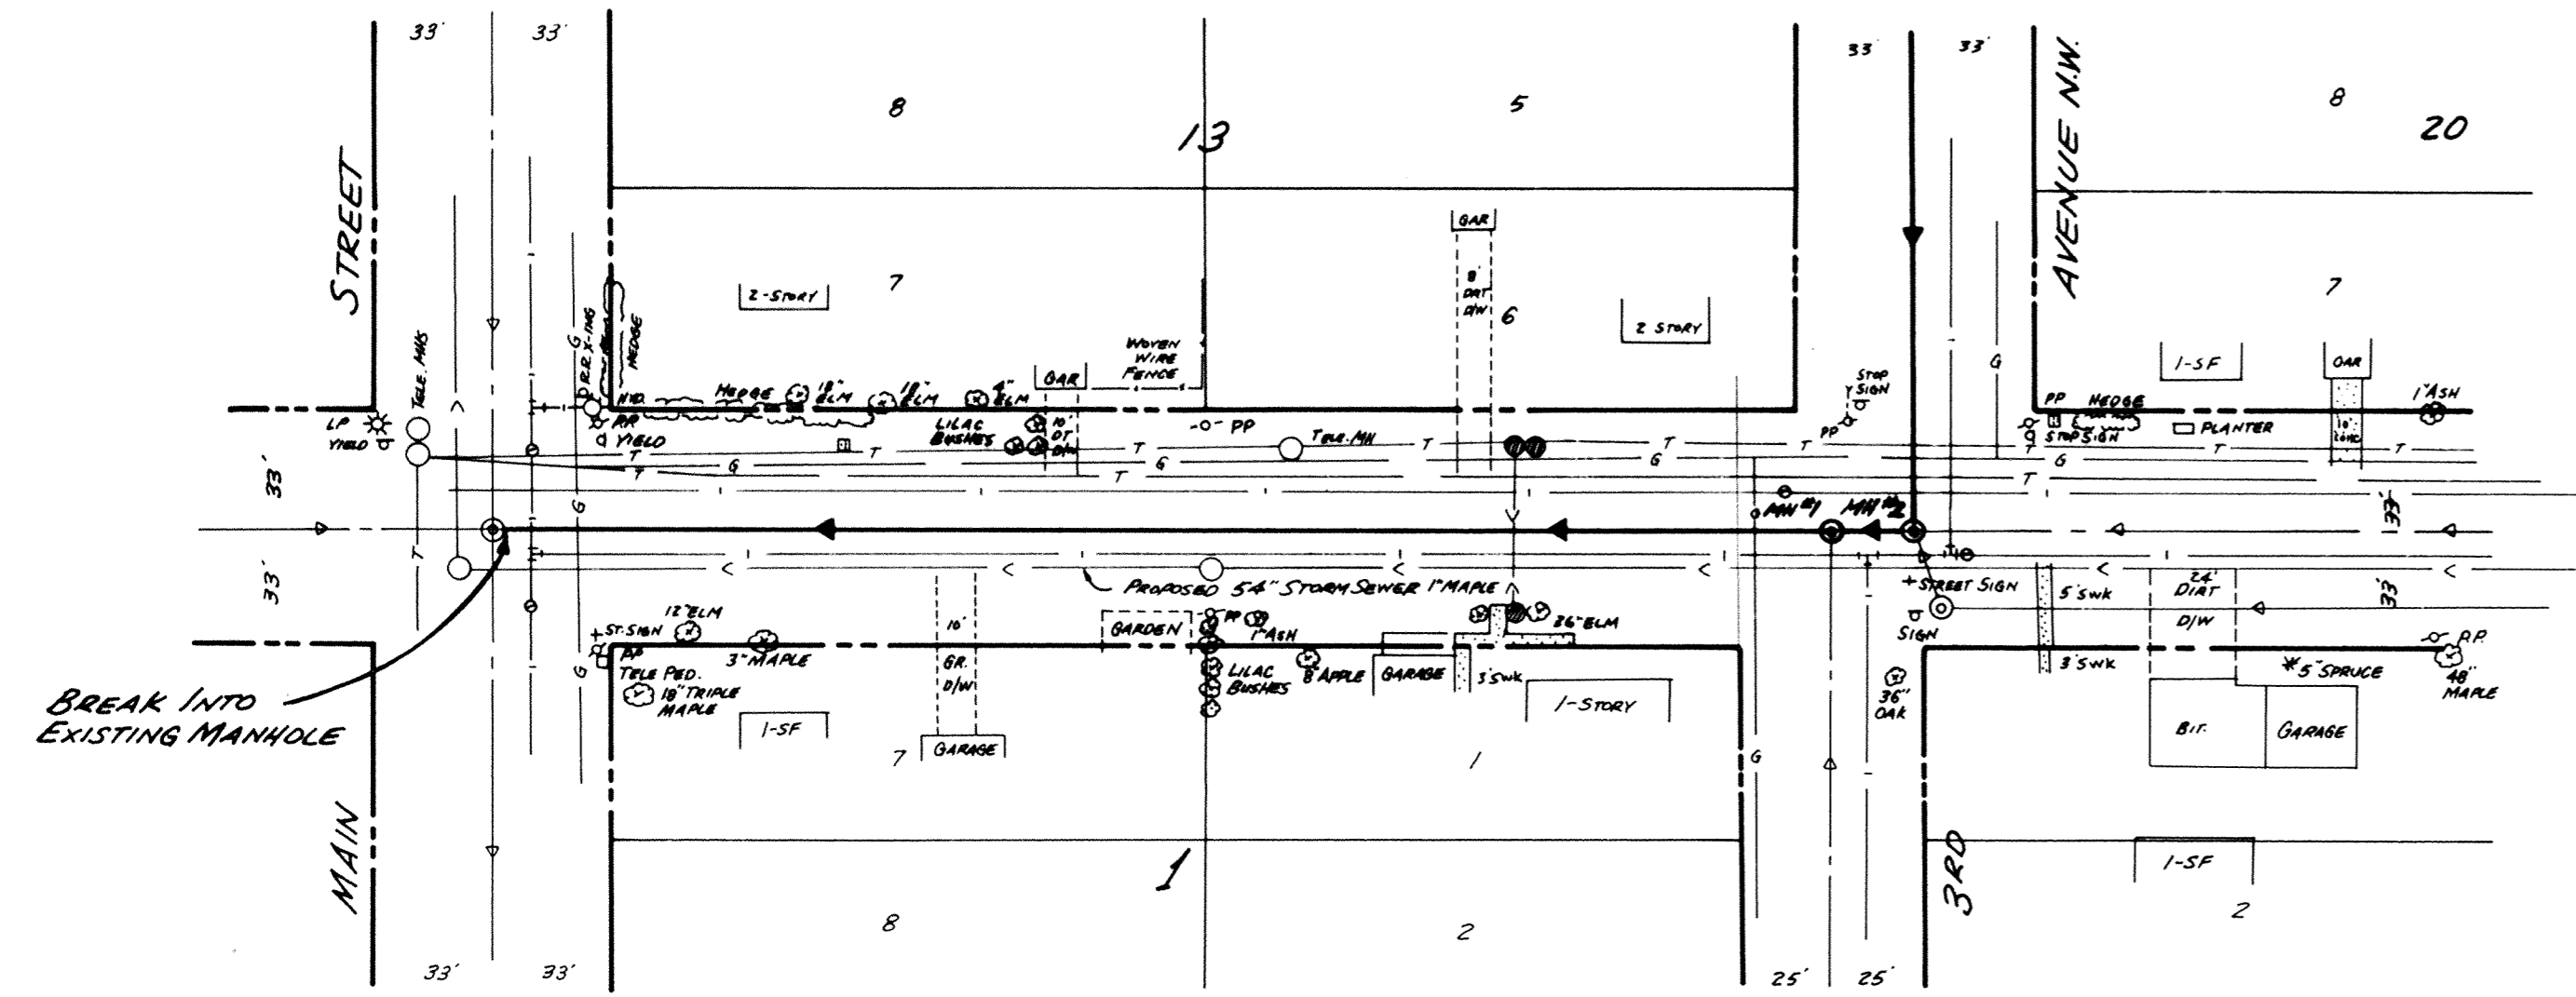

**NOTES:**

1. Street area disturb on 3rd Avenue to be restored with 4" Class 5 base and 2" Bituminous Surfacing (MnDOT 2341).
2. Existing Sanitary Sewer services on 3rd Avenue to be connected to the proposed 12" line.

NOTE: SERVICE STATIONING REFERS TO WYE LOCATION.  
-PVC PIPE SIZE USED TO CONNECT TO EXIST. SERVICE.

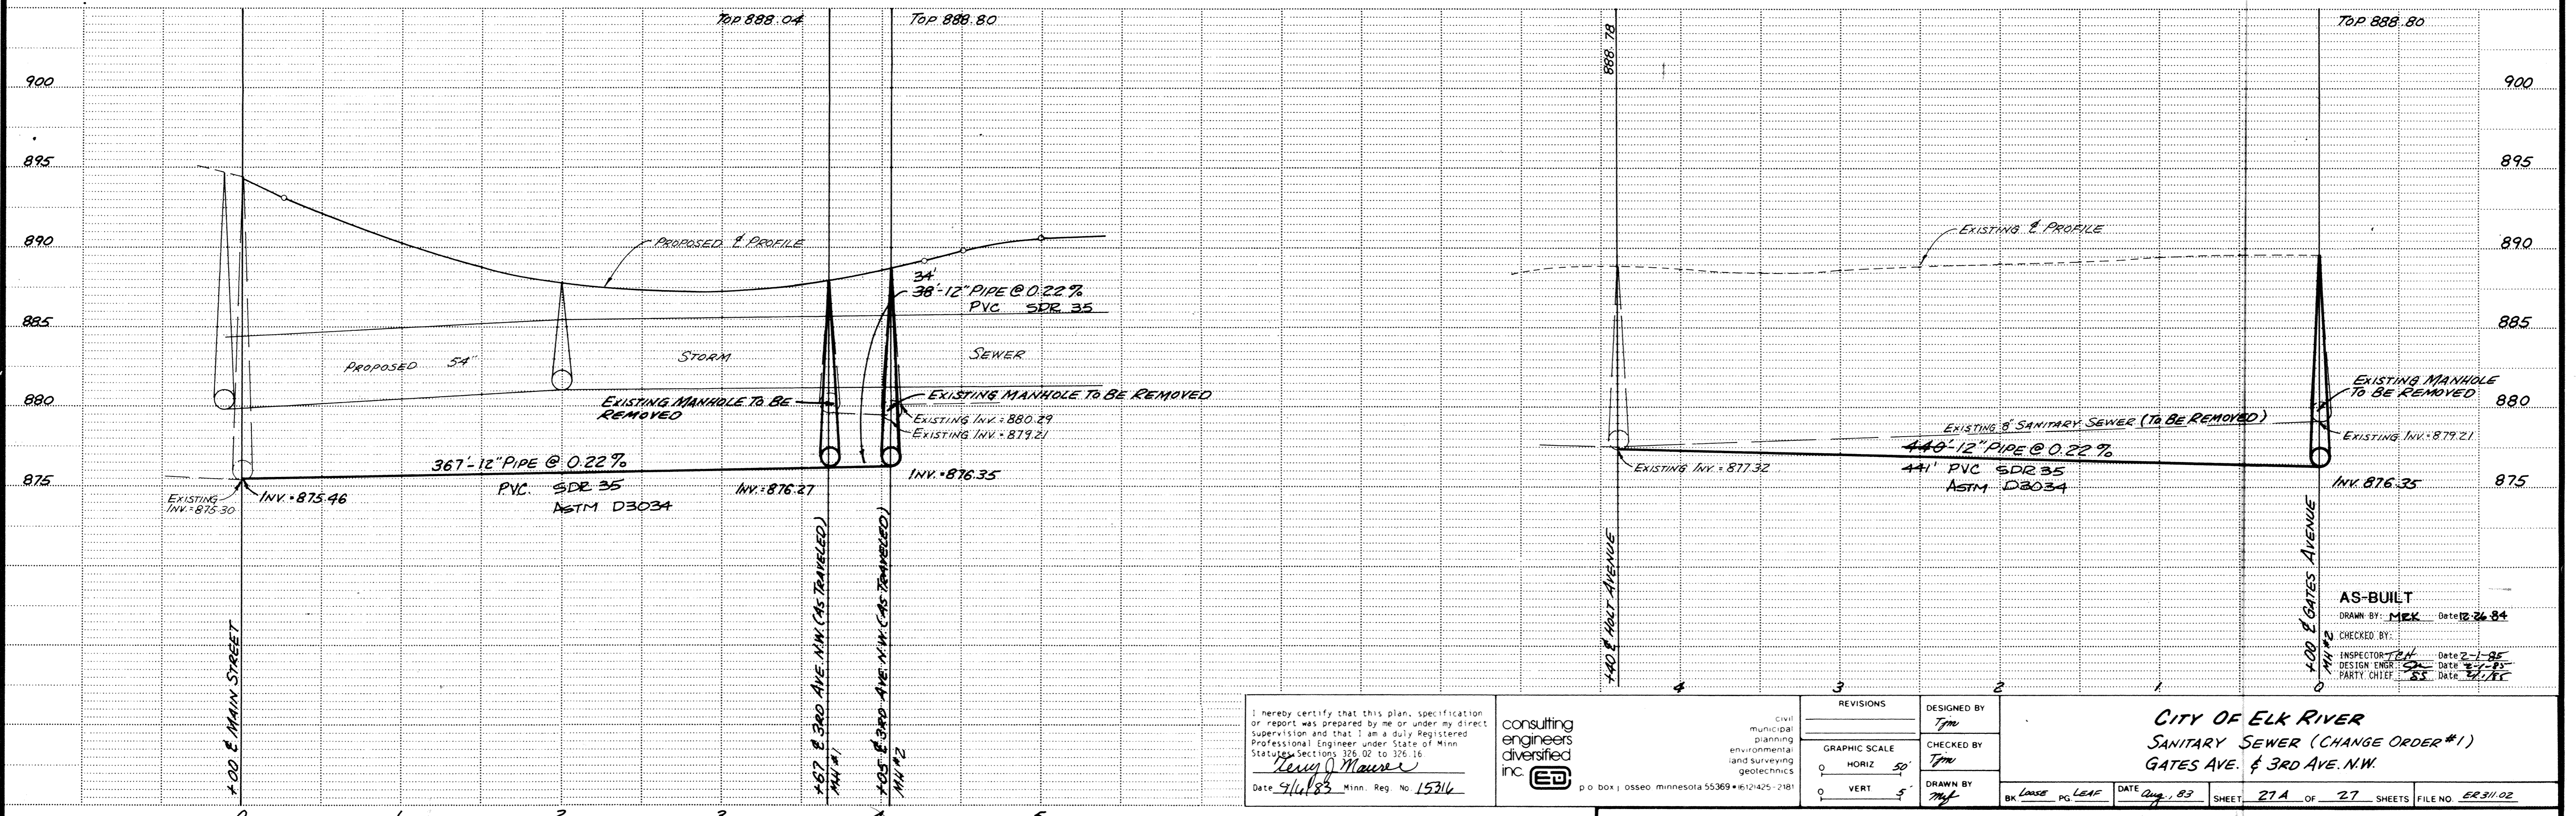

I hereby certify that this plan, specification or report was prepared by me or under my direct supervision and that I am a duly Registered Professional Engineer under State of Minn. Statutes Sections 326.02 to 326.16  
*Kenny J. Maurer*  
Date 9/16/83 Minn. Reg. No. 15316

consulting engineers diversified inc  
Civil municipal planning environmental land surveying geotechnics  
p o box 1 osseo minnesota 55369 #612/425-2181

REVISIONS	

DESIGNED BY: Tjm  
CHECKED BY: Tjm  
DRAWN BY: Tjm  
DATE: Aug, 83  
SHEET: 27A OF 27 SHEETS  
FILE NO: ER31102

CITY OF ELK RIVER  
SANITARY SEWER (CHANGE ORDER #1)  
GATES AVE. & 3RD AVE. NW

DRAWING NUMBER GATES 83 27A  
DRAWING NUMBER 27A  
DRAWING NUMBER 68