GUARDIAN ANGELS SANITARY SEWER, WATERMAIN AND TRAIL IMPROVEMENTS WEST RD. #4 NORTH RD. #5 EAST RD. #6 SOUTH RD. #7 & #8 BOSTON STREET#12 SANITARY SEWER AND WATERMAIN IMPROVEMENTS

RAILROAD DRIVE #13 & #14

SANITARY SEWER, WATERMAIN AND STREET IMPROVEMENTS

JACKSON/HOLT#15, #16, #17

SANITARY SEWER AND WATERMAIN IMPROVEMENTS

I HEREBY CERTIFY THAT THIS PLAN, SPECIFICATION, OR REPORT WAS PREPARED BY ME OR UNDER MY DIRECT SUPERVISION AND THAT I AM A DULY REGISTERED PROFESSIONAL ENGINEER UNDER THE LAWS OF THE STATE OF MINNESOTA. DATE 5-28-98 REG.NO. 18568



1326 ENERGY PARK DRIVE ST. PAUL, MINNESOTA 55108 (612) 644-4389

Howard R. Green Company consulting engineers

PREPARED FOR:



MAY 1998


SHEET 1 OF 21

CITY OF ELK RIVER

Pursuant to the requirements of M.S. 216D.04, the state one-call notification center was contacted on APRIL 15, 1998, and these plans include the type, size and general location of underground facilities as reported by the affected operators of those facilities as of the date of completion of these final drawings. This information may not be relied on as warranting the actual presence, characteristics, or location of the underground facilities, and does not relieve any person from complying with state notification and location requirements prior to excavation.

> CONTRACTOR: REDSTONE CONST. SUPT. DENNY FOREMAN PAUL

10" - 8" - 6" DIP GRIFFIN MH'S CRETEX

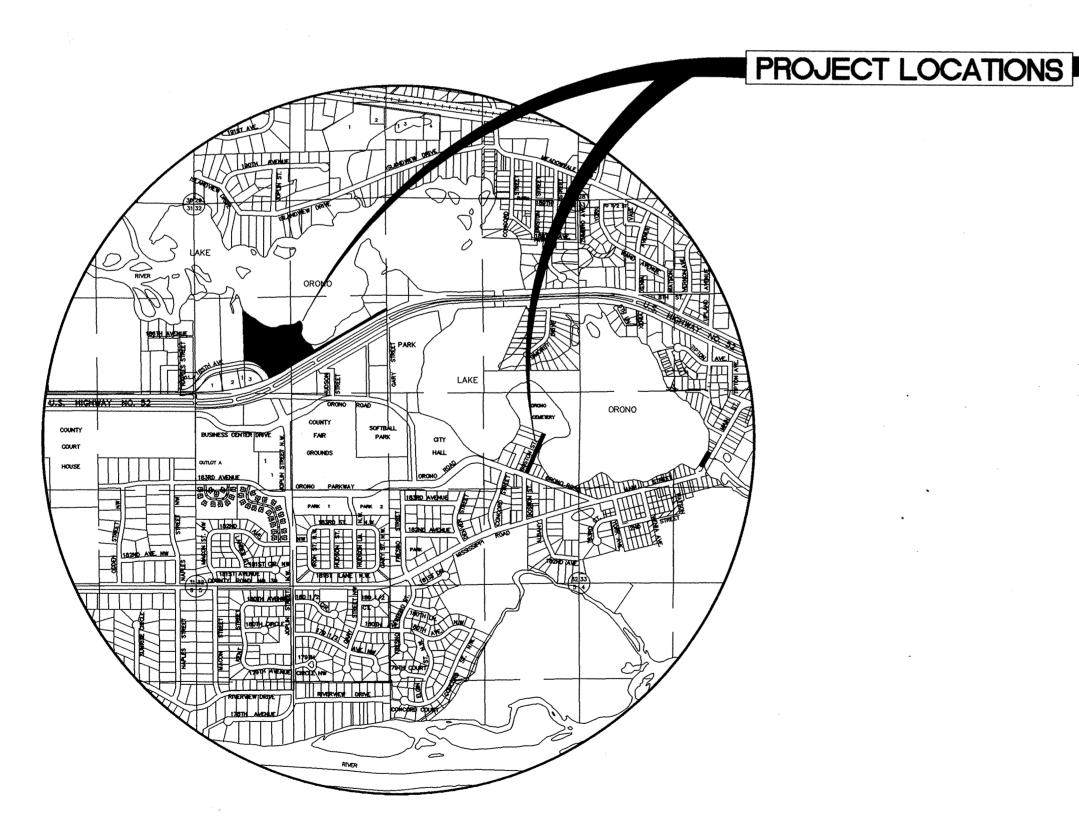

GUARDIAN ANGELS AND BOSTON STREET

LOCATION MAP

RECORD PLAN JULY, 1999



JACKSON/HOLT AND RAILROAD DRIVE

ER691-t

1401 1350