
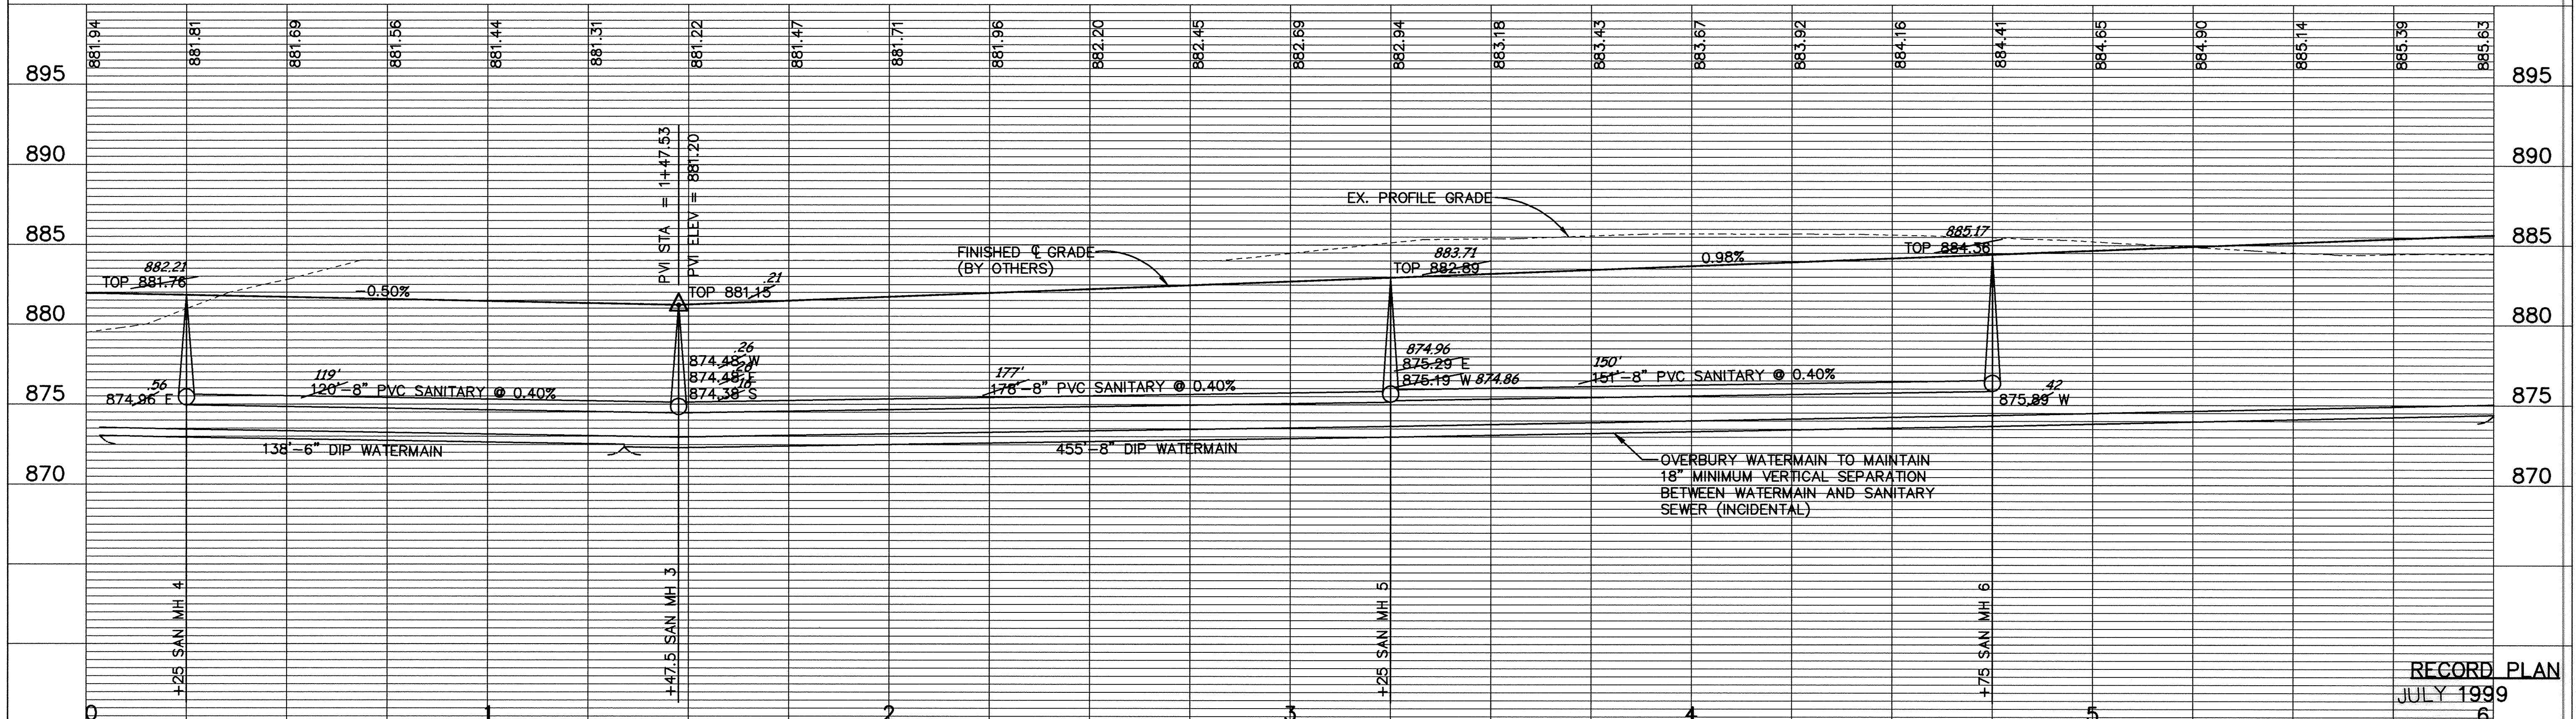


NORTH ROAD

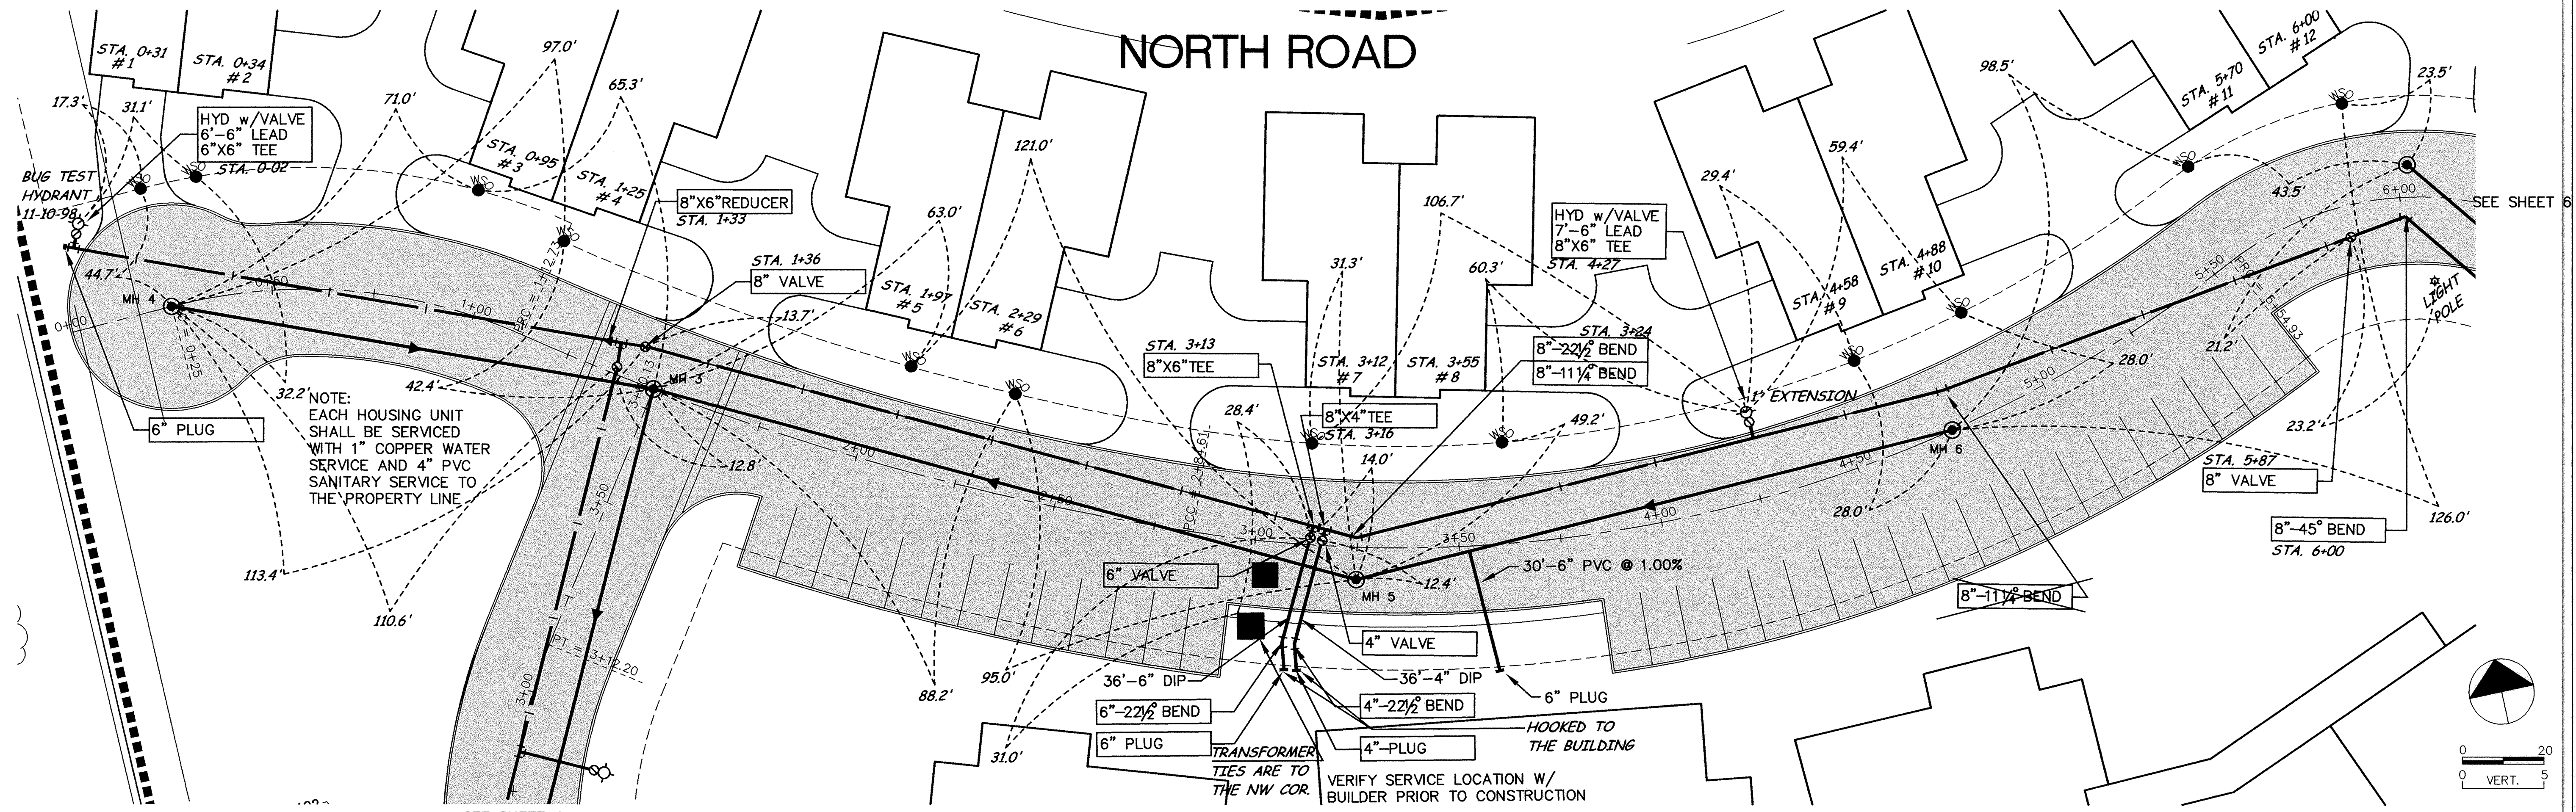

DESIGNED BY: PB JOB DATE: MAY 1998
 DRAWN BY: RKM JOB NUMBER: 803691J
 APPROVED: CAD DATE: MAY 1998
 CAD FILE: 803691-2

I HEREBY CERTIFY THAT THIS PLAN, SPECIFICATION, OR REPORT WAS PREPARED BY ME OR UNDER MY DIRECT SUPERVISION AND THAT I AM A DULY REGISTERED PROFESSIONAL ENGINEER UNDER THE LAWS OF THE STATE OF MINNESOTA.
 DATE: 5-26-98 REG. NO.: 18508

NO.	DATE	BY	REVISION DESCRIPTION

Howard R. Green Company
 CONSULTING ENGINEERS

1326 ENERGY PARK DRIVE
 ST. PAUL, MINNESOTA 55108
 (612) 644-4389

CITY OF ELK RIVER
GUARDIAN ANGELS
 UTILITY IMPROVEMENTS

SANITARY SEWER AND WATERMAIN
NORTH ROAD
 STA. 0+00 TO STA. 6+00

SHEET NO.
5
 OF
21

RECORD PLAN
 JULY 1999

1397-1377