
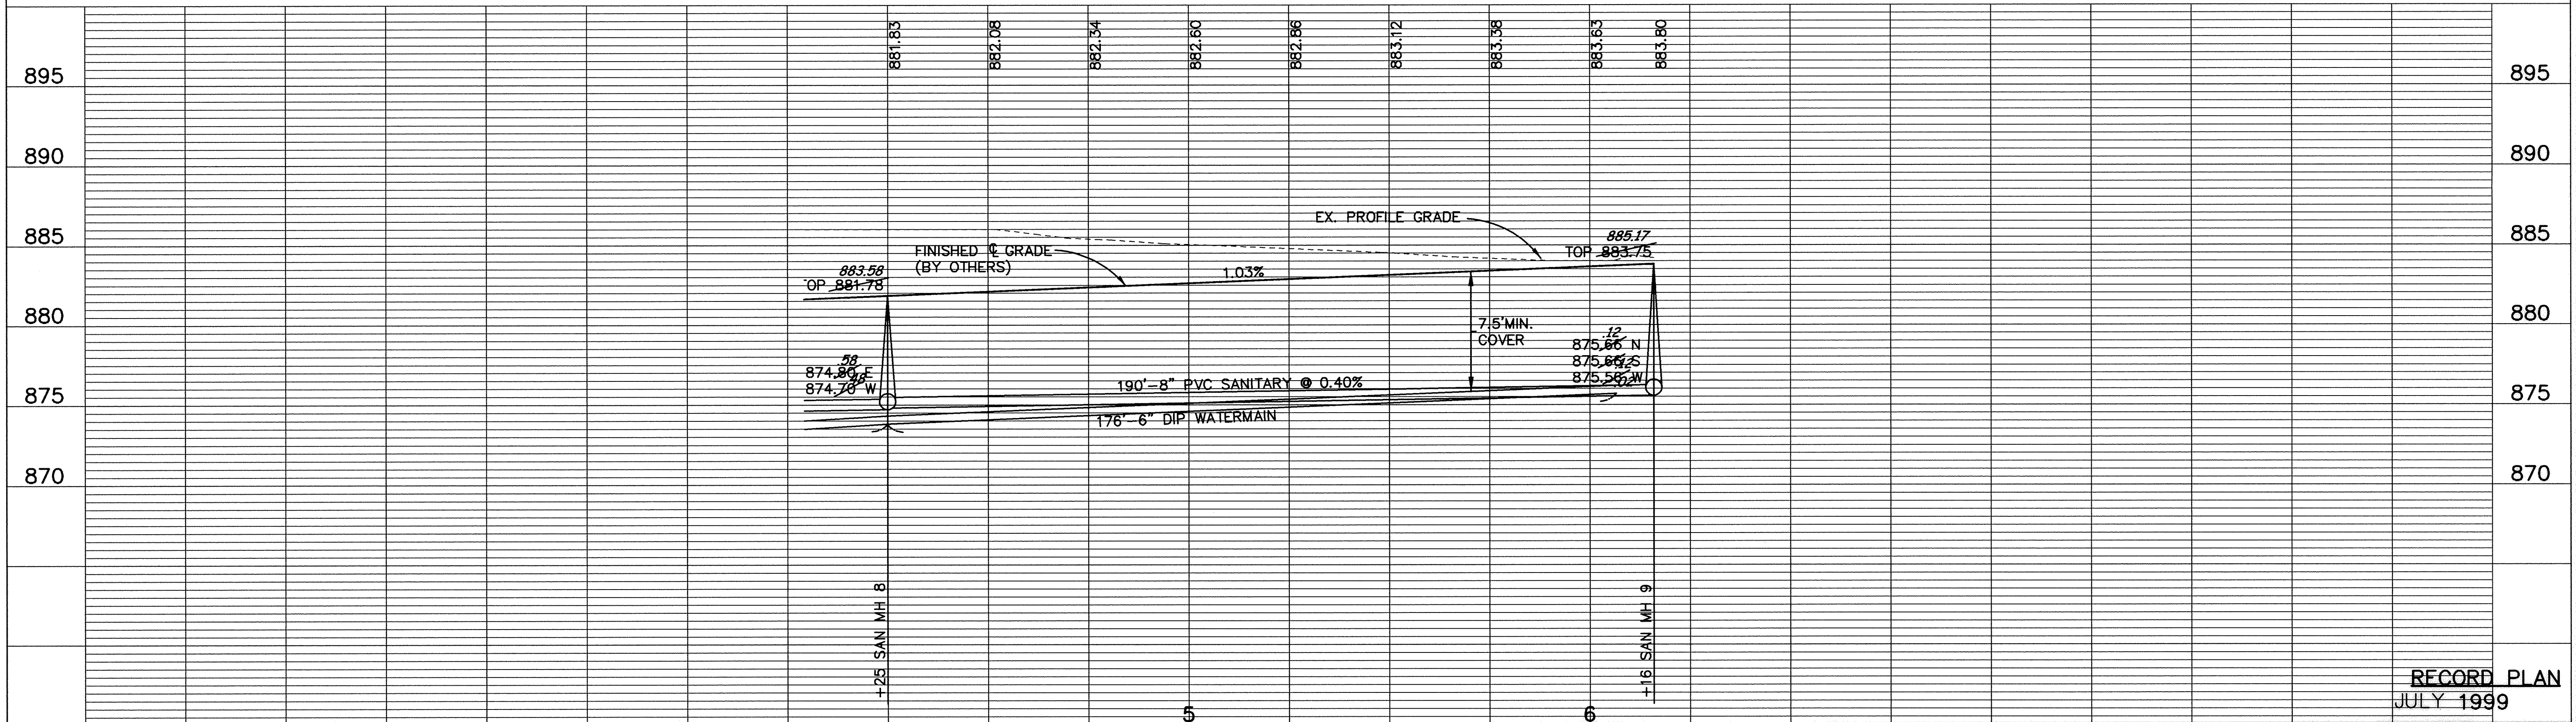
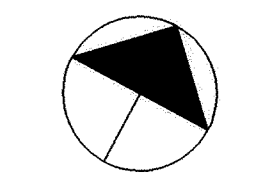


SOUTH ROAD

SEE SHEET 6

SEE SHEET 7

SEE SHEET 6

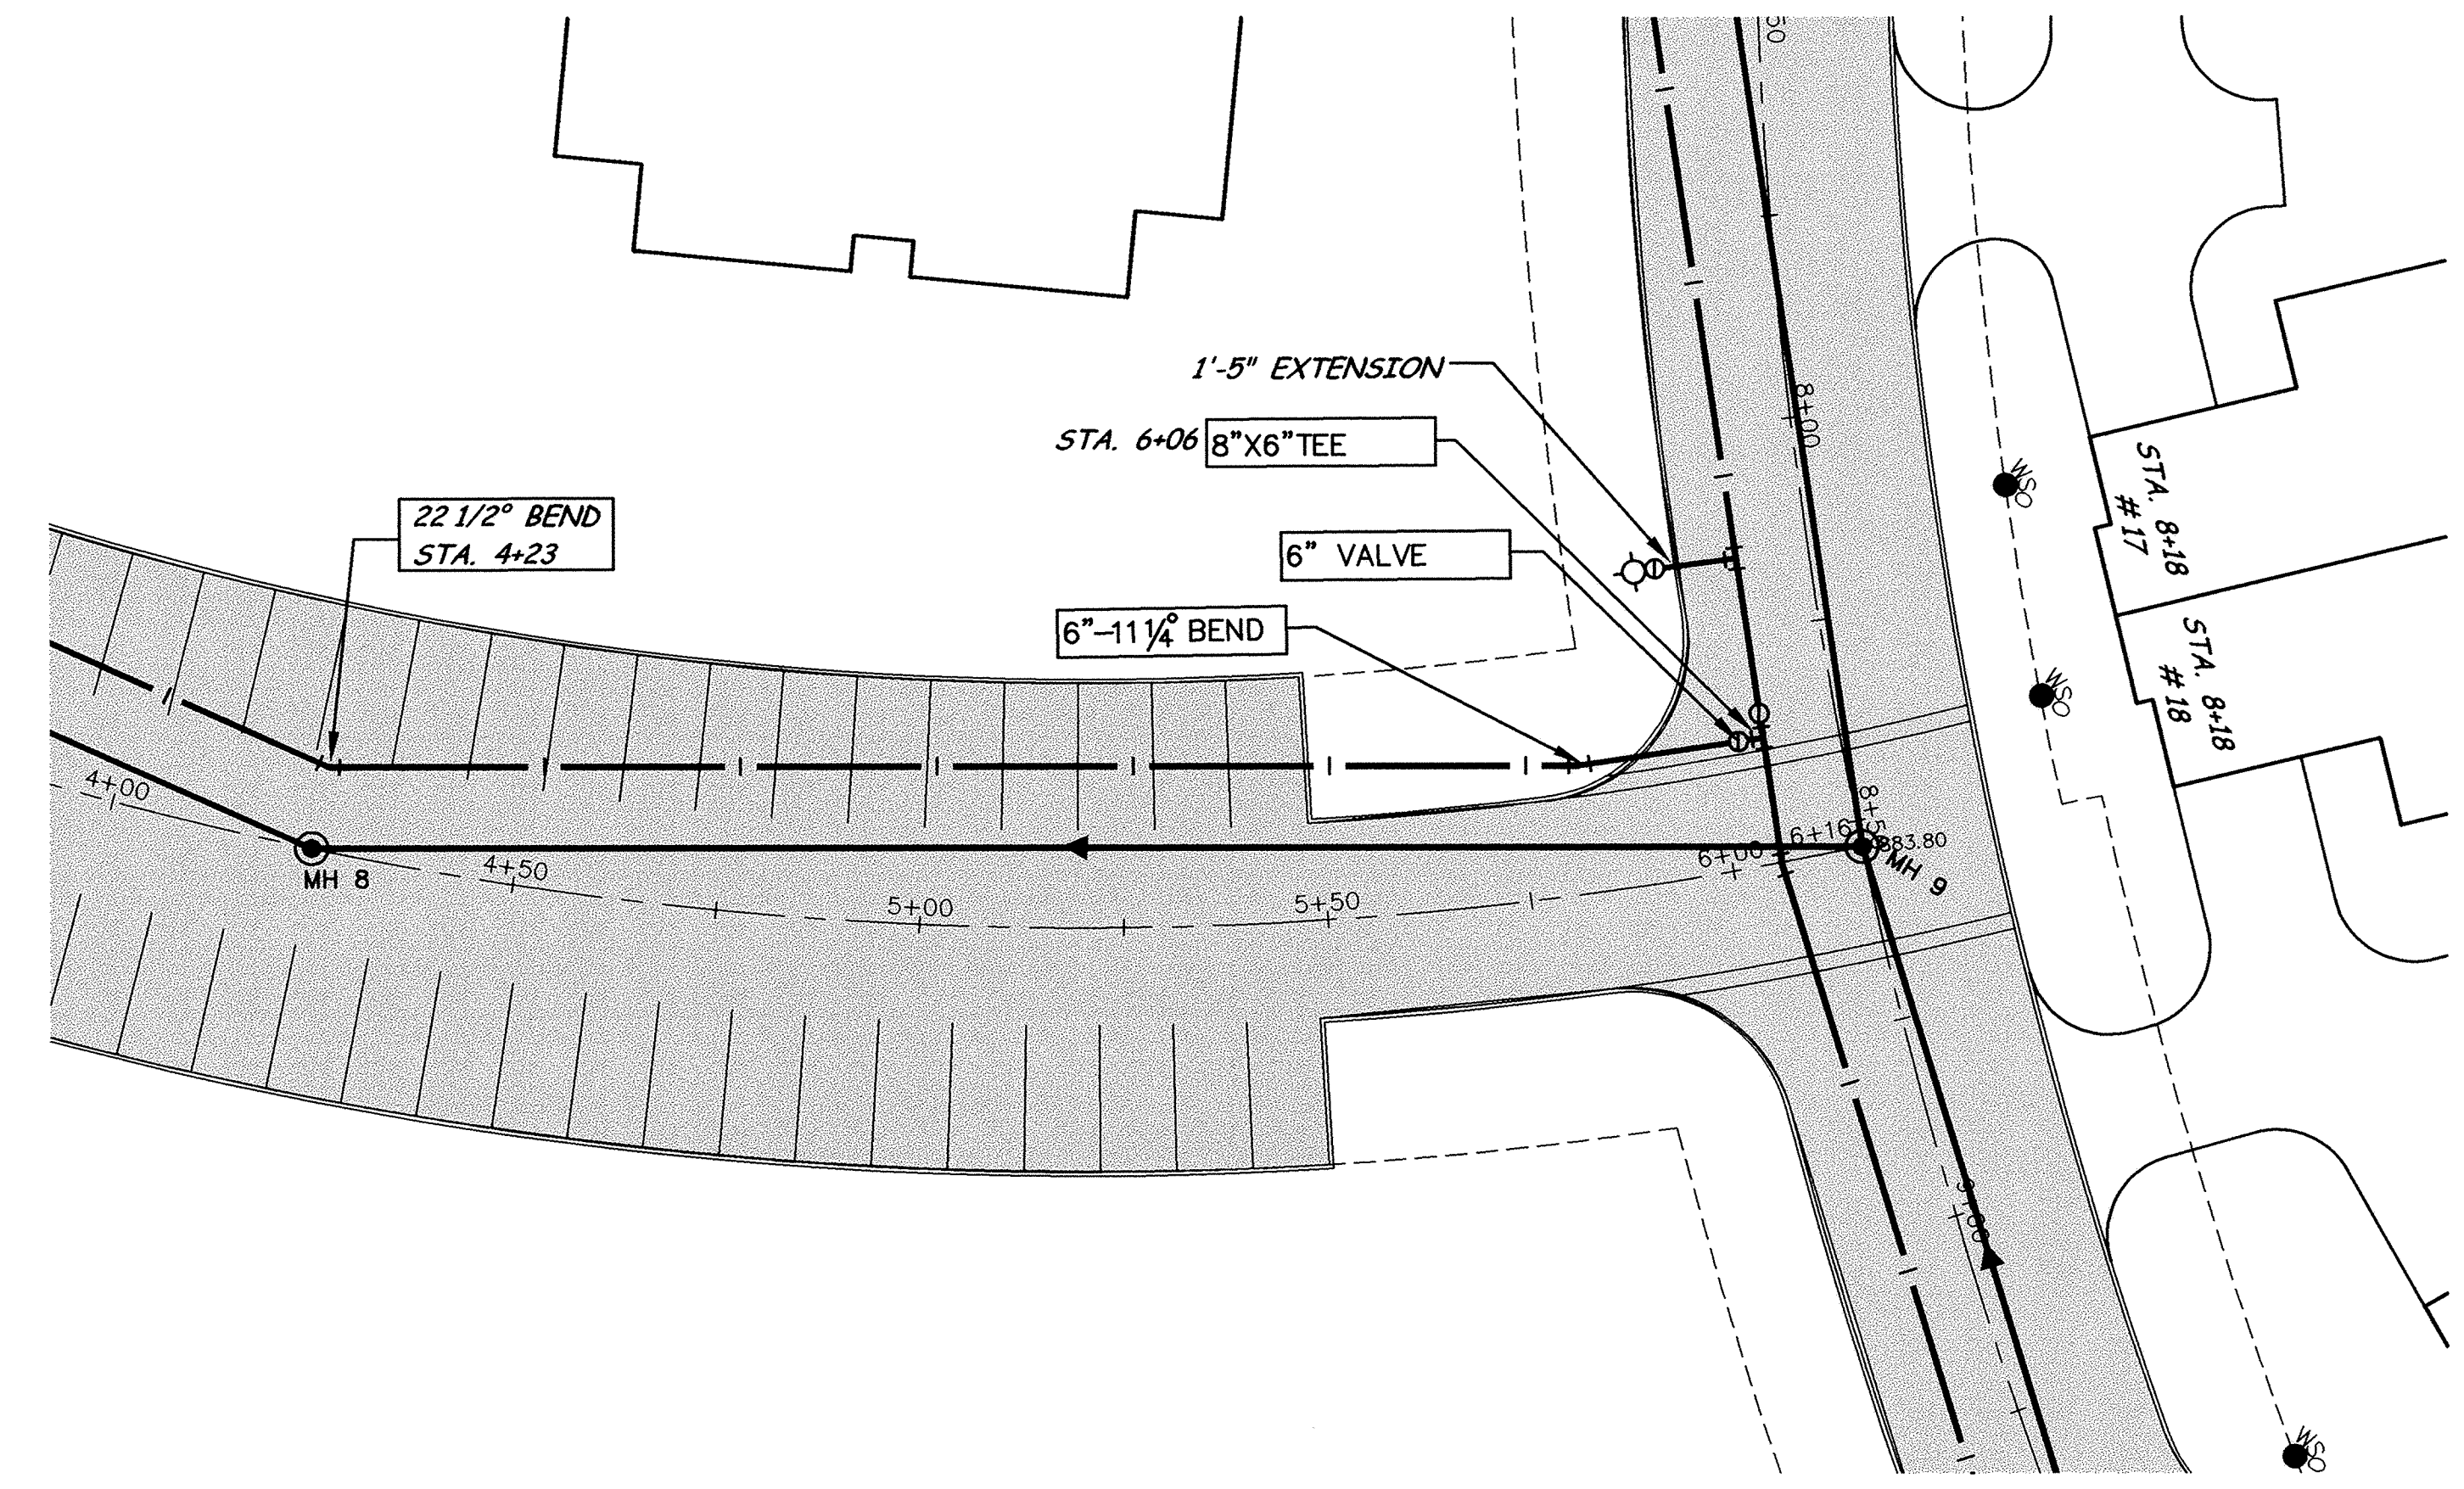

RECORD PLAN
JULY 1999

DESIGNED BY: PB JOB DATE: MAY 1998
 DRAWN BY: RKM JOB NUMBER: 803691J
 APPROVED: CAD DATE: MAY 1998
 CAD FILE: 803691-4A

I HEREBY CERTIFY THAT THIS PLAN, SPECIFICATION, OR REPORT WAS PREPARED BY ME OR UNDER MY DIRECT SUPERVISION AND THAT I AM A DULY REGISTERED PROFESSIONAL ENGINEER UNDER THE LAWS OF THE STATE OF MINNESOTA.
 DATE: 6-24-98 REG. NO.: 18568

NO.	DATE	BY	REVISION DESCRIPTION
1.	6/22/98		VALVE LOCATION CHANGED PER CITY COMMENT

1326 ENERGY PARK DRIVE
 ST. PAUL, MINNESOTA 55108
 (612) 644-4389
Howard R. Green Company
 CONSULTING ENGINEERS

CITY OF ELK RIVER
 GUARDIAN ANGELS
 UTILITY IMPROVEMENTS

SANITARY SEWER AND WATERMAIN
 SOUTH ROAD
 STA. 4+25 TO STA. 6+16

SHEET NO.
 8
 OF
 21

1374