

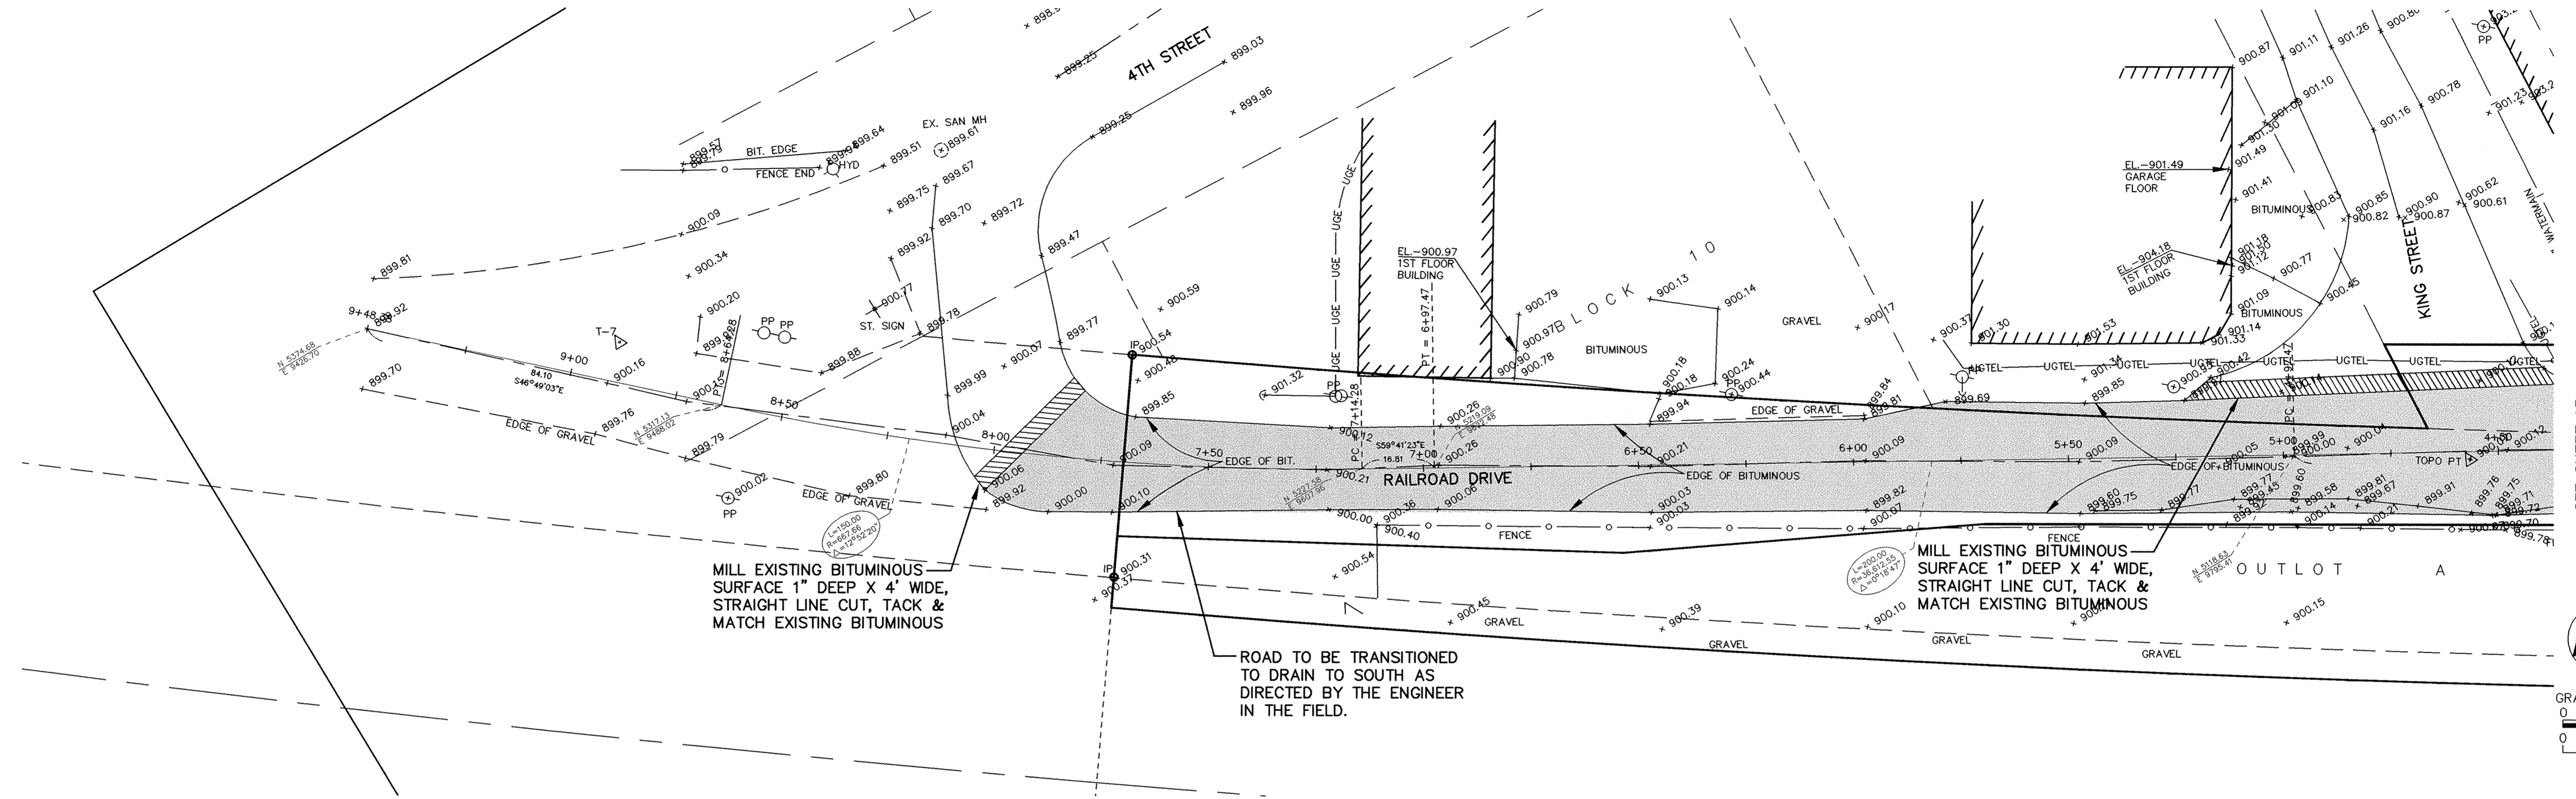
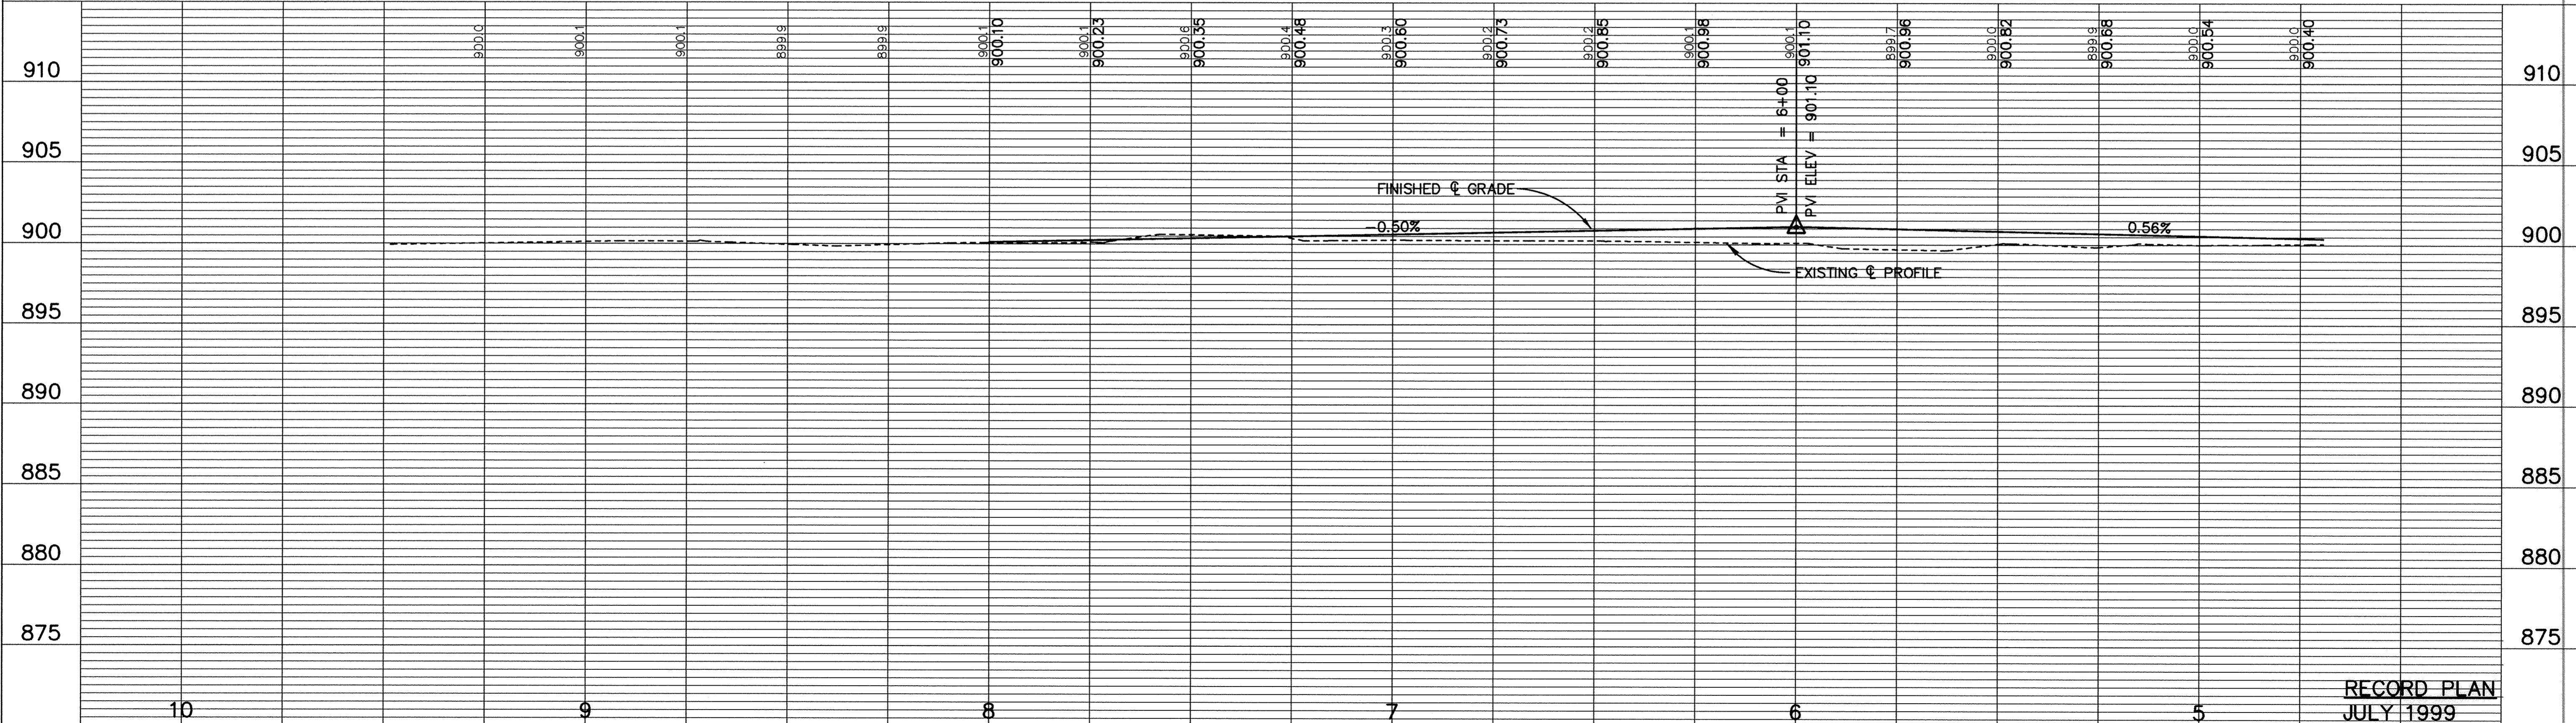


RAILROAD DRIVE

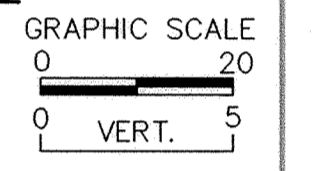

SEE SHEET 13

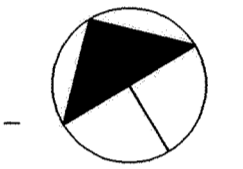

RECORD PLAN
 JULY 1999

DRAWN BY: LK JOB DATE: DATE
 APPROVED: JOB NUMBER 801840J
 CAD DATE: APRIL 1998
 CAD FILE: 801840J-P2

I HEREBY CERTIFY THAT THIS PLAN, SPECIFICATION, OR REPORT WAS PREPARED BY ME OR UNDER MY DIRECT SUPERVISION AND THAT I AM A DULY REGISTERED PROFESSIONAL ENGINEER UNDER THE LAWS OF THE STATE OF MINNESOTA.
 DATE 5-28-98 REG. NO. 18568

NO.	DATE	BY	REVISION DESCRIPTION



Howard R. Green Company
 CONSULTING ENGINEERS

1326 ENERGY PARK DRIVE
 ST. PAUL, MINNESOTA 55108
 (612) 644-4389

CITY OF ELK RIVER
 RAILROAD DRIVE
 STREET AND UTILITY IMPROVEMENTS

STREET
 RAILROAD DRIVE
 5+00 TO 8+00

SHEET NO.
 14
 OF
 21

1389 1388