


193RD AVENUE NW

MANDRELED SEWER 11-10-98 (PASSED)
 PRESSURE TEST SAN. SEWER 8-5-98 PASS
 PRESSURE TEST WATERMAIN 8-5-98 PASS
 CONDUCTIVITY 8-25-98 (PASS)
 BUG TEST TAKEN 8-5-98

HYD w/VALVE
 31'-6" LEAD
 10"X6" TEE
 STA. 4+40



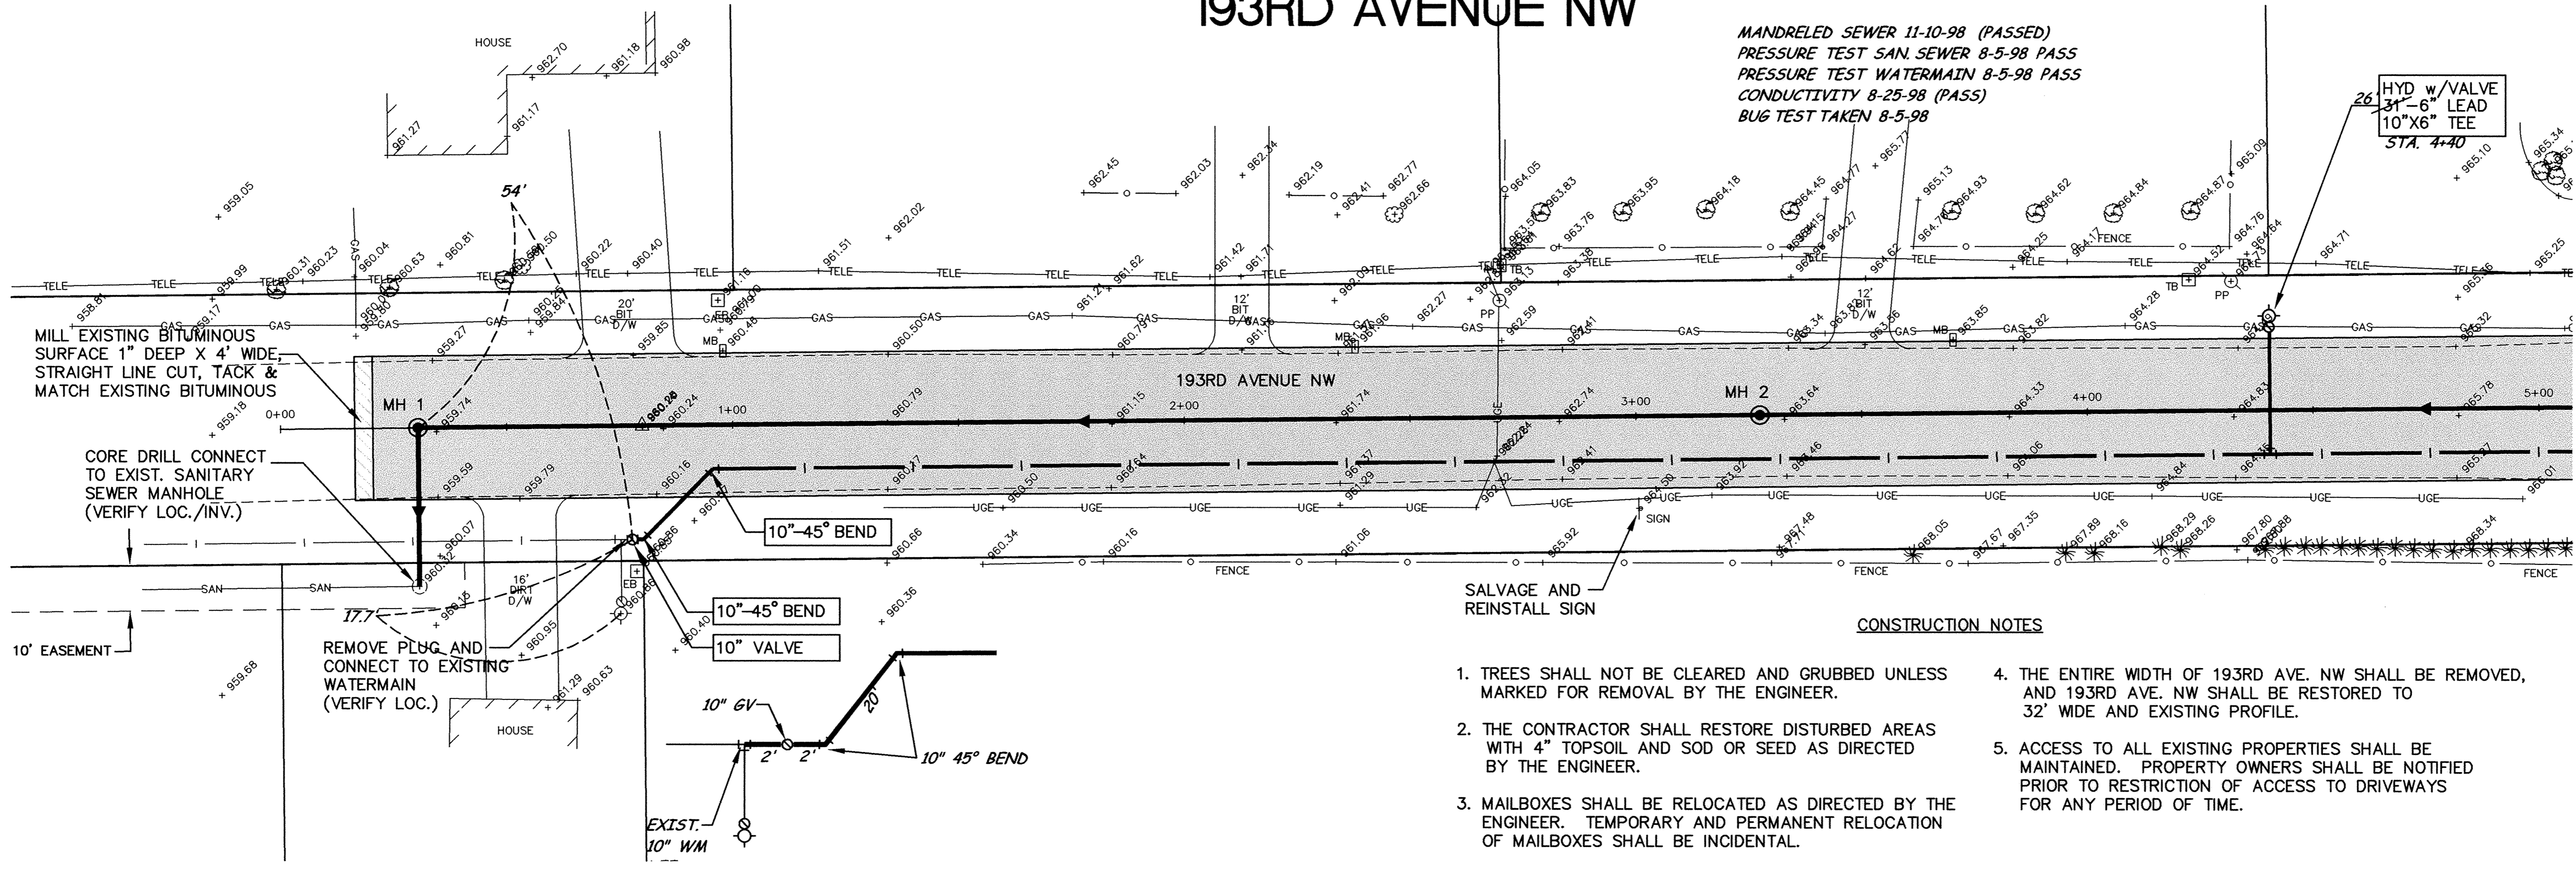


SEE SHEET 16

SALVAGE AND REINSTALL SIGN

CONSTRUCTION NOTES

1. TREES SHALL NOT BE CLEARED AND GRUBBED UNLESS MARKED FOR REMOVAL BY THE ENGINEER.
2. THE CONTRACTOR SHALL RESTORE DISTURBED AREAS WITH 4" TOPSOIL AND SOD OR SEED AS DIRECTED BY THE ENGINEER.
3. MAILBOXES SHALL BE RELOCATED AS DIRECTED BY THE ENGINEER. TEMPORARY AND PERMANENT RELOCATION OF MAILBOXES SHALL BE INCIDENTAL.
4. THE ENTIRE WIDTH OF 193RD AVE. NW SHALL BE REMOVED, AND 193RD AVE. NW SHALL BE RESTORED TO 32' WIDE AND EXISTING PROFILE.
5. ACCESS TO ALL EXISTING PROPERTIES SHALL BE MAINTAINED. PROPERTY OWNERS SHALL BE NOTIFIED PRIOR TO RESTRICTION OF ACCESS TO DRIVEWAYS FOR ANY PERIOD OF TIME.

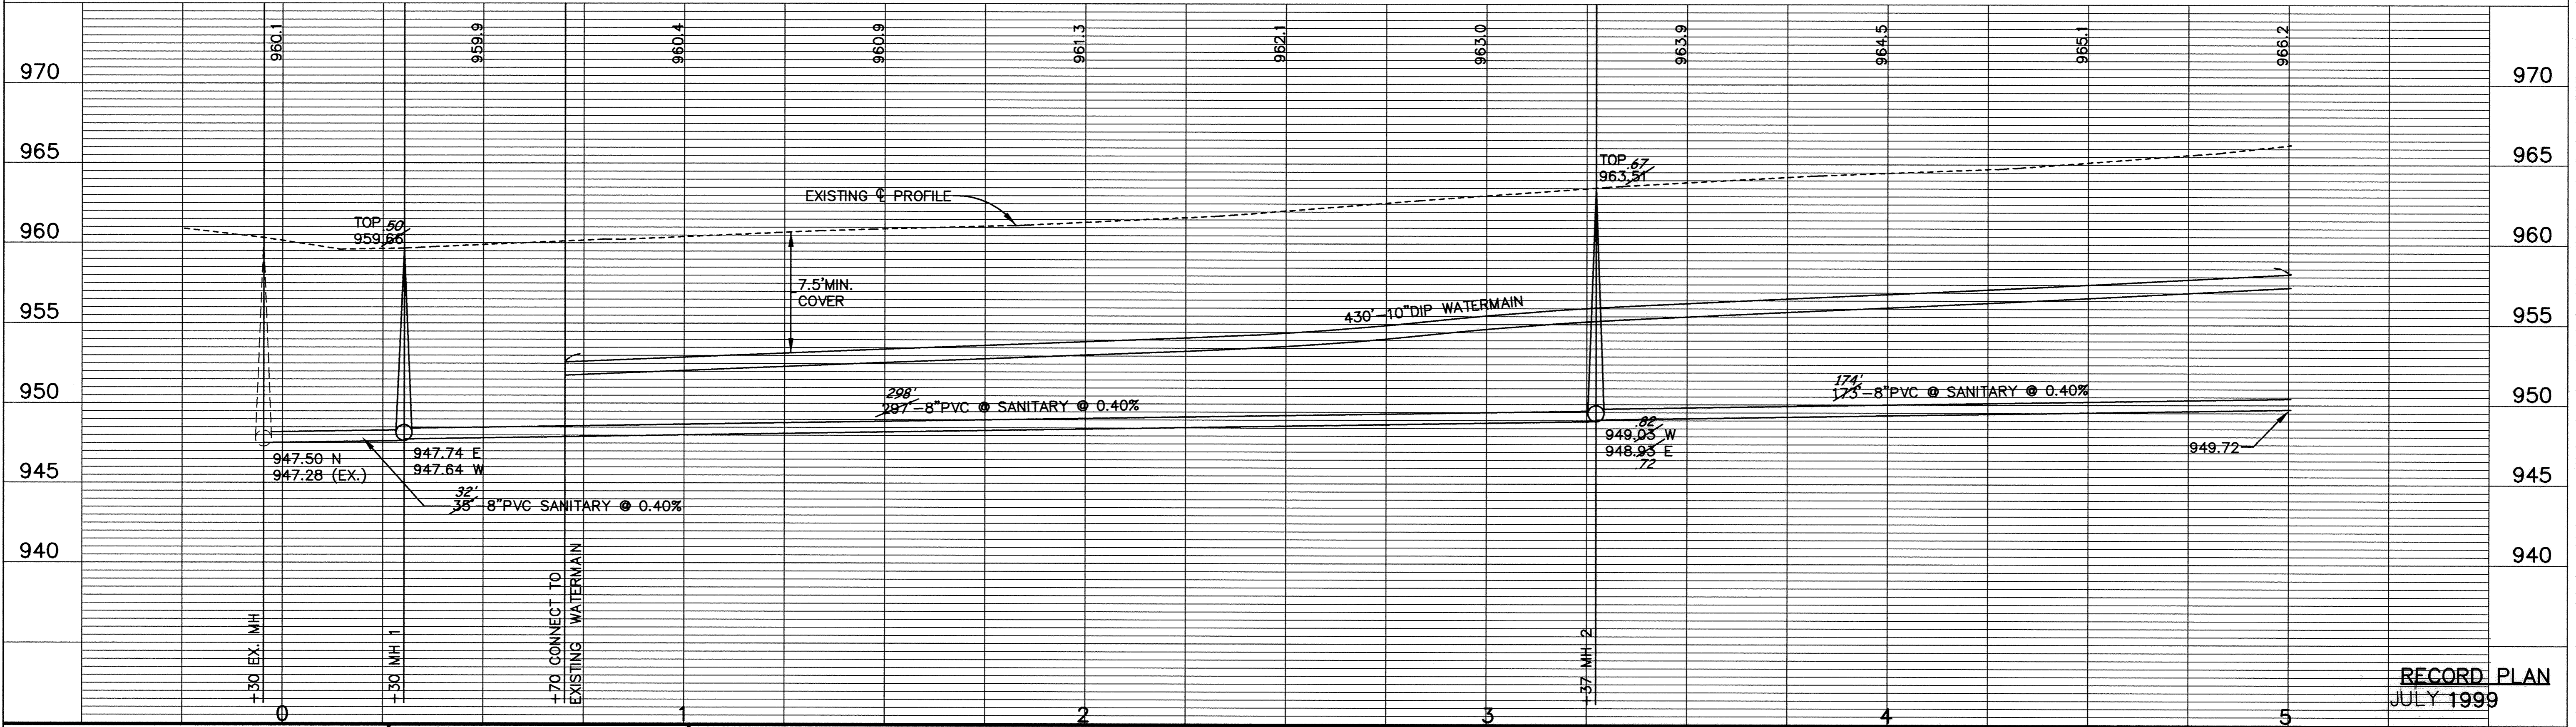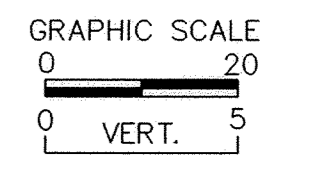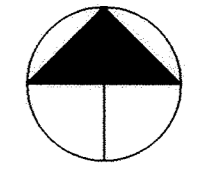

RECORD PLAN
 JULY 1999

DRAWN BY: _____ JOB DATE: APRIL 1998
 APPROVED: _____ JOB NUMBER 803580J
 CAD DATE: APRIL 1998
 CAD FILE: 803580P1

I HEREBY CERTIFY THAT THIS PLAN, SPECIFICATION, OR REPORT WAS PREPARED BY ME OR UNDER MY DIRECT SUPERVISION AND THAT I AM A DULY REGISTERED PROFESSIONAL ENGINEER UNDER THE LAWS OF THE STATE OF MINNESOTA.
 DATE: 6-24-98 REG. NO. 18548

NO.	DATE	BY	REVISION DESCRIPTION
1.	6/22/98		HYDRANT RELOCATED PER CITY COMMENT

1326 ENERGY PARK DRIVE
 ST. PAUL, MINNESOTA 55108
 (612) 644-4389

Howard R. Green Company
 CONSULTING ENGINEERS

CITY OF ELK RIVER
 JACKSON/HOLT
 UTILITY IMPROVEMENTS

SANITARY SEWER AND WATERMAIN
 193RD AVENUE NW
 0+00 TO 5+00

SHEET NO.
 15
 OF
 21

1388/357

DRAWING NUMBER
 GUARD 98
 SAFCO PRODUCTS • NEW HOPE, MINNESOTA
 REORDER BY PART NUMBER 8592
 DRAWING NUMBER
 15