


JACKSON AVENUE/HOLT STREET

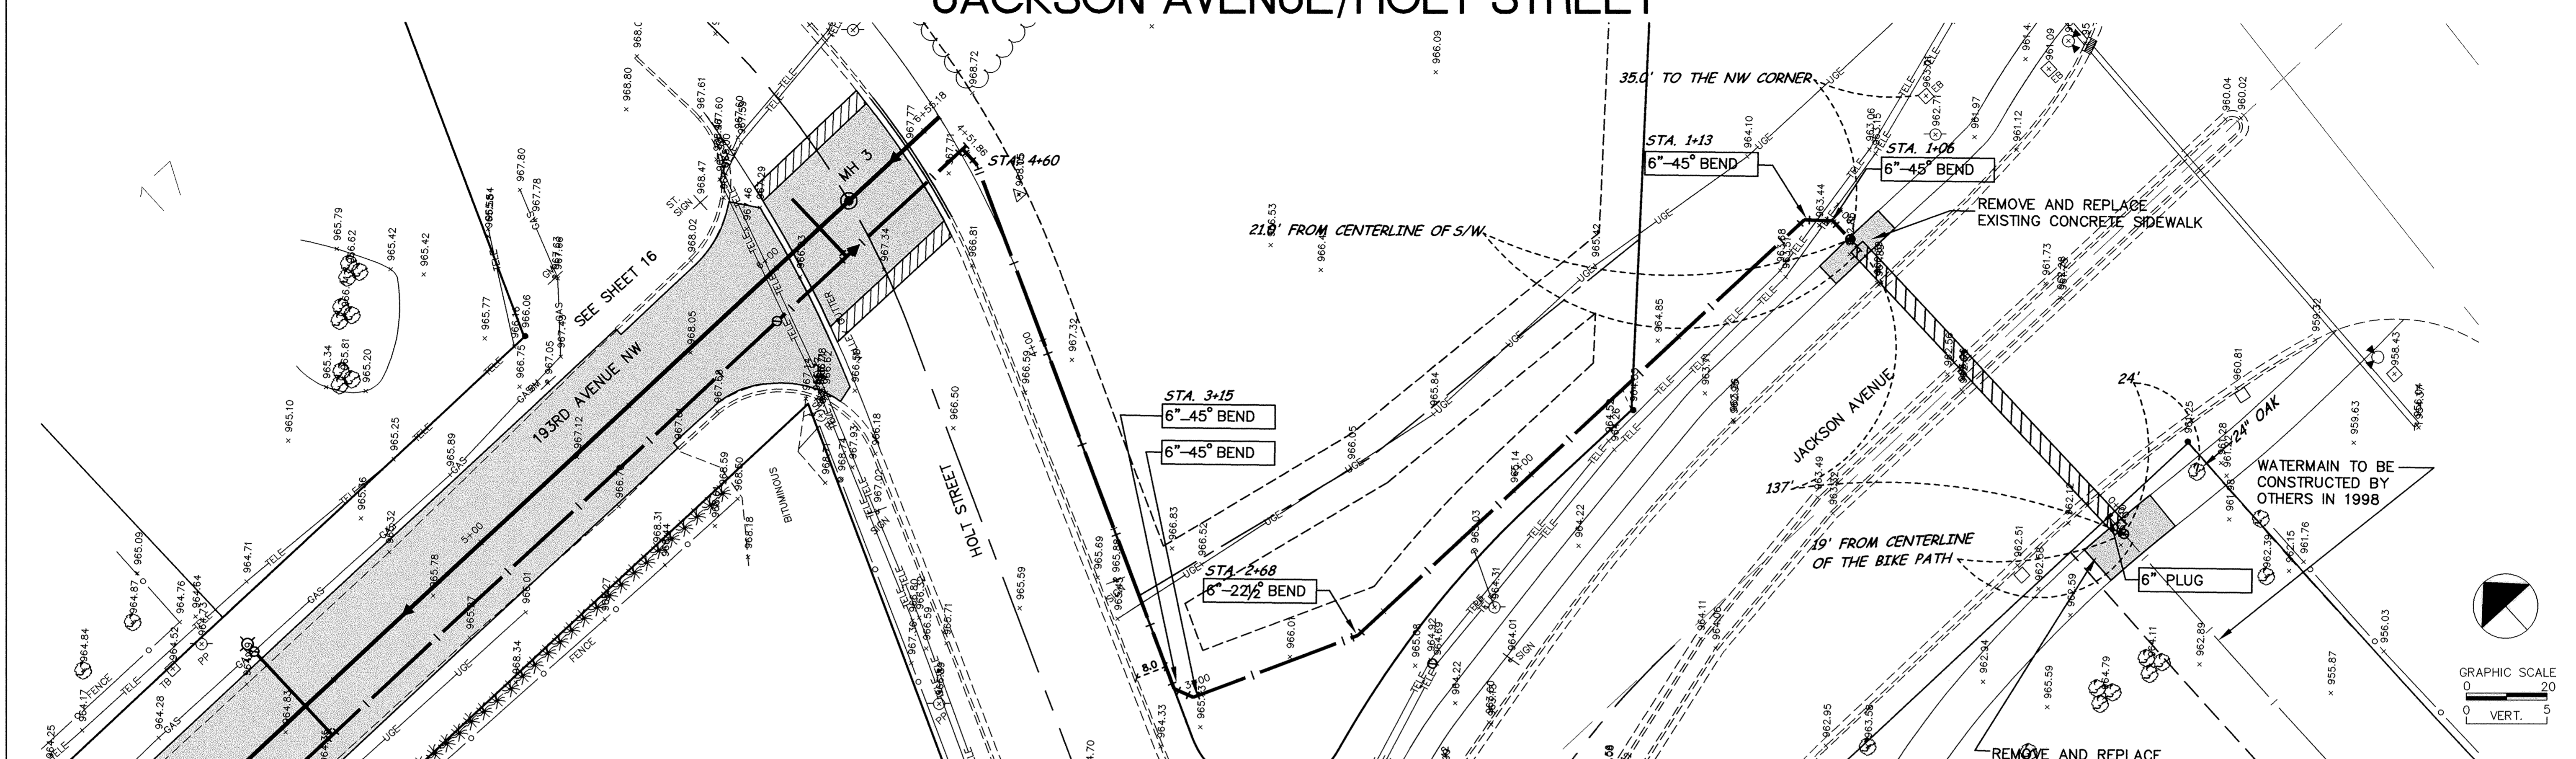

DRAWN BY: EY JOB DATE: MAY 1998
 APPROVED: JOB NUMBER 803580J
 CAD DATE: MAY 1998
 CAD FILE: 803580P3

I HEREBY CERTIFY THAT THIS PLAN, SPECIFICATION, OR REPORT WAS PREPARED BY ME OR UNDER MY DIRECT SUPERVISION AND THAT I AM A DULY REGISTERED PROFESSIONAL ENGINEER UNDER THE LAWS OF THE STATE OF MINNESOTA.
 DATE: 6-24-99 REG. NO. 18548

NO.	DATE	BY	REVISION DESCRIPTION
1.	6/22/98		HYDRANT RELOCATED PER CITY COMMENT

Howard R. Green Company
 CONSULTING ENGINEERS
 1326 ENERGY PARK DRIVE
 ST. PAUL, MINNESOTA 55108
 (612) 644-4389

CITY OF ELK RIVER
JACKSON/HOLT
UTILITY IMPROVEMENTS

WATERMAIN EXTENSION
JACKSON AVENUE/HOLT STREET
 0+00 TO 4+51.86

SHEET NO.
17
 OF
21

RECORD PLAN
JULY 1999

1386 1998

SACO PRODUCTS • NEW HOPE, MINNESOTA
 REORDER BY PART NUMBER 9582
 SACO PRODUCTS • NEW HOPE, MINNESOTA
 REORDER BY PART NUMBER 9582
 SACO PRODUCTS • NEW HOPE, MINNESOTA
 REORDER BY PART NUMBER 9582