

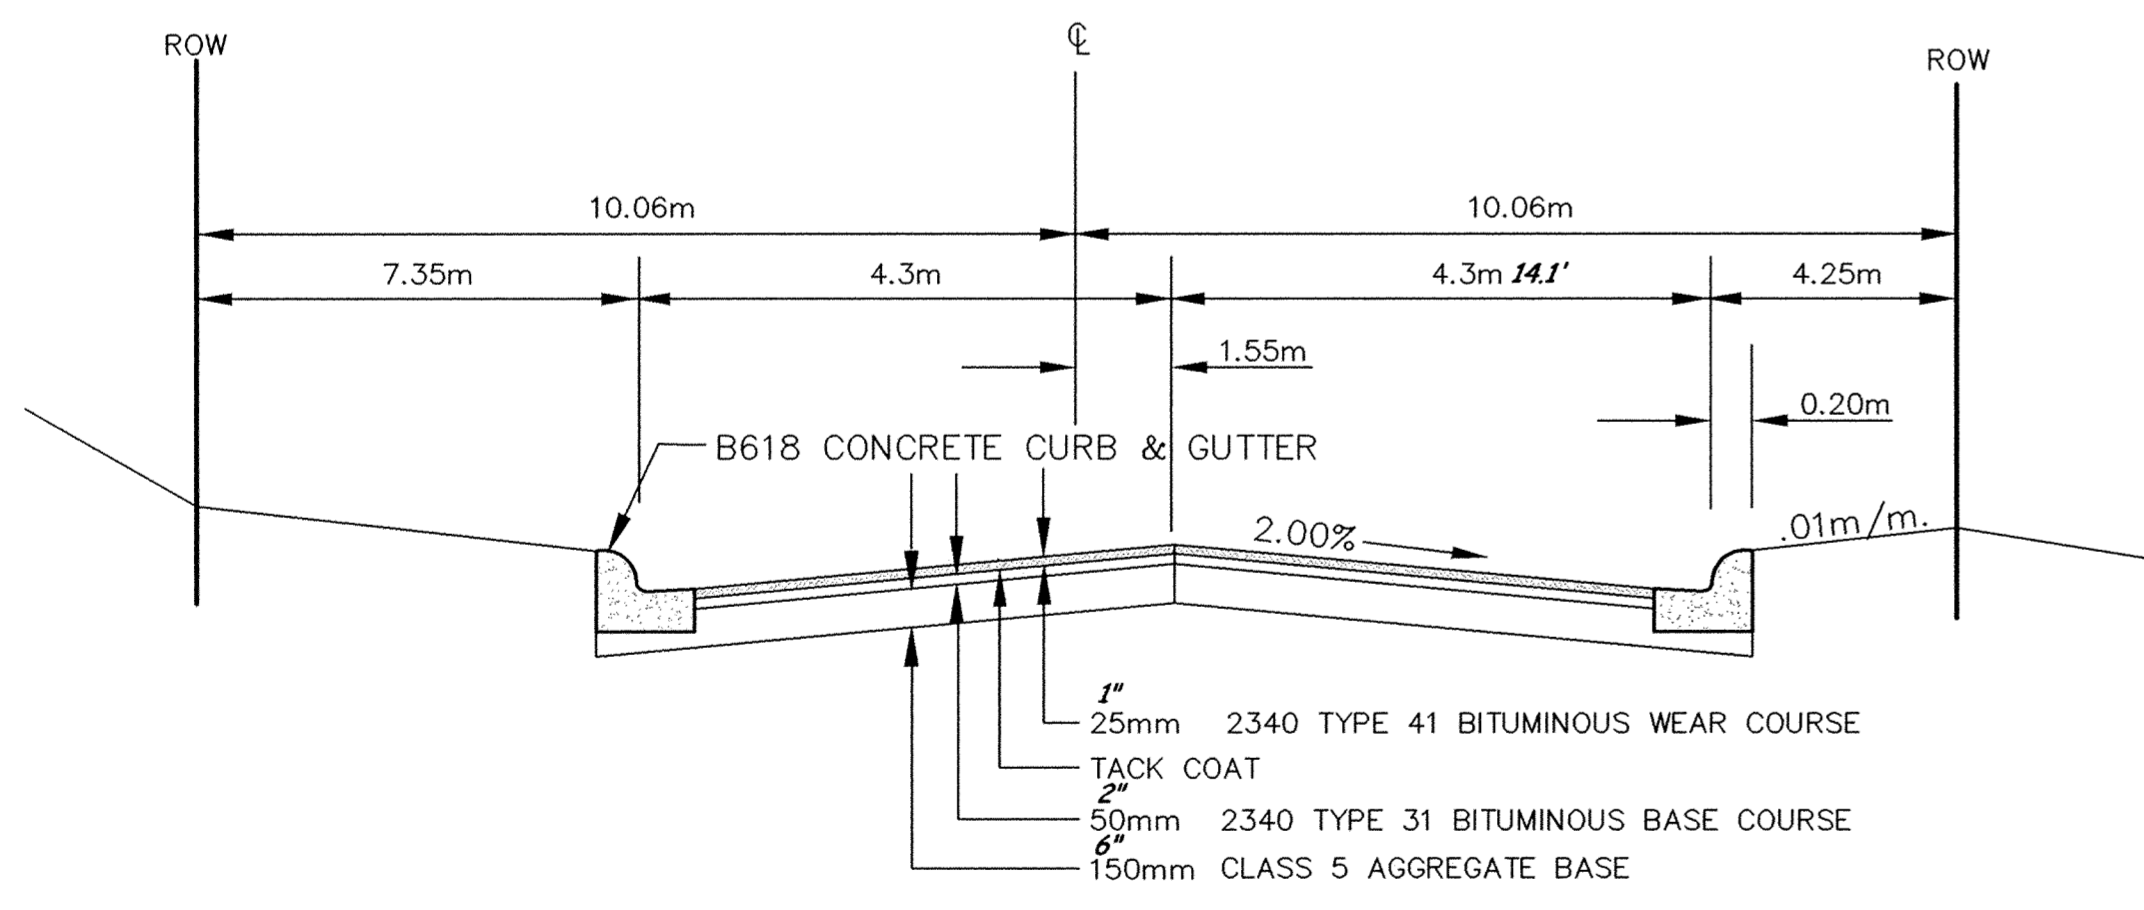


# SCHOOL ST.

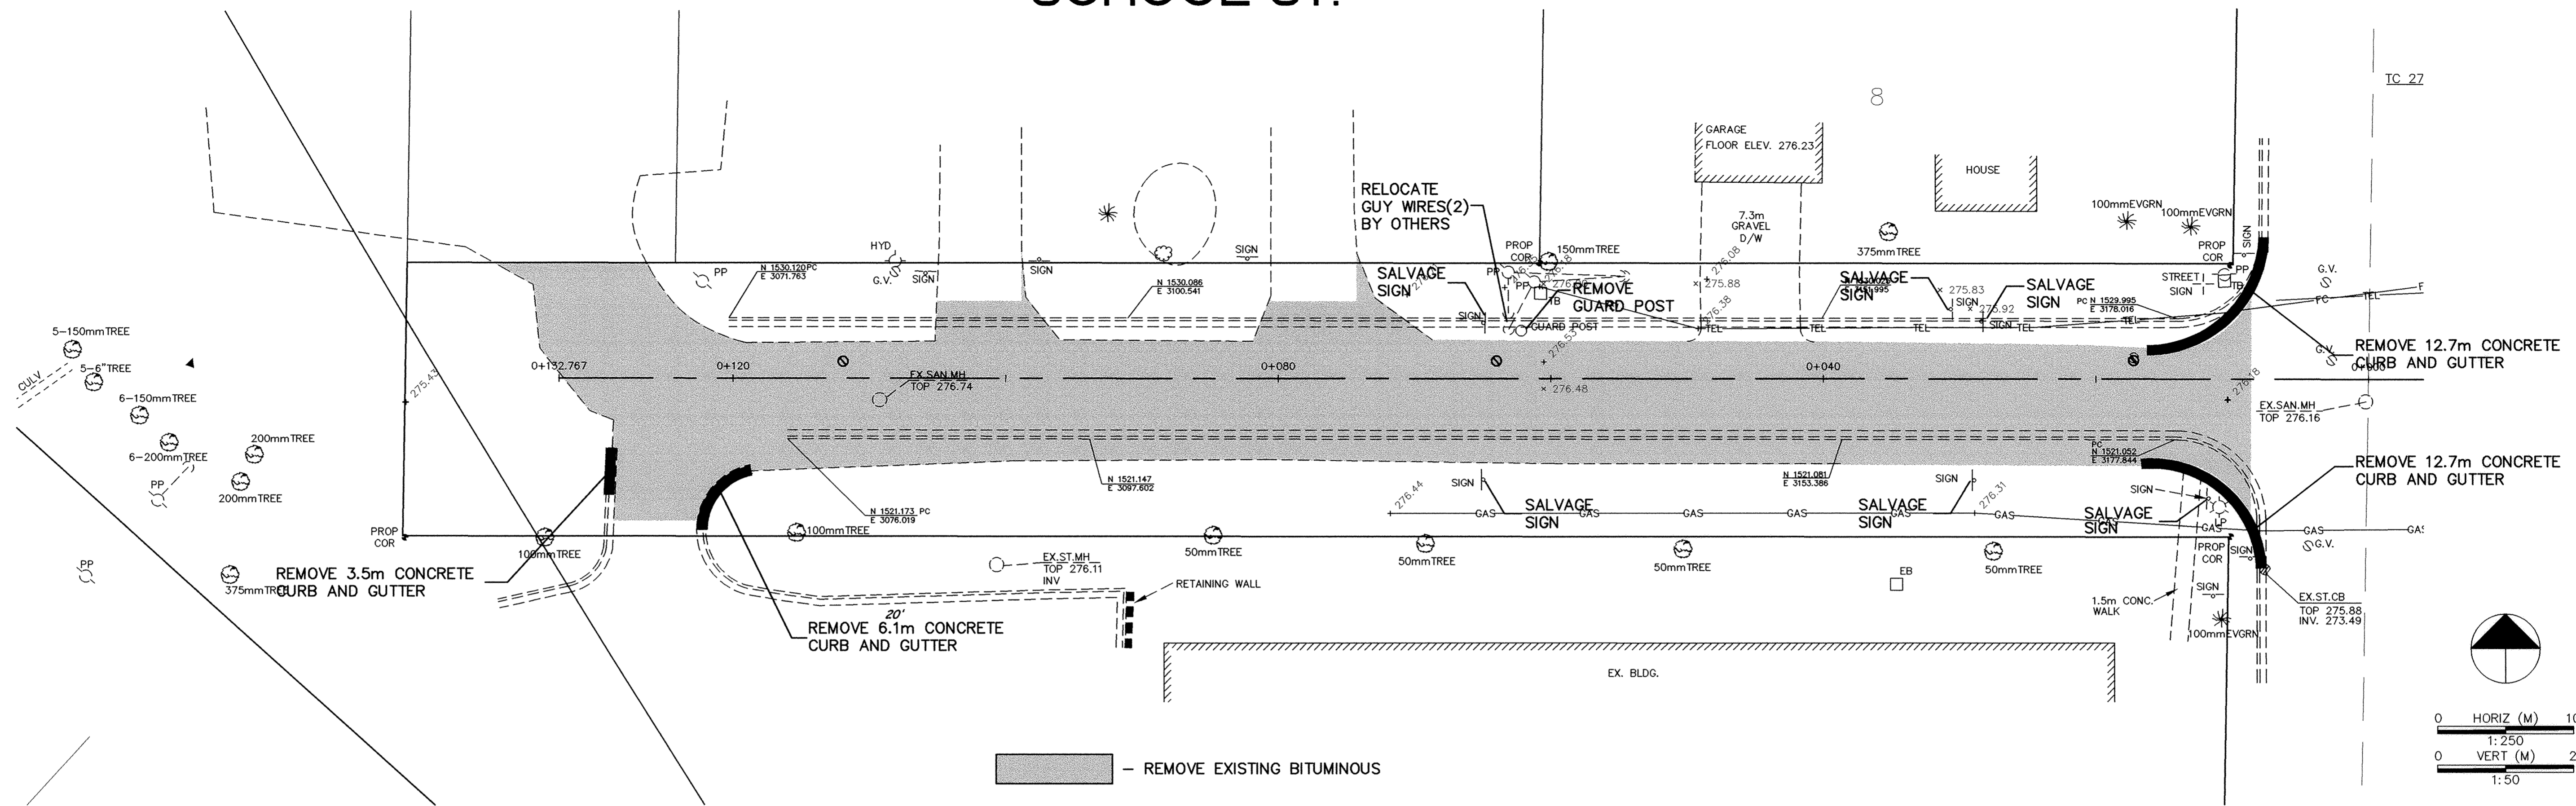

TYPICAL STREET SECTION

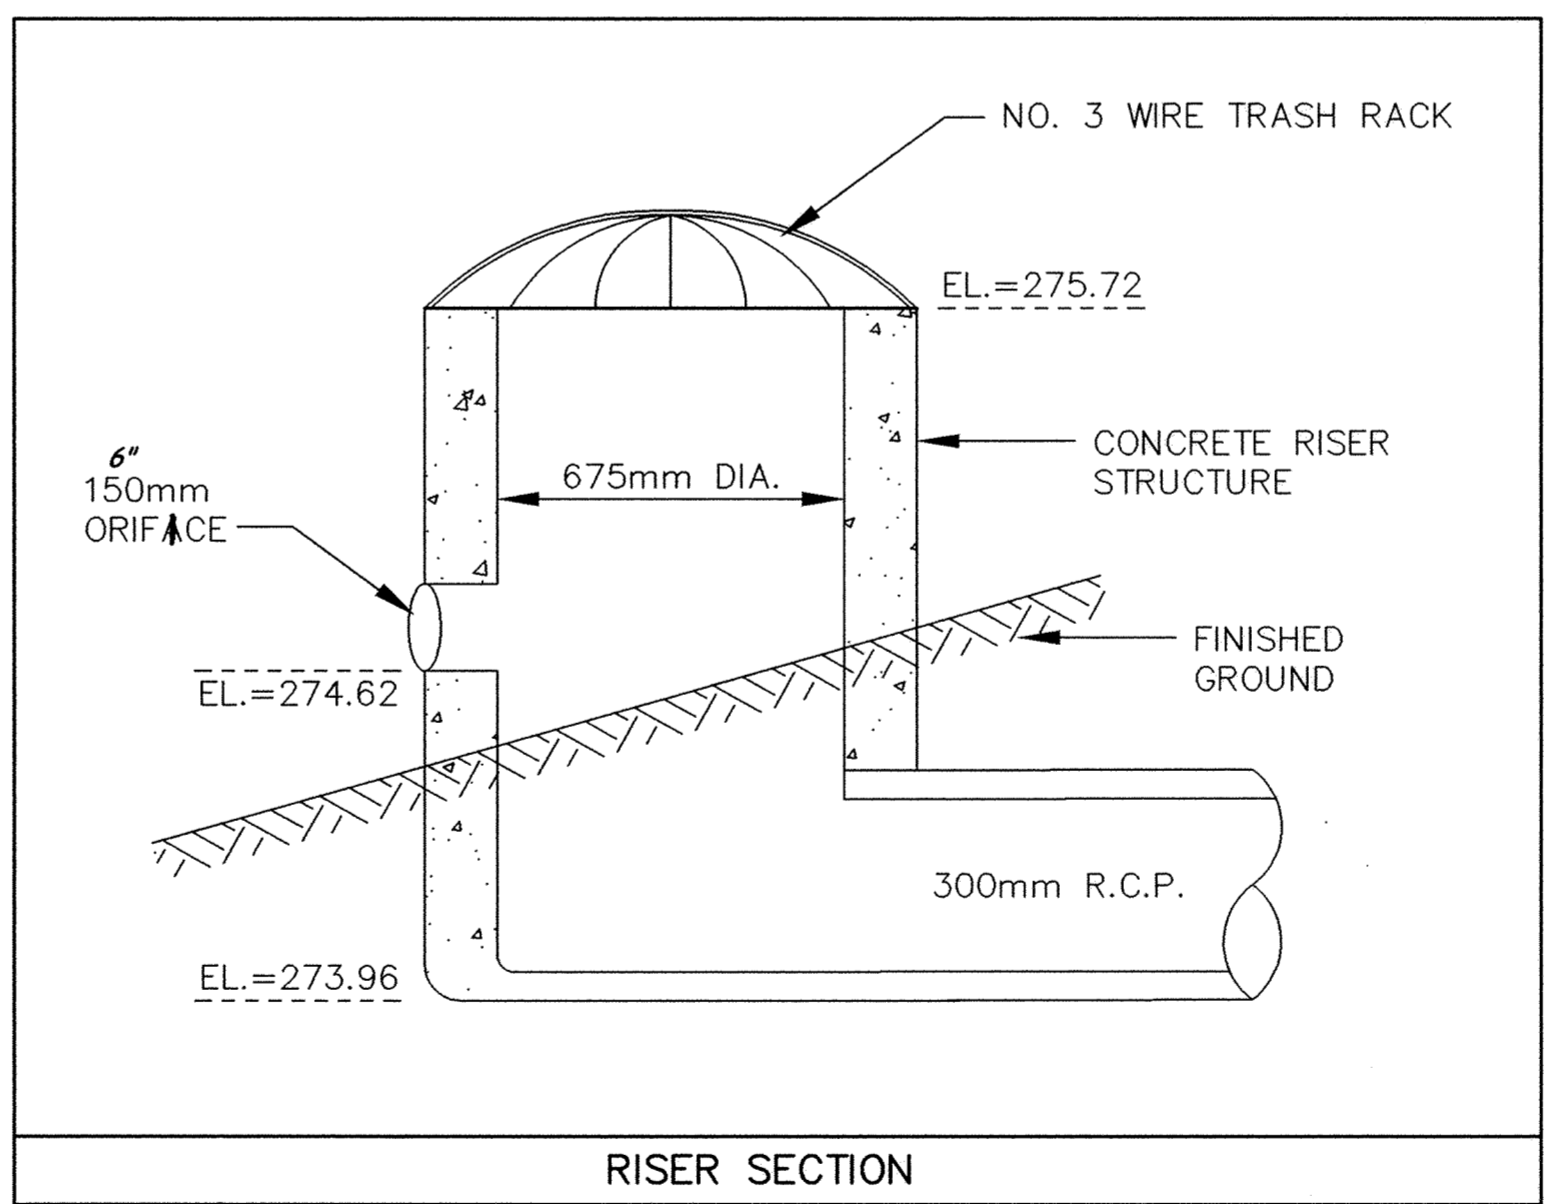

RISER SECTION

CONSTRUCTION NOTES

1. TREES SHALL NOT BE CLEARED AND GRUBBED UNLESS MARKED FOR REMOVAL BY THE ENGINEER.
2. THE CONTRACTOR SHALL RESTORE DISTURBED AREAS WITH 100mm TOPSOIL AND SOD OR SEED AS DIRECTED BY THE ENGINEER.
3. MAILBOXES SHALL BE RELOCATED AS DIRECTED BY THE ENGINEER. TEMPORARY AND PERMANENT RELOCATION OF MAILBOXES SHALL BE INCIDENTAL.
4. THE ENTIRE WIDTH OF SCHOOL ST. (WEST OF PROCTOR AVE.) SHALL BE REMOVED AND RESTORED TO 8.6m WIDE URBAN ROAD AS PER TYPICAL SECTION. (SEE PROPOSED SECTION.)
5. ACCESS TO ALL EXISTING PROPERTIES SHALL BE MAINTAINED. PROPERTY OWNERS SHALL BE NOTIFIED PRIOR TO RESTRICTION OF ACCESS TO DRIVEWAYS FOR ANY PERIOD OF TIME.

RECORD PLAN  
JULY 1999

DESIGNED BY: \_\_\_\_\_ JOB DATE: MAY 1998  
 DRAWN BY: \_\_\_\_\_ JOB NUMBER 803570J  
 APPROVED: \_\_\_\_\_ CAD DATE: MAY 1998  
 CAD FILE: 803570P7

I HEREBY CERTIFY THAT THIS PLAN, SPECIFICATION, OR REPORT WAS PREPARED BY ME OR UNDER MY DIRECT SUPERVISION AND THAT I AM A DULY REGISTERED PROFESSIONAL ENGINEER UNDER THE LAWS OF THE STATE OF MINNESOTA.  
 DATE 6-24-98 REG. NO. 18518

NO.	DATE	BY	REVISION DESCRIPTION

1326 ENERGY PARK DRIVE  
 ST. PAUL, MINNESOTA 55108  
 (612) 644-4389  

 Howard R. Green Company  
 CONSULTING ENGINEERS

CITY OF ELK RIVER  
 SCHOOL STREET  
 IMPROVEMENTS

REMOVAL PLAN, TYPICAL SECTION, NOTES  
 SCHOOL STREET  
 0+000 TO 0+132.767

SHEET NO.  
 17A  
 OF  
 21

1385 1368A

DRAWING NUMBER  
 17A  
 GUARD 98  
 1385 1368A  
 SARGO PRODUCTS • NEW HORIZON, MINNESOTA  
 REPRODUCED BY PART NUMBER 6932  
 DRAWING NUMBER  
 17A  
 GUARD 98  
 SARGO PRODUCTS • NEW HORIZON, MINNESOTA  
 REPRODUCED BY PART NUMBER 6932  
 DRAWING NUMBER  
 17A  
 GUARD 98  
 SARGO PRODUCTS • NEW HORIZON, MINNESOTA  
 REPRODUCED BY PART NUMBER 6932