

DESIGNED BY: AB JOB DATE: MAY 1998
 DRAWN BY: EY JOB NUMBER: 803570J
 APPROVED: CAD DATE:
 CAD FILE: 803570J/X05.DWG

I HEREBY CERTIFY THAT THIS PLAN, SPECIFICATION, OR REPORT WAS PREPARED BY ME OR UNDER MY DIRECT SUPERVISION AND THAT I AM A DULY REGISTERED PROFESSIONAL ENGINEER UNDER THE LAWS OF THE STATE OF MINNESOTA.
 DATE: 5-26-98 REG. NO. 18568

NO.	DATE	BY	REVISION DESCRIPTION




1326 ENERGY PARK DRIVE
 ST. PAUL, MINNESOTA 55108
 (612) 644-4389
 Howard R. Green Company
 CONSULTING ENGINEERS

CITY OF ELK RIVER
 SCHOOL STREET
 IMPROVEMENTS

RECORD PLAN
 JULY 1999
 CROSS SECTIONS
 SCHOOL STREET
 0+000 TO 0+139.99

SHEET NO.
 17C
 OF
 21

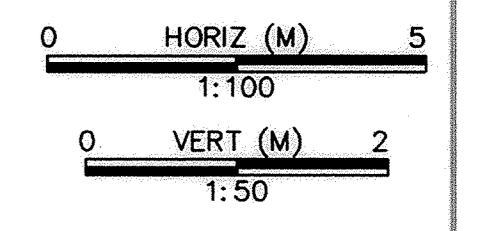

1383 1383C

JACOBS PRODUCTS • NEW HARBOR, MINNESOTA
 SAVED PRODUCTS • NEW HARBOR, MINNESOTA
 SAVED PRODUCTS • NEW HARBOR, MINNESOTA
 SAVED PRODUCTS • NEW HARBOR, MINNESOTA
 GUARD: 98
 17C