


- LEGEND**
- | — WATERMAIN
 - > — SANITARY SEWER
 - >> — STORM SEWER
 - ⊕ WATER SERVICE
 - ⊕ SANITARY SEWER SERVICE

- REFERENCE NOTES:**
- ① FIELD VERIFY INVERT PRIOR TO CONSTRUCTION.
 - ② CONSTRUCT HYDRANT LEAD PER CITY STANDARD PLATE NO. 3402.
 - ③ ADJUST FRAME AND RING CASTING TO PROPOSED RIM ELEVATION.

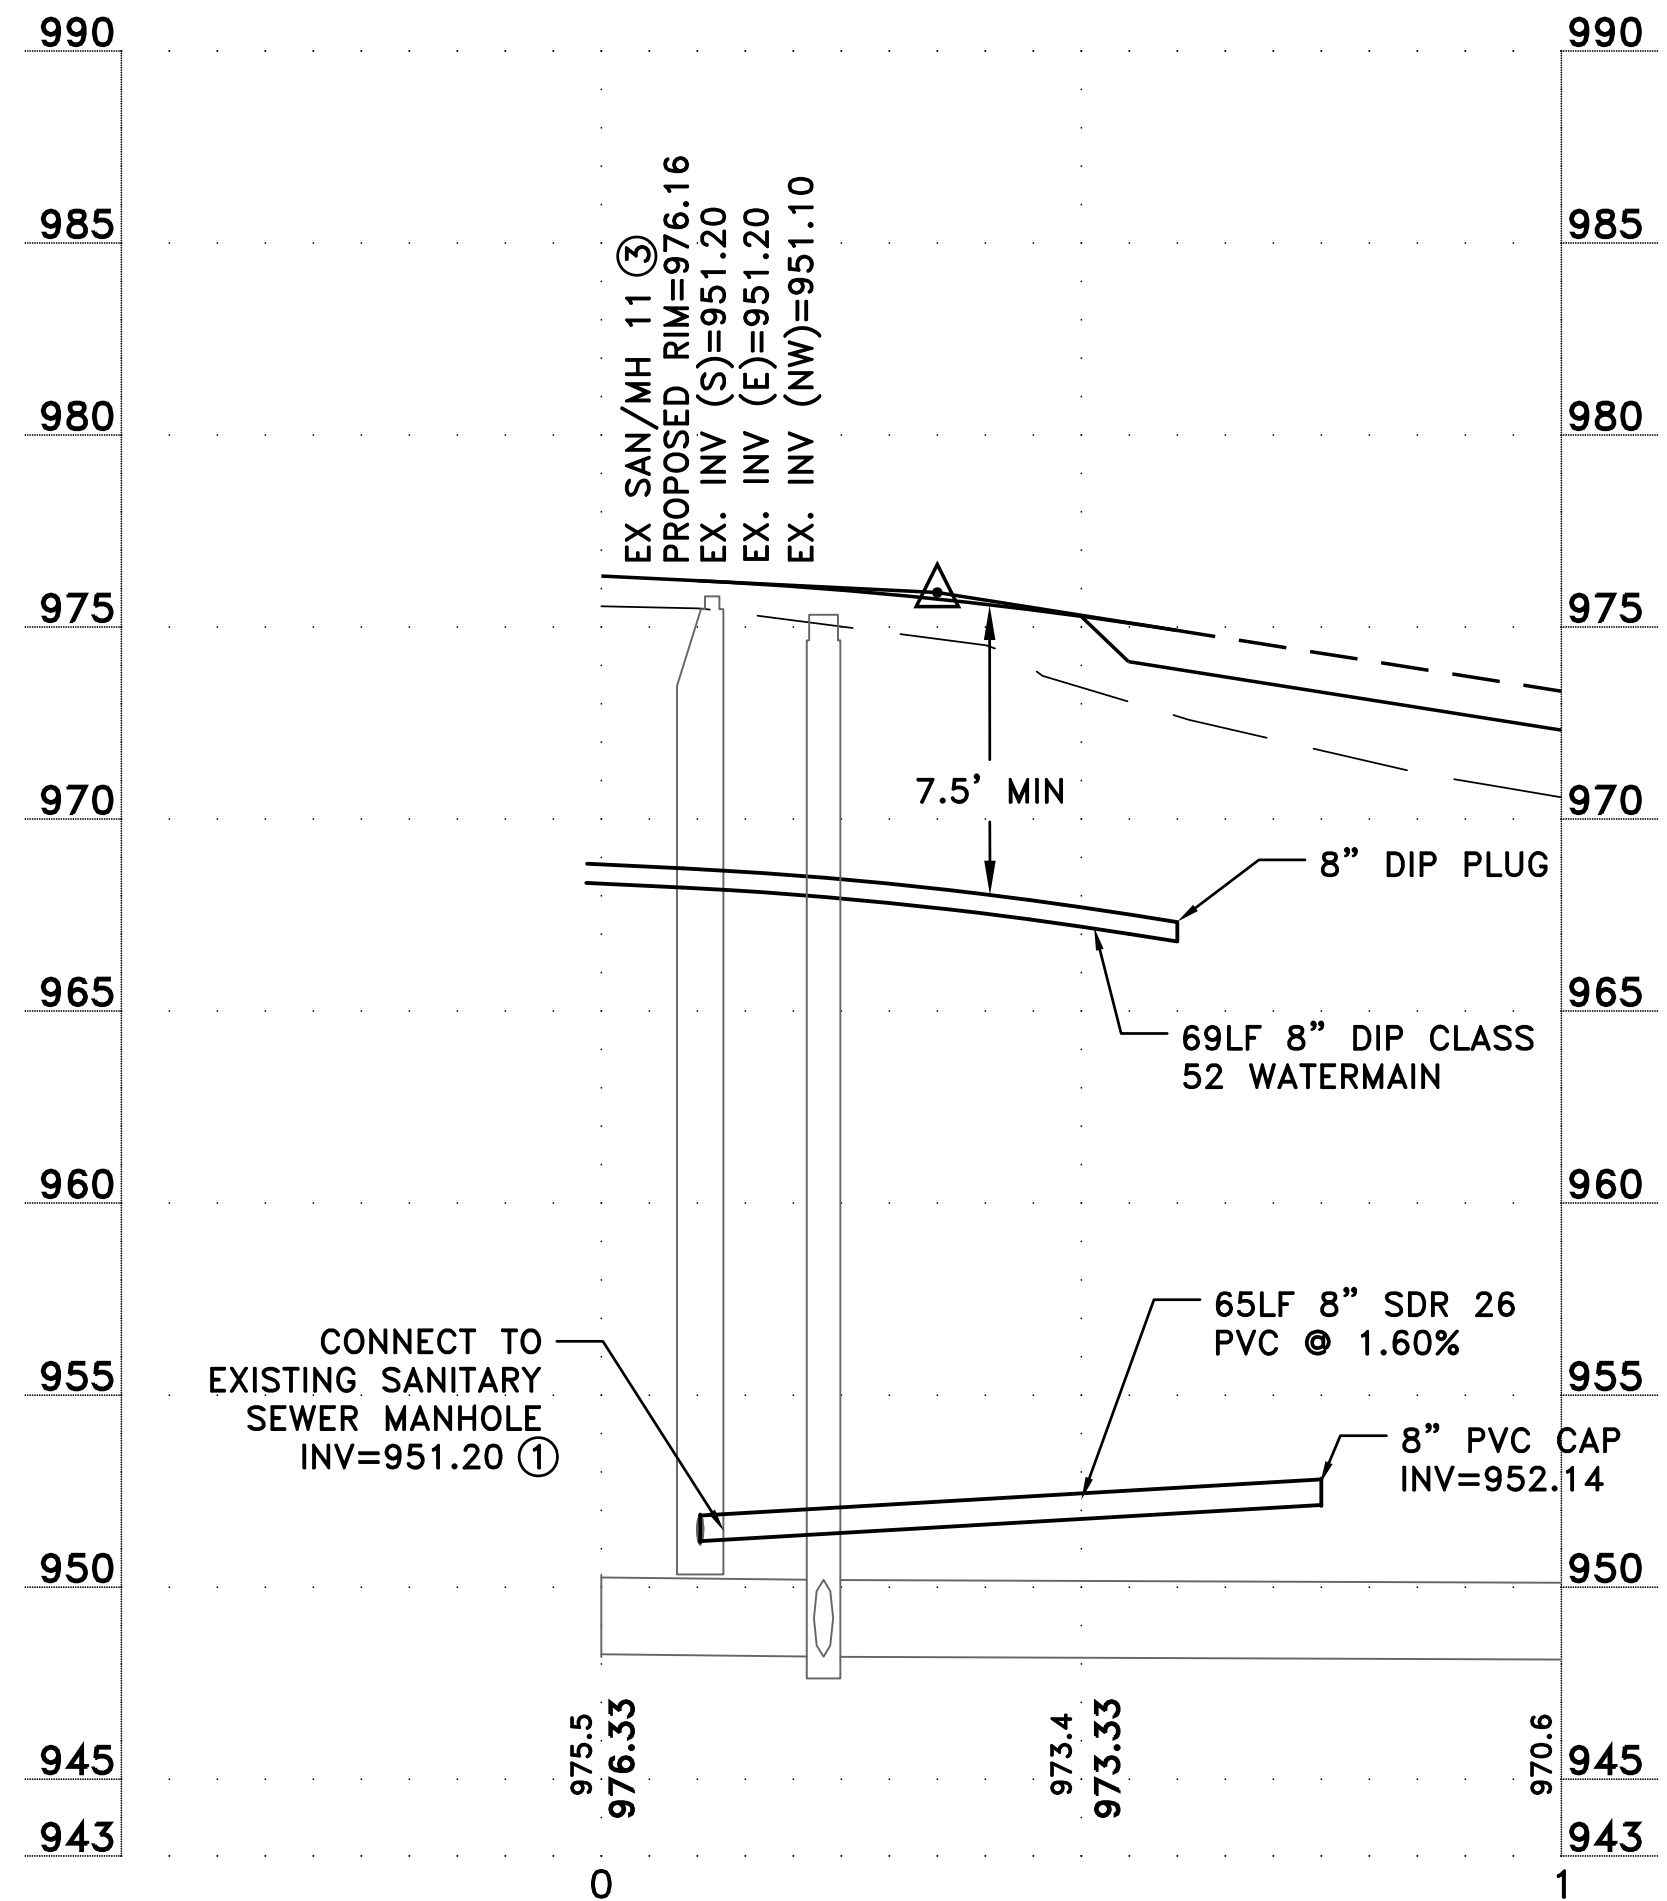

Mar 23, 2018 - 8:11am K:\PRIVATE\p-2135.15\ENGINEERING\p-2135.15_PP_CARLSON.dwg

DATE	REVISION
11/28/17	PLAN REVISIONS PER CITY REVIEW
2/9/18	PLAN REVISIONS
3/19/18	PLAN REVISIONS

I hereby certify that this plan, specification, or report was prepared by me or under my direct supervision and that I am a duly Licensed Professional Engineer under the laws of the State of Minnesota.

Paul J. Jochum
PAUL J. JOCHUM, PE
 Date 7/31/17 Lic. No. 23461

DESIGNED BY: CJJ
 DRAWN BY: MSS
 CHECKED BY: TAE

RUM RIVER
 LAND SURVEYORS & ENGINEERS
 PO Box 1044 Telephone: (763) 389-4476
 Princeton, MN 55371 Fax: (763) 631-0376

HILLSIDE ESTATES ELEVENTH ADDITION

SANITARY SEWER AND WATERMAIN
 CARSON COURT NW
 CITY OF ELK RIVER, MINNESOTA

SHEET 15 OF 22 SHEETS