


SAICO PRODUCTS • NEW HOPE, MINNESOTA
REPRODUCED BY PART NUMBER 0202
SAICO PRODUCTS • NEW HOPE, MINNESOTA
REPRODUCED BY PART NUMBER 0202
SAICO PRODUCTS • NEW HOPE, MINNESOTA
REPRODUCED BY PART NUMBER 0202
SAICO PRODUCTS • NEW HOPE, MINNESOTA
REPRODUCED BY PART NUMBER 0202

HERITAGE LANDING

GRADING, SANITARY SEWER WATERMAIN, STORM SEWER, AND STREET CONSTRUCTION

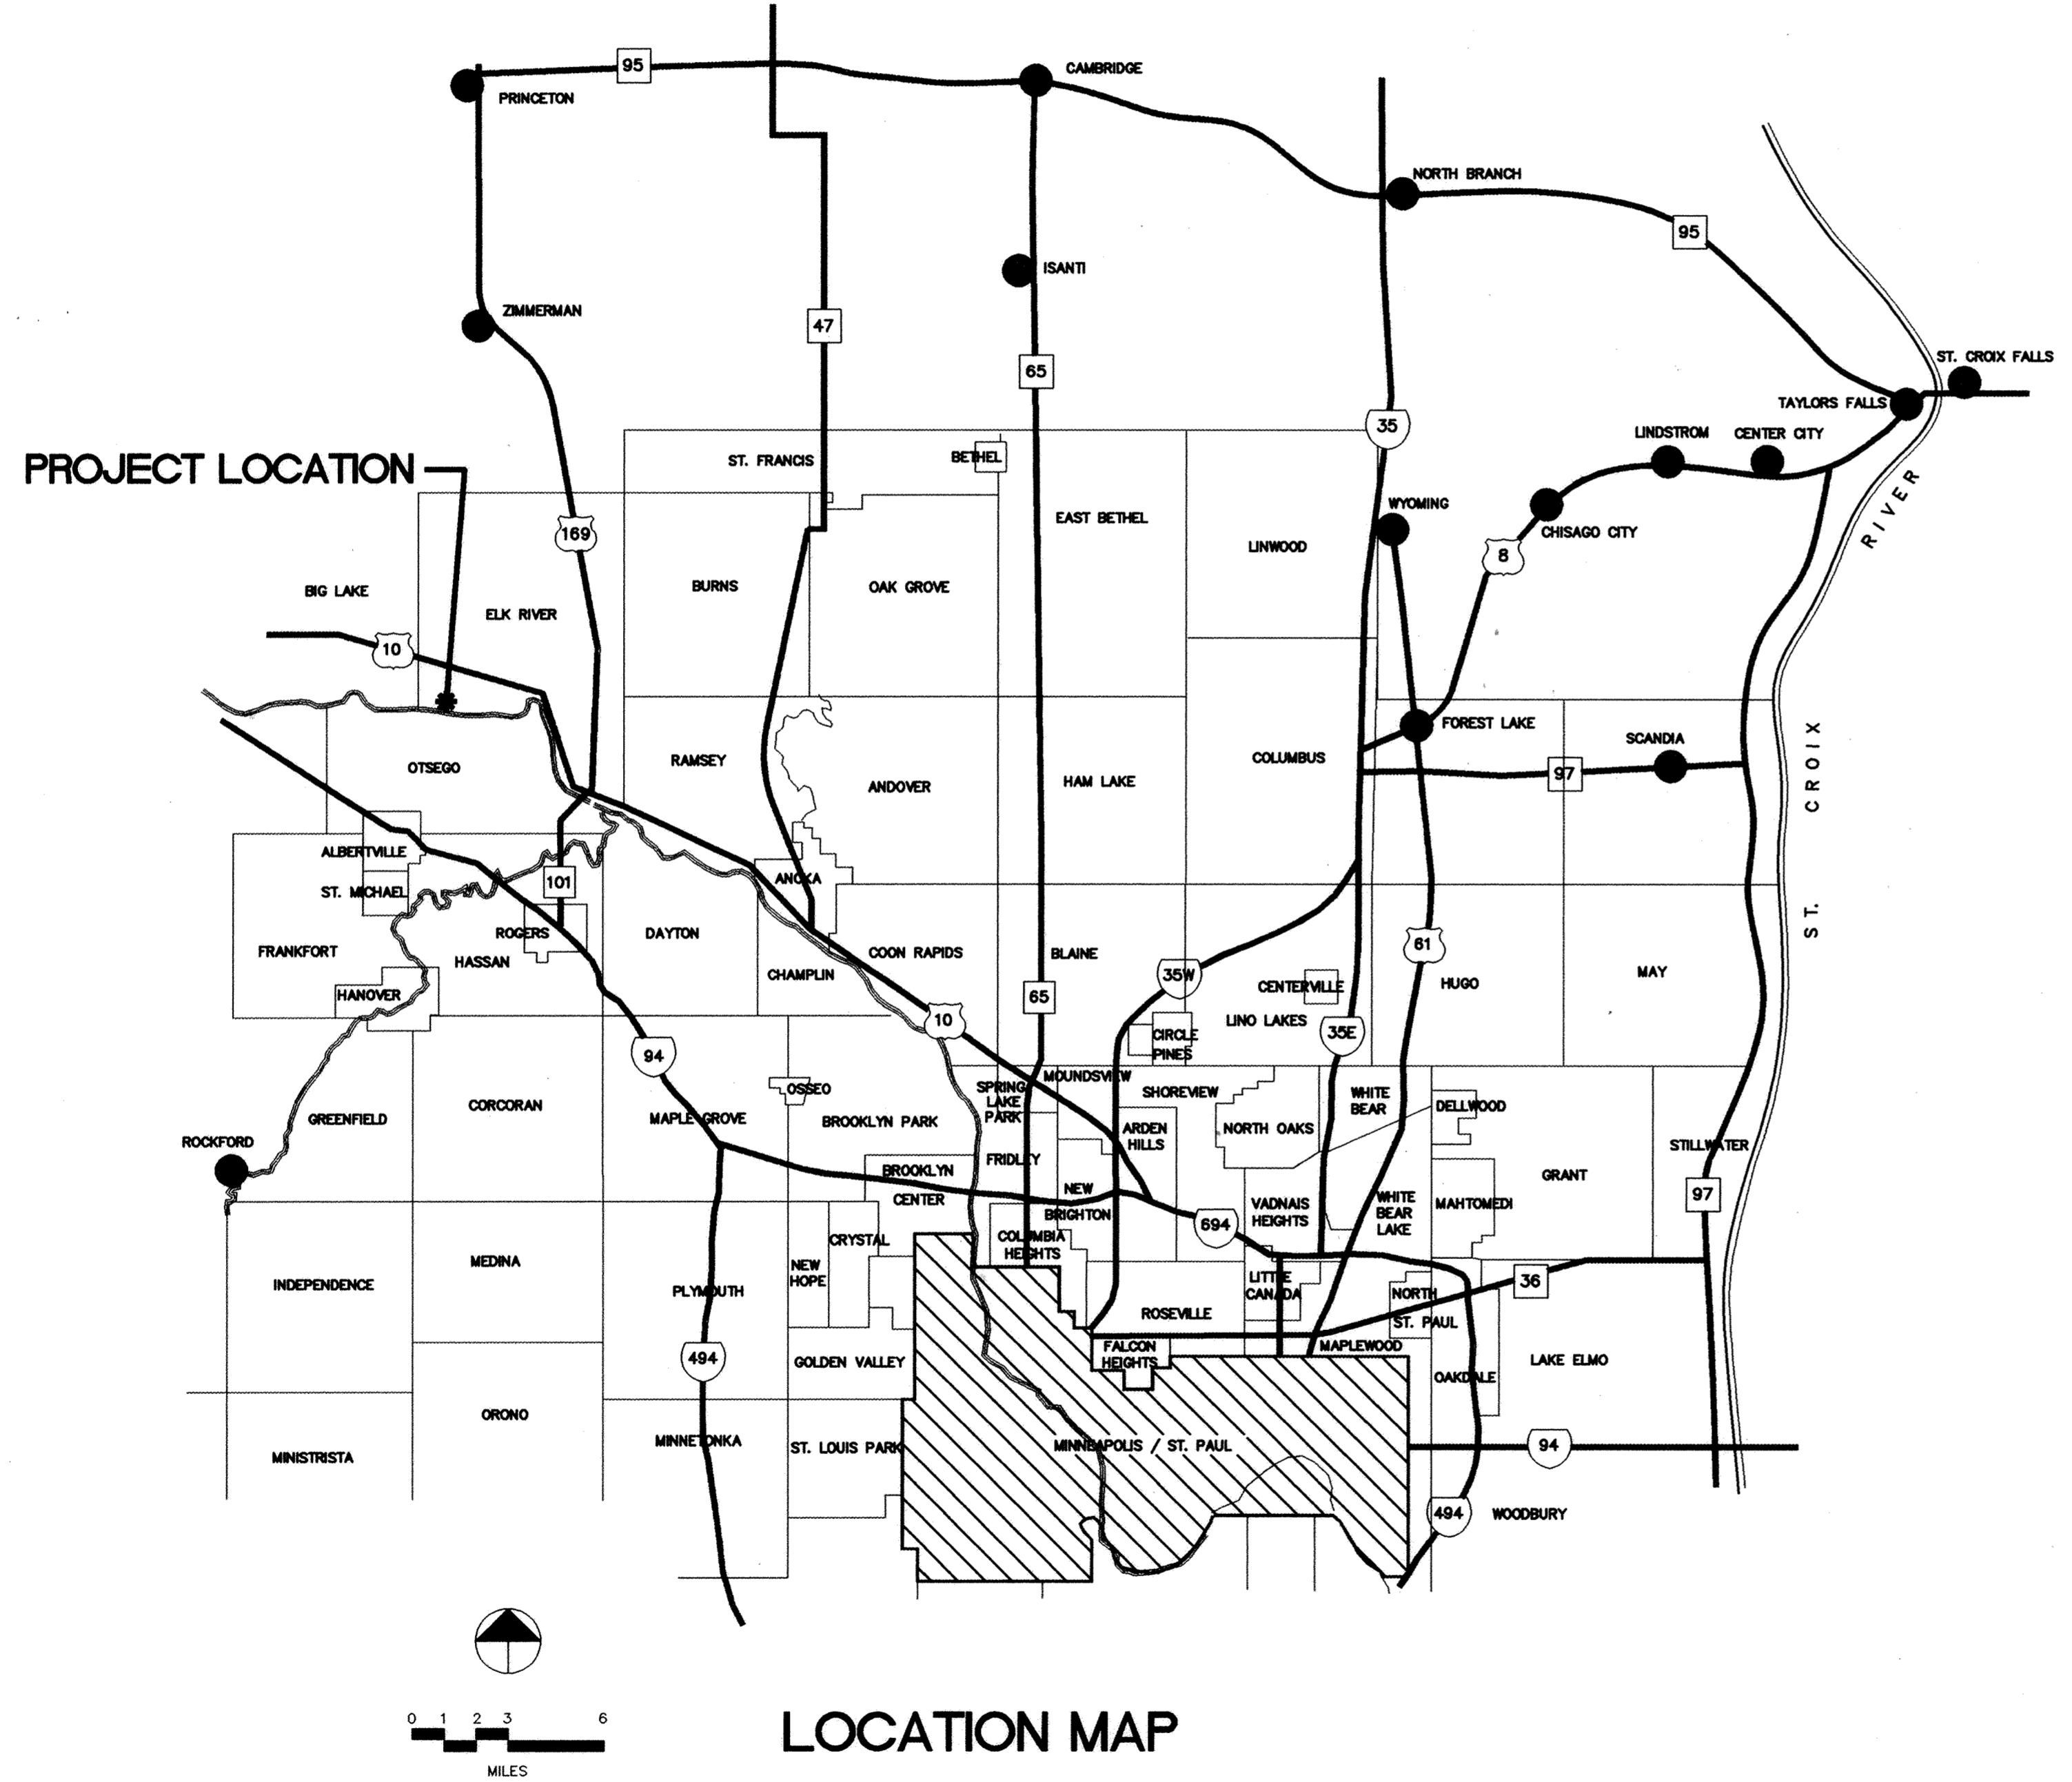

I HEREBY CERTIFY THAT THIS PLAN, SPECIFICATION,
OR REPORT WAS PREPARED BY ME OR UNDER MY DIRECT
SUPERVISION AND THAT I AM A DULY REGISTERED
PROFESSIONAL ENGINEER UNDER THE LAWS OF THE
STATE OF MINNESOTA.

Terry J. Maier
DATE 4/28/93 REG. NO. 15316

WMA CONSULTING ENGINEERS
Maier Stewart & Associates Inc.
1959 SLOAN PLACE [612] 774-6021 ST. PAUL, MINNESOTA 55117
9800 SHELARD PARKWAY [612] 546-0432 MINNEAPOLIS, MINNESOTA 55441

PREPARED FOR:



RECORD PLAN NOV, 1993