
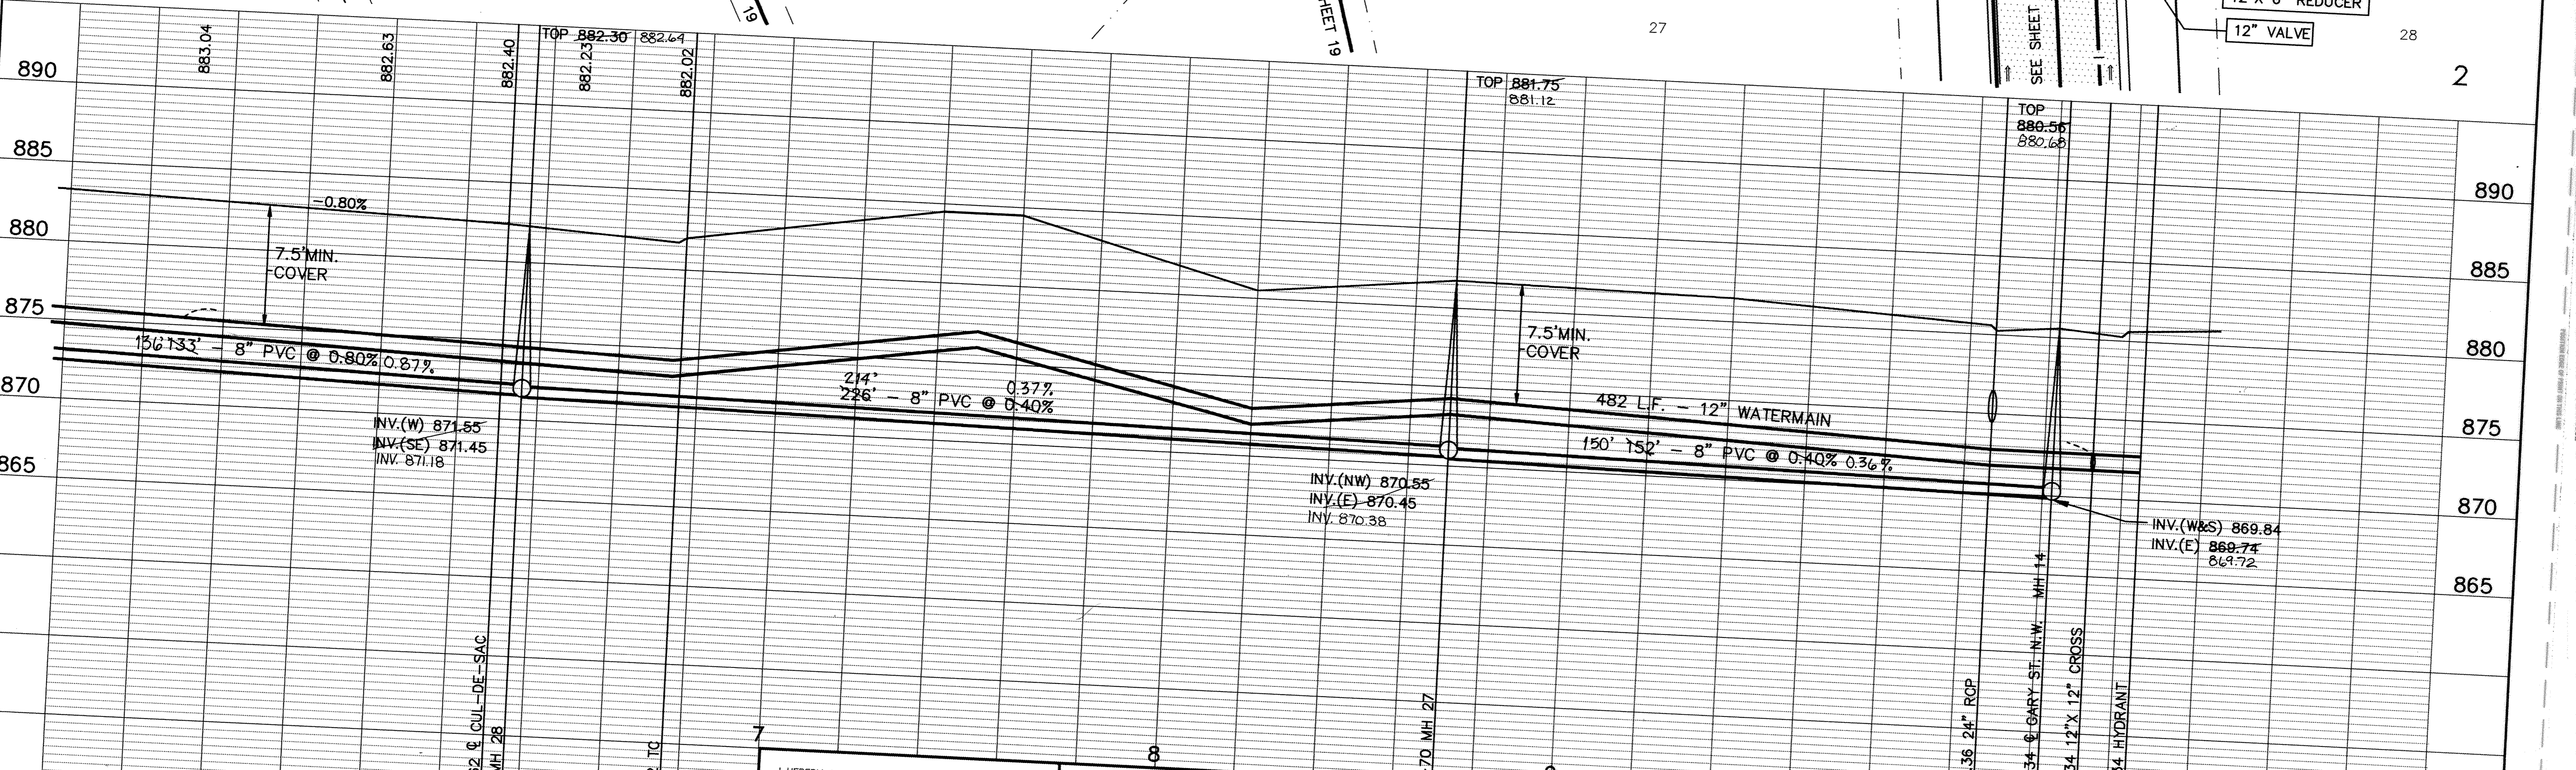
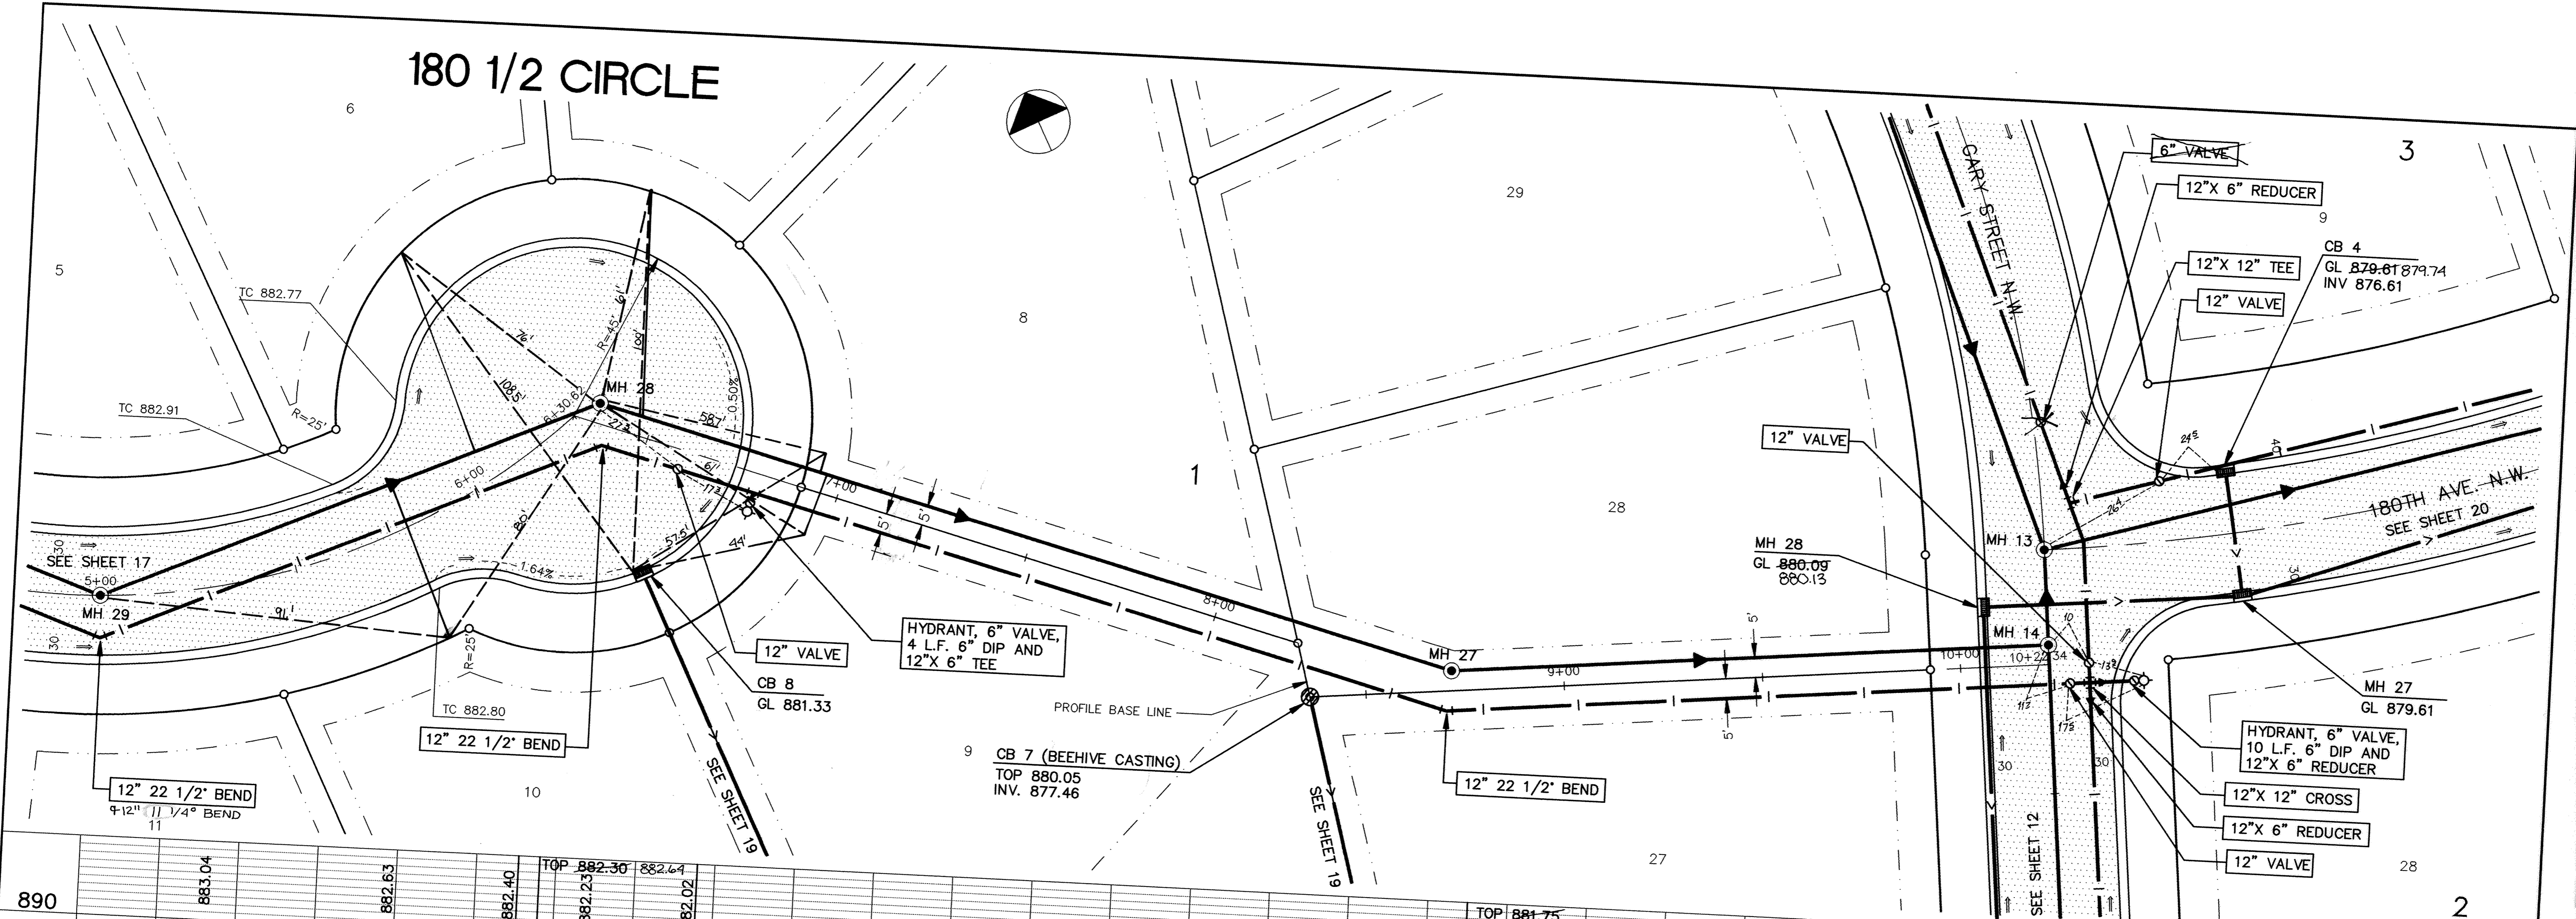


180 1/2 CIRCLE

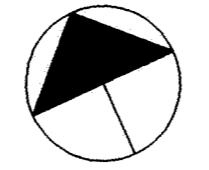

I HEREBY CERTIFY THAT THIS PLAN, SPECIFICATION, OR REPORT WAS PREPARED BY ME OR UNDER MY DIRECT SUPERVISION AND THAT I AM A DULY REGISTERED PROFESSIONAL ENGINEER UNDER THE LAWS OF THE STATE OF MINNESOTA.
 DATE 4/24/93 REG. NO. 15,214

MSA CONSULTING ENGINEERS
 Maier Stewart & Associates Inc.
 1959 SLOAN PLACE (612) 774-6021 ST. PAUL, MINNESOTA

NO.	DATE	DESCRIPTION

DESIGNED: GG
 CHECKED: TJM
 DRAWN: CLS
 GRAPHIC SCALE
 CITY OF ELK RIVER
 SANITARY SEWER, WATERMAIN, STORM SEWER & STREET

RECORD PLAN NOV. 1993

DRAWING NUMBER

DRAWING NUMBER

DRAWING NUMBER

DRAWING NUMBER

ER159-5