
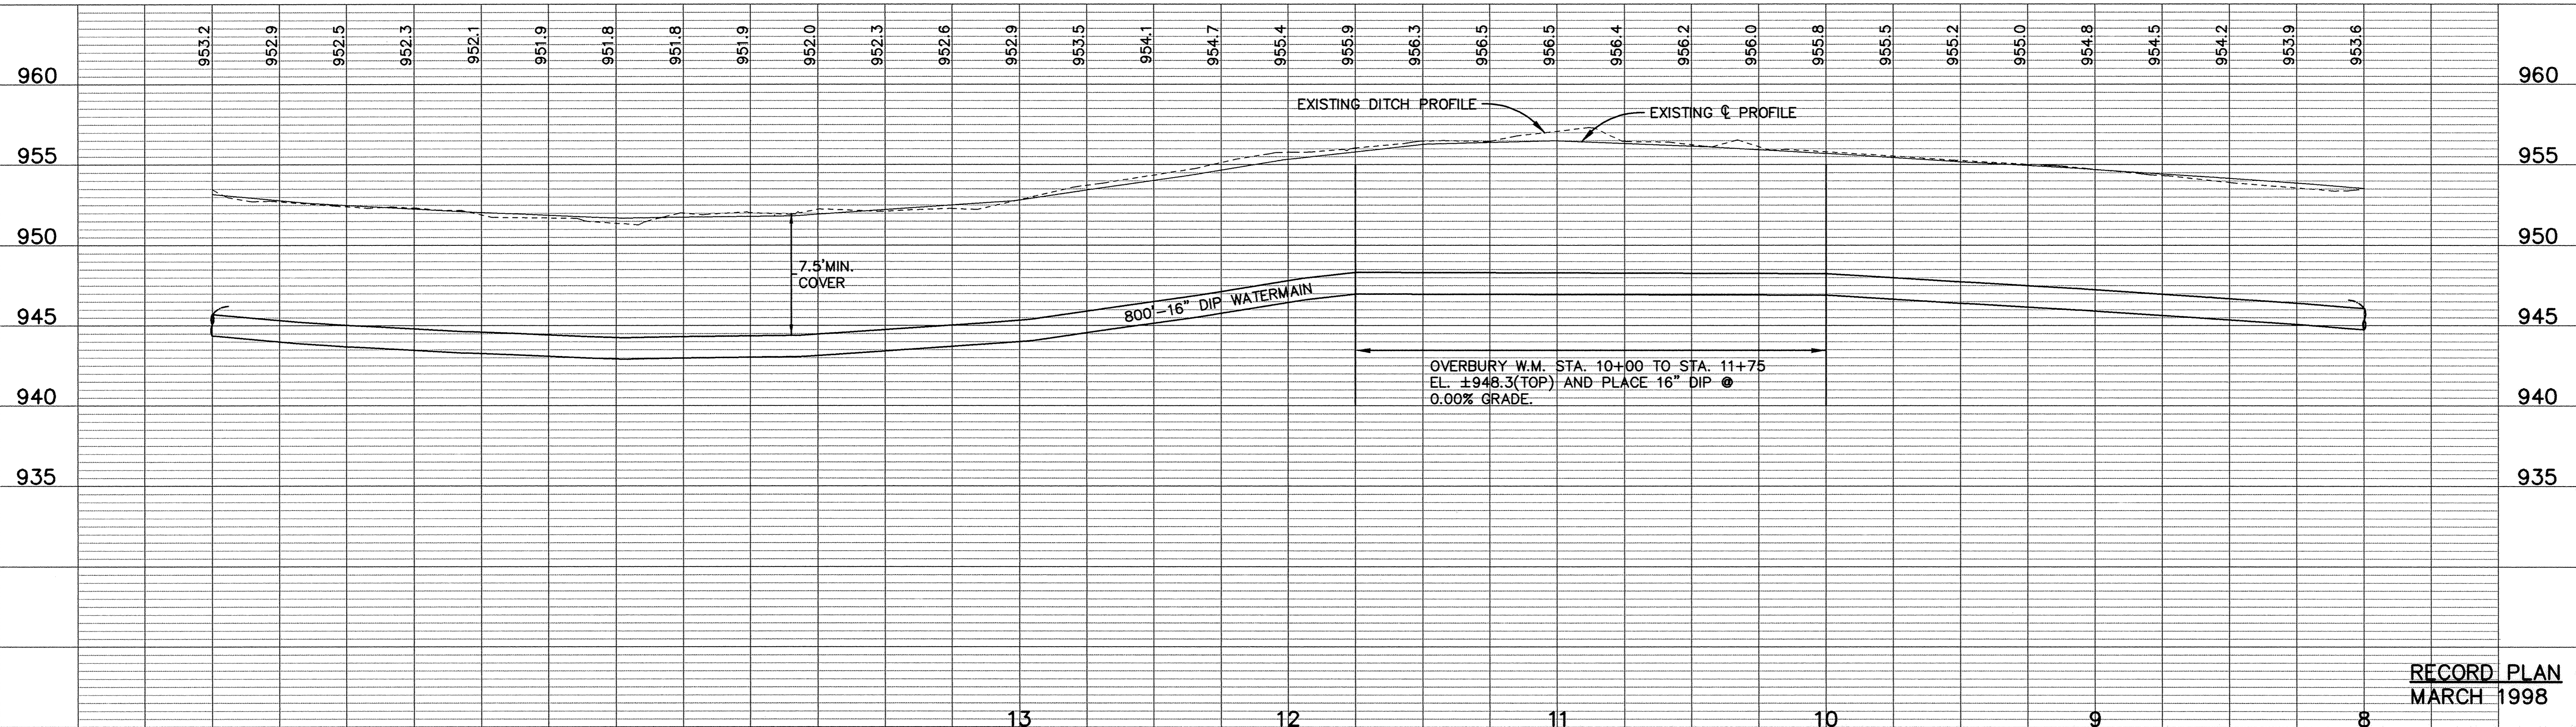


HIGHLAND ROAD

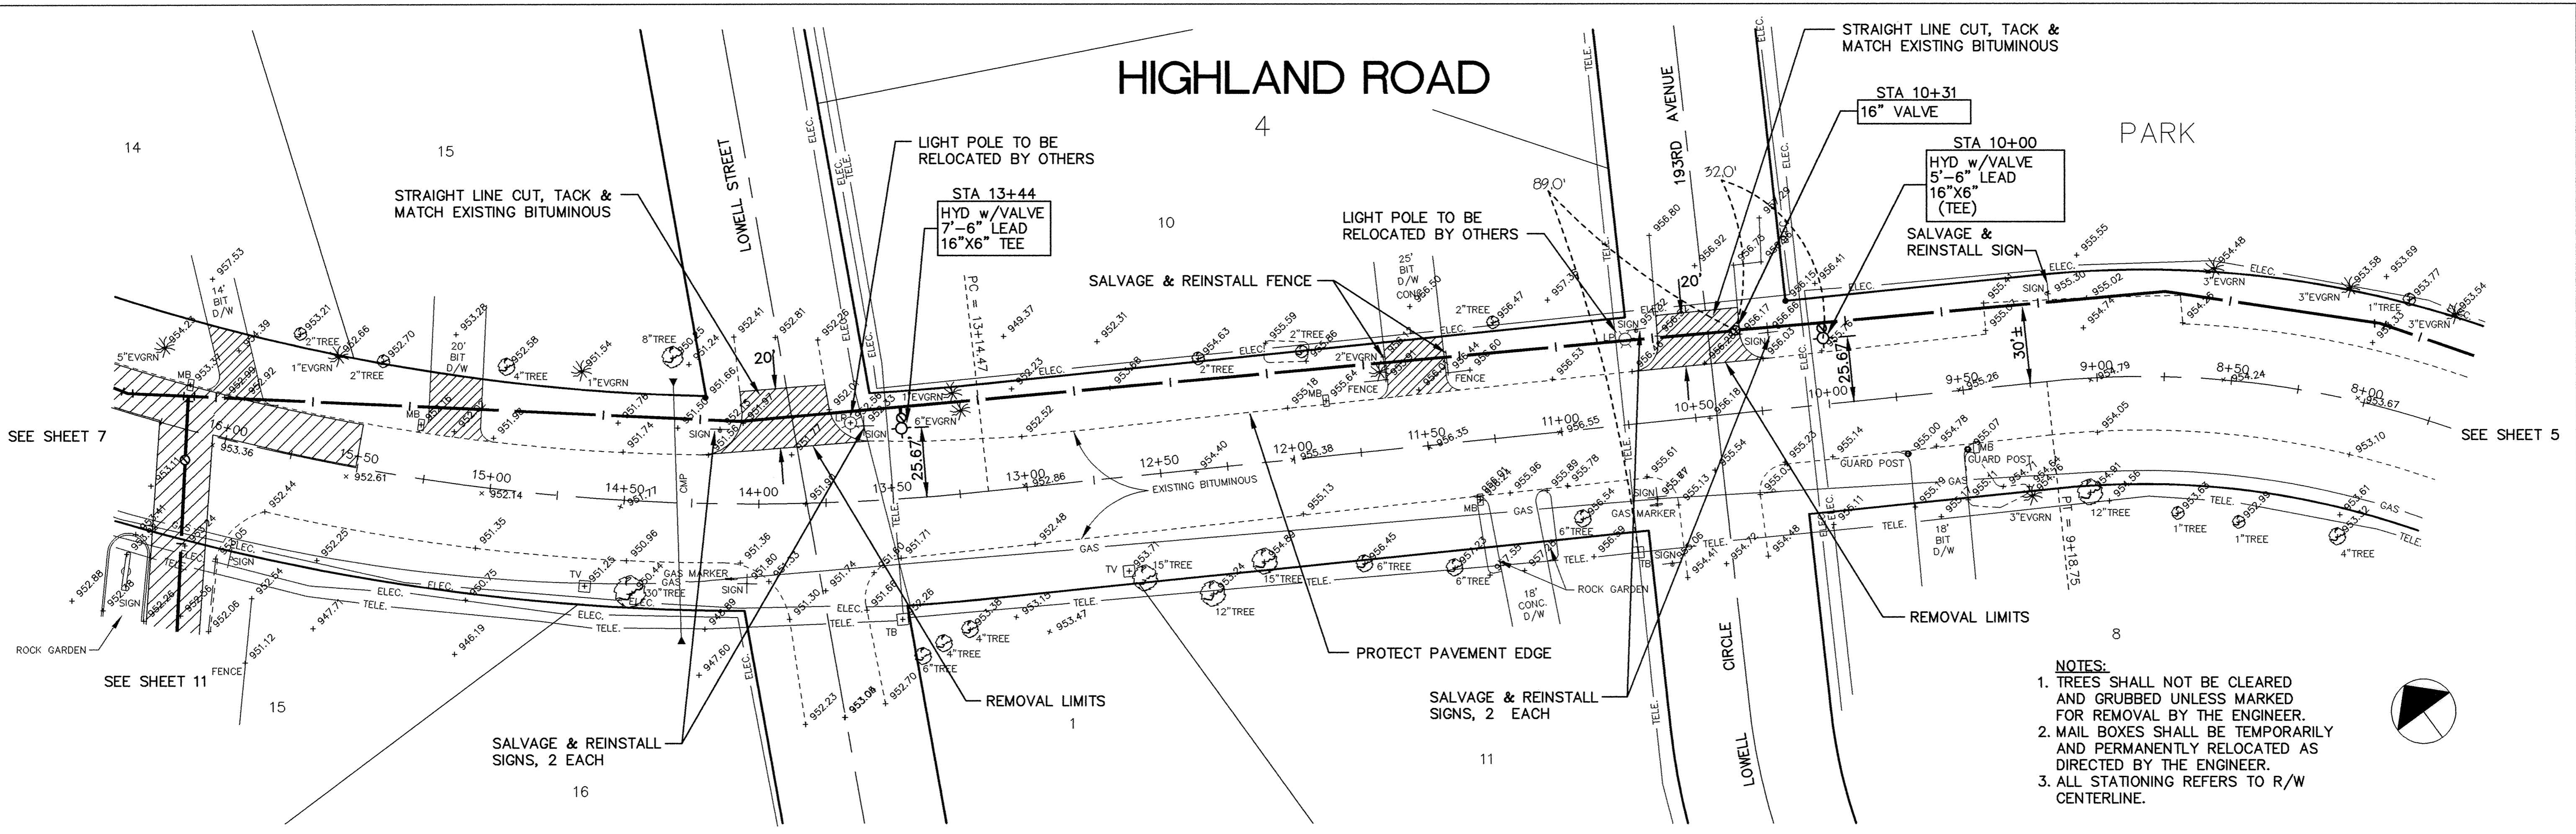

RECORD PLAN
MARCH 1998

I HEREBY CERTIFY THAT THIS PLAN, SPECIFICATION, OR REPORT WAS PREPARED BY ME OR UNDER MY DIRECT SUPERVISION AND THAT I AM A DULY REGISTERED PROFESSIONAL ENGINEER UNDER THE LAWS OF THE STATE OF MINNESOTA.

DATE 4/9/97 REG. NO. 15316



1326 ENERGY PARK DRIVE
ST. PAUL, MINNESOTA 55108
(612) 644-4389

DATE	DESCRIPTION	DESIGNED	CHECKED	DRAWN
		AJB		RKM

GRAPHIC SCALE
0 30
VERT. 5

ELK RIVER MUNICIPAL UTILITIES
HIGHLAND ROAD TRUNK WATERMAIN
HIGHLAND ROAD

8+00 TO 16+00

DATE APR. 1997 SHEET 6 OF 16 SHEETS PROJECT NO. 235-013