
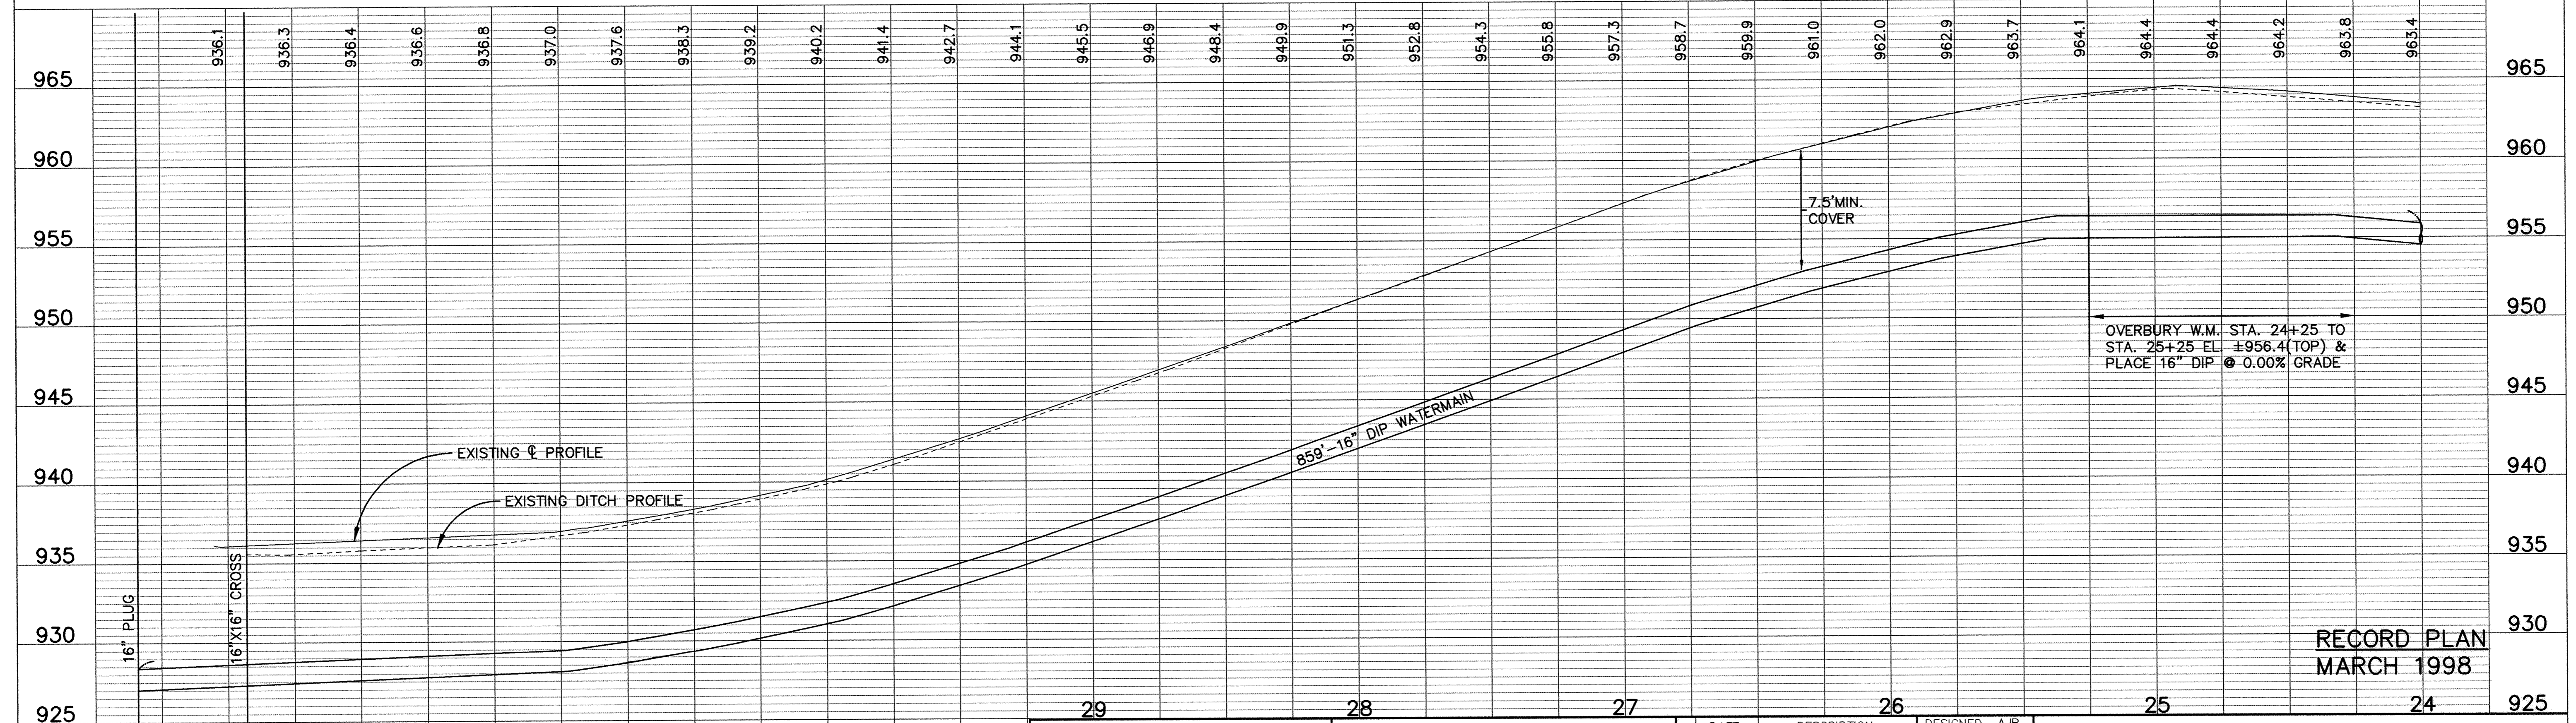


HIGHLAND ROAD

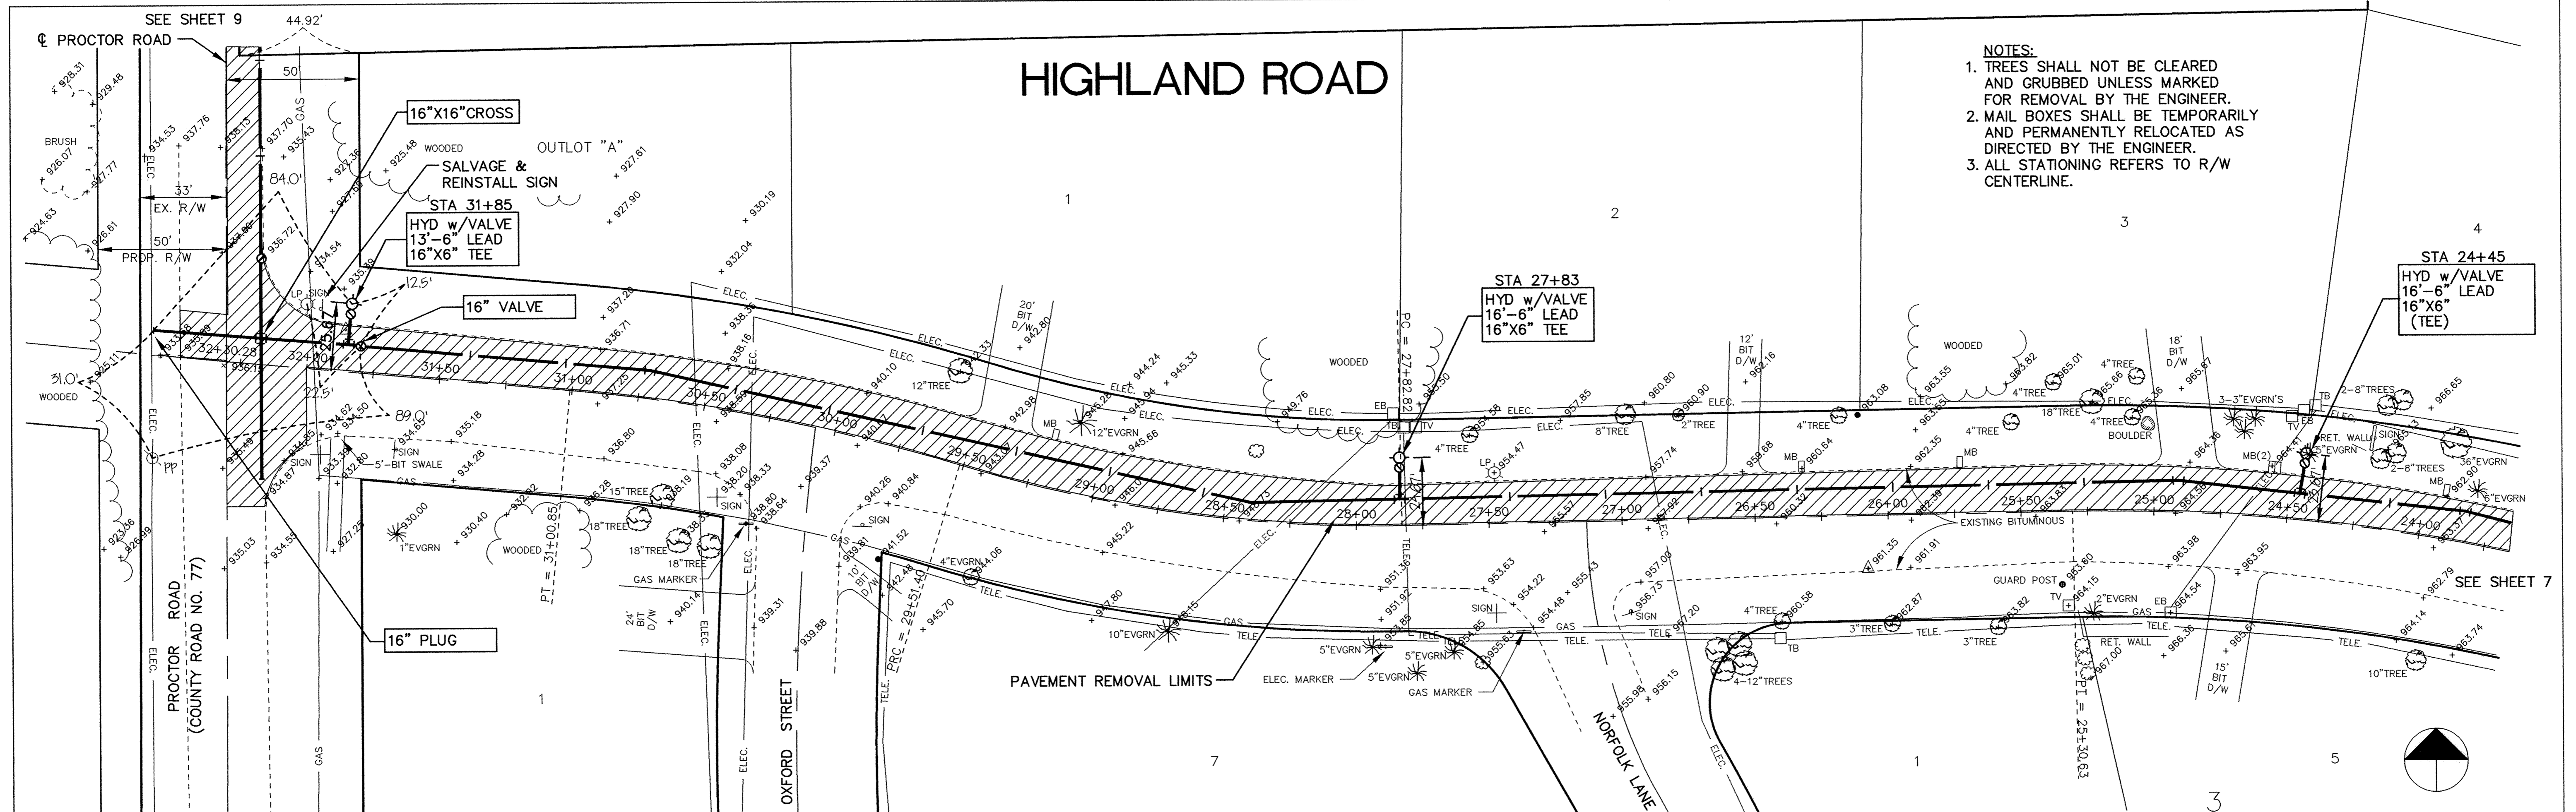


RECORD PLAN
MARCH 1998

I HEREBY CERTIFY THAT THIS PLAN, SPECIFICATION, OR REPORT WAS PREPARED BY ME OR UNDER MY DIRECT SUPERVISION AND THAT I AM A DULY REGISTERED PROFESSIONAL ENGINEER UNDER THE LAWS OF THE STATE OF MINNESOTA.

Conrad Manner

DATE 4/2/97 REG. NO. 15316

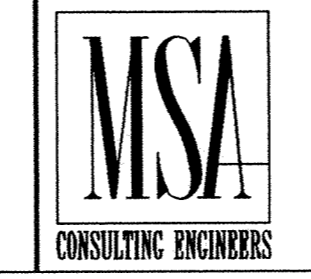

1326 ENERGY PARK DRIVE
ST. PAUL, MINNESOTA 55108
(612) 644-4389

REVISIONS	DATE	DESCRIPTION	DESIGNED	AJL

ELK RIVER MUNICIPAL UTILITIES HIGHLAND ROAD TRUNK WATERMAIN HIGHLAND ROAD		24+00 TO 32+30.28
DATE	APR. 1997	SHEET 8 OF 16 SHEETS
PROJECT NO.	235-013	