

SDCO PRODUCTS • NEW HAVEN, MINNESOTA
 PREPARED BY PART NUMBER 0552












SDCO PRODUCTS • NEW HAVEN, MINNESOTA
 PREPARED BY PART NUMBER 0552

SDCO PRODUCTS • NEW HAVEN, MINNESOTA
 PREPARED BY PART NUMBER 0552

SDCO PRODUCTS • NEW HAVEN, MINNESOTA
 PREPARED BY PART NUMBER 0552

STATION	AREAS Square Feet		VOLUMES Cubic Yards		CUMULATIVE VOLUMES Cubic Yards	
	CUT	FILL	CUT	FILL	CUT	FILL
0+75	187.65	0.00	0.00	0.00	86.87	28.69
1+00	0.00	61.96	86.87	28.69	86.87	28.69
1+50	0.00	228.19	0.00	268.66	86.87	297.34
2+00	0.00	454.55	0.00	632.17	86.87	929.51
2+50	0.00	475.66	0.00	861.31	86.87	1790.82
3+00	0.00	371.13	0.00	784.06	86.87	2574.88
3+35.34	0.00	227.36	0.00	391.64	86.87	2966.52

STATION	AREAS Square Feet		VOLUMES Cubic Yards		CUMULATIVE VOLUMES Cubic Yards	
	CUT	FILL	CUT	FILL	CUT	FILL
3+01.71	0.00	333.89	0.00	462.75	0.00	462.75
3+50	0.00	183.57	0.00	313.25	0.00	776.00
4+00	0.00	154.74	0.00	386.73	0.00	1162.73
4+50	0.00	262.92	0.00	485.82	0.00	1648.55
5+00	0.00	261.76	0.00	499.08	0.00	2147.63
5+50	0.00	277.25	0.04	315.93	0.04	2463.56
6+00	0.04	63.95	0.02	29.61	0.06	2493.17
6+25	0.00	0.00	0.00	0.00	0.06	2493.17

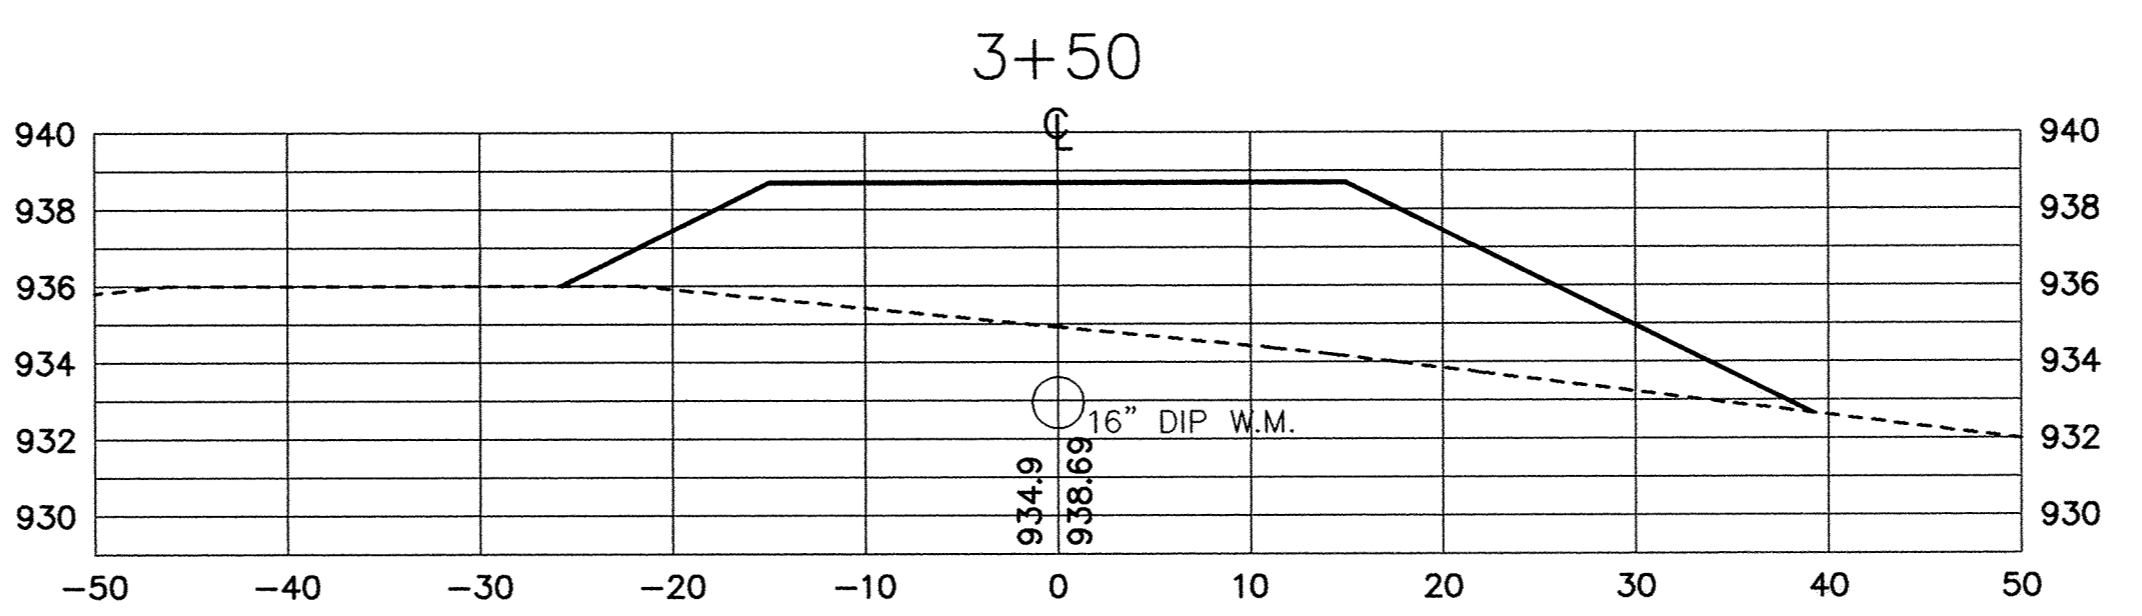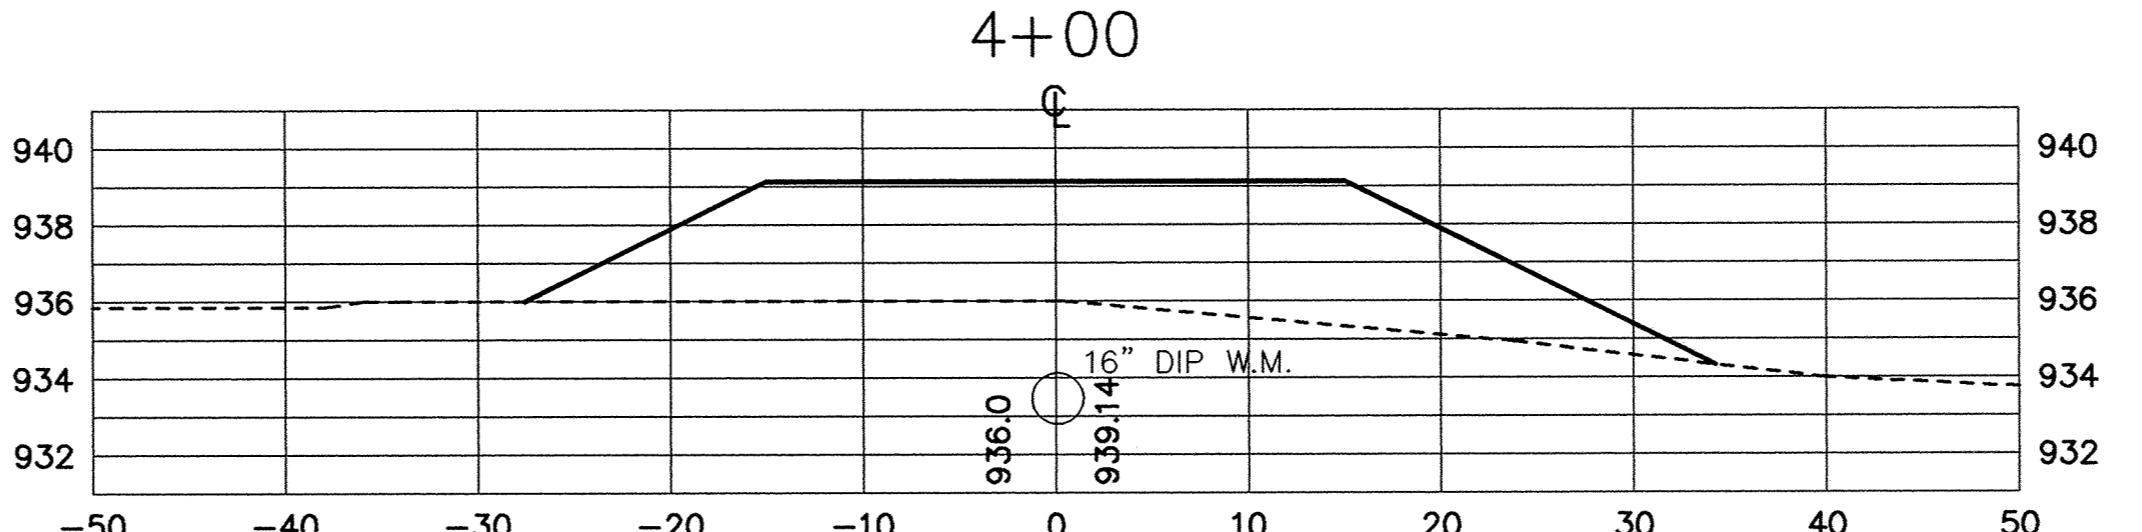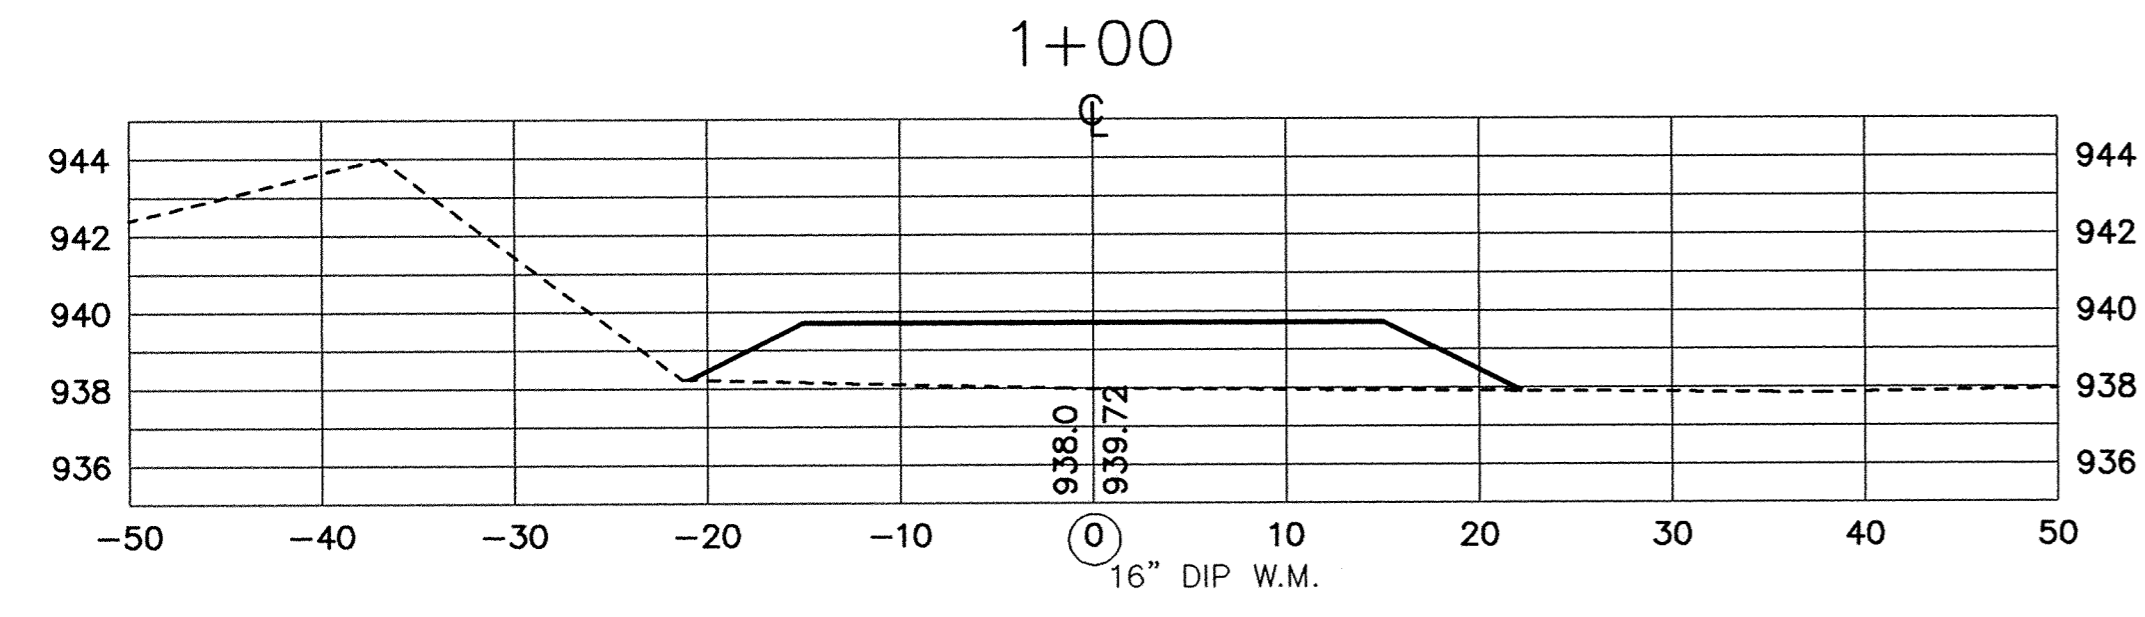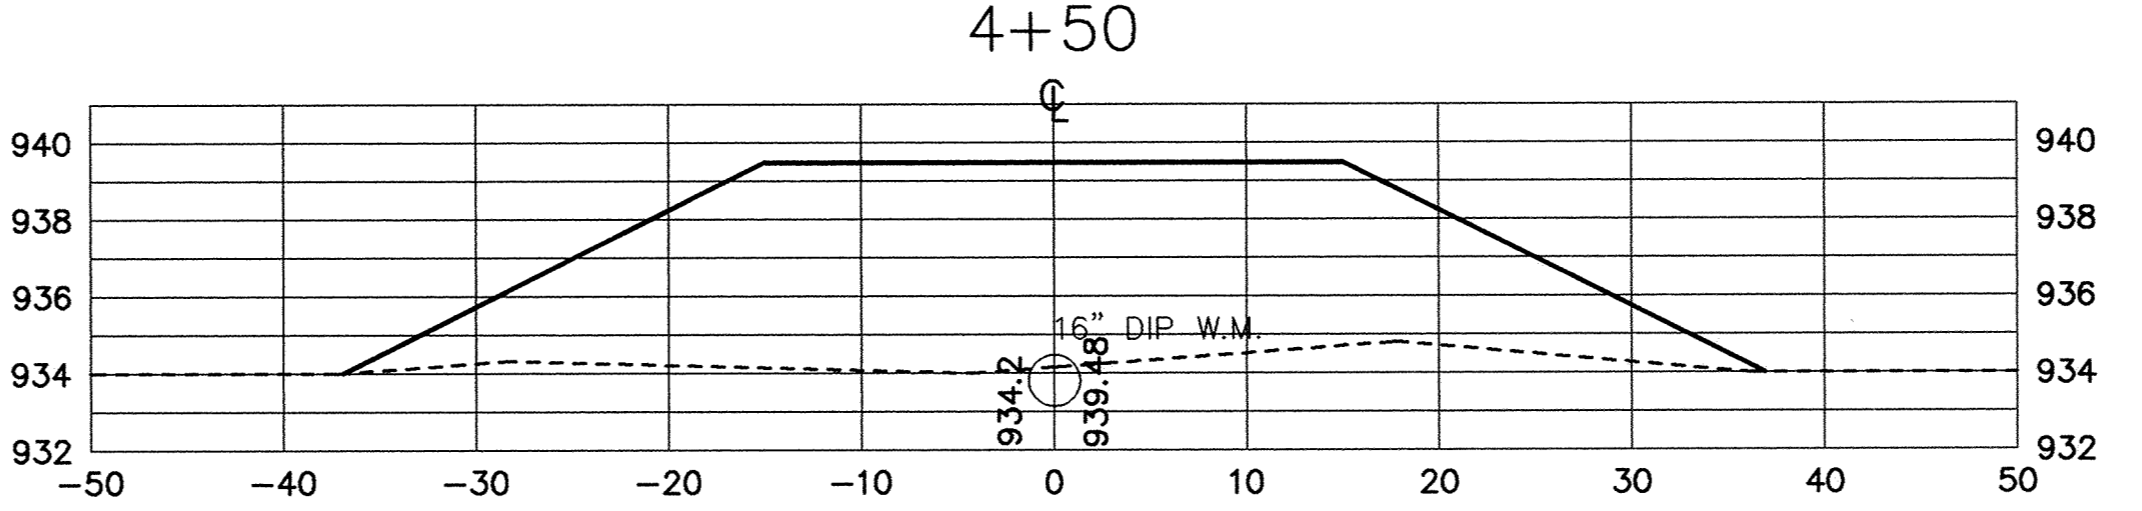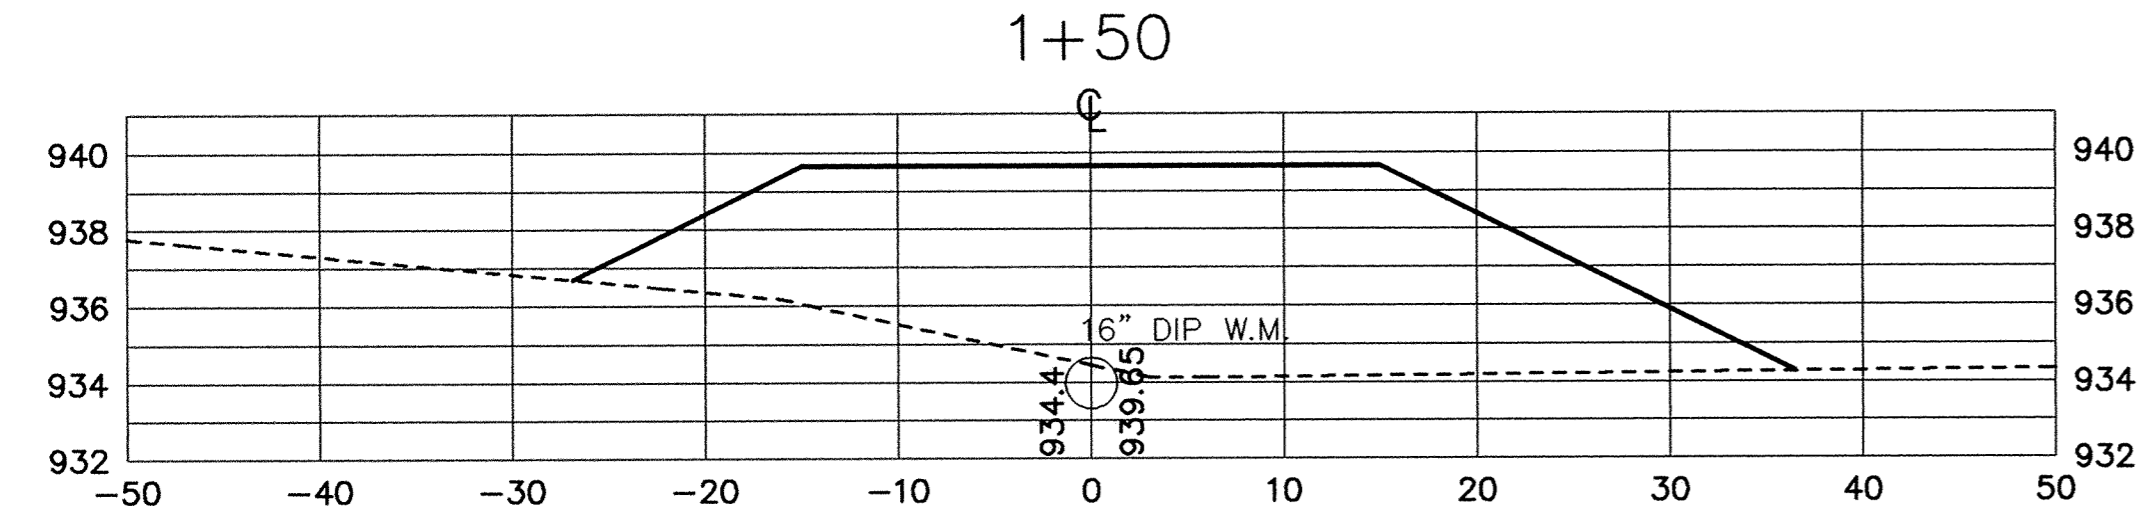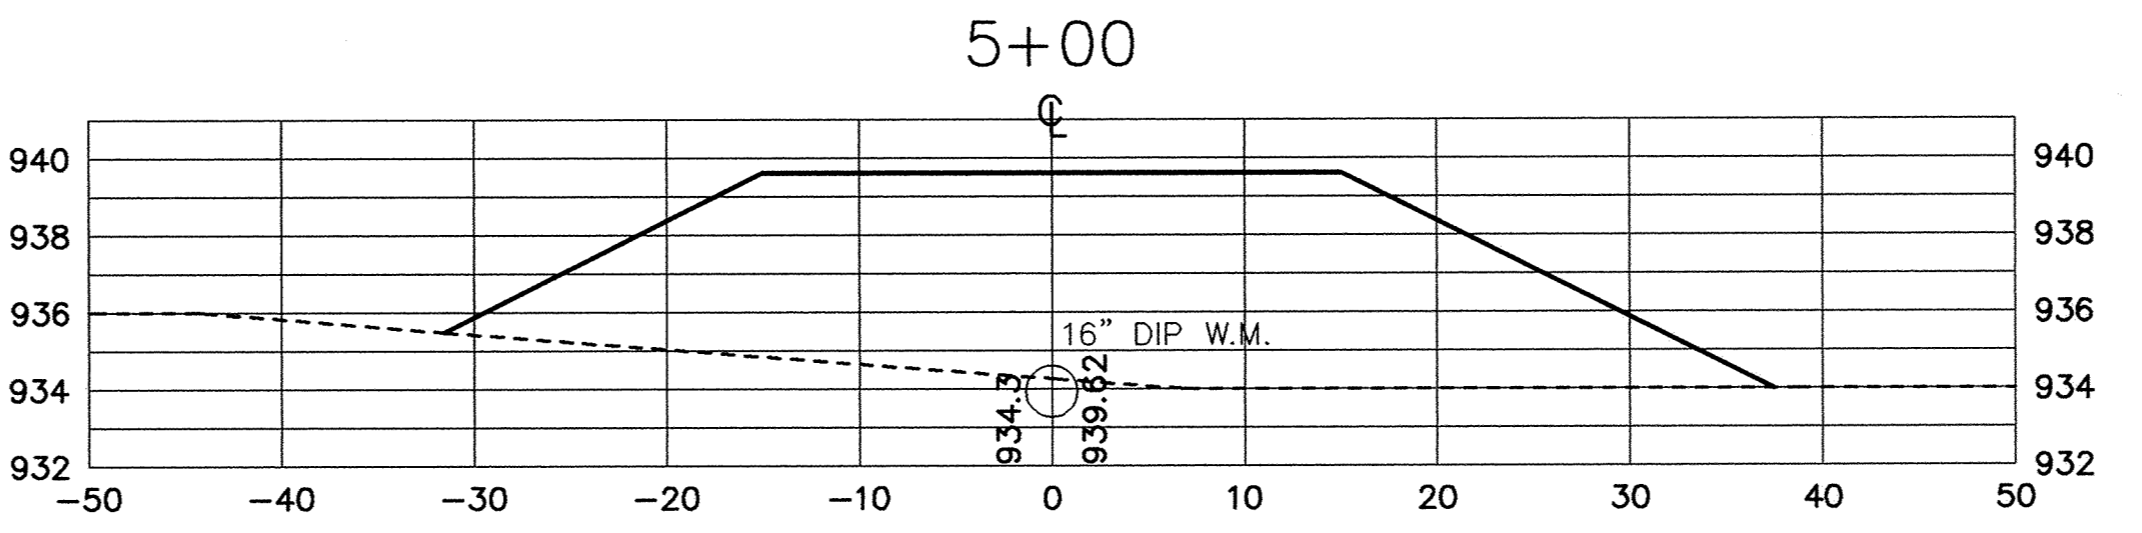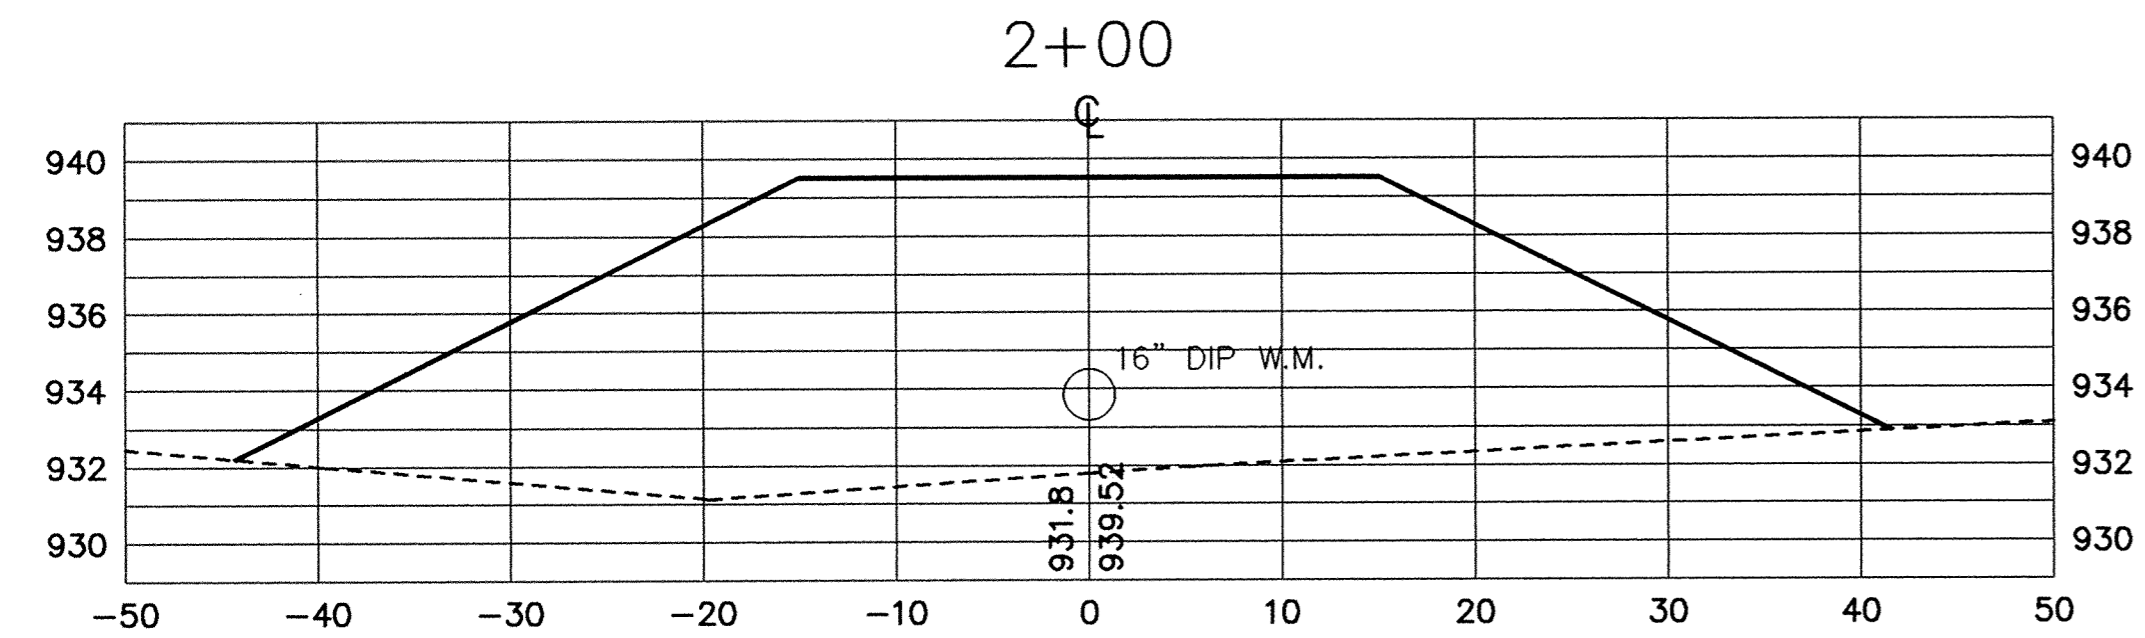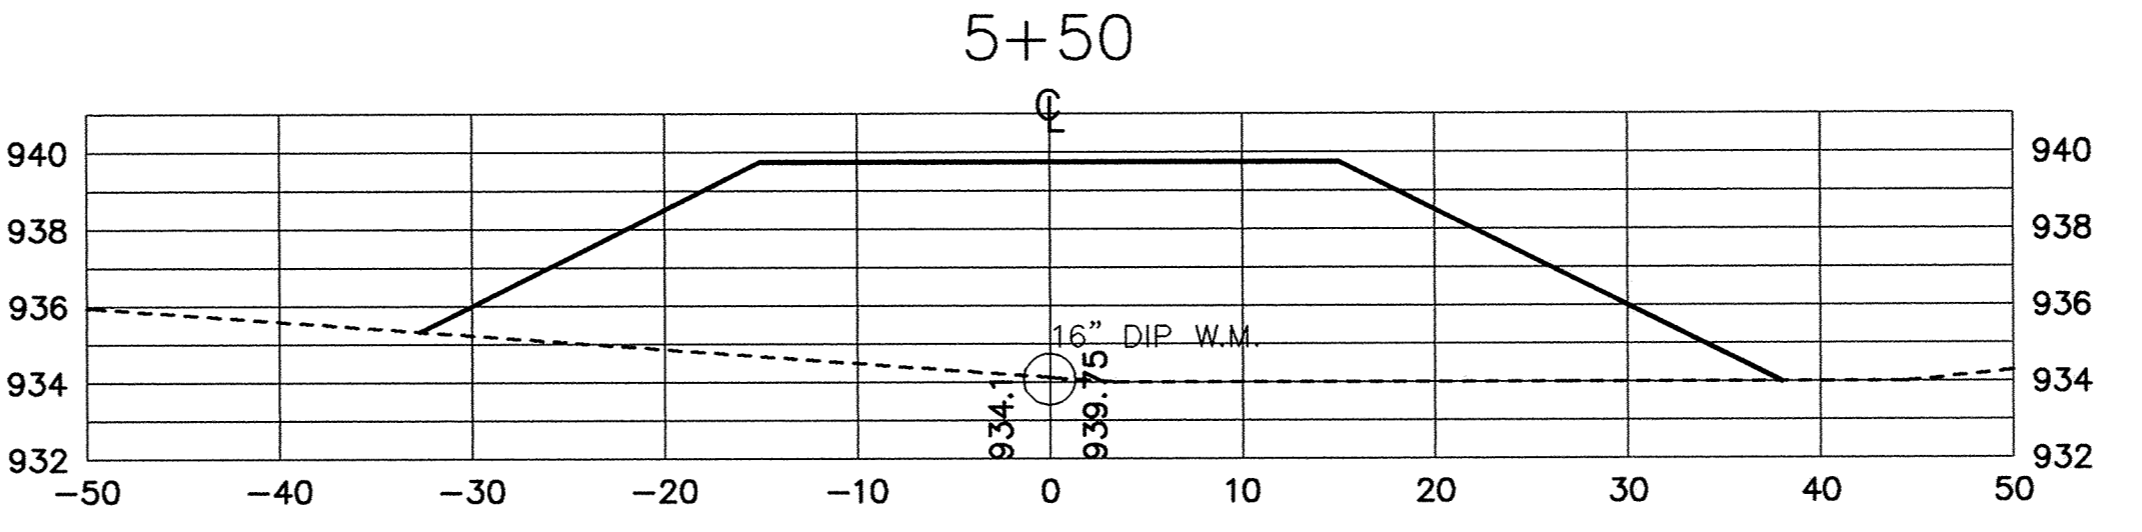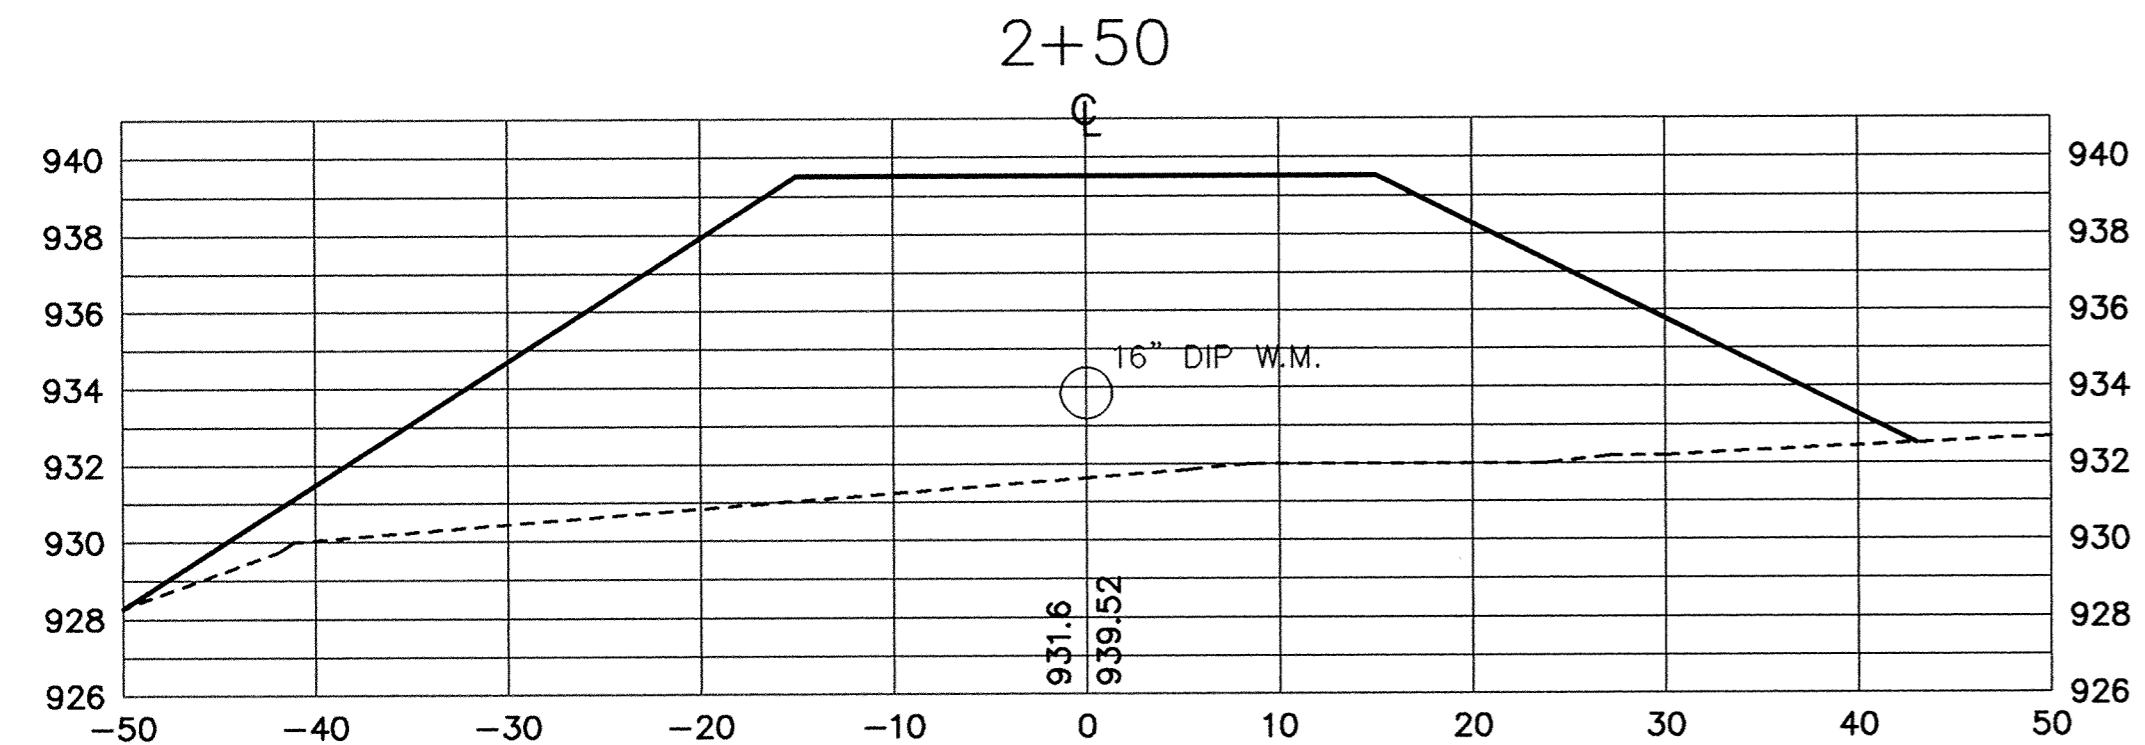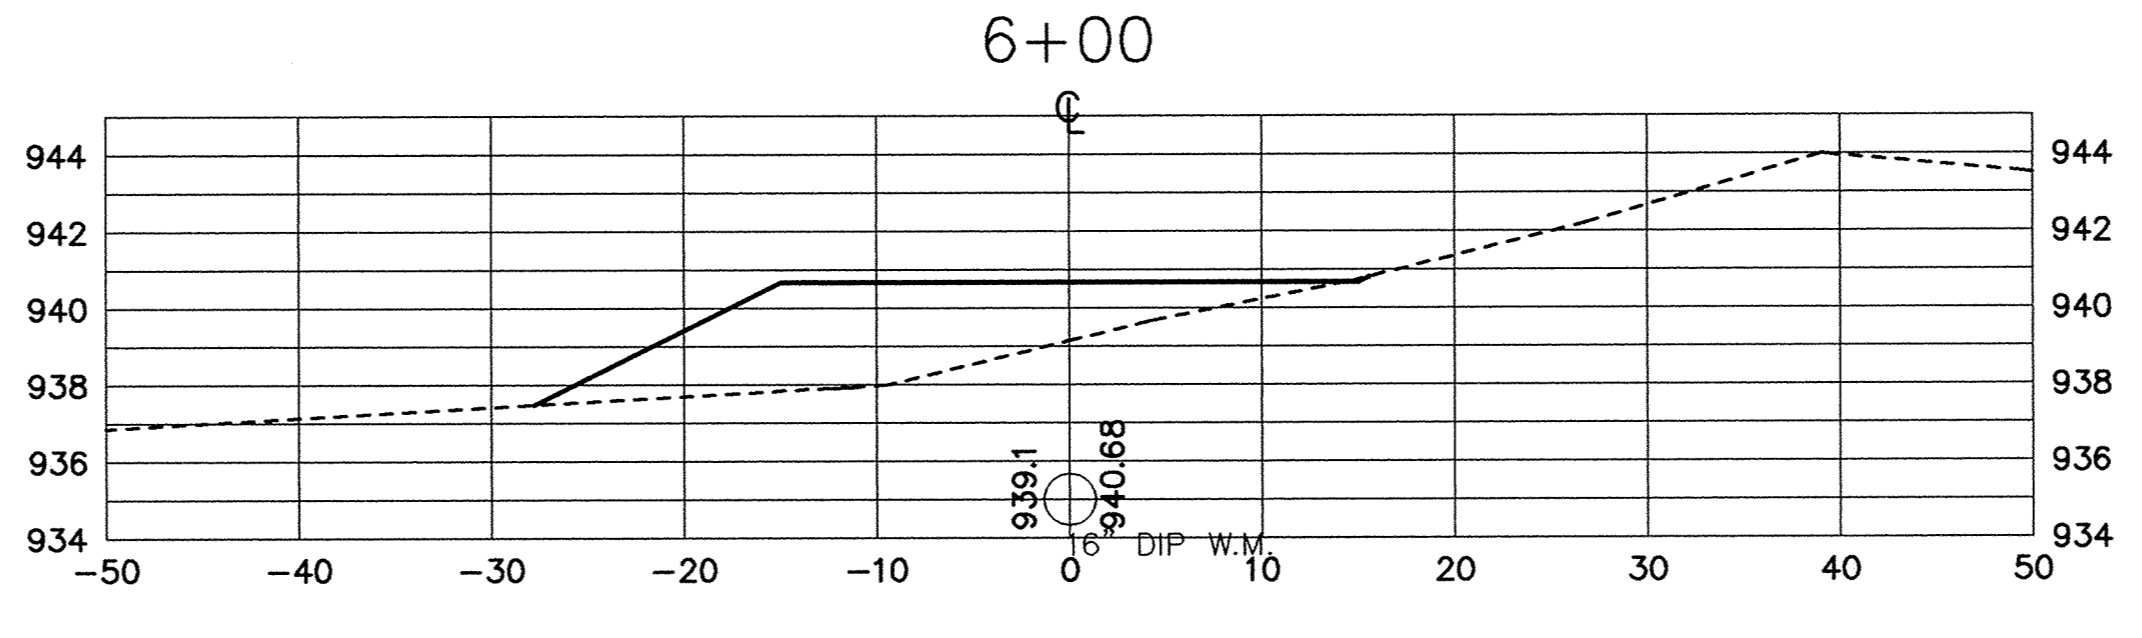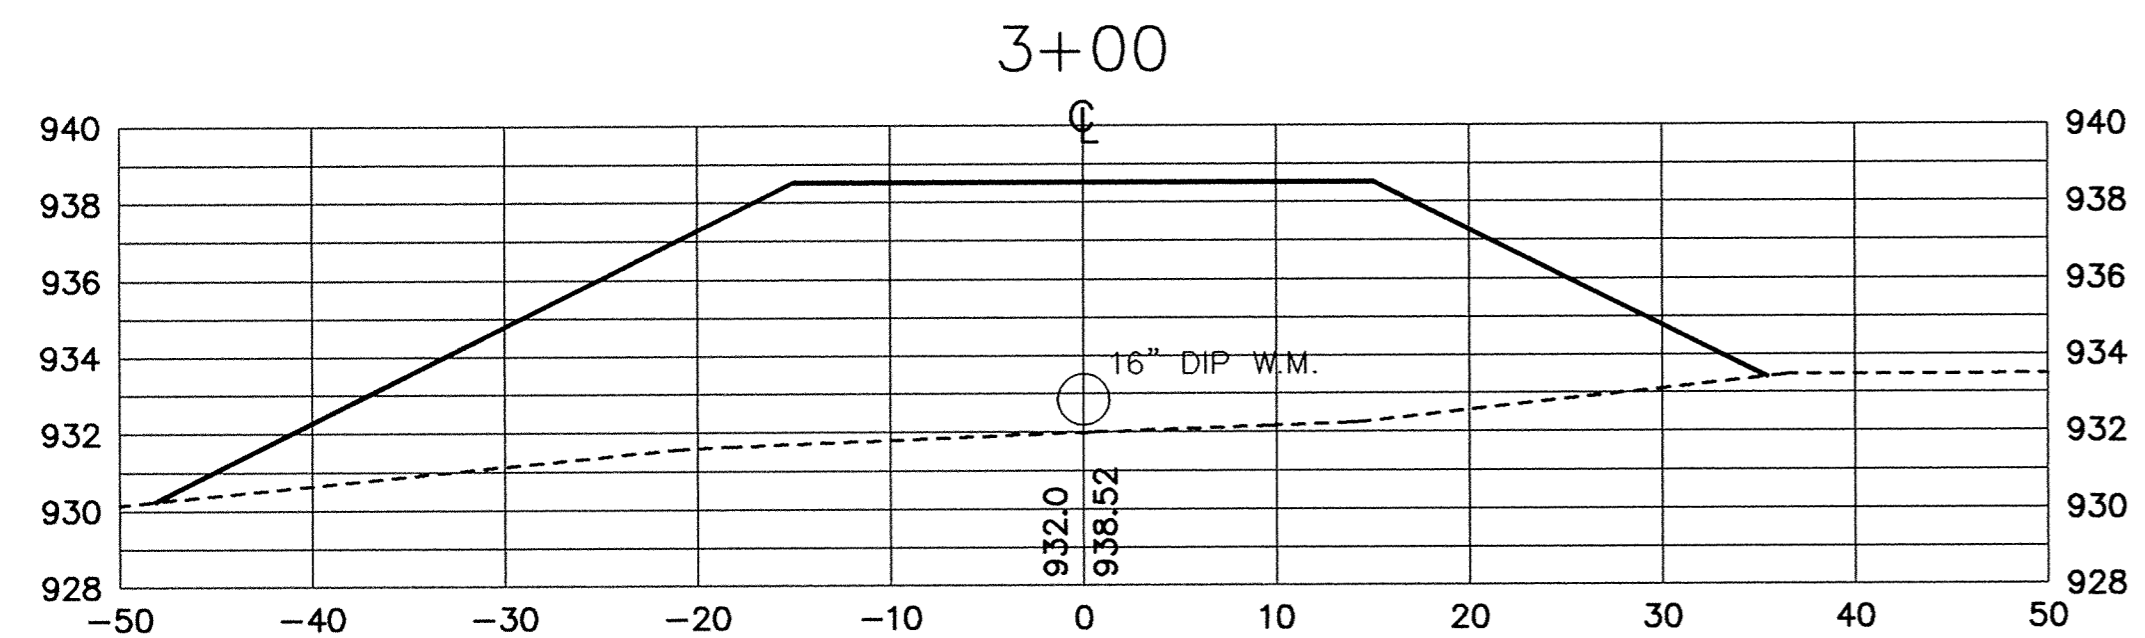

RECORD PLAN
 MARCH 1998

I HEREBY CERTIFY THAT THIS PLAN, SPECIFICATION, OR REPORT WAS PREPARED BY ME OR UNDER MY DIRECT SUPERVISION AND THAT I AM A DULY REGISTERED PROFESSIONAL ENGINEER UNDER THE LAWS OF THE STATE OF MINNESOTA. DATE <u>4/9/97</u> REG. NO. <u>15316</u>		1326 ENERGY PARK DRIVE ST. PAUL, MINNESOTA 55108 (612) 644-4389	DATE	DESCRIPTION	DESIGNED <u>AJB</u>	ELK RIVER MUNICIPAL UTILITIES HIGHLAND ROAD TRUNK WATERMAIN COTTAGES OF ELK RIVER CROSS SECTIONS	1+00 TO 6+00
			REVISIONS	CHECKED _____ DRAWN <u>RKM</u>	GRAPHIC SCALE 0 10 0 VERT. 5		

0:\CAD\New Archives\ELK RIVER\ERU13\ERU13-x1.dwg Sun Mar 29 12:21:56 1998