

REVISIONS	NO.	DATE	BY	DESCRIPTION


I HEREBY CERTIFY THAT THIS PLAN, SPECIFICATION OR REPORT WAS PREPARED BY ME OR UNDER MY DIRECT SUPERVISION AND THAT I AM A DULY LICENSED PROFESSIONAL ENGINEER UNDER THE LAWS OF THE STATE OF MINNESOTA.

NAME: _____ LIC. NO.: 15316
 DATE: 05-02-06

SAP 204-187-001

RECORD PLAN
 HIGHLAND ROAD IMPROVEMENTS


TYPICAL STREET SECTION

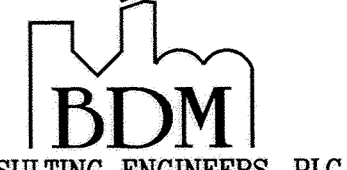


BDM
 CONSULTING ENGINEERS, PLC
 Engineers and Surveyors
 4175 Lovell Road, Suite 112
 Lexington, MN 55014
 Phone: (763) 786-4570
 Fax: (763) 786-4574
 bdmce.com

DRAWN BY: NAB
 CHECKED BY: KJT
 DESIGNED BY: KJT
 JOB NO. 226068D

SHEET 5 SHEETS 55

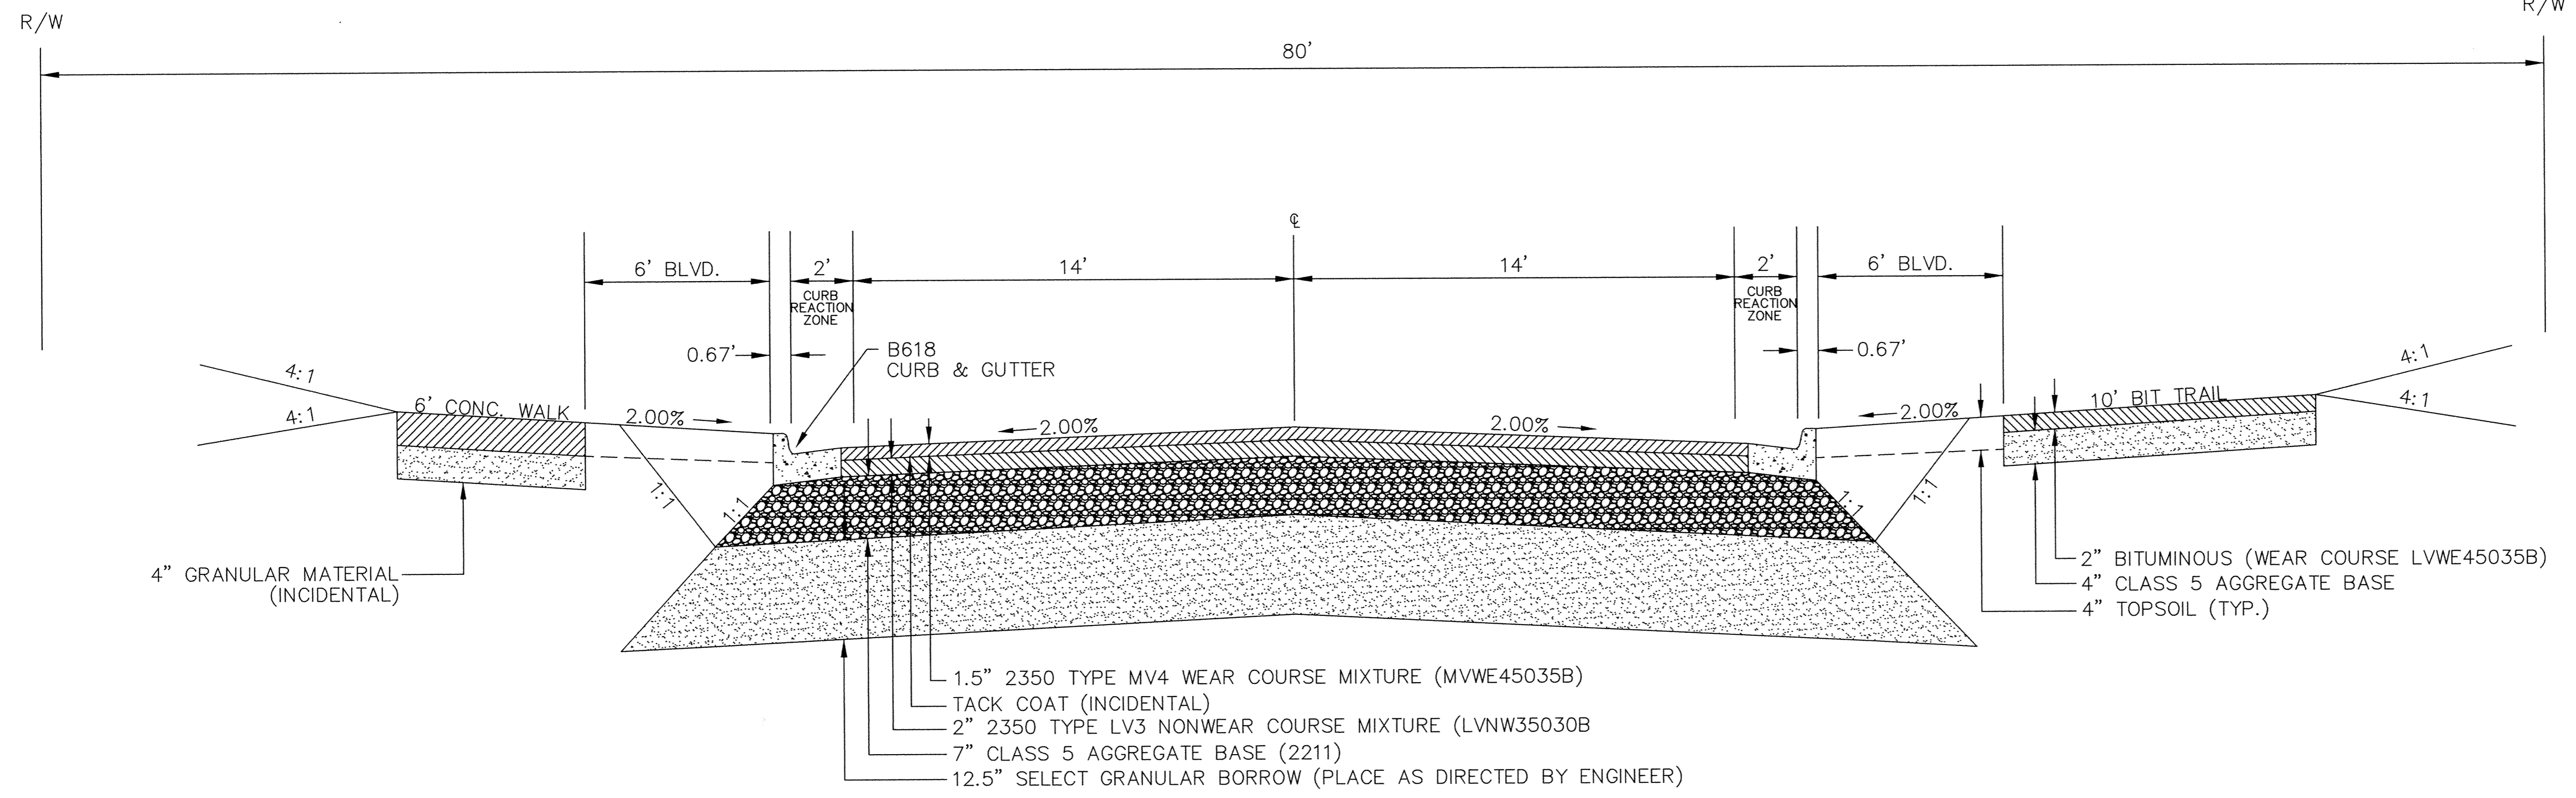

TYPICAL STREET SECTION
 STATION 0+00 TO 10+75

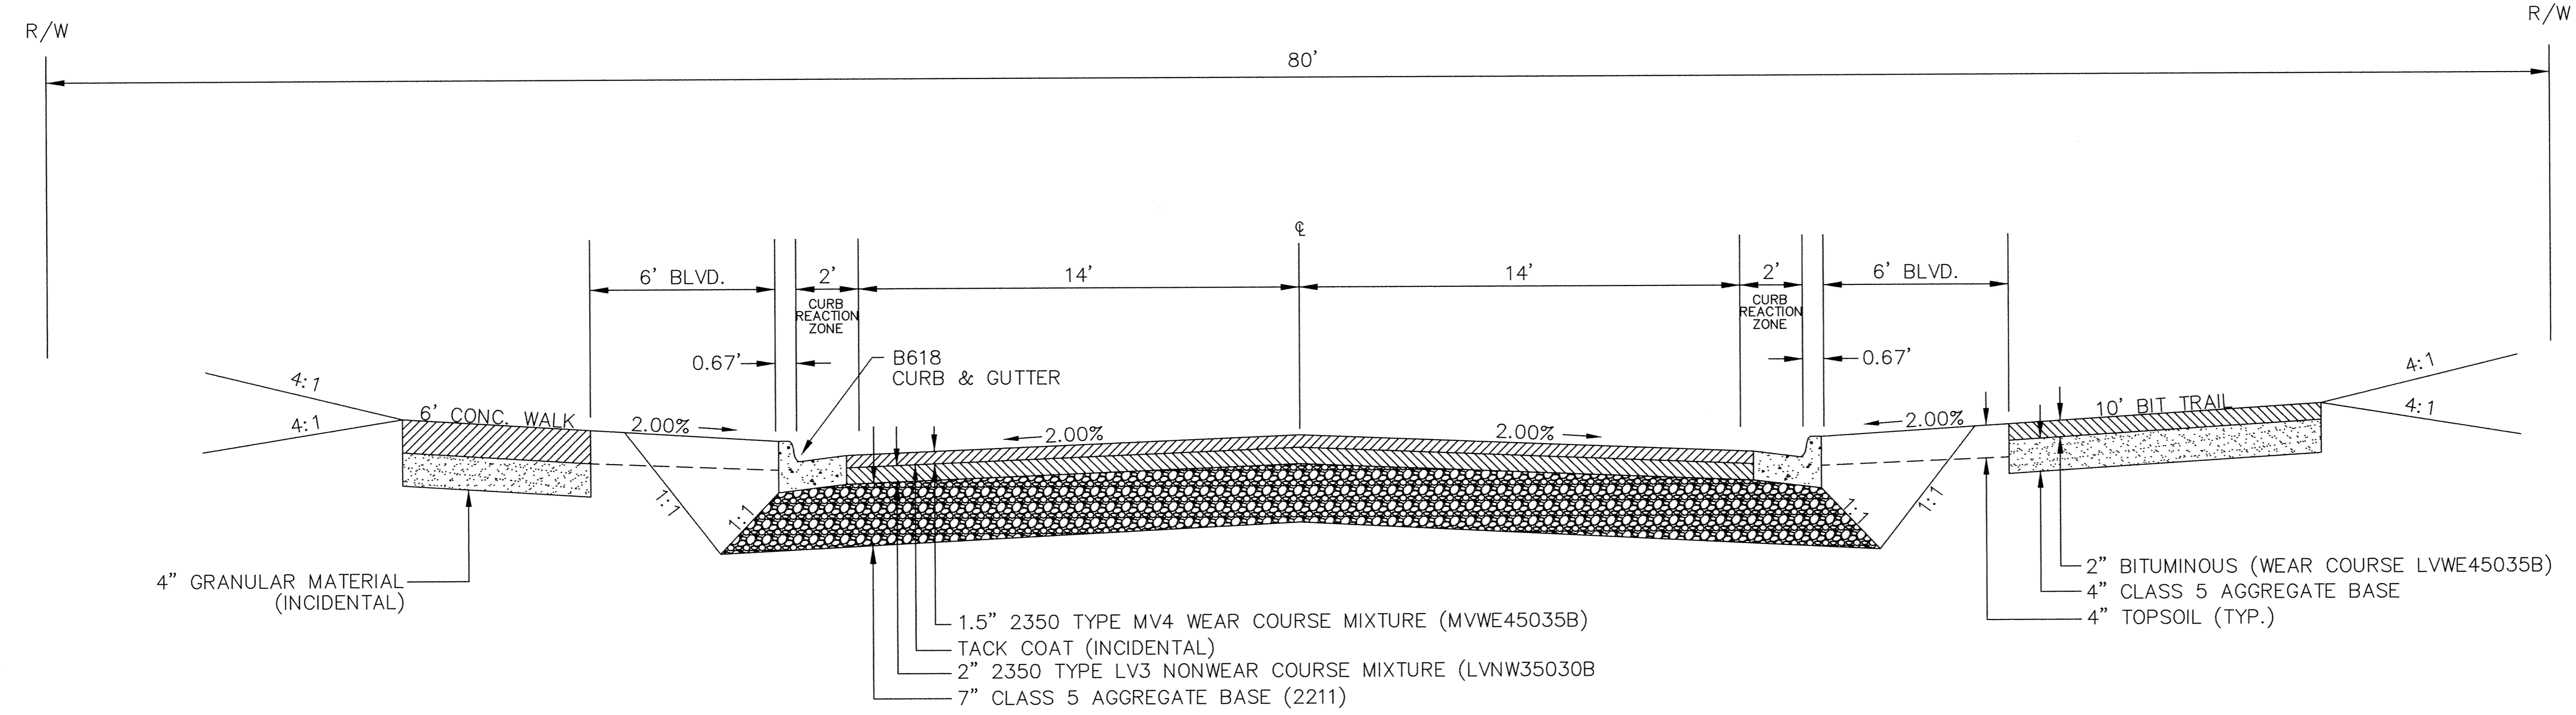

TYPICAL STREET SECTION
 STATION 10+75 TO 39+06