


- NOTES:
- EXISTING LANDSCAPING FEATURES SHALL BE PROTECTED IF NECESSARY, SALVAGING AND REINSTALLING SHALL BE CONSIDERED INCIDENTAL.
 - ALL DRIVEWAYS SHALL BE FULL DEPTH STRAIGHT LINE SAW CUT IMMEDIATELY PROCEEDING PAVING.

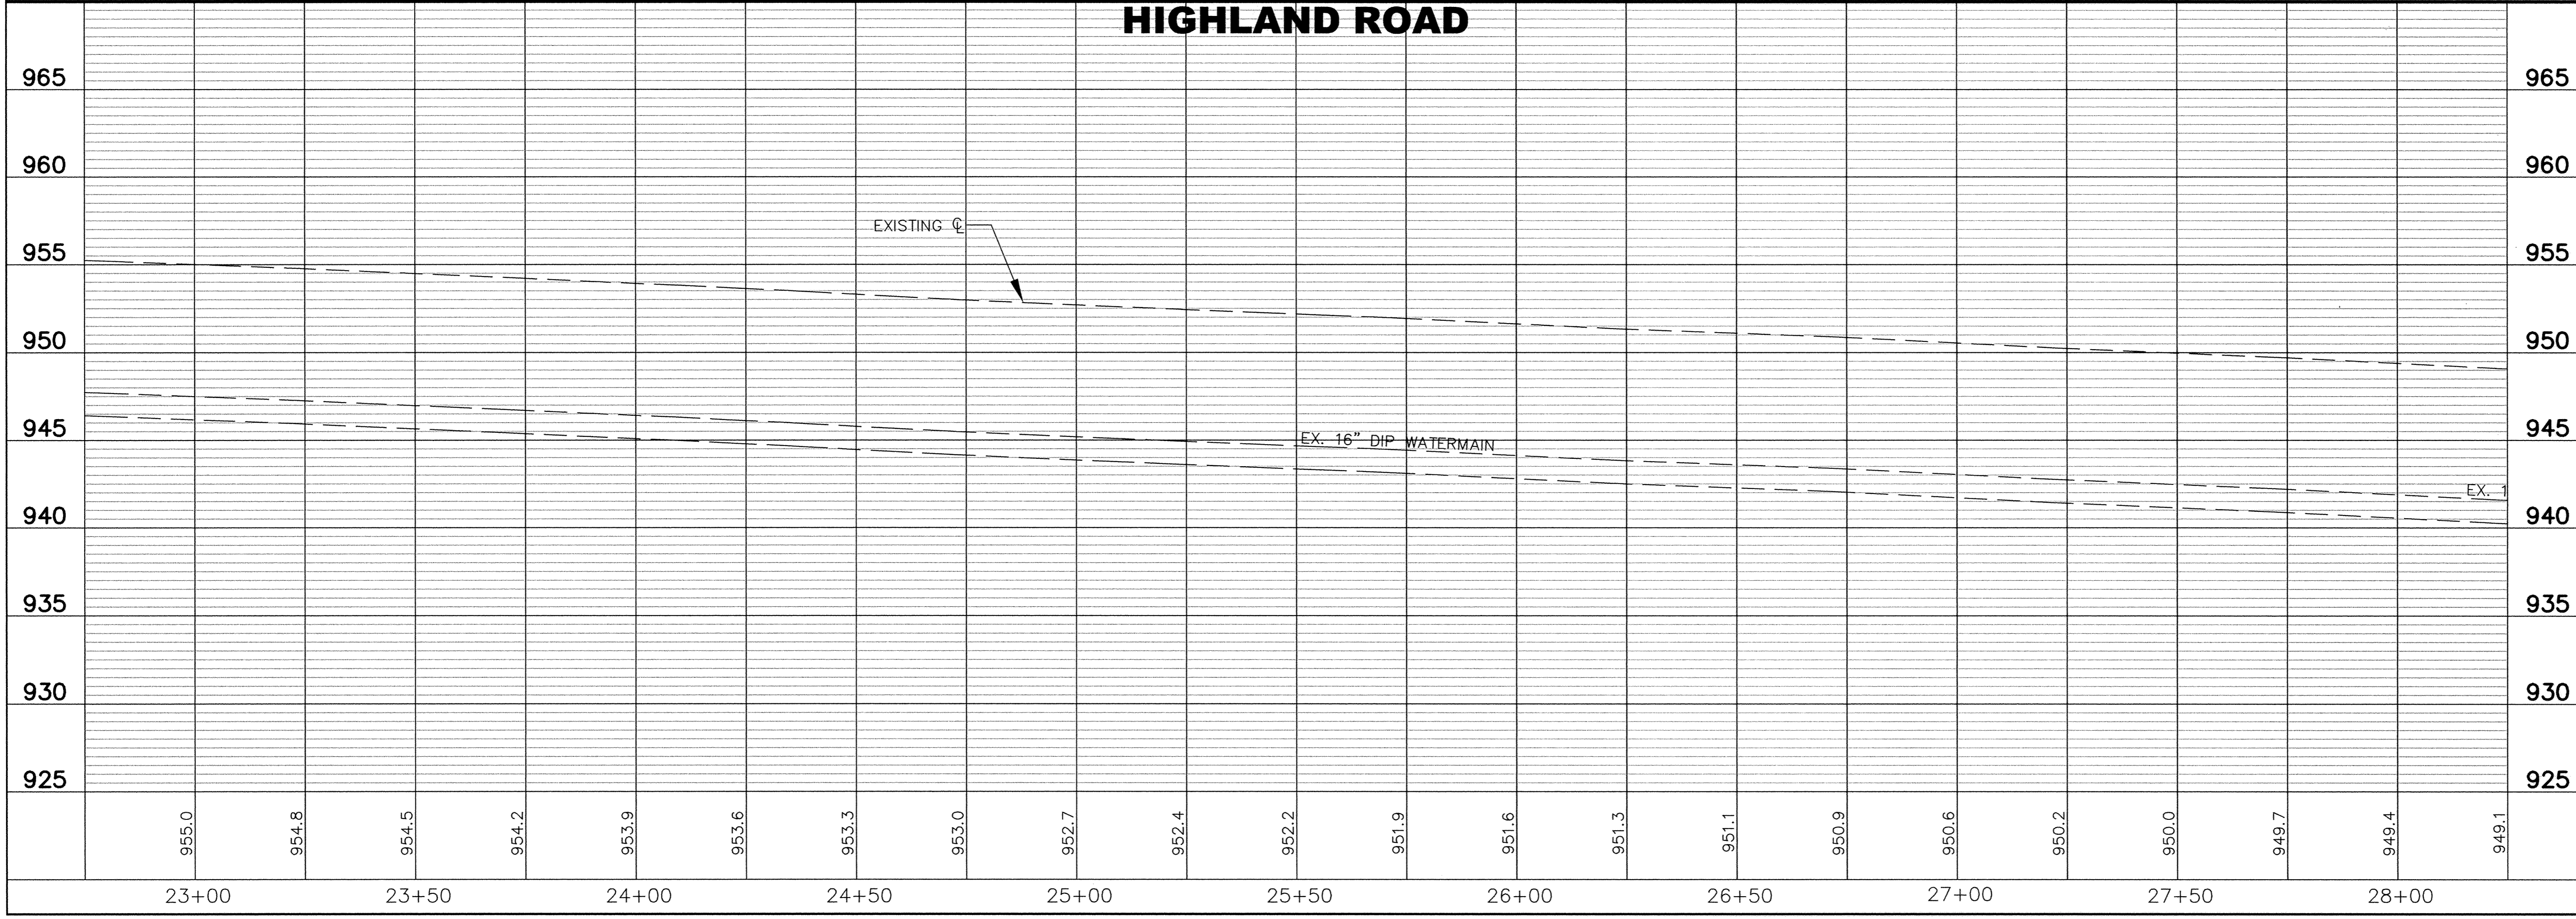

REVISIONS		NO. DATE		BY DESCRIPTION	
I HEREBY CERTIFY THAT THIS PLAN, SPECIFICATION, OR REPORT WAS PREPARED BY ME OR UNDER MY DIRECT SUPERVISION AND THAT I AM A DULY LICENSED PROFESSIONAL ENGINEER UNDER THE LAWS OF THE STATE OF MINNESOTA.		DATE	05-02-2006	LIC. NO.	15316
SAP 204-137-001 RECORD PLAN HIGHLAND ROAD IMPROVEMENTS		23+00 TO 28+00			
REMOVAL PLAN HIGHLAND ROAD					
CONSULTING ENGINEERS, P.L.C. Engineers and Surveyors 4175 Lovell Road, Suite 112 Lexington, MN 55014 Phone: (763) 786-4570 Fax: (763) 786-4574 bdme.com					
DRAWN BY: NAB					
CHECKED BY: KJT					
DESIGNED BY: KJT					
JOB NO. 226068D					
SHEET		SHEETS			
16		55			