


- NOTES:
- EXISTING LANDSCAPING FEATURES SHALL BE PROTECTED IF NECESSARY, SALVAGING AND REINSTALLING SHALL BE CONSIDERED INCIDENTAL.
 - ALL DRIVEWAYS SHALL BE FULL DEPTH STRAIGHT LINE SAW CUT IMMEDIATELY PROCEEDING PAVING.

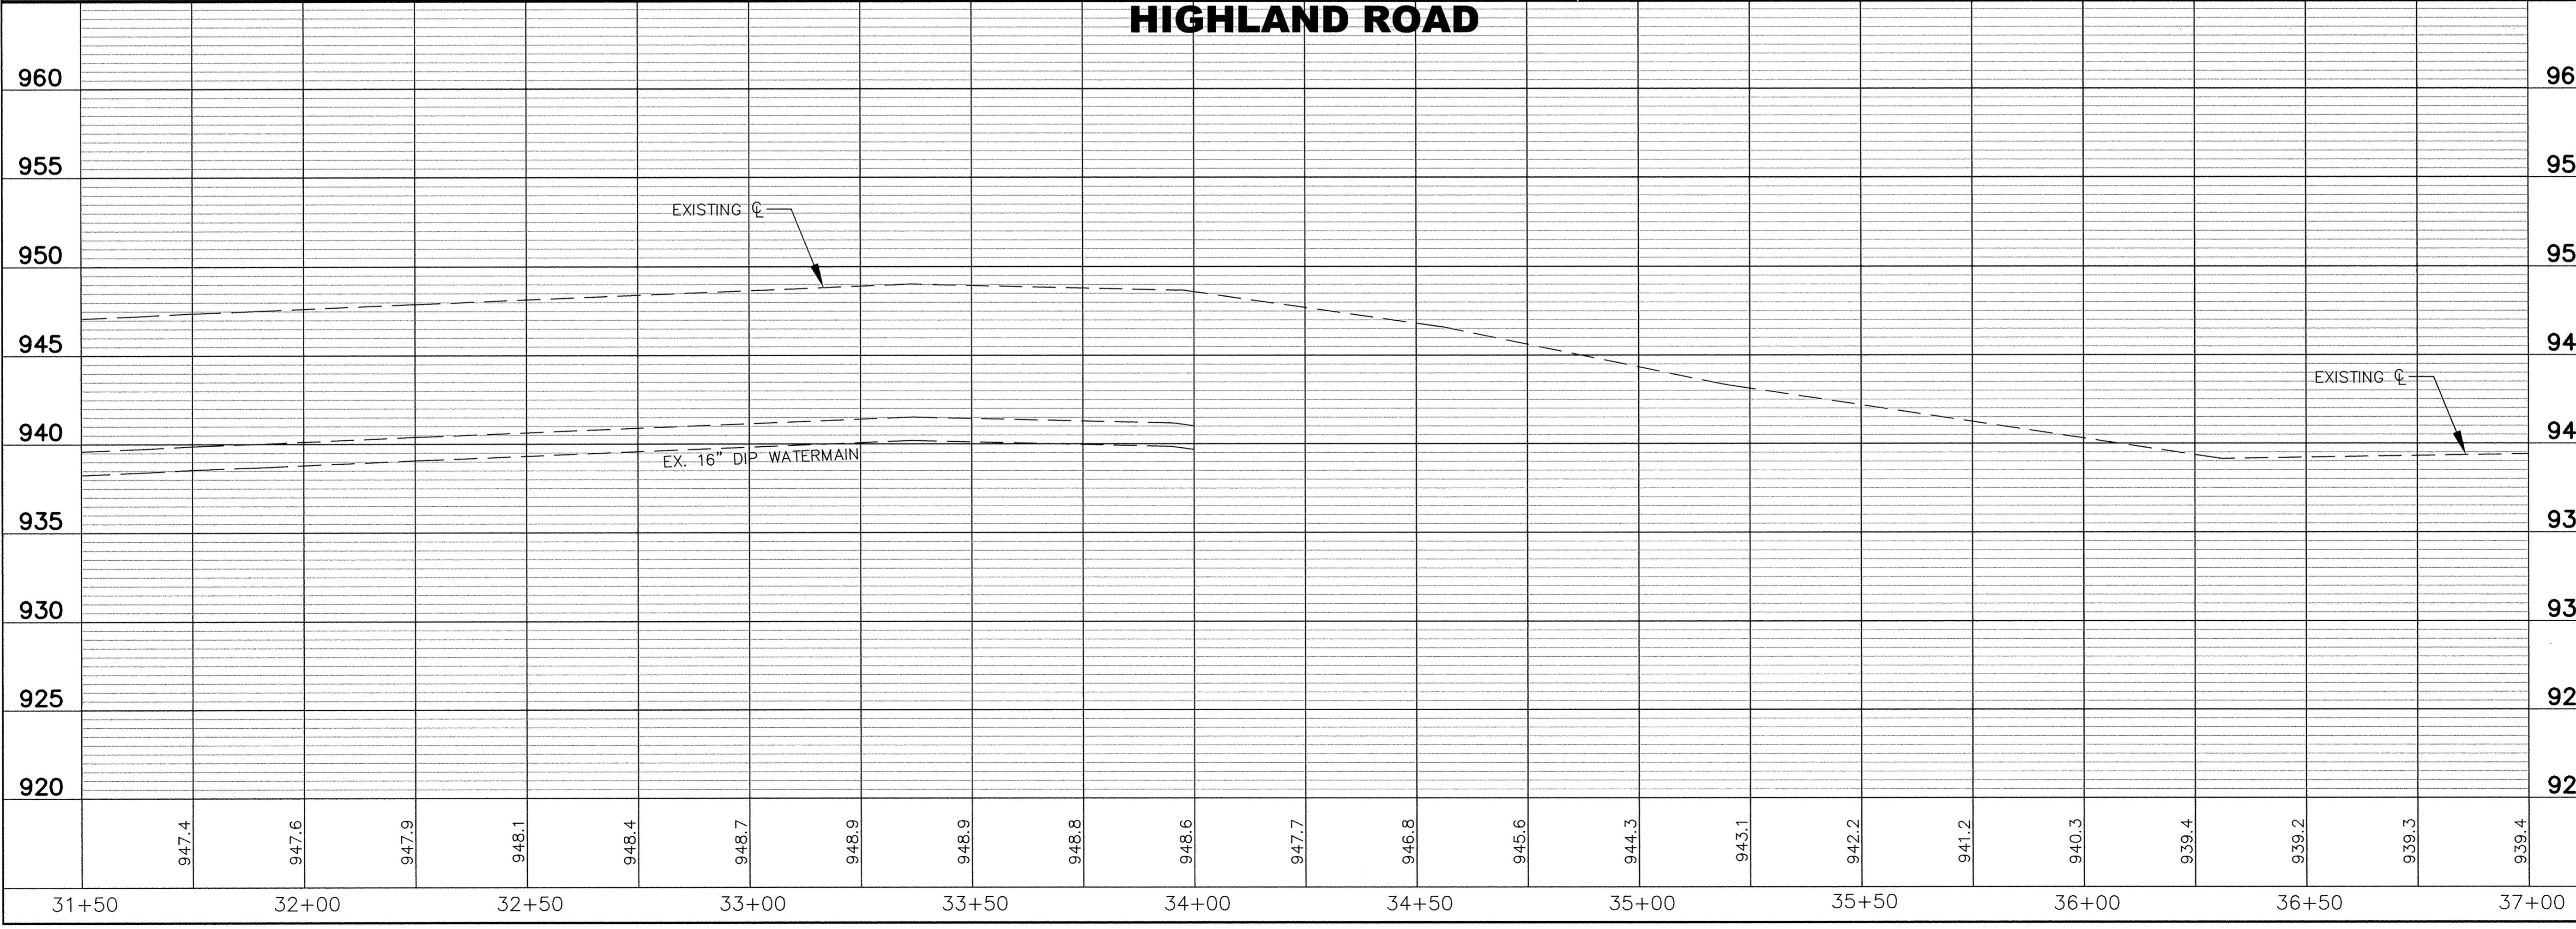

REVISIONS	
NO.	DATE
I HEREBY CERTIFY THAT THIS PLAN, SPECIFICATIONS, AND REPORTS WERE PREPARED BY ME OR UNDER MY DIRECT SUPERVISION AND THAT I AM A DULY LICENSED PROFESSIONAL ENGINEER UNDER THE LAWS OF THE STATE OF MINNESOTA.	
DATE 05-02-2006	LIC. NO. 15316
SAP 204-137-001 RECORD PLAN HIGHLAND ROAD IMPROVEMENTS	
REMOVAL PLAN HIGHLAND ROAD	
32+00 TO 37+00	
 BDM CONSULTING ENGINEERS, PLC Engineers and Surveyors 4175 Lovell Road, Suite 112 Lexington, MN 55014 Phone: (763) 786-4570 Fax: (763) 786-4574 bdmce.com	
DRAWN BY: NAB	
CHECKED BY: KJT	
DESIGNED BY: KJT	
JOB NO. 226068D	
SHEET 18	SHEETS 55