

NO.	DATE	BY	DESCRIPTION
1	06/28/06	NB	CHANGE ORDER #1

I HEREBY CERTIFY THAT THIS PLAN, SPECIFICATION, REPORT, AND DIRECT SUPERVISION AND THAT I AM A LICENSED PROFESSIONAL ENGINEER UNDER THE LAWS OF THE STATE OF MINNESOTA.

05-02-2006 15316
 DATE LIC. NO.

SAP 204-137-001


RECORD PLAN

HIGHLAND ROAD IMPROVEMENTS

STREET AND STORM SEWER

HIGHLAND ROAD

0+00 TO 4+50

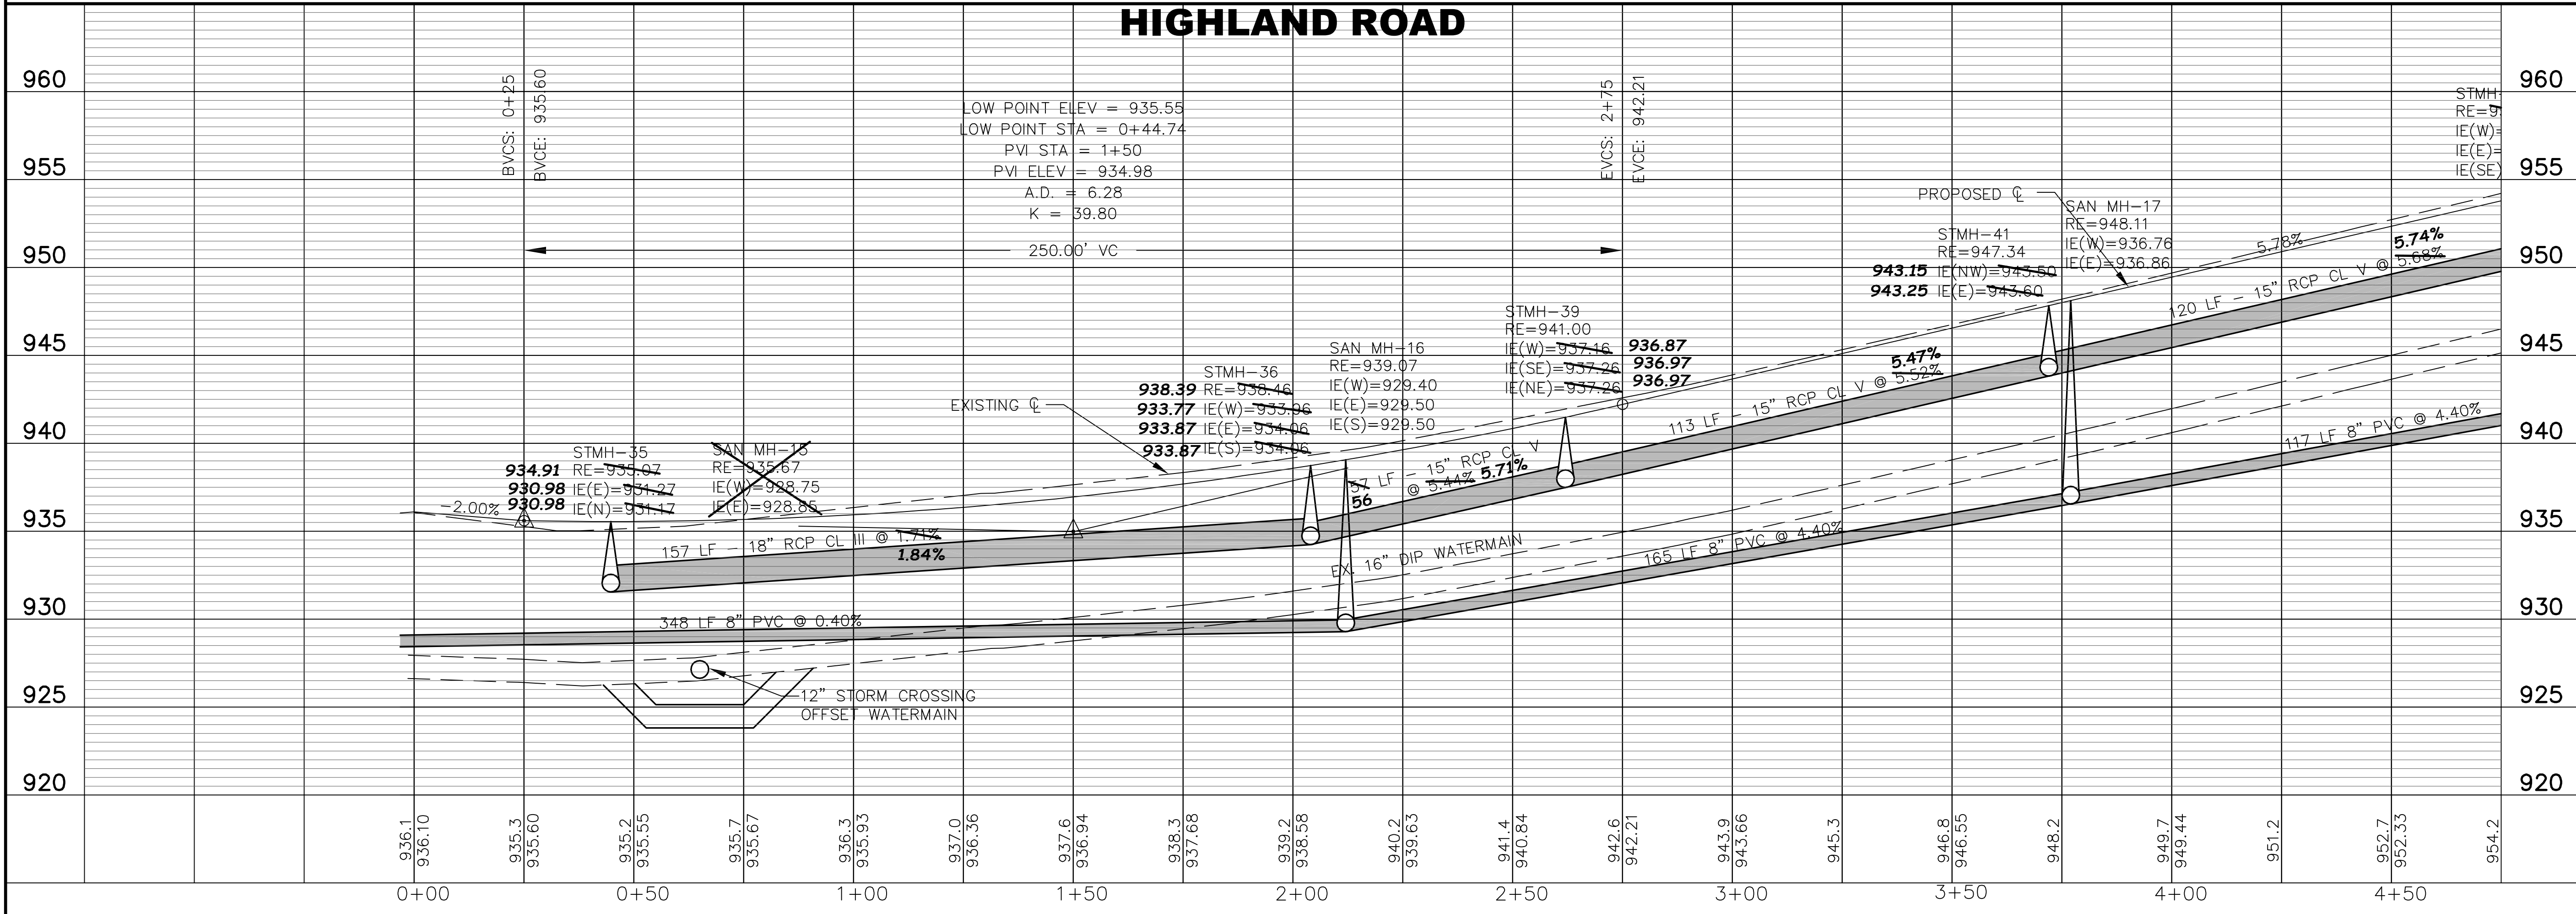

BDM
 CONSULTING ENGINEERS, PLC
 Engineers and Surveyors
 4175 Lovell Road, Suite 112
 Lexington, MN 55014
 Phone: (763) 786-4570
 Fax: (763) 786-4574
 bdmce.com

DRAWN BY: NAB
 CHECKED BY: KJT
 DESIGNED BY: KJT
 JOB NO. 226068D

SHEET **20** SHEETS **55**