
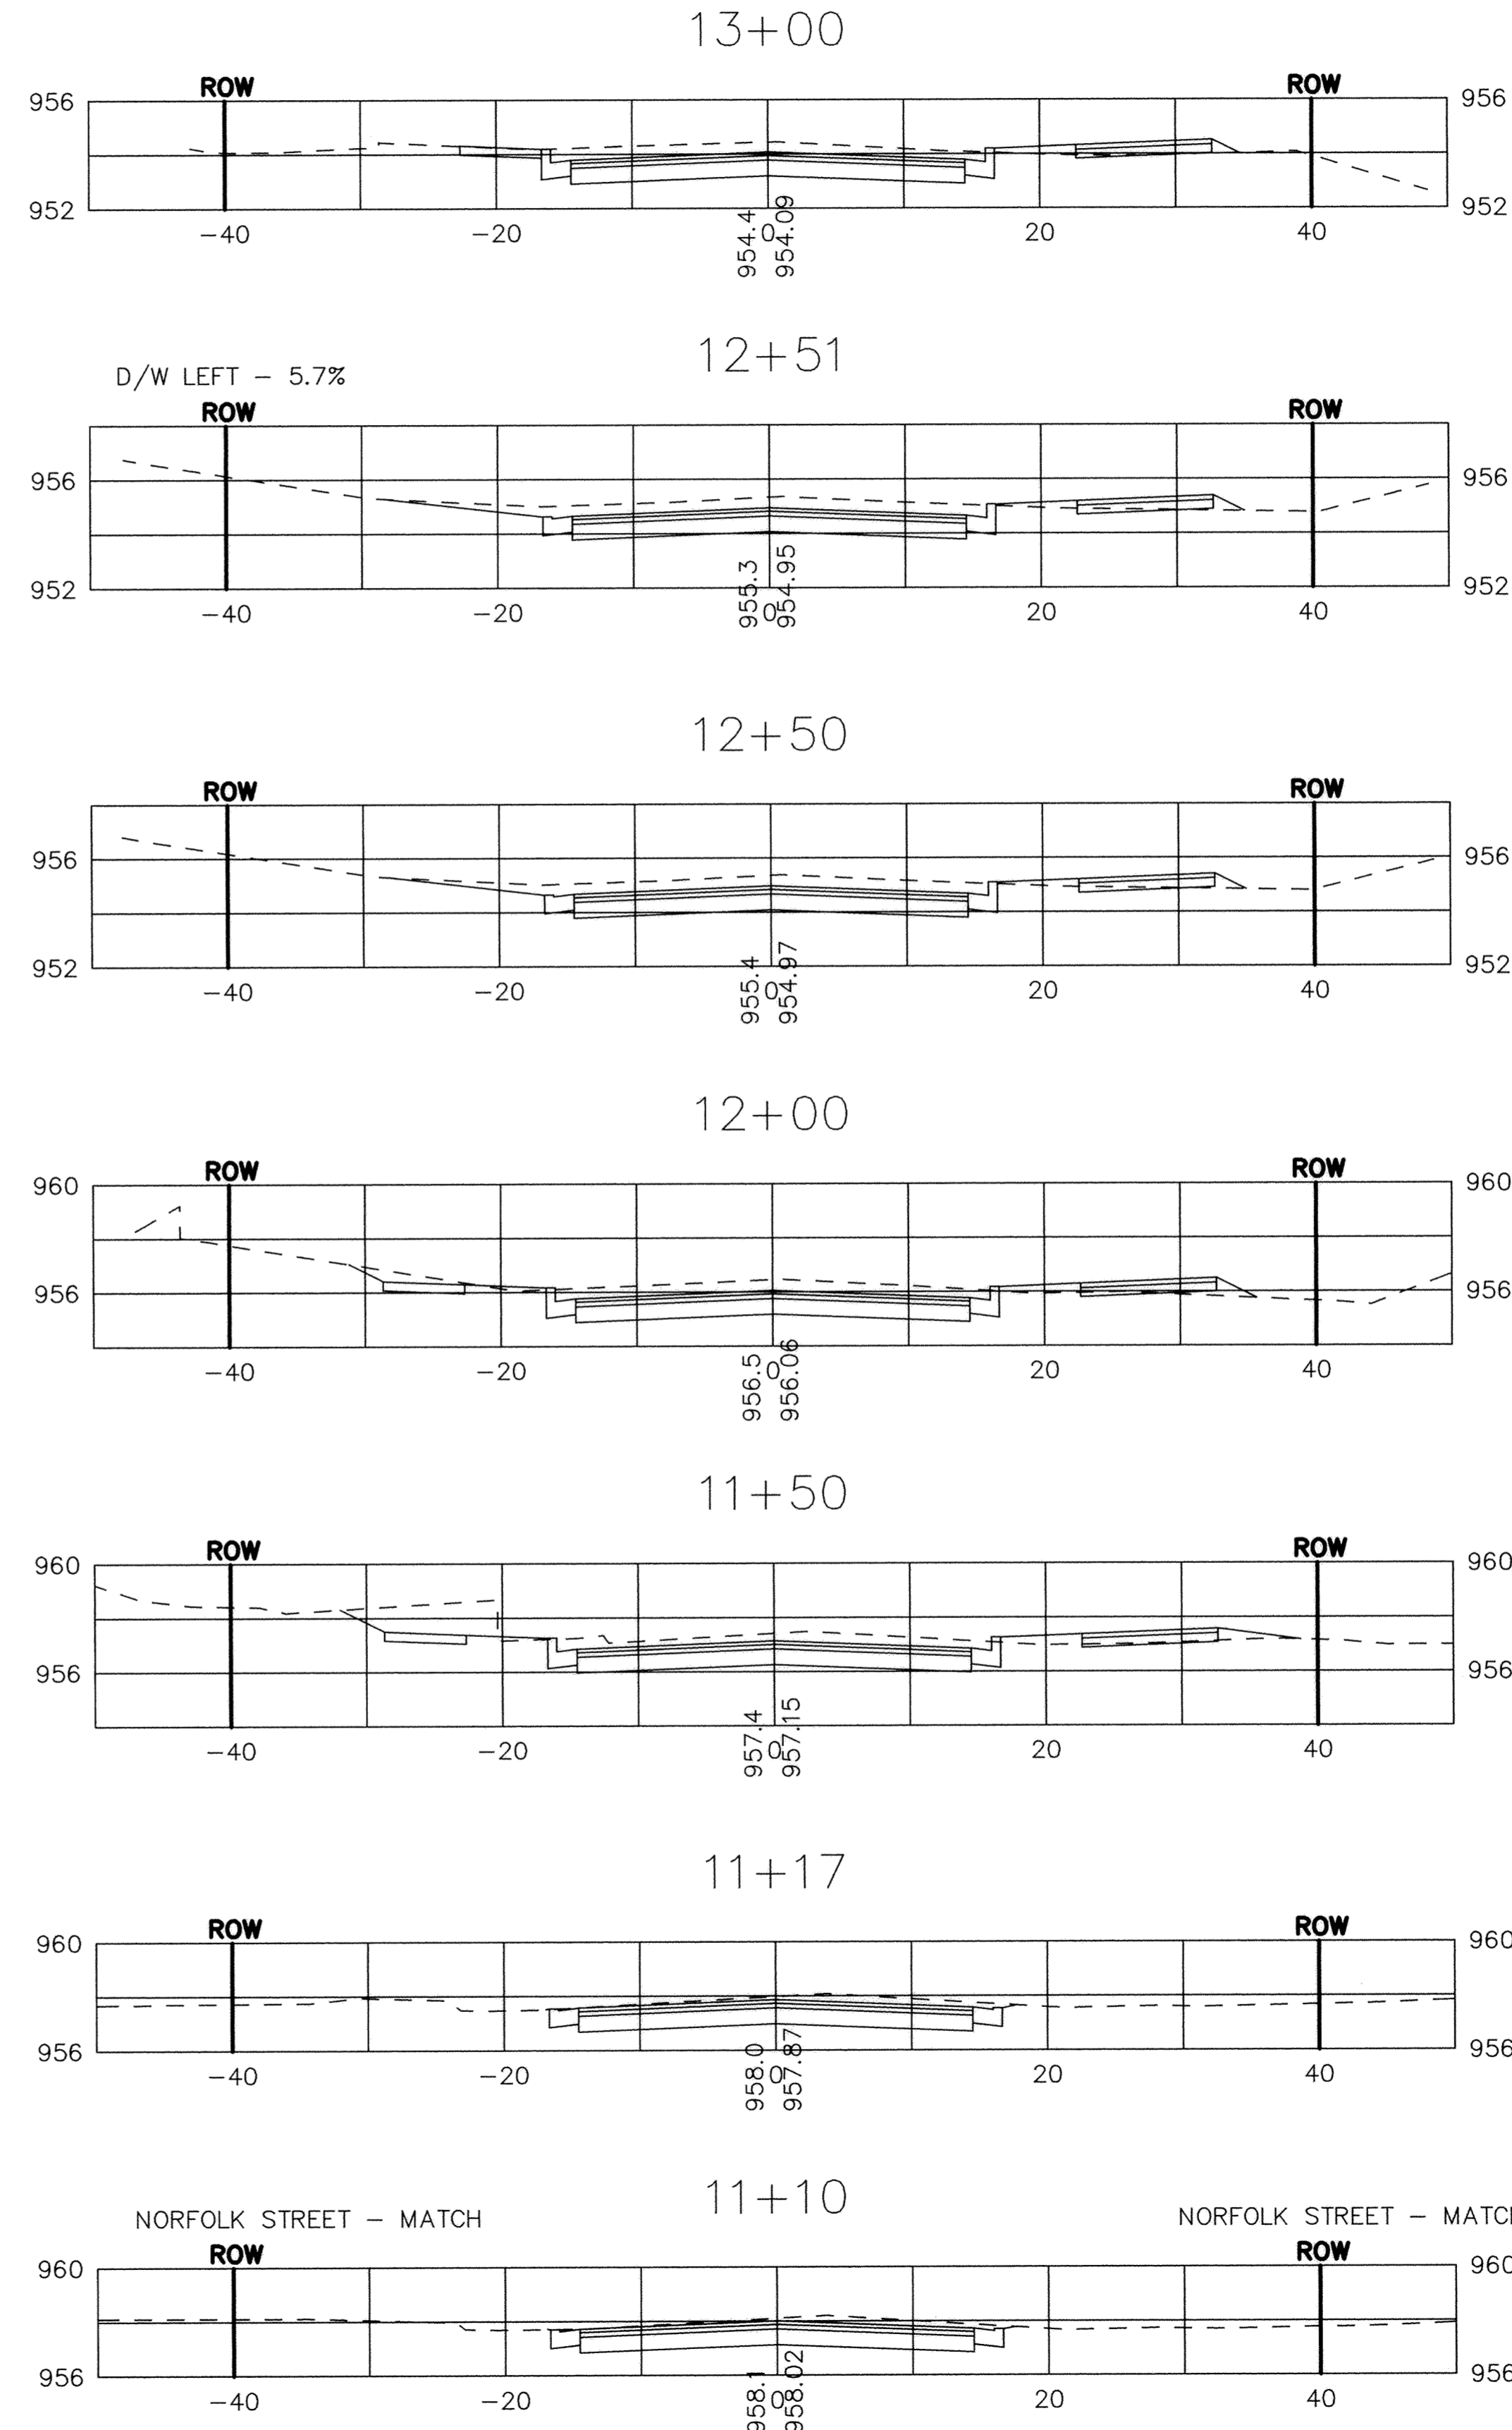


HIGHLAND ROAD

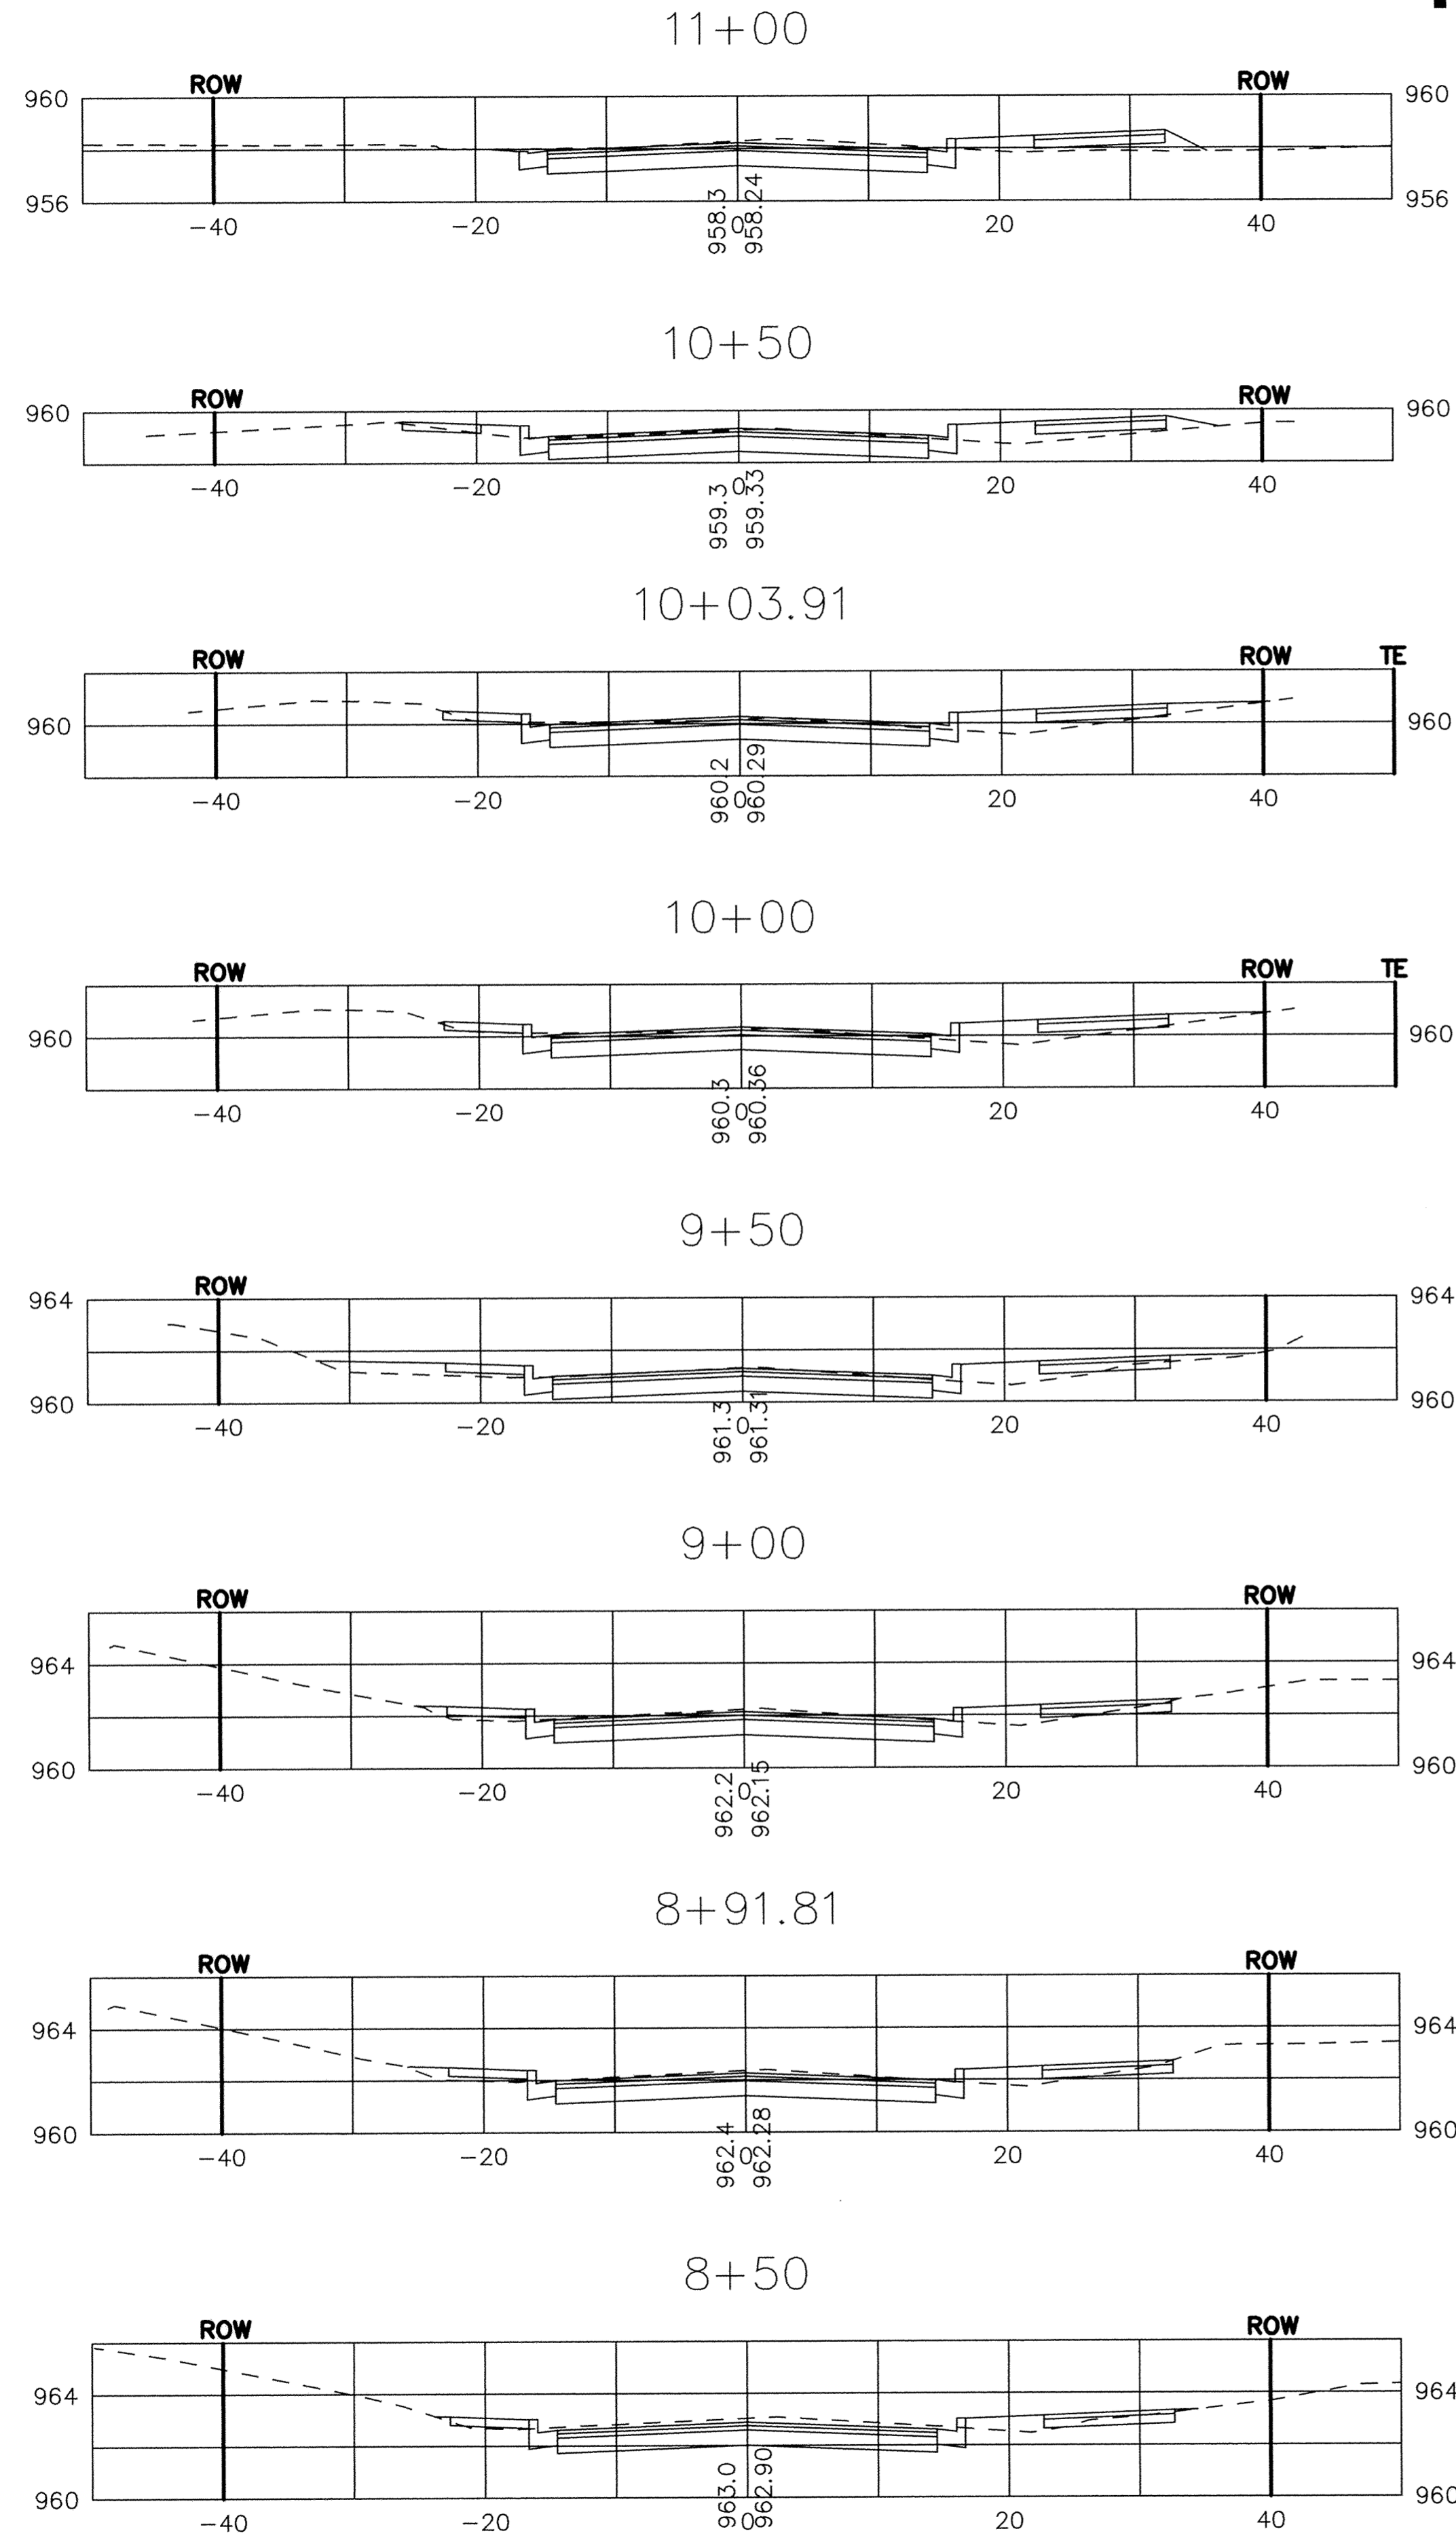

I HEREBY CERTIFY THAT THIS PLAN, SPECIFICATION, OR REPORT WAS PREPARED BY ME UNDER MY DIRECT SUPERVISION AND THAT I AM A LICENSED PROFESSIONAL ENGINEER UNDER THE LAWS OF THE STATE OF MINNESOTA.

05-02-2006 15316
DATE LIC. NO.

SAP 204-137-001

RECORD PLAN HIGHLAND ROAD IMPROVEMENTS

CROSS SECTIONS

8+50 TO 13+00

BDM
CONSULTING ENGINEERS, PLC
Engineers and Surveyors
4175 Lovell Road, Suite 112
Lexington, MN 55014
Phone: (763) 786-4570
Fax: (763) 786-4574
bdmce.com

DRAWN BY: NAB
CHECKED BY: KJT
DESIGNED BY: KJT
JOB NO. 226068D

SHEET **40** SHEETS **55**

DRAWING NUMBER 40

DRAWING NUMBER HIGHLAND 06

DRAWING NUMBER

DRAWING NUMBER

