
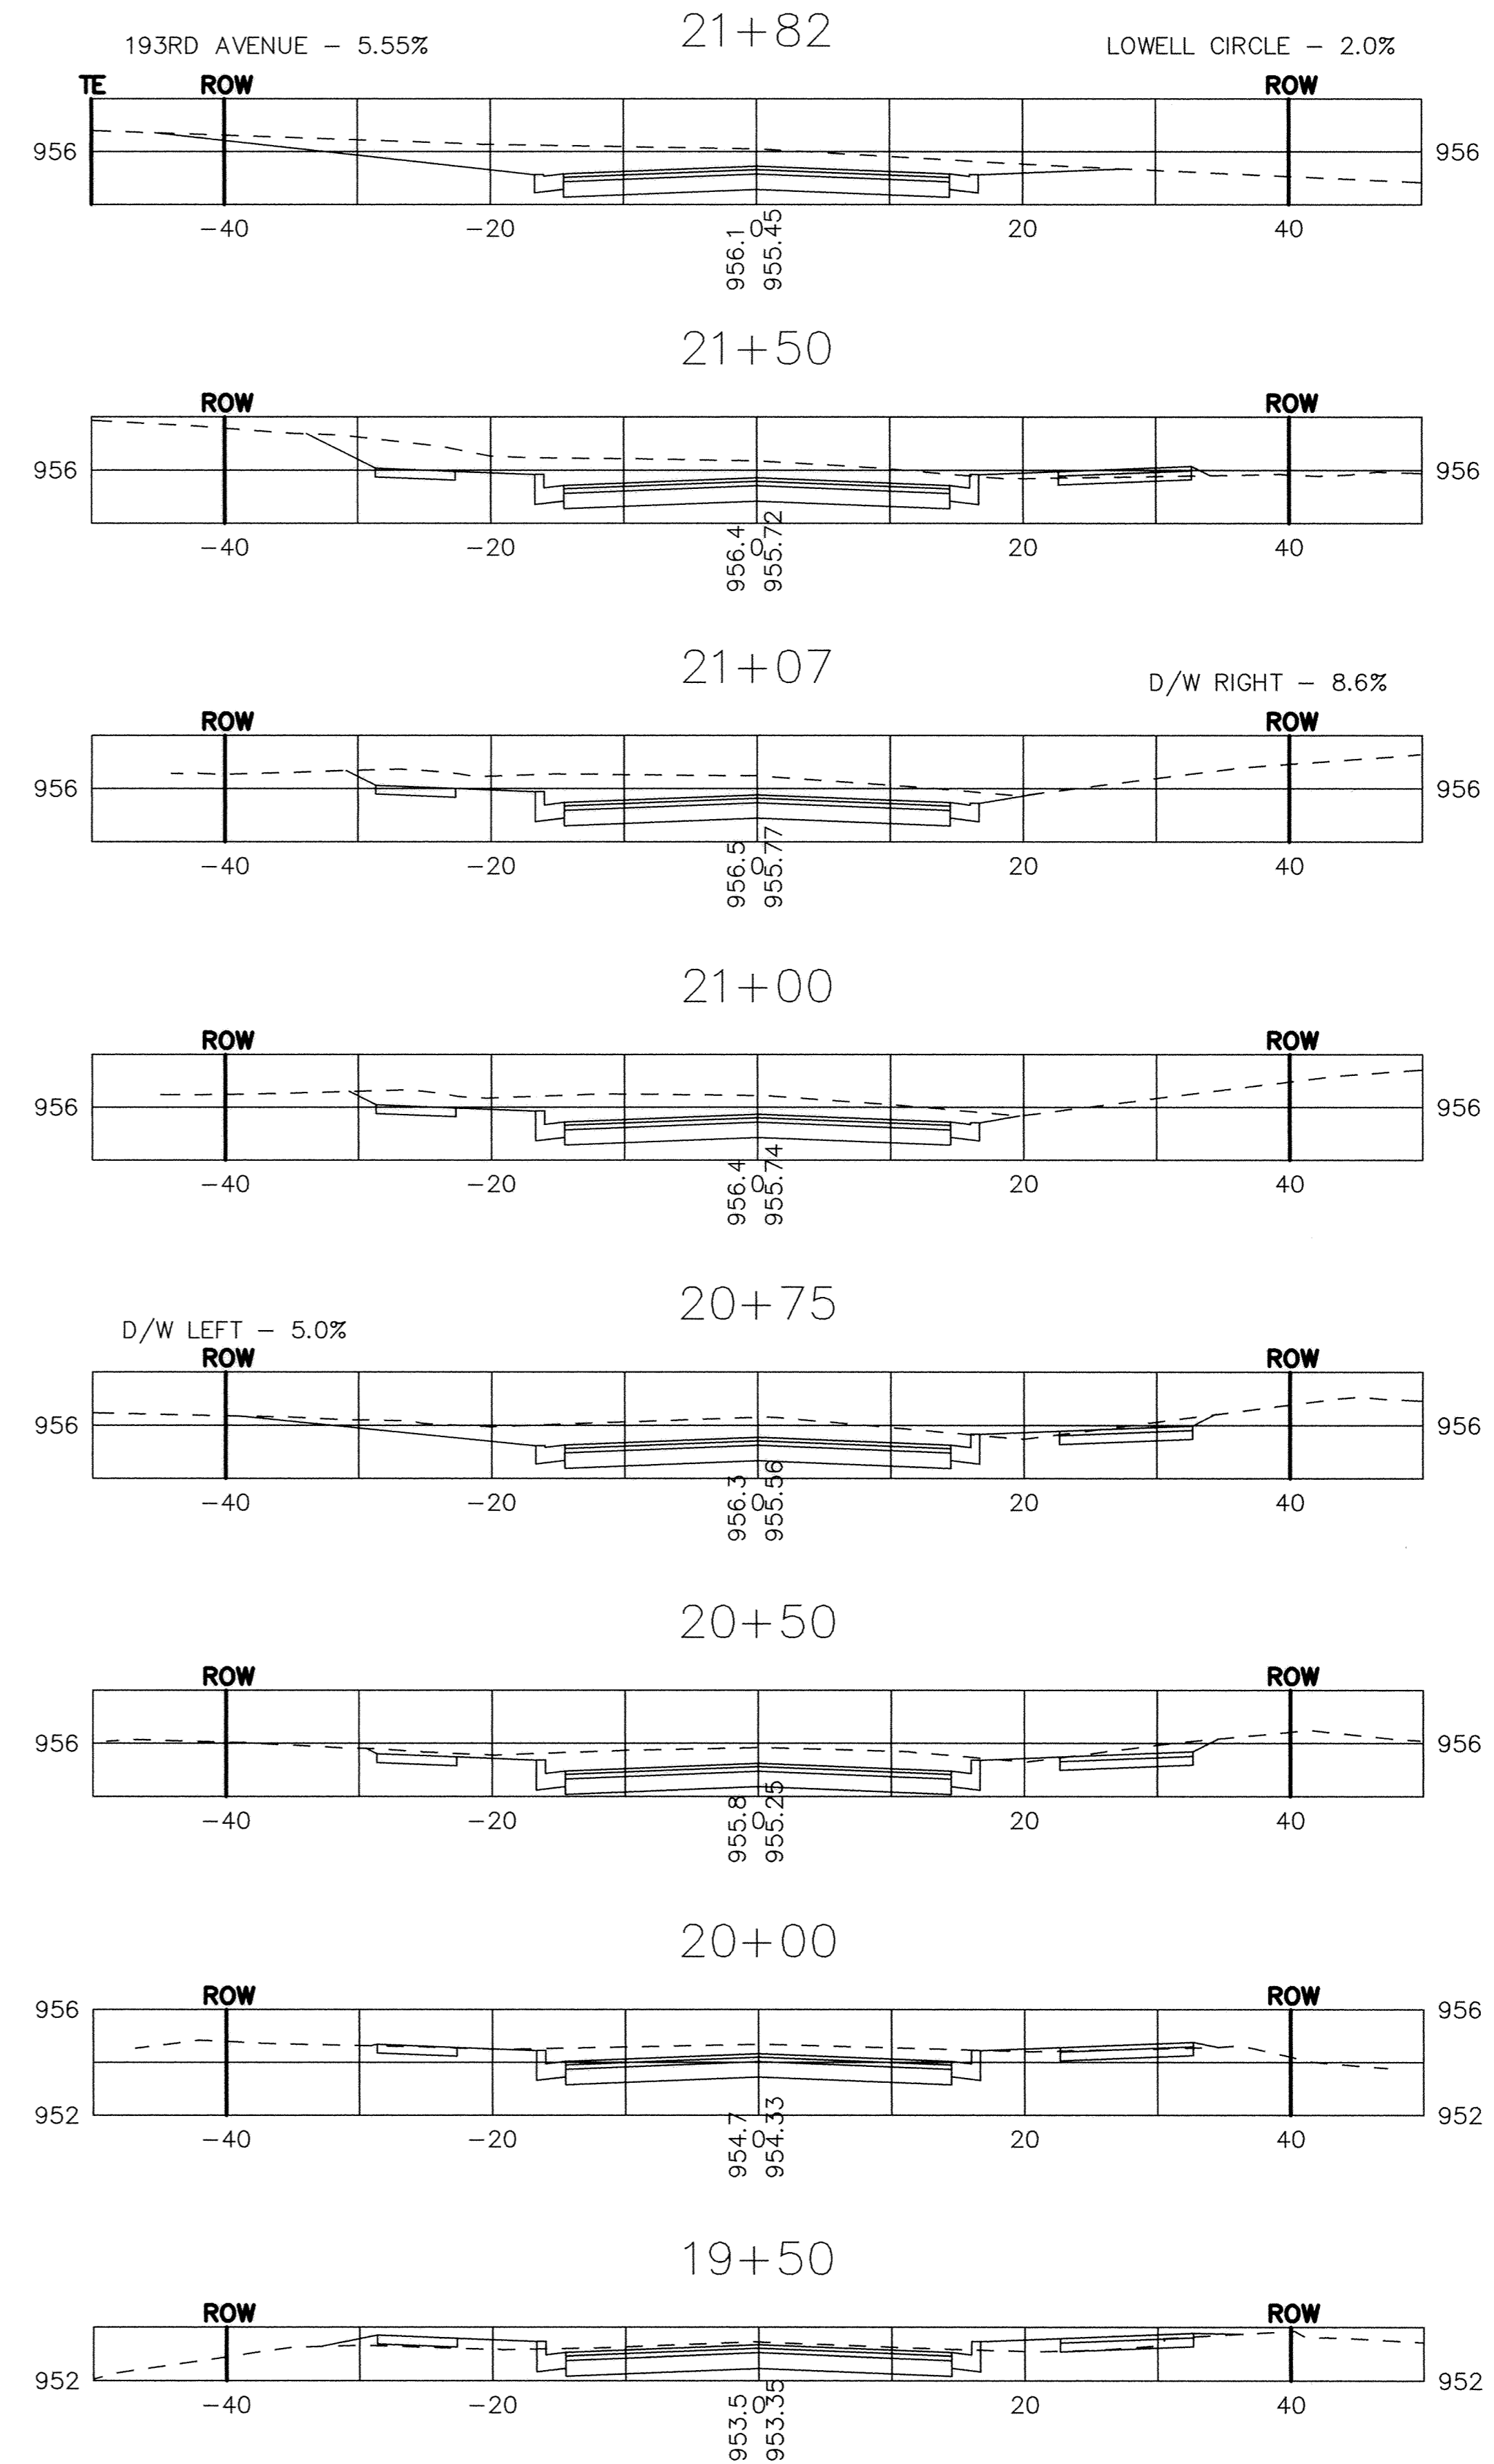


HIGHLAND ROAD

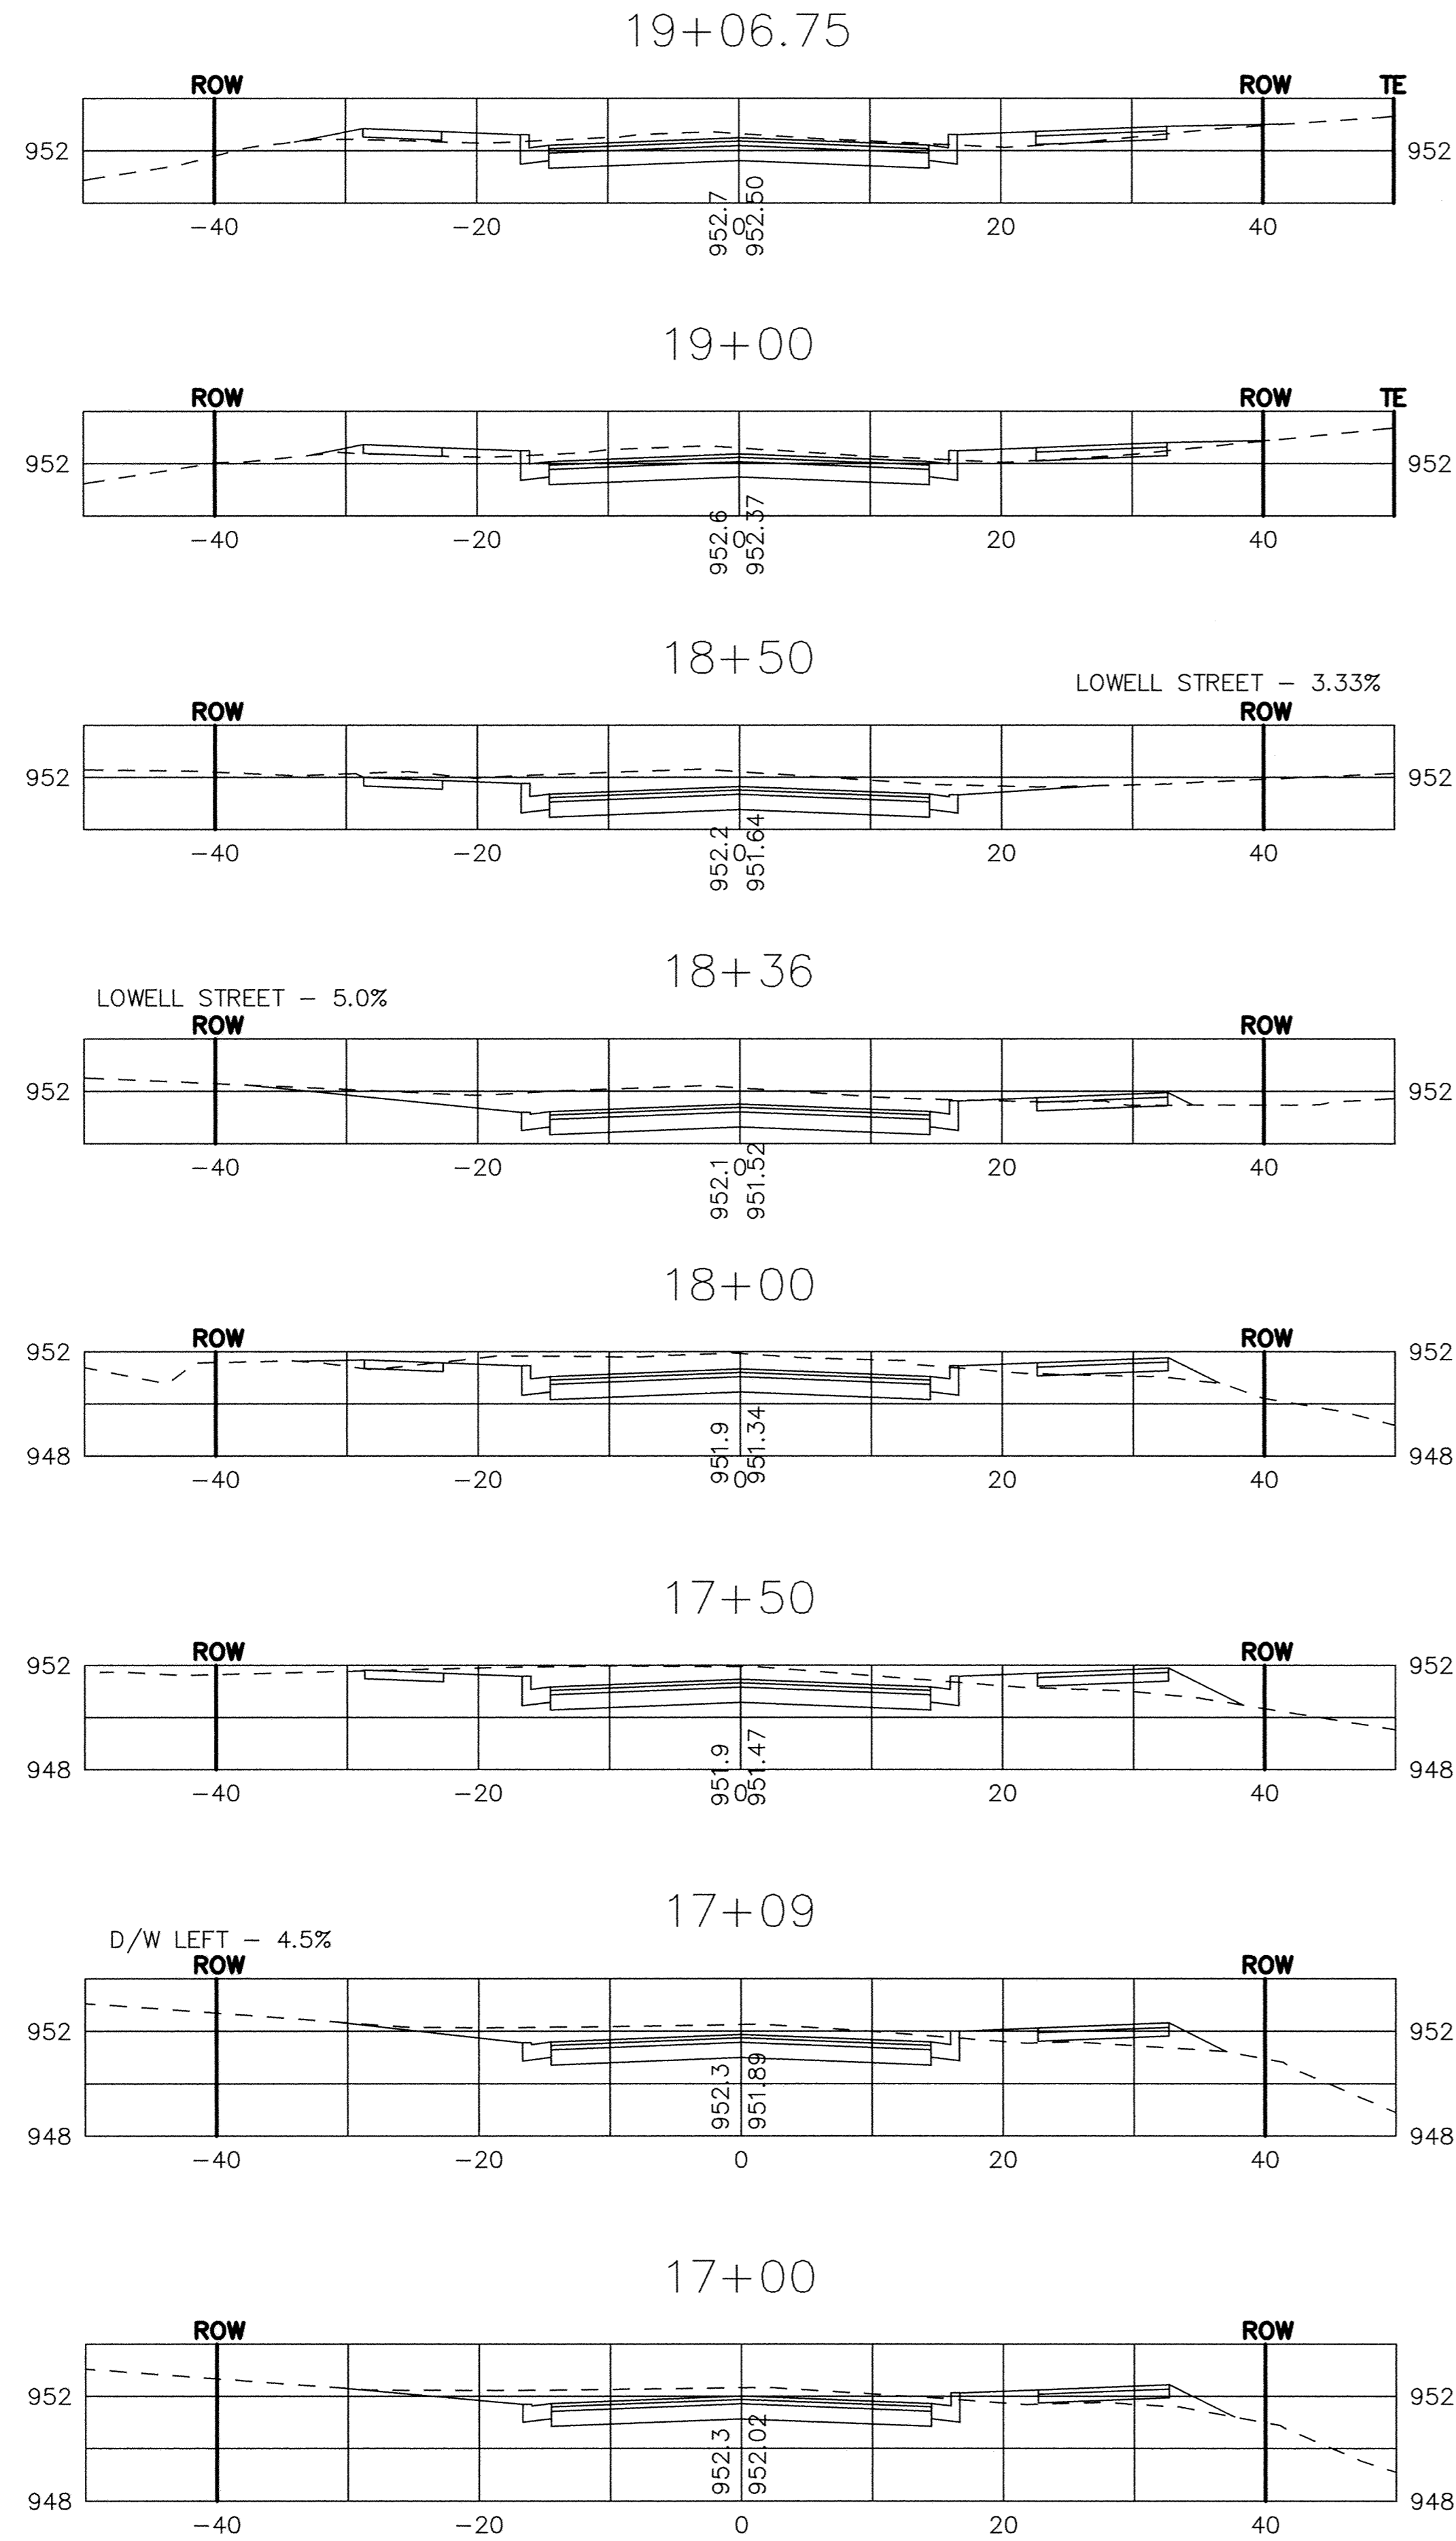

REVISIONS	NO.	DATE	BY	DESCRIPTION

I HEREBY CERTIFY THAT THIS PLAN, SPECIFICATION, OR REPORT WAS PREPARED BY ME OR UNDER MY DIRECT SUPERVISION AND THAT I AM A DULY LICENSED PROFESSIONAL ENGINEER UNDER THE LAWS OF THE STATE OF MINNESOTA.

SAP 204-137-001
 DATE 05-02-2006
 LIC. NO. 15316

RECORD PLAN
HIGHLAND ROAD IMPROVEMENTS
CROSS SECTIONS

DRAWN BY: NAB
 CHECKED BY: KJT
 DESIGNED BY: KJT
 JOB NO. 226068D