


HIGHLAND ROAD

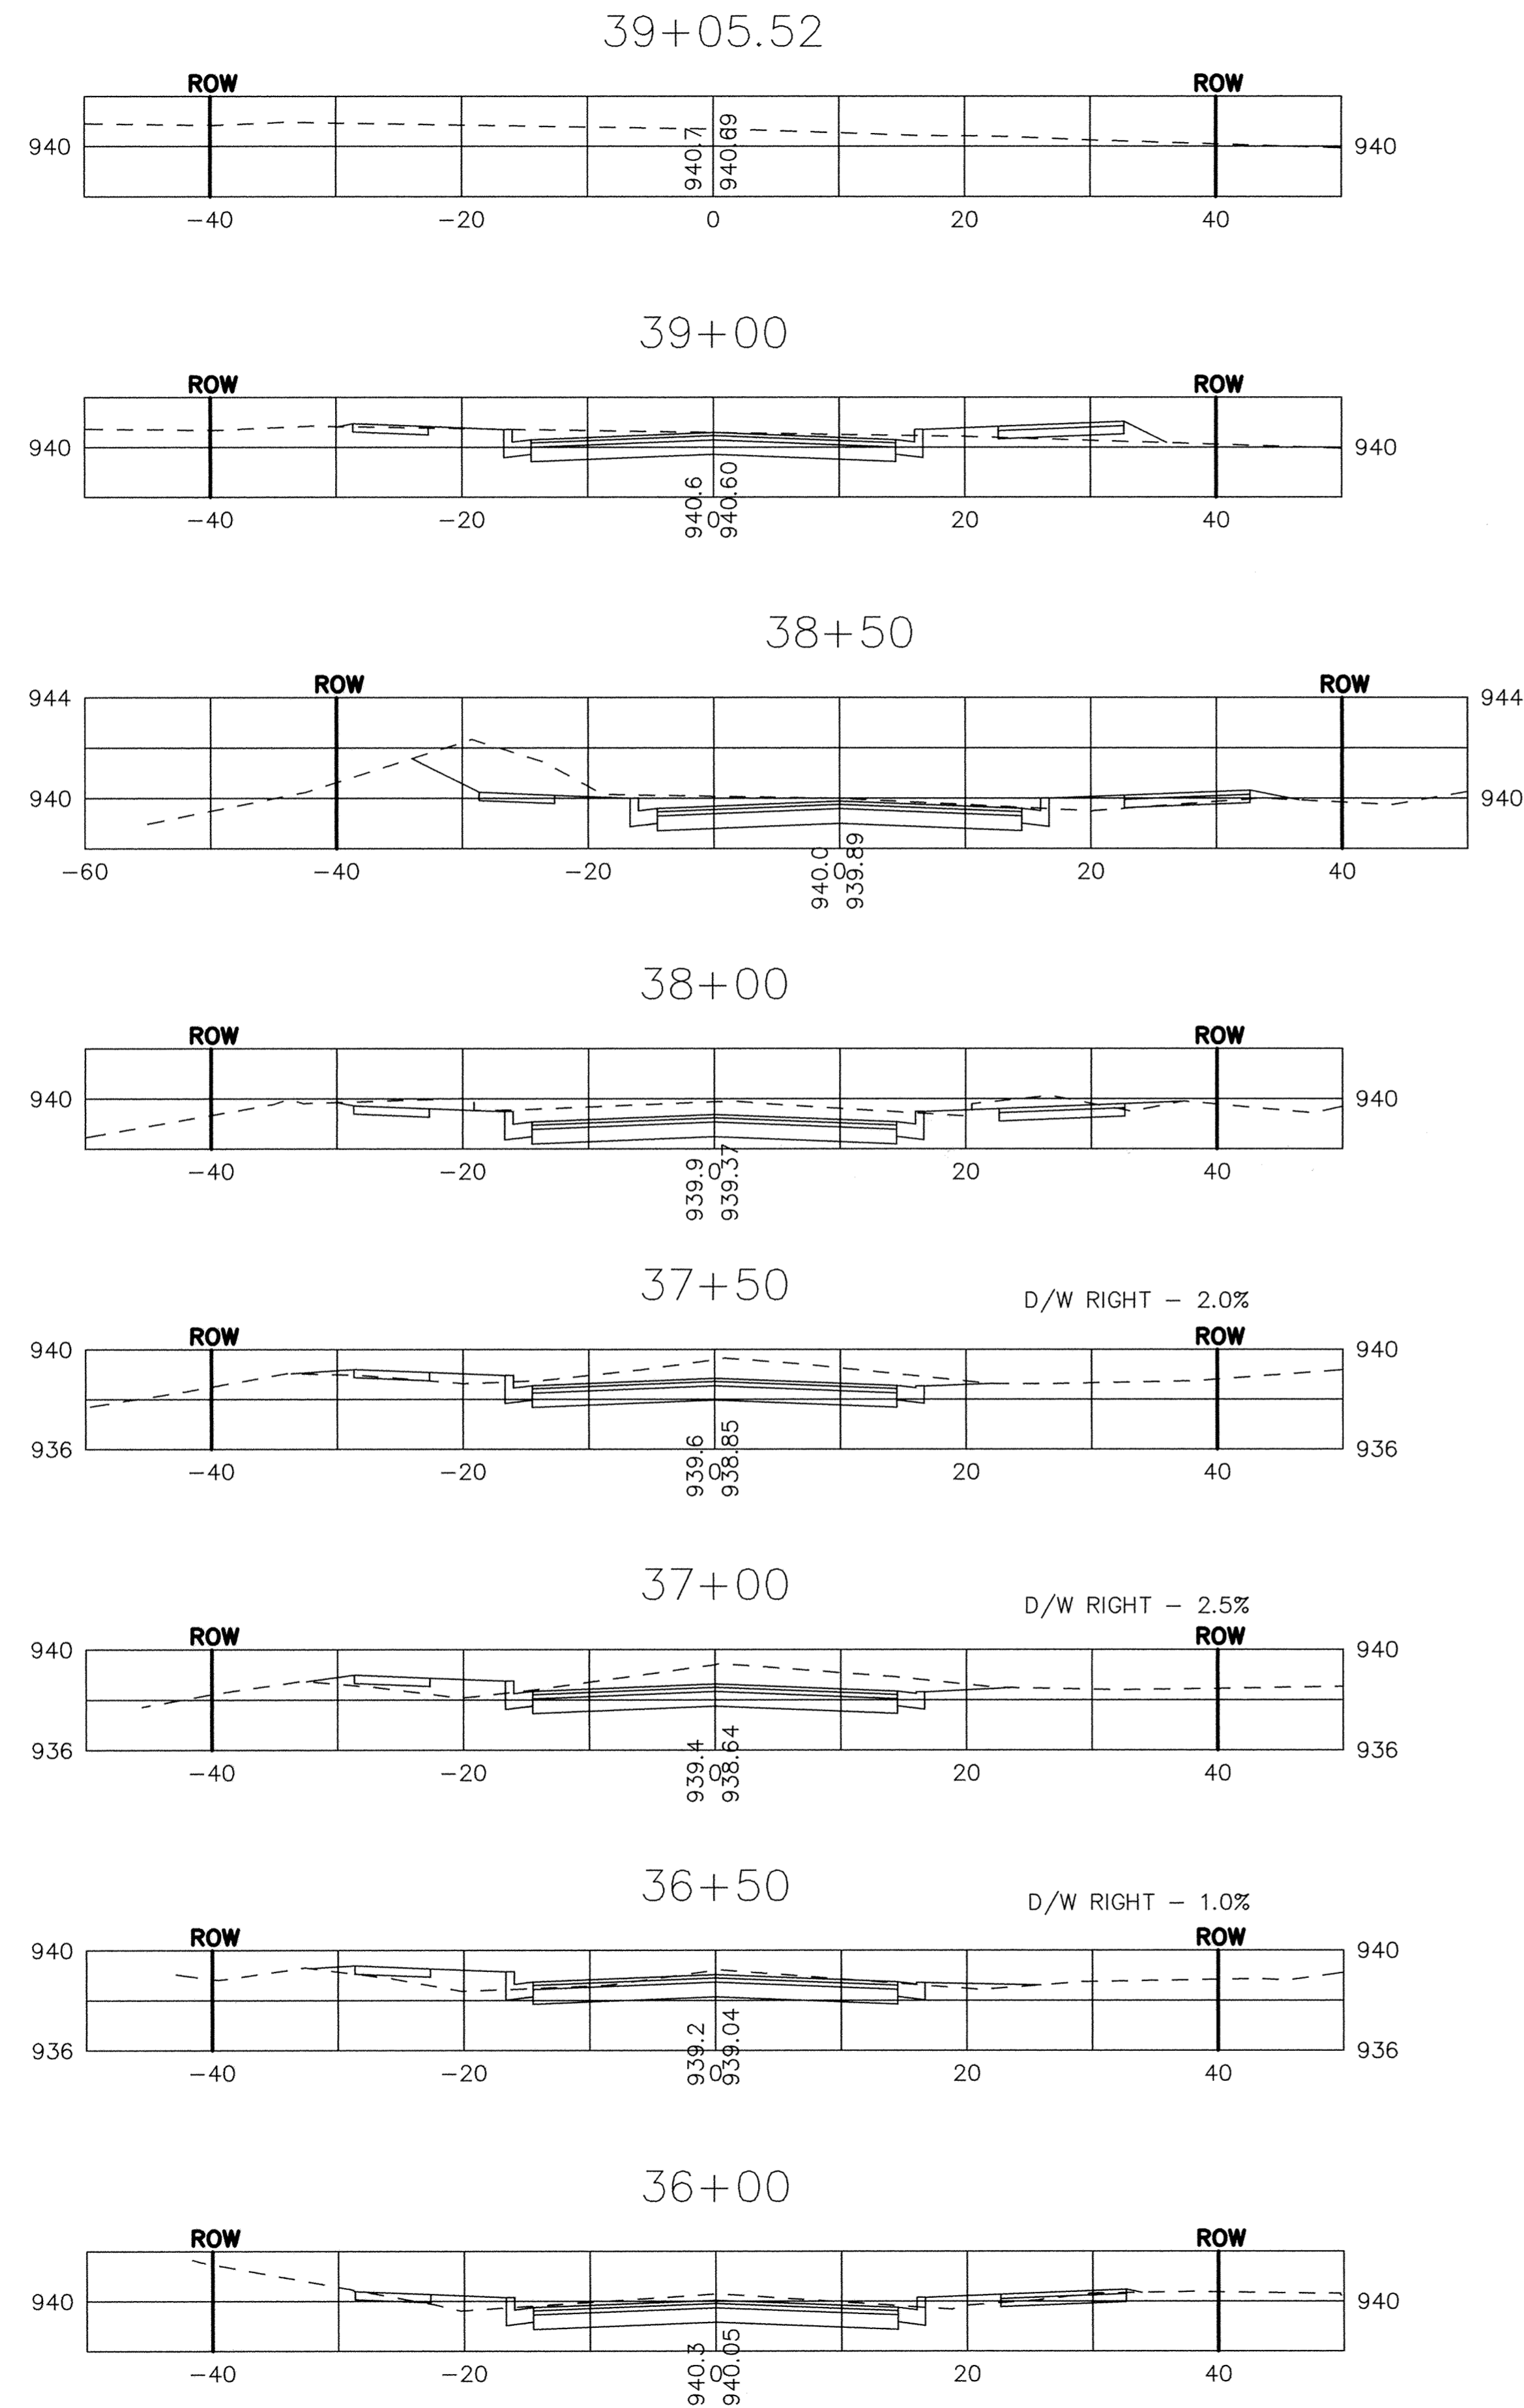

REVISIONS	
NO.	DESCRIPTION

I HEREBY CERTIFY THAT THIS PLAN, SPECIFICATION, OR REPORT WAS PREPARED BY ME OR UNDER MY DIRECT SUPERVISION AND THAT I AM A LICENSED PROFESSIONAL ENGINEER UNDER THE LAWS OF THE STATE OF MINNESOTA.

DATE 05-02-2006 LIC. NO. 15316

SAP 204-137-001
 RECORD PLAN
HIGHLAND ROAD IMPROVEMENTS
 CROSS SECTIONS
 36+00 TO 39+05

BDM
 CONSULTING ENGINEERS, PLC
 Engineers and Surveyors
 4175 Lovell Road, Suite 112
 Lexington, MN 55014
 Phone: (763) 786-4570
 Fax: (763) 786-4574
 bdmce.com

DRAWN BY: NAB
 CHECKED BY: KJT
 DESIGNED BY: KJT
 JOB NO. 226068D

SHEET **46** SHEETS **55**

DRAWING NUMBER

DRAWING NUMBER

DRAWING NUMBER

DRAWING NUMBER
 HIGHLAND 06
 46

SAPCO PRODUCTS • NEW HOPE, MINNESOTA
 REGISTERED BY PART NUMBER 8552

SAPCO PRODUCTS • NEW HOPE, MINNESOTA
 REGISTERED BY PART NUMBER 8552

SAPCO PRODUCTS • NEW HOPE, MINNESOTA
 REGISTERED BY PART NUMBER 8552

SAPCO PRODUCTS • NEW HOPE, MINNESOTA
 REGISTERED BY PART NUMBER 8552