

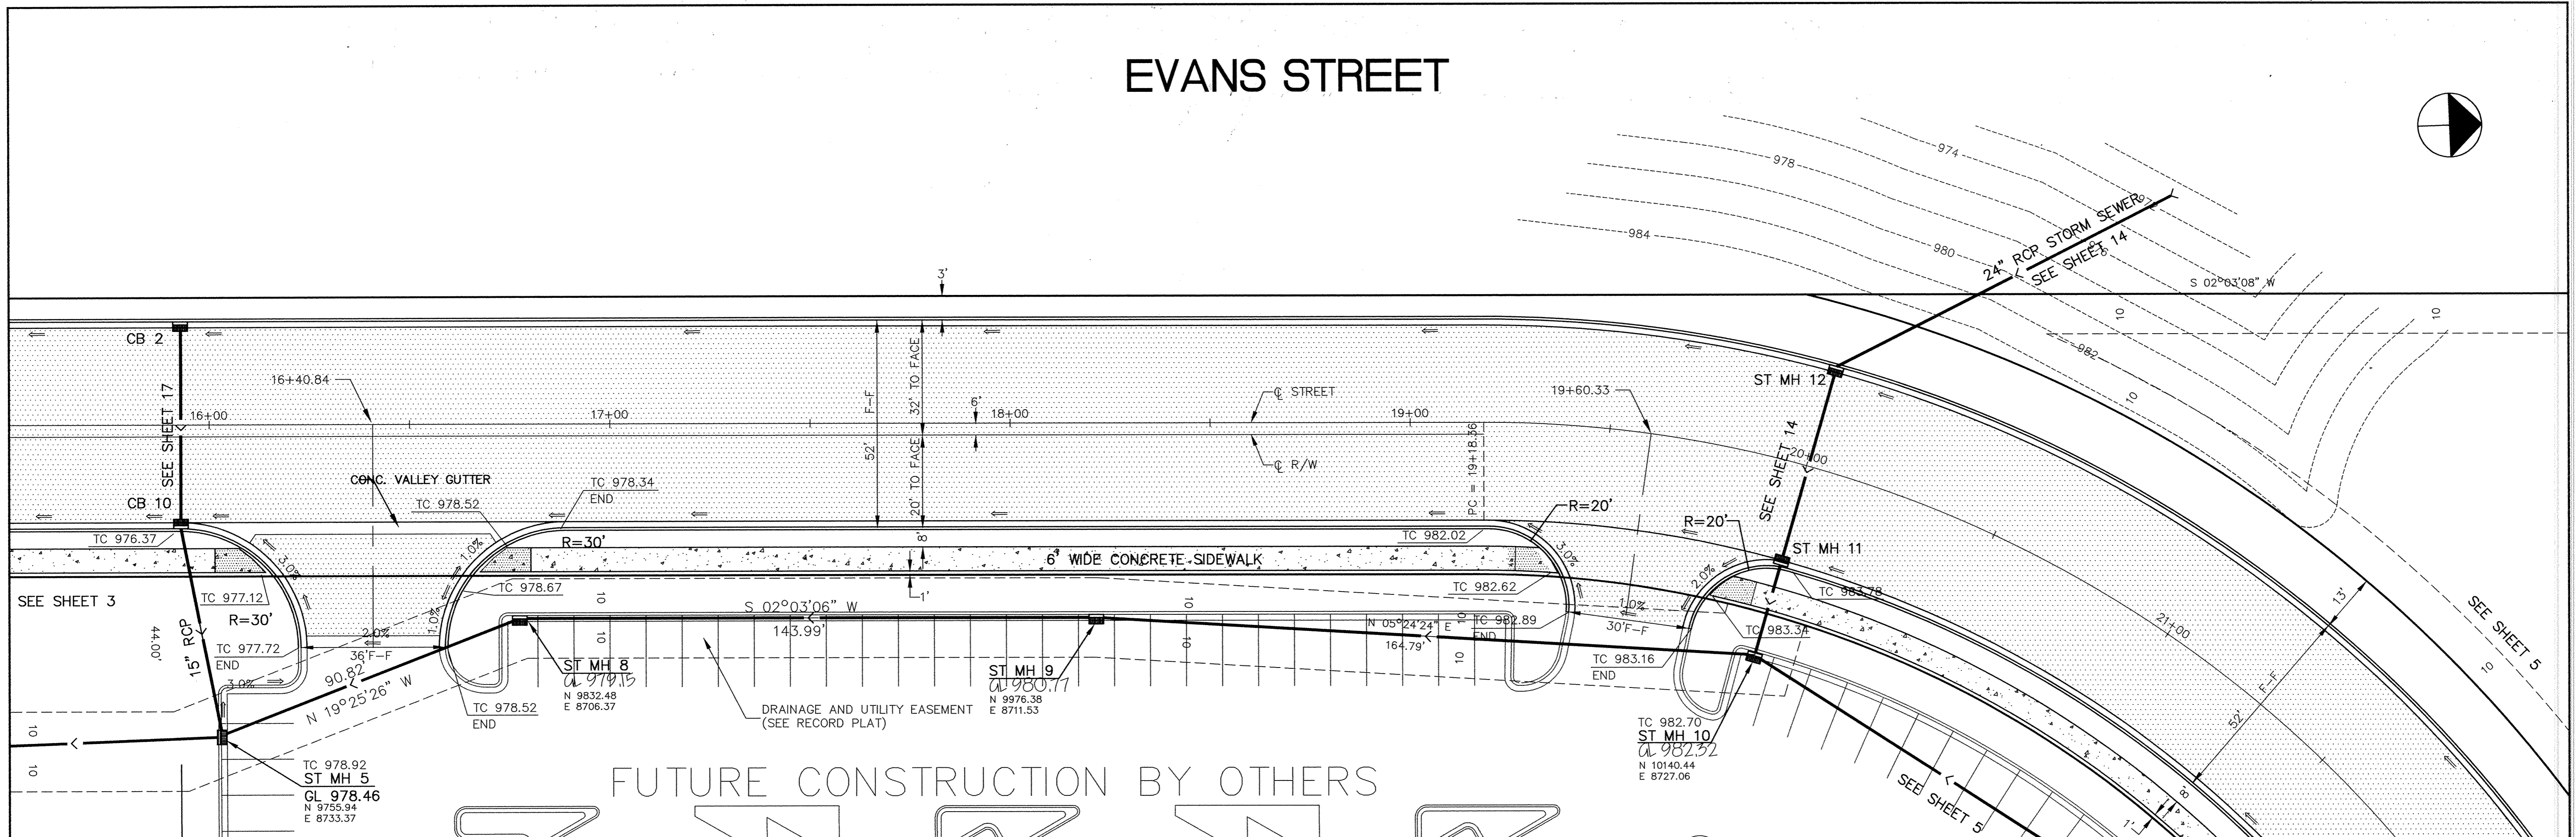


EVANS STREET

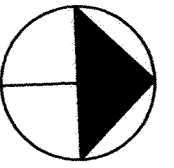

FUTURE CONSTRUCTION BY OTHERS

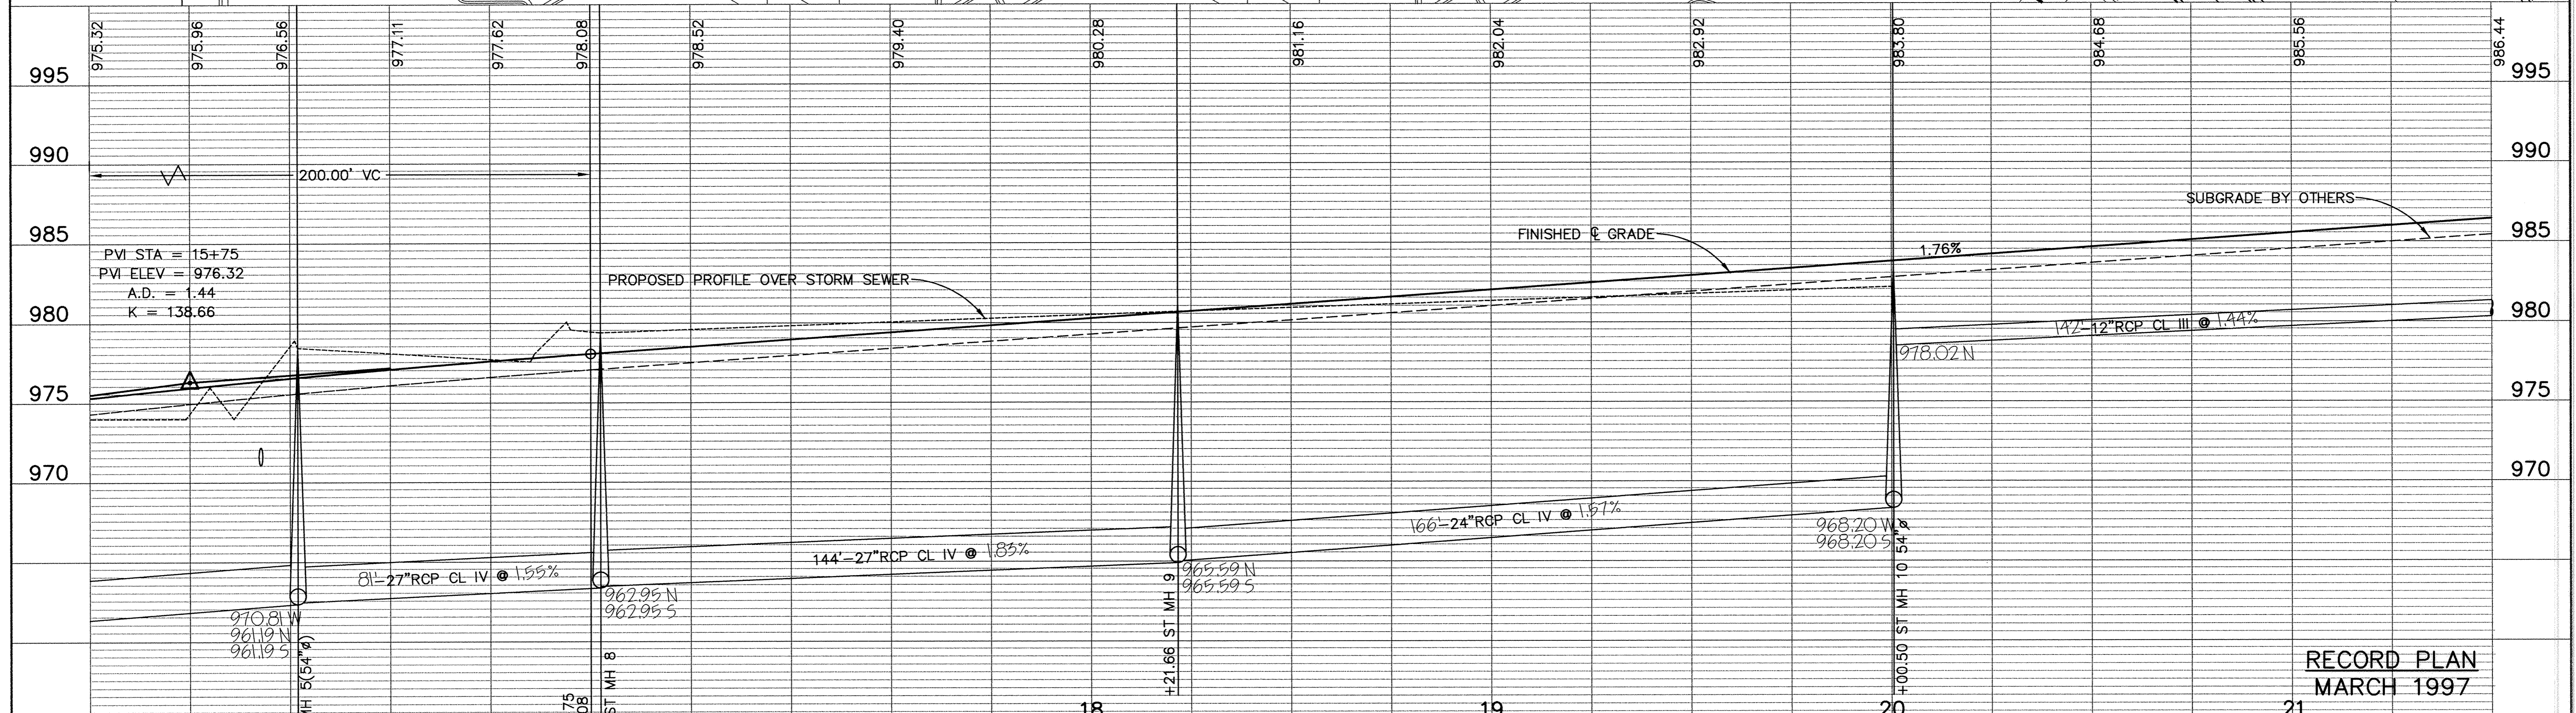

RECORD PLAN
MARCH 1997

I HEREBY CERTIFY THAT THIS PLAN, SPECIFICATION, OR REPORT WAS PREPARED BY ME OR UNDER MY DIRECT SUPERVISION AND THAT I AM A DULY REGISTERED PROFESSIONAL ENGINEER UNDER THE LAWS OF THE STATE OF MINNESOTA.
 DATE 4/15/96 REG. NO. 15316



1326 ENERGY PARK DRIVE
ST. PAUL, MINNESOTA 55108
(612) 644-4389

REVISIONS	DATE	DESCRIPTION

DESIGNED <u>SEF</u>	CITY OF ELK RIVER HILLSIDE CROSSING II STORM SEWER AND STREET CONSTRUCTION EVANS STREET	15+50 TO 21+50
CHECKED <u> </u>		
DRAWN <u>EY</u>		
GRAPHIC SCALE 0 20 0 5	DATE <u>APRIL 1996</u>	SHEET <u>4</u> OF <u>31</u> SHEETS
	PROJECT NO. <u>230-297</u>	

1209