
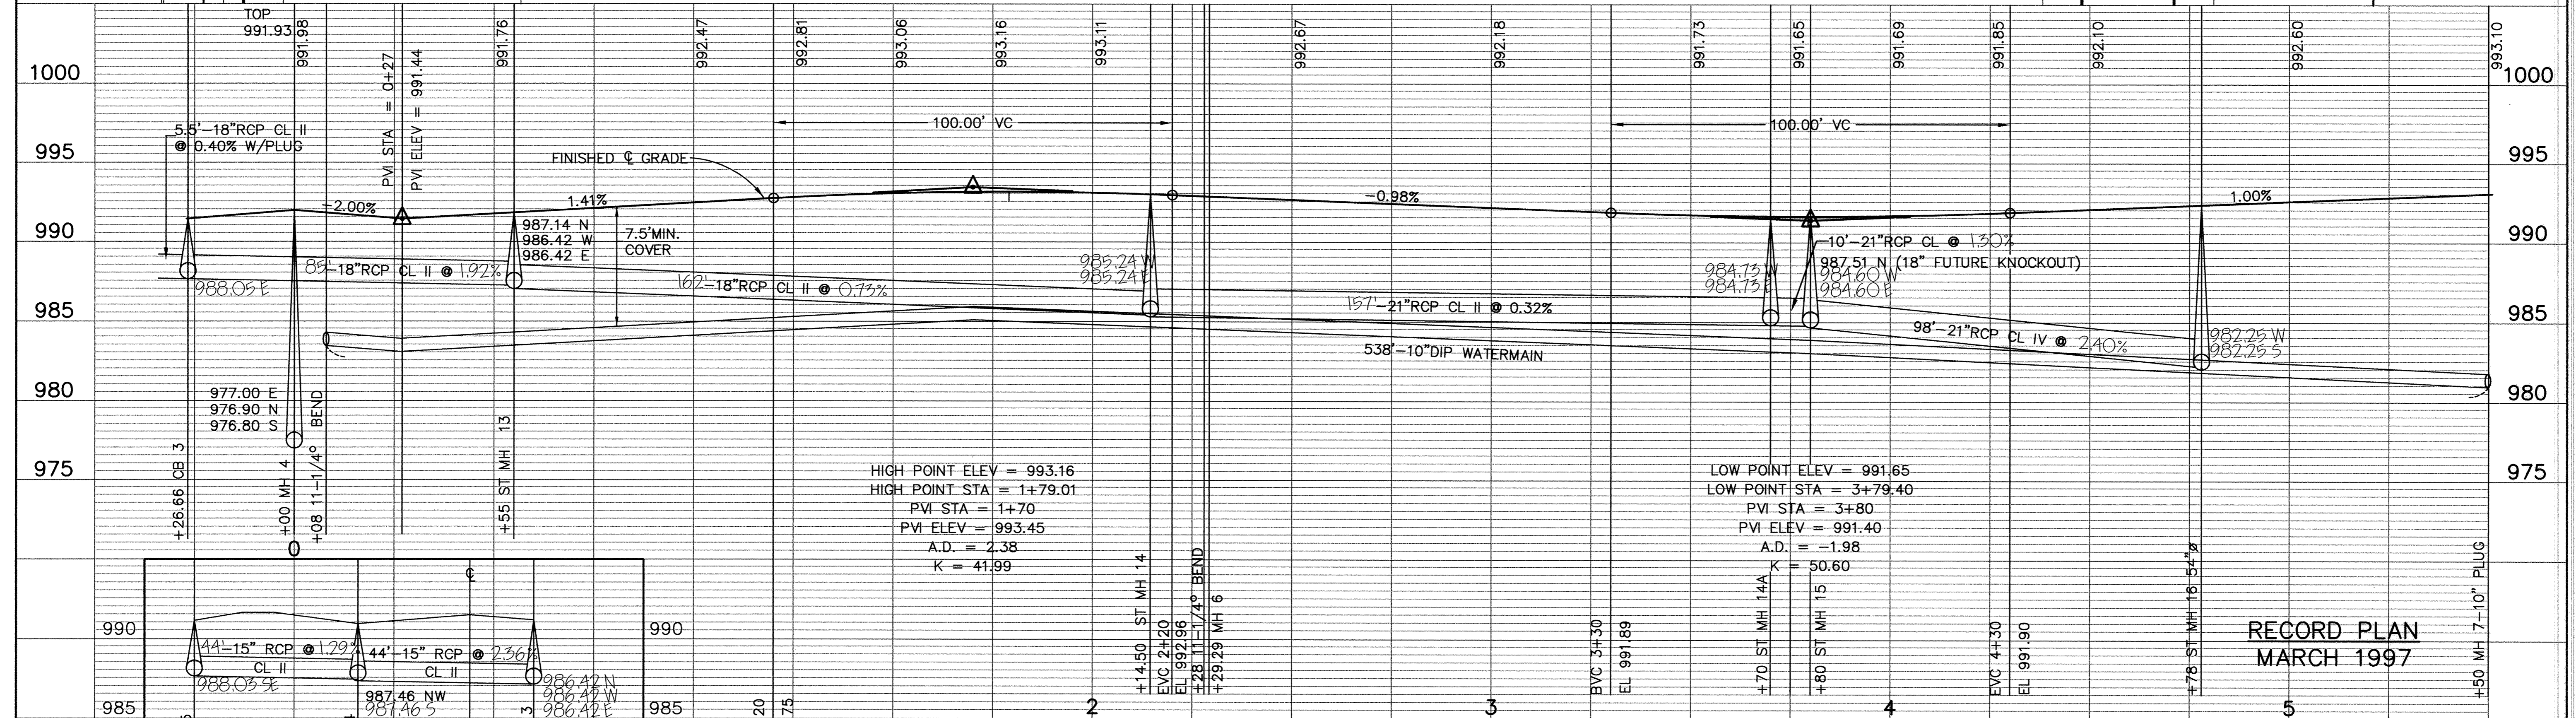


SAICO PRODUCTS • NEW HOPE, MINNESOTA
REORDER BY PART NUMBER 6552
SAICO PRODUCTS • NEW HOPE, MINNESOTA
REORDER BY PART NUMBER 6552
SAICO PRODUCTS • NEW HOPE, MINNESOTA
REORDER BY PART NUMBER 6552
SAICO PRODUCTS • NEW HOPE, MINNESOTA
REORDER BY PART NUMBER 6552

196TH AVENUE N.W.

FUTURE CONSTRUCTION BY OTHERS

FUTURE CONSTRUCTION

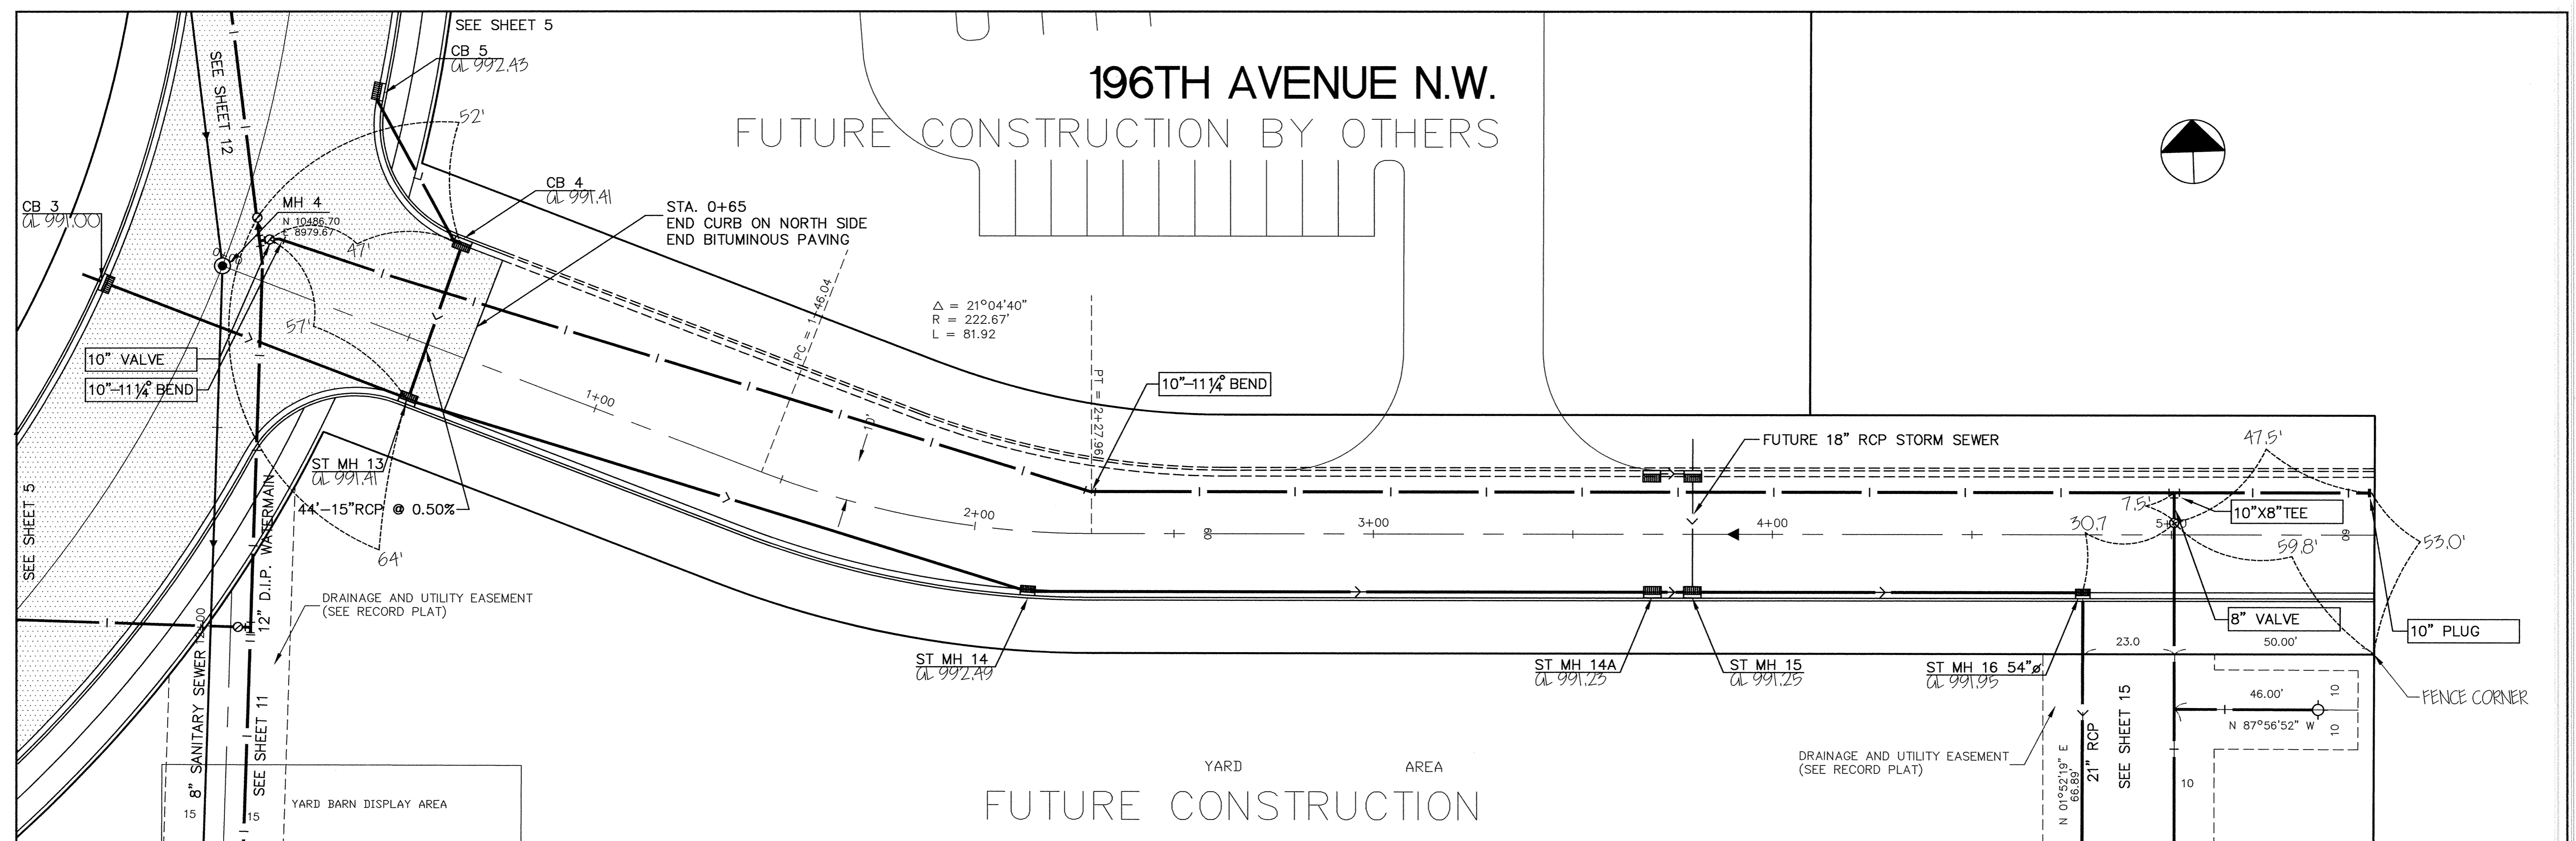

RECORD PLAN
MARCH 1997

I HEREBY CERTIFY THAT THIS PLAN, SPECIFICATION, OR REPORT WAS PREPARED BY ME OR UNDER MY DIRECT SUPERVISION AND THAT I AM A DULY REGISTERED PROFESSIONAL ENGINEER UNDER THE LAWS OF THE STATE OF MINNESOTA.

Elmer J. Mann
DATE 4/15/96 REG. NO. 15316



1326 ENERGY PARK DRIVE
ST. PAUL, MINNESOTA 55108
(612) 644-4389

DATE	DESCRIPTION	DESIGNED	SEF
		CHECKED	
		DRAWN	EY
		GRAPHIC SCALE	
		0 20	
		VERT. 5	

CITY OF ELK RIVER
HILLSIDE CROSSING II
SANITARY SEWER, WATERMAIN, STORM SEWER, STREET CONSTRUCTION
196TH AVENUE N.W.
0+00 TO 5+50.92

DATE APRIL 1996 SHEET 7 OF 31 SHEETS PROJECT NO. 230-297