



STATION	AREAS Square Feet		VOLUMES Cubic Yards		CUMULATIVE VOLUMES Cubic Yards	
	CUT	FILL	CUT	FILL	CUT	FILL
0+00	0.00	0.00	0.00	0.00	0.00	0.00
0+12	0.00	0.00	123.70	0.04	123.70	0.04
0+50	175.79	0.06	252.01	0.03	375.71	0.07
0+78	310.22	0.00	209.49	0.00	585.20	0.07
0+94	396.80	0.00	88.51	0.00	673.71	0.07
1+00	399.80	0.00	790.40	0.00	1464.11	0.07
1+50	453.83	0.00	406.99	0.00	1871.10	0.07
1+72	545.15	0.00	229.65	0.00	2100.75	0.07
1+83	582.22	0.00	368.53	0.00	2469.28	0.07
2+00	588.41	0.00	1005.18	0.00	3474.46	0.07
2+50	497.19	0.00	166.47	0.00	3640.93	0.07
2+60.10	392.88	0.00	417.32	0.00	4058.26	0.07
2+97	217.84	0.00	23.96	0.00	4082.21	0.07
3+00	213.37	0.00	70.83	0.00	4153.04	0.07
3+09	211.61	0.00	181.19	0.81	4334.23	0.88
3+41	94.15	1.36	30.99	0.53	4365.23	1.41
3+50	91.81	1.82	62.54	1.60	4427.77	3.01
3+69	85.94	2.72	65.29	1.70	4493.06	4.71
3+90	81.94	1.66	30.74	1.14	4523.80	5.85
4+00	84.04	4.47	97.39	7.42	4621.18	13.26
4+41	44.22	5.29	14.55	1.55	4635.73	14.82
4+50	43.07	4.03	18.48	1.47	4654.21	16.29
4+61	47.64	3.20	59.46	7.86	4713.67	24.15
5+00	34.69	7.68	11.87	3.39	4725.54	27.54
5+10	29.43	10.62	42.91	10.56	4768.45	38.10
5+50	28.50	3.64	0.00	0.00	4768.45	38.10

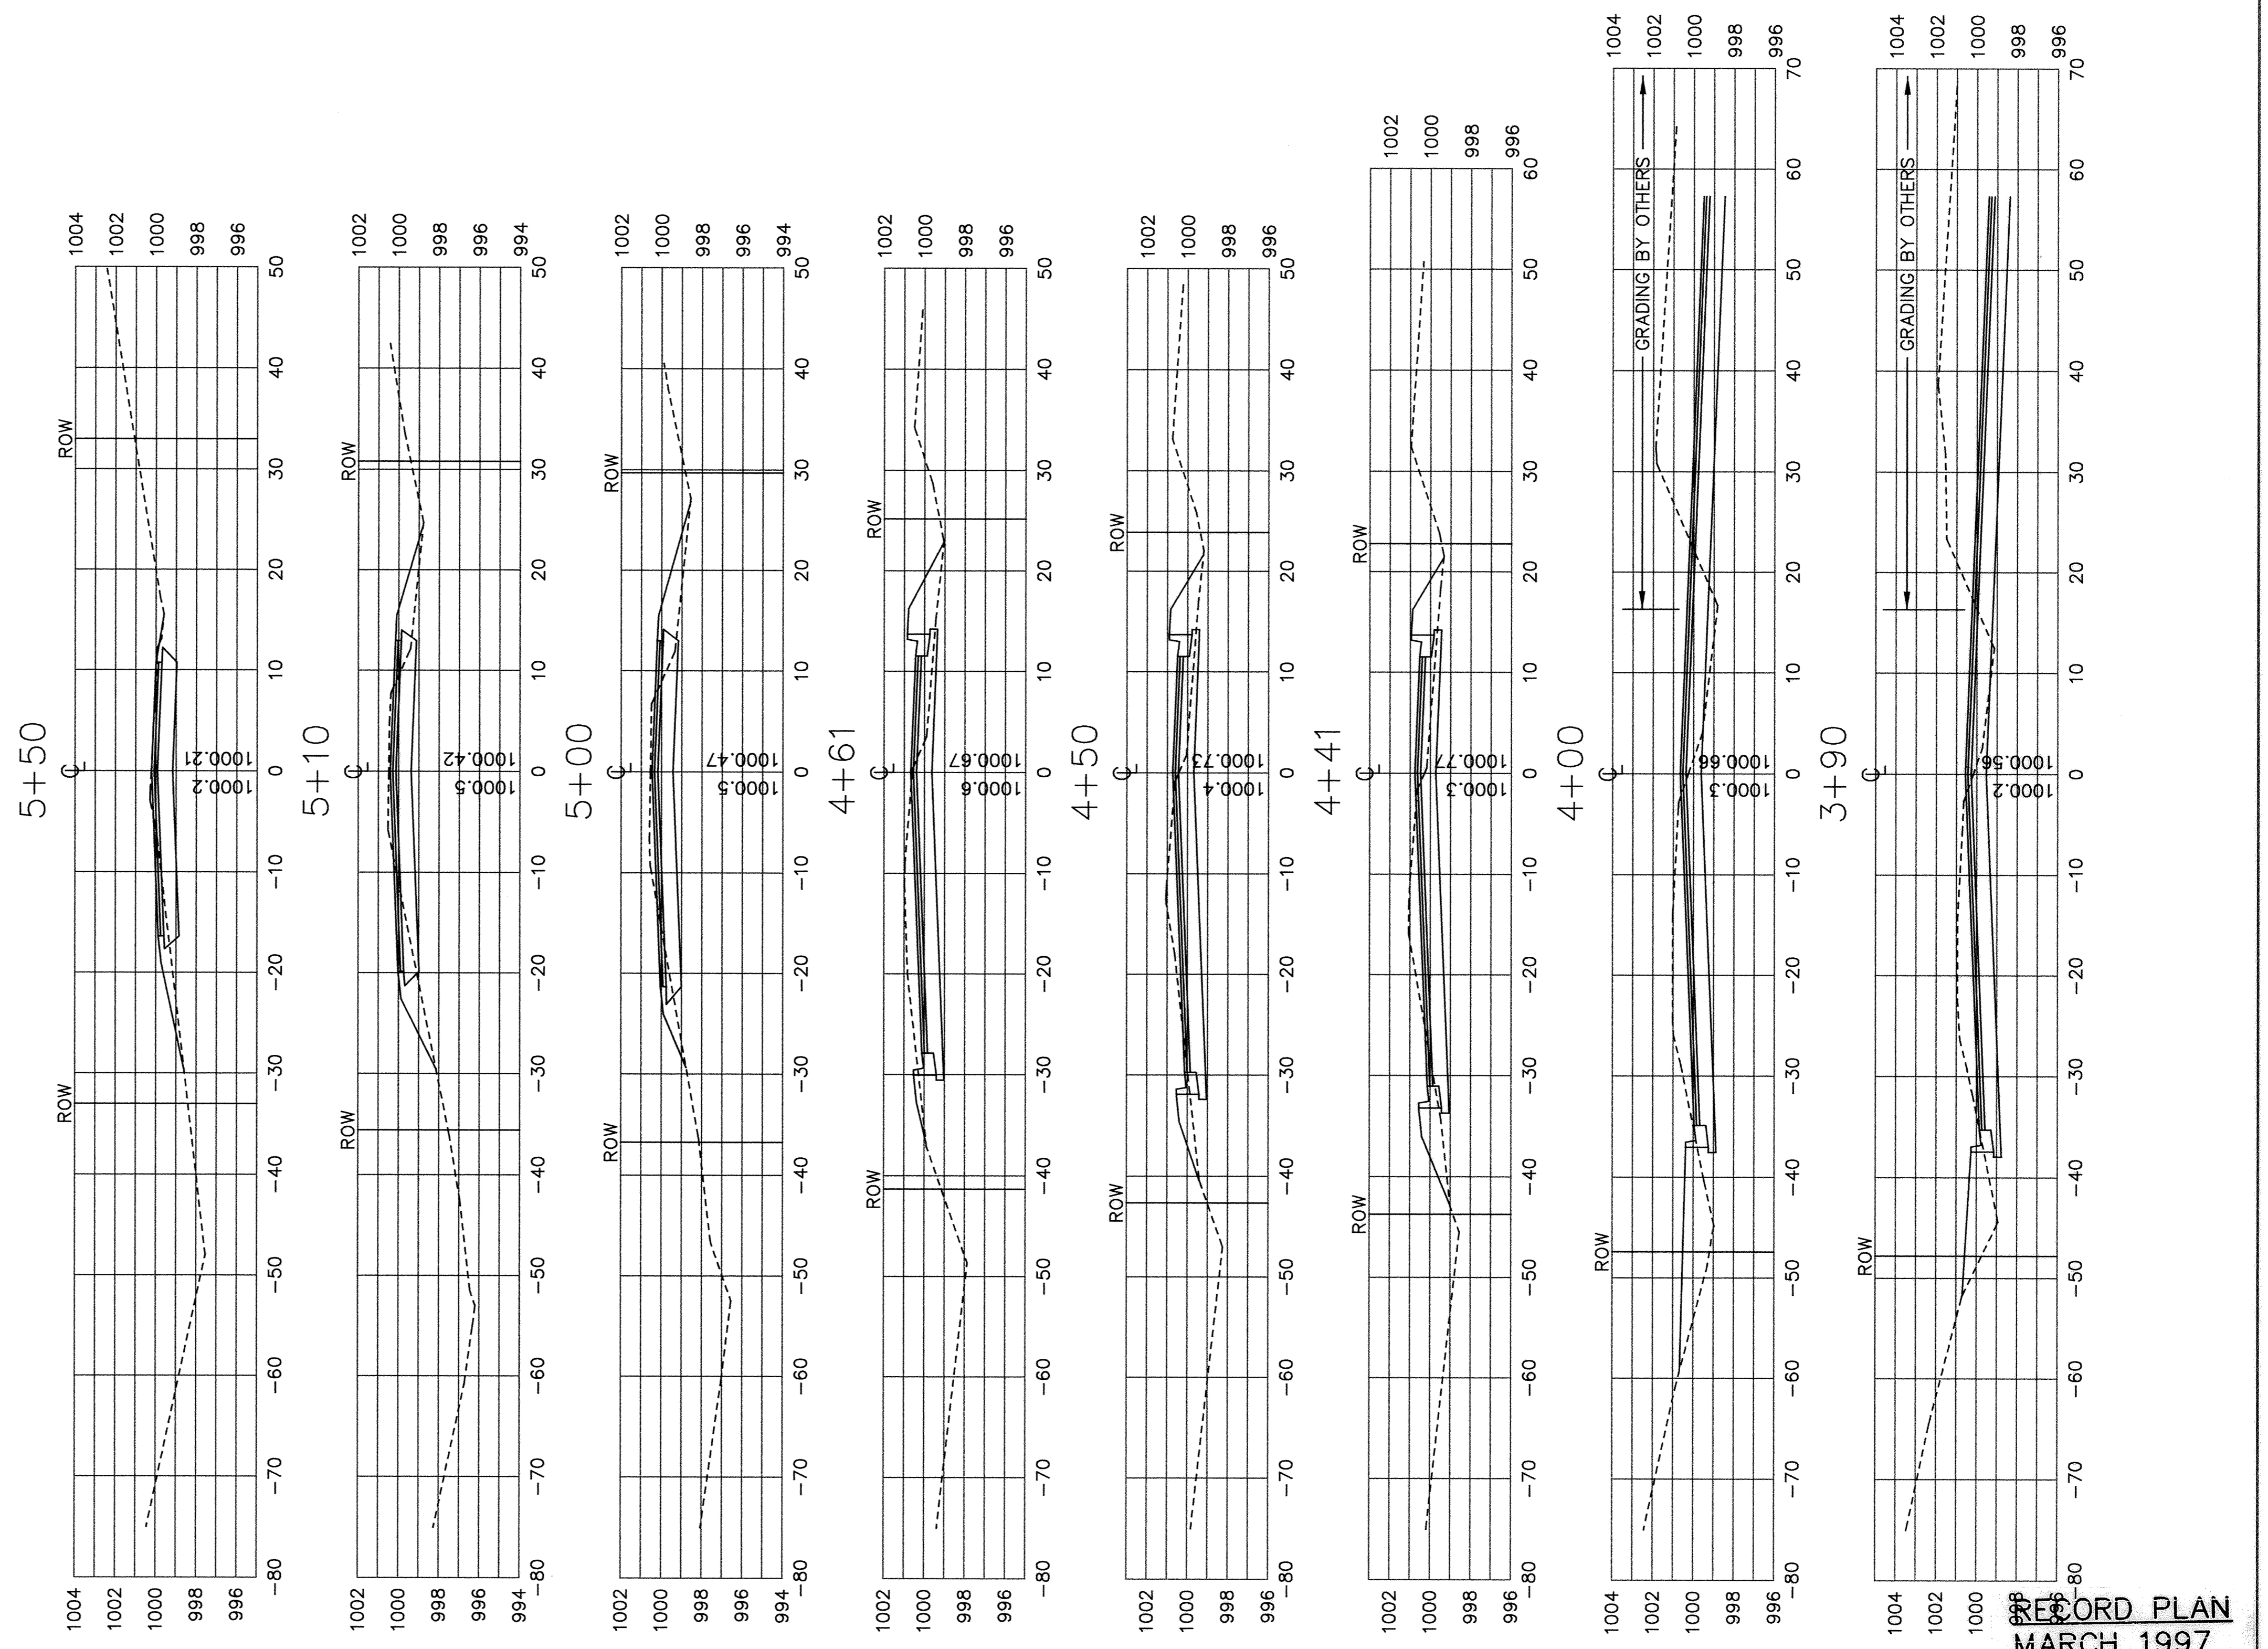

RECORD PLAN
MARCH 1997

I HEREBY CERTIFY THAT THIS PLAN, SPECIFICATION, OR REPORT WAS PREPARED BY ME OR UNDER MY DIRECT SUPERVISION AND THAT I AM A DULY REGISTERED PROFESSIONAL ENGINEER UNDER THE LAWS OF THE STATE OF MINNESOTA.
Ken Mauer
DATE 4/15/96 REG. NO. 15316

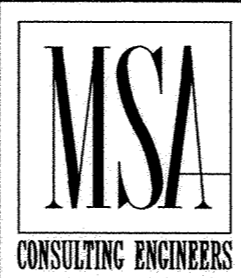

1326 ENERGY PARK DRIVE
ST. PAUL, MINNESOTA 55108
(612) 644-4389

REVISIONS	DATE	DESCRIPTION	DESIGNED	CHECKED	DRAWN

GRAPHIC SCALE
0 10 5
VERT. 5

CITY OF ELK RIVER
HILLSIDE CROSSING II
STREET CONSTRUCTION
197TH AVENUE
CROSS SECTIONS
3+90 TO 5+50

DATE APRIL 1996 SHEET 24 OF 31 SHEETS PROJECT NO. 230-297