













SDCO PRODUCTS • NEW HARBOR, MINNESOTA
REVISION BY PART NUMBER 8032

SDCO PRODUCTS • NEW HARBOR, MINNESOTA
REVISION BY PART NUMBER 8032

SDCO PRODUCTS • NEW HARBOR, MINNESOTA
REVISION BY PART NUMBER 8032

SDCO PRODUCTS • NEW HARBOR, MINNESOTA
REVISION BY PART NUMBER 8032

197TH AVE. WEST OF TH 169 EARTHWORK											
CUT						FILL					
STA	PLAN S.F.	AVG S.F.	DIST	C.F.	C.Y.	STA	PLAN S.F.	AVG S.F.	DIST	C.F.	C.Y.
0	0					0	0				
15	69	35	15	518	19	15	0	0	15	0	0
32	15	77	17	1301	48	32	0	0	17	0	0
50	10	20	18	360	13	50	53	27	18	477	18
100	7.5	14	50	688	25	100	23.5	38	50	1913	71
150	9.5	12	50	613	23	150	10	17	50	838	31
200	5.5	12	50	613	23	200	8.5	9	50	463	17
250	8.5	10	50	488	18	250	3.5	6	50	300	11
300	7.5	12	50	613	23	300	5.5	5	50	225	8
350	10	13	50	625	23	350	1.5	4	50	175	6
400	8	14	50	700	26	400	0	1	50	38	1
450	3.5	10	50	488	18	450	0	0	50	0	0
475	0	4	25	88	3	475	0	0	25	0	0
TOTALS					263						164

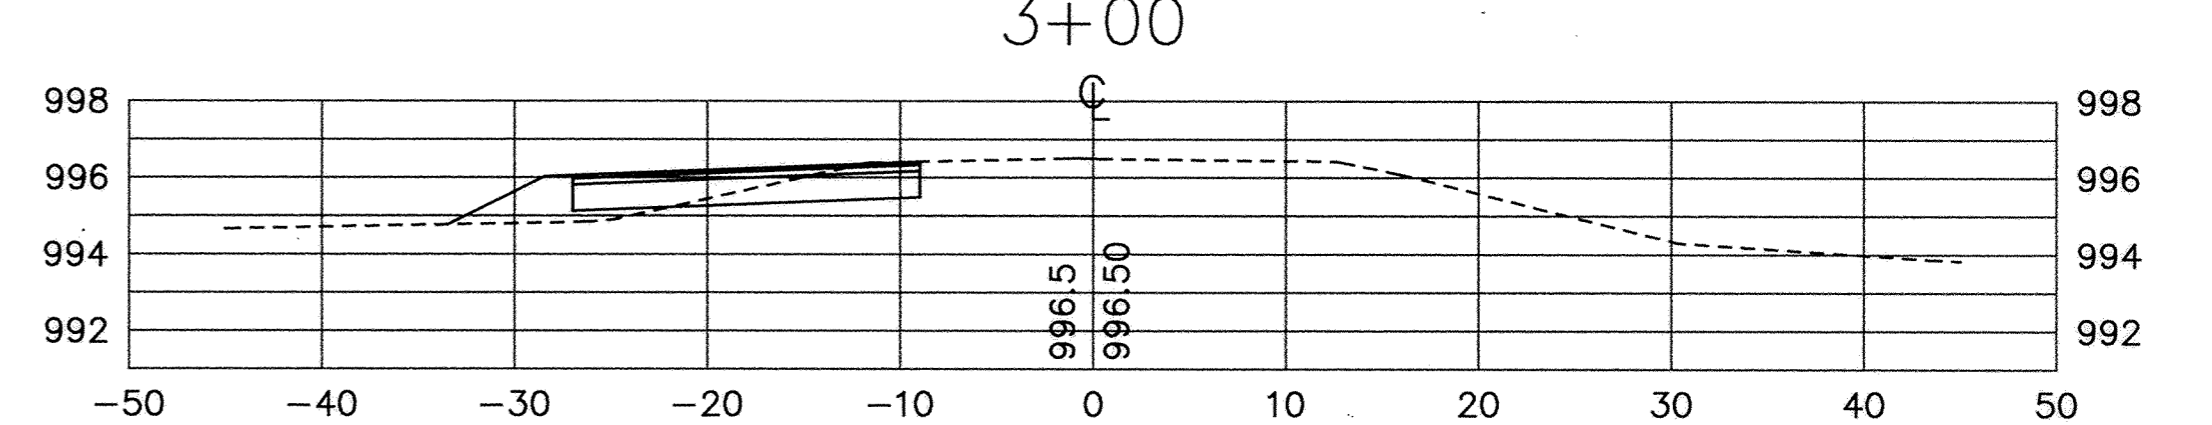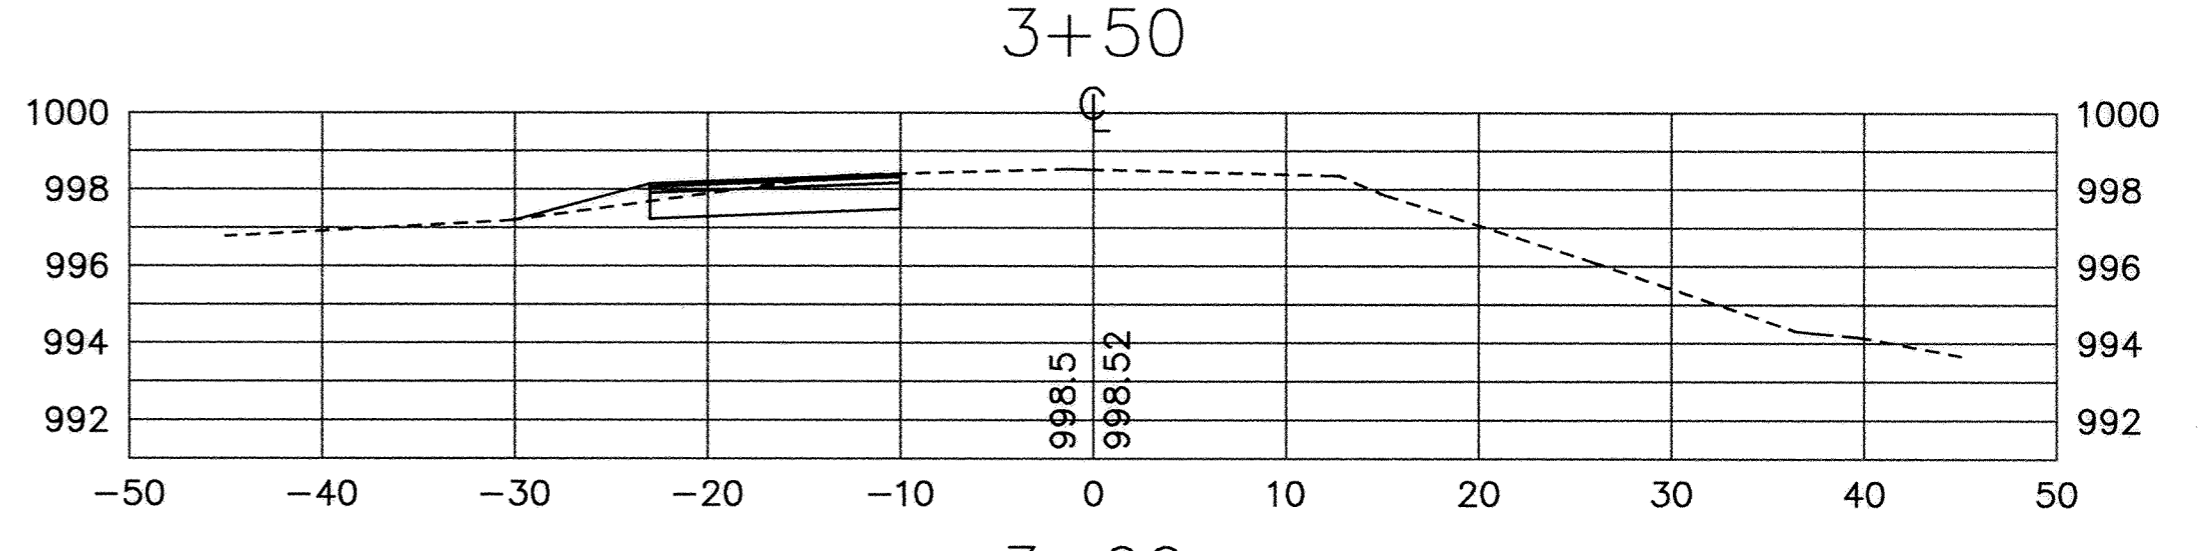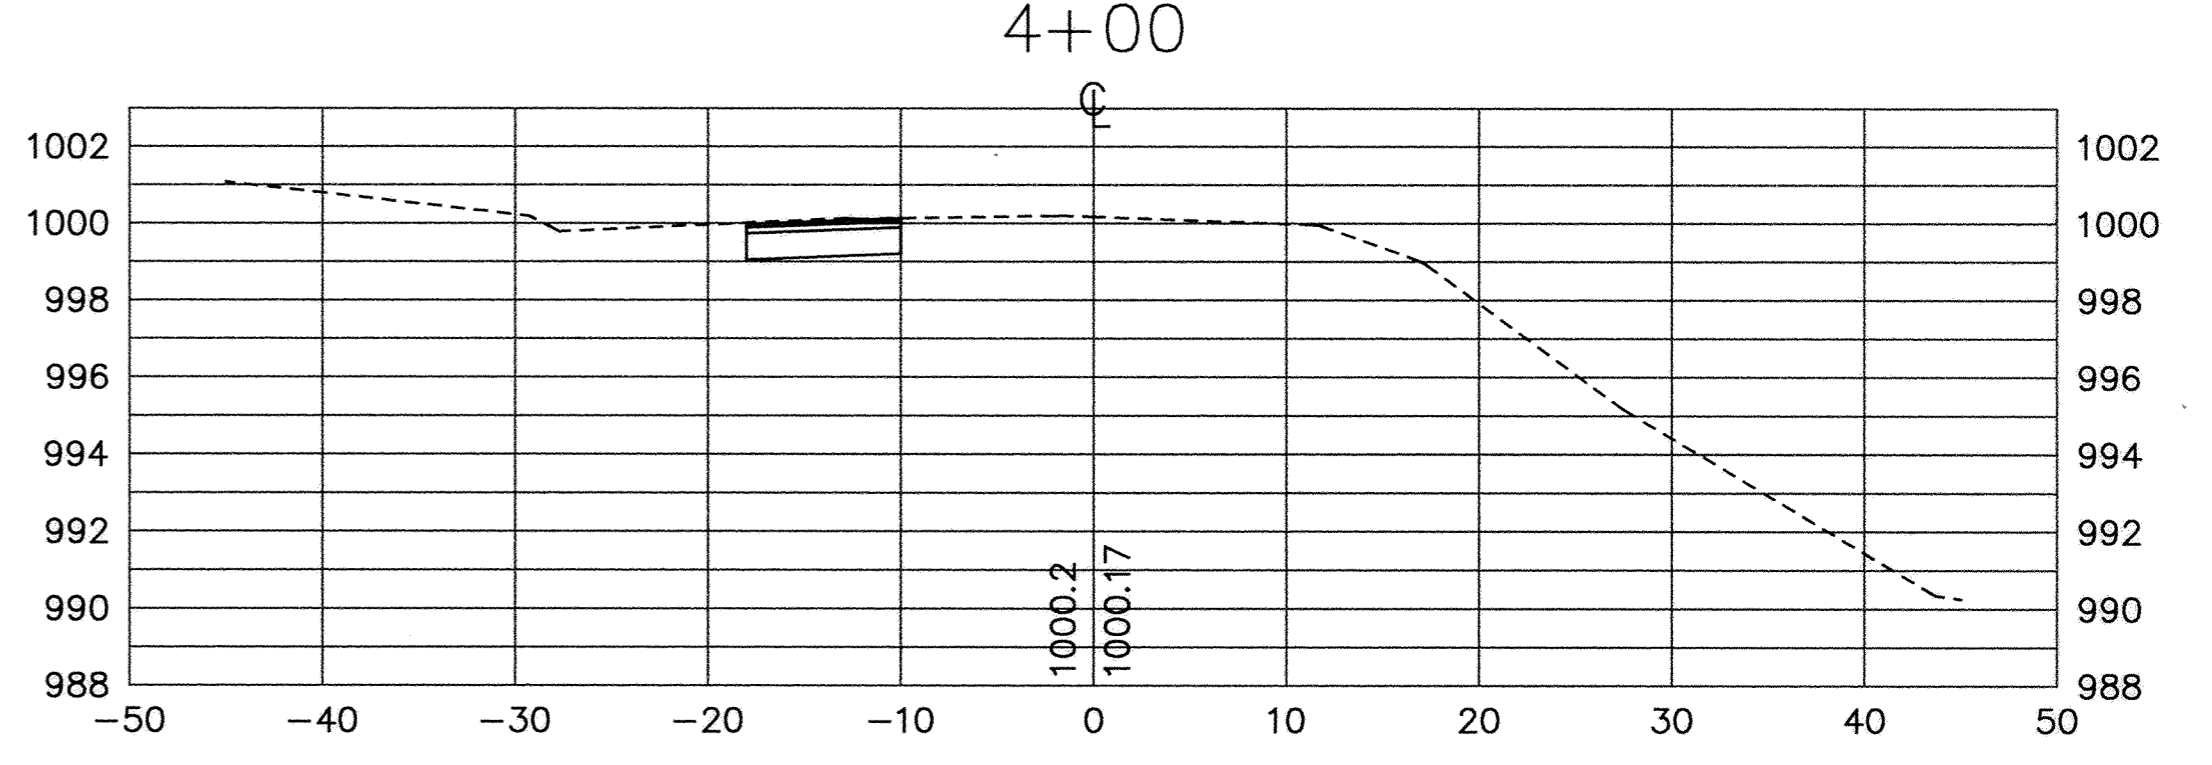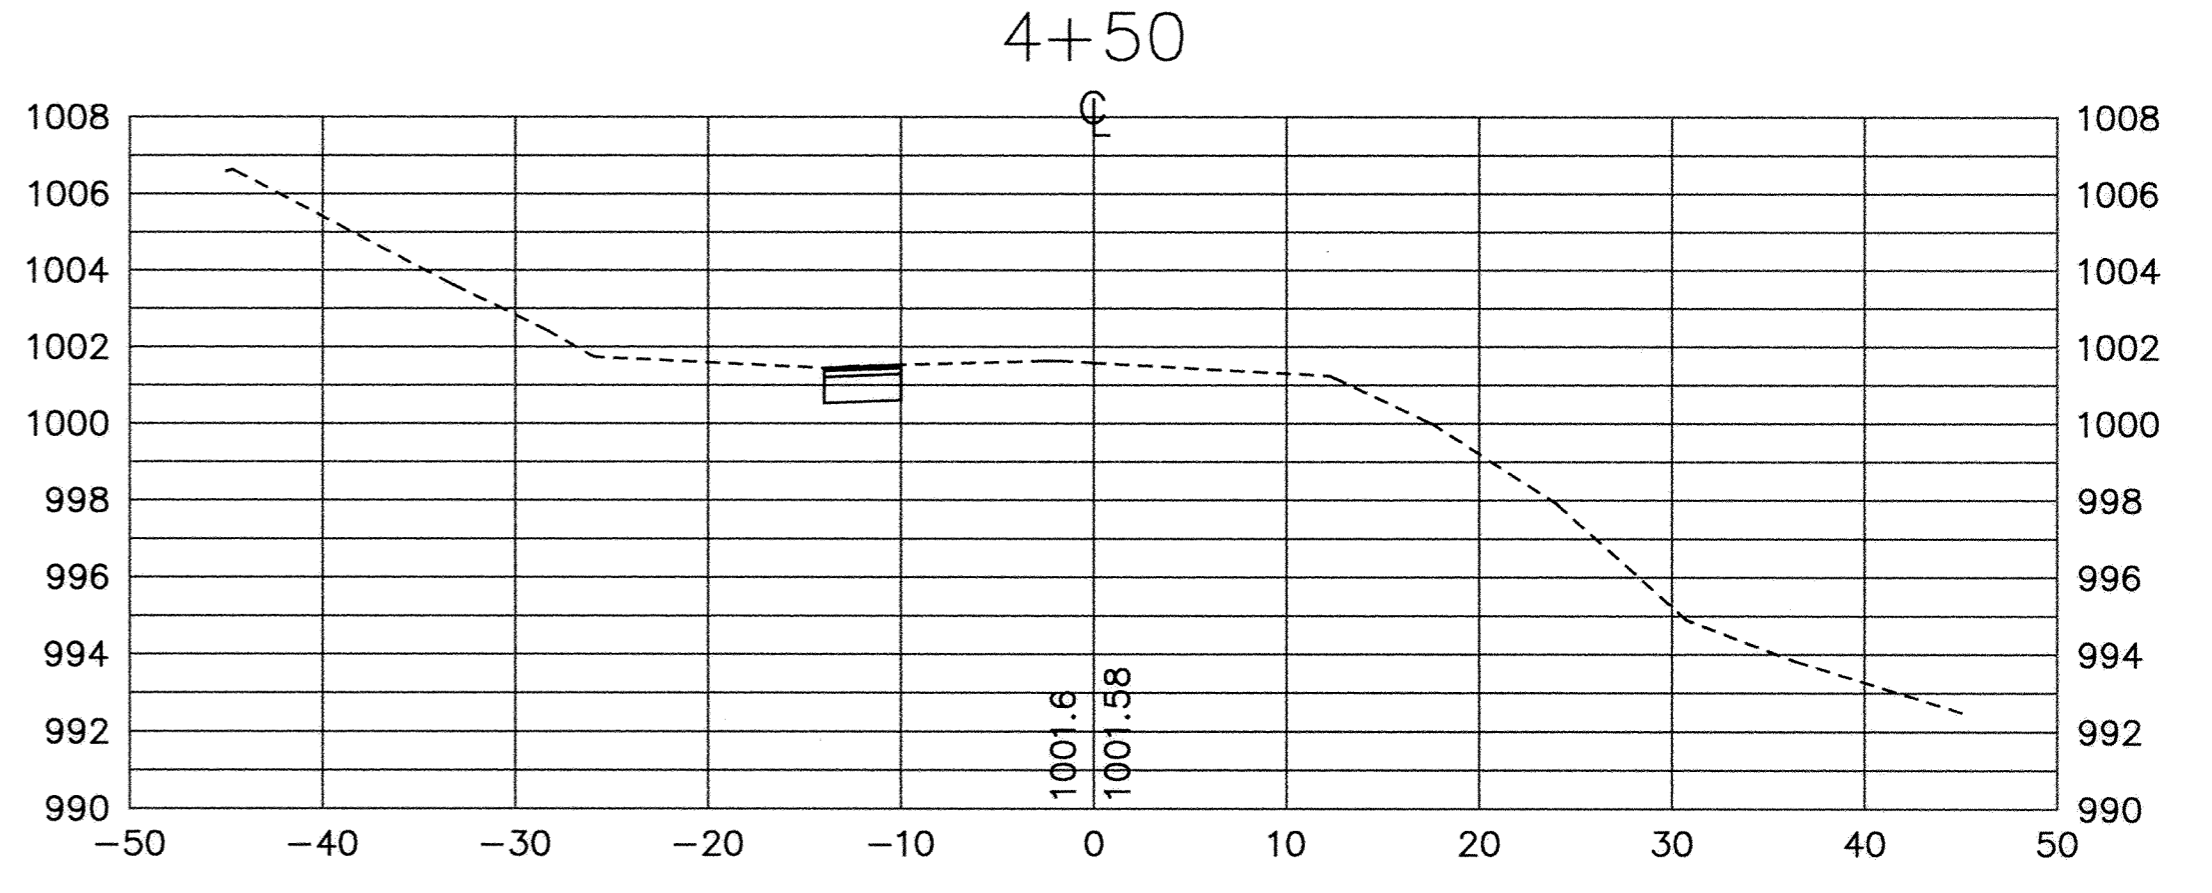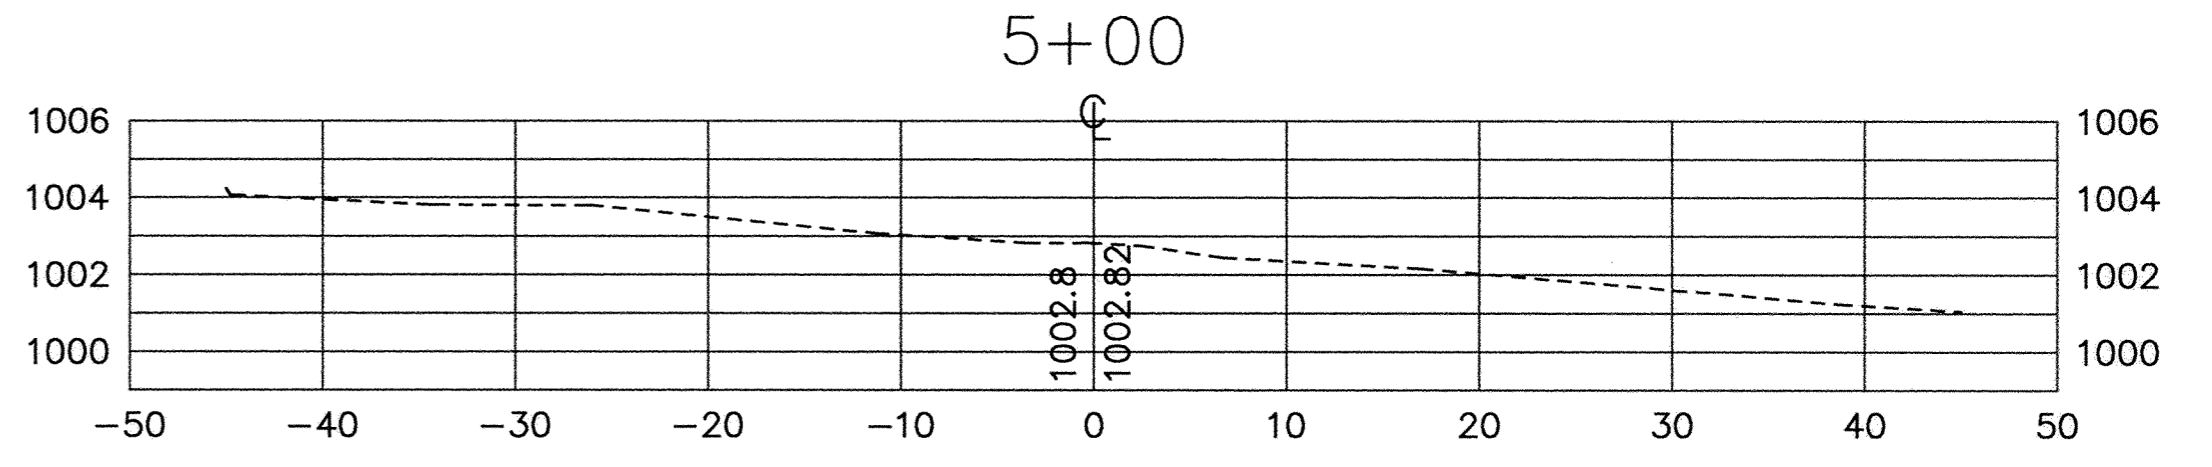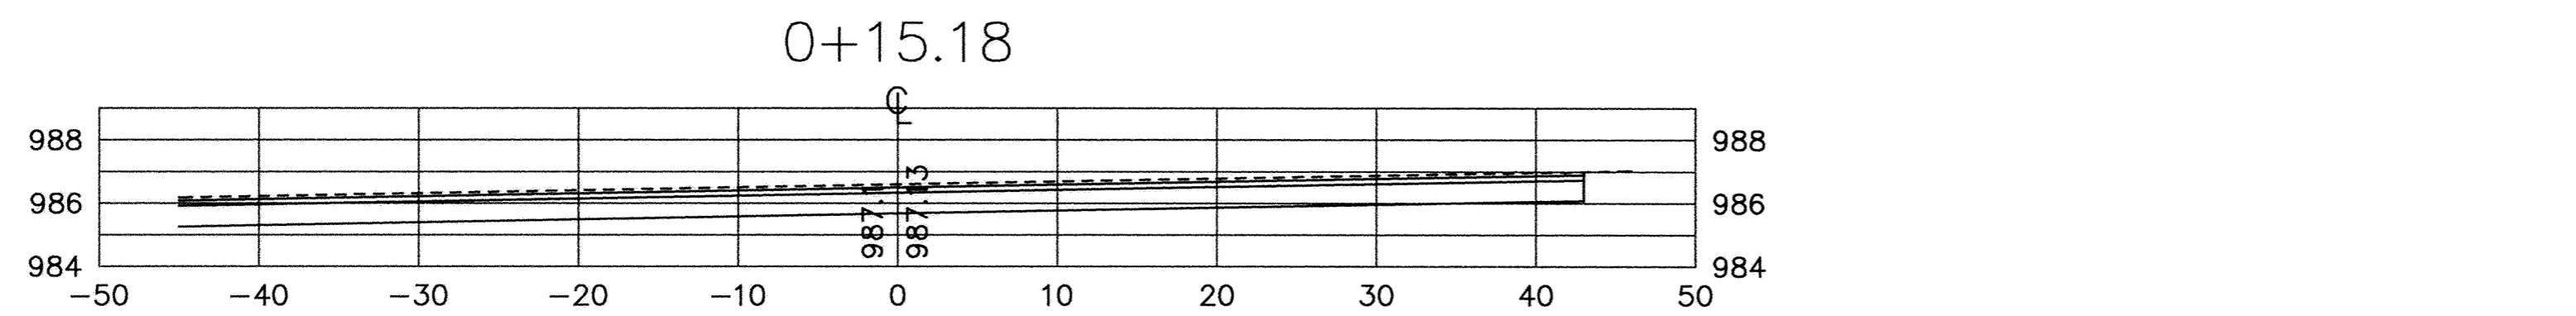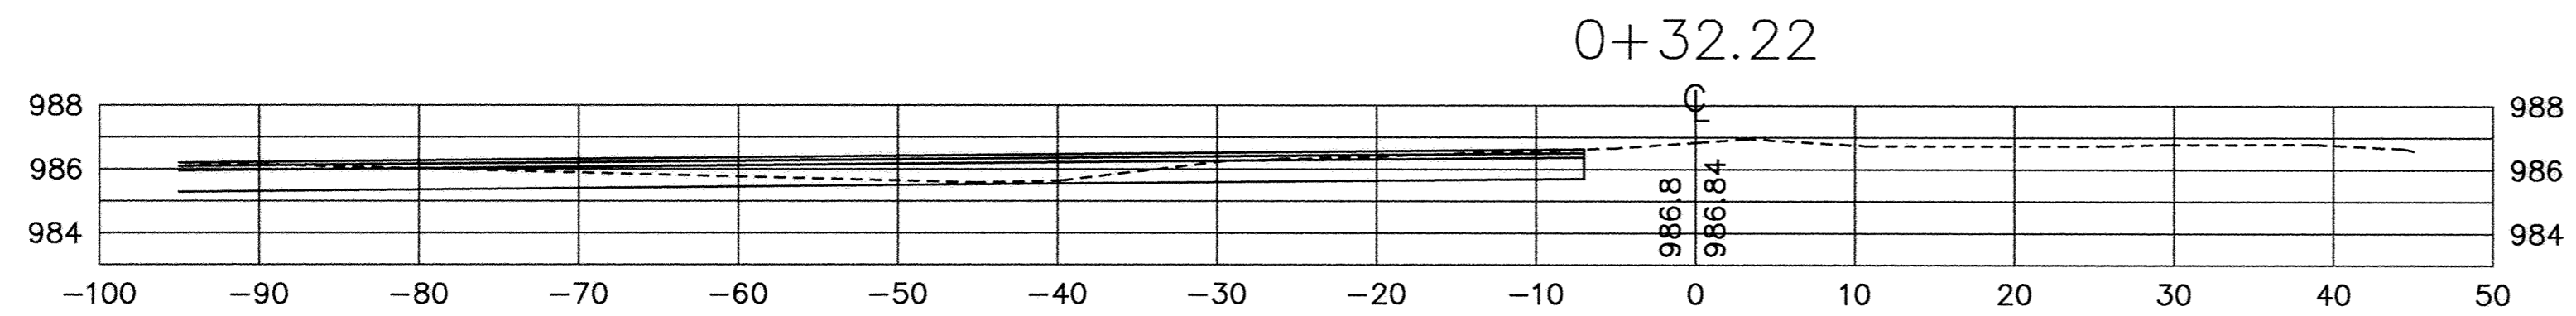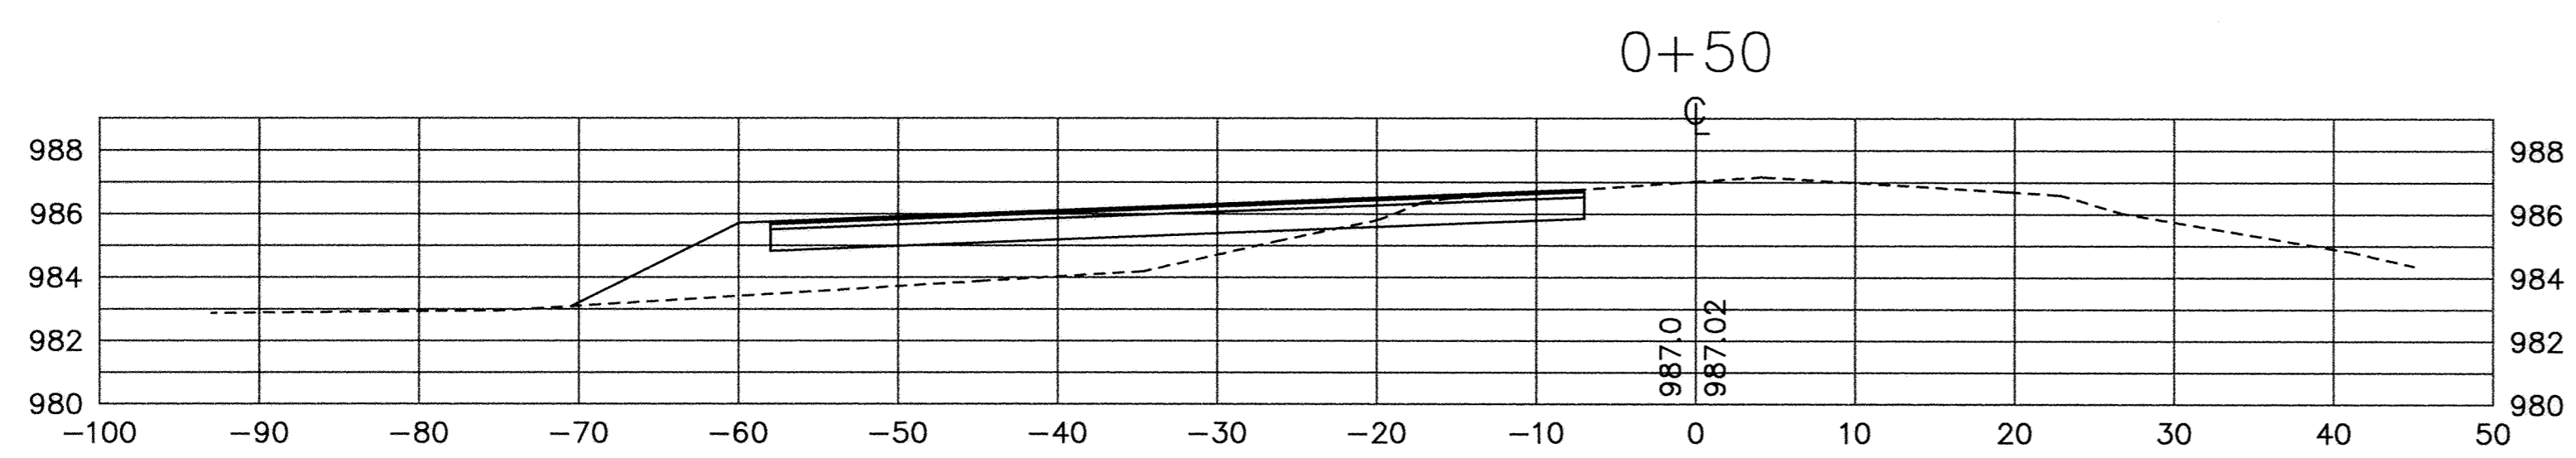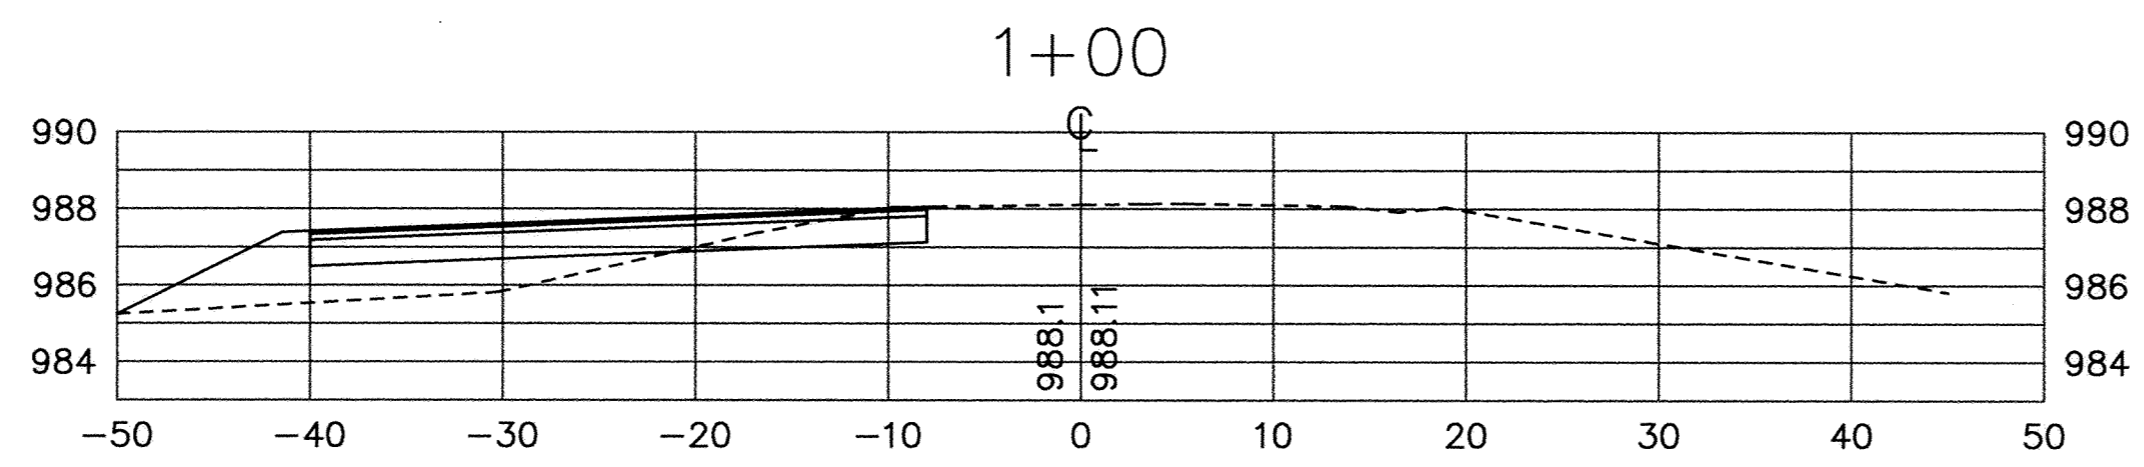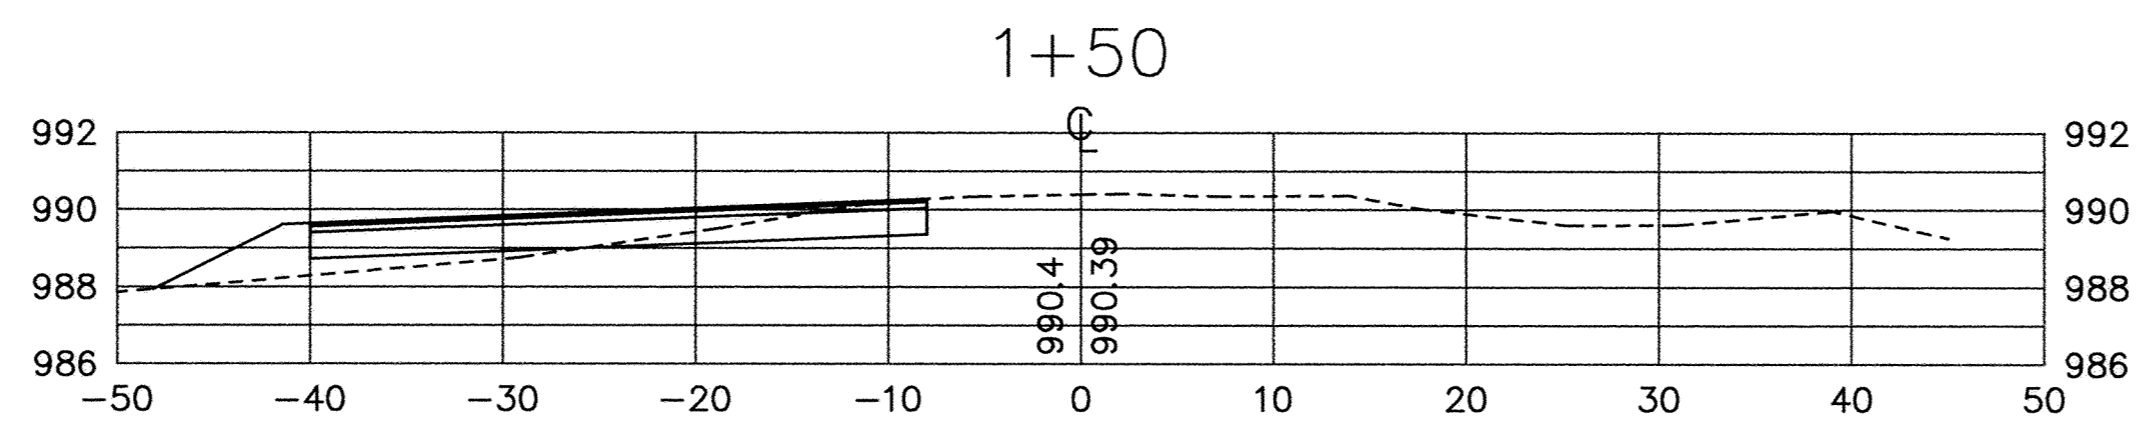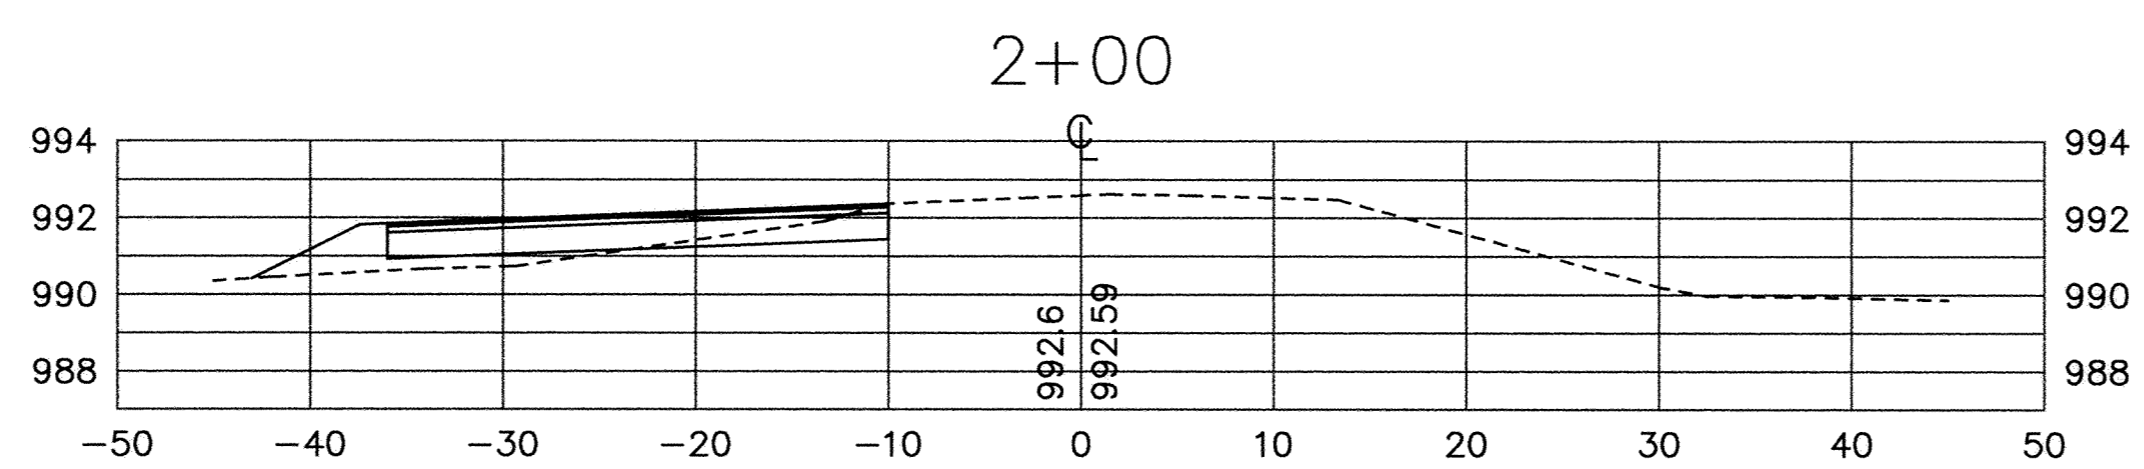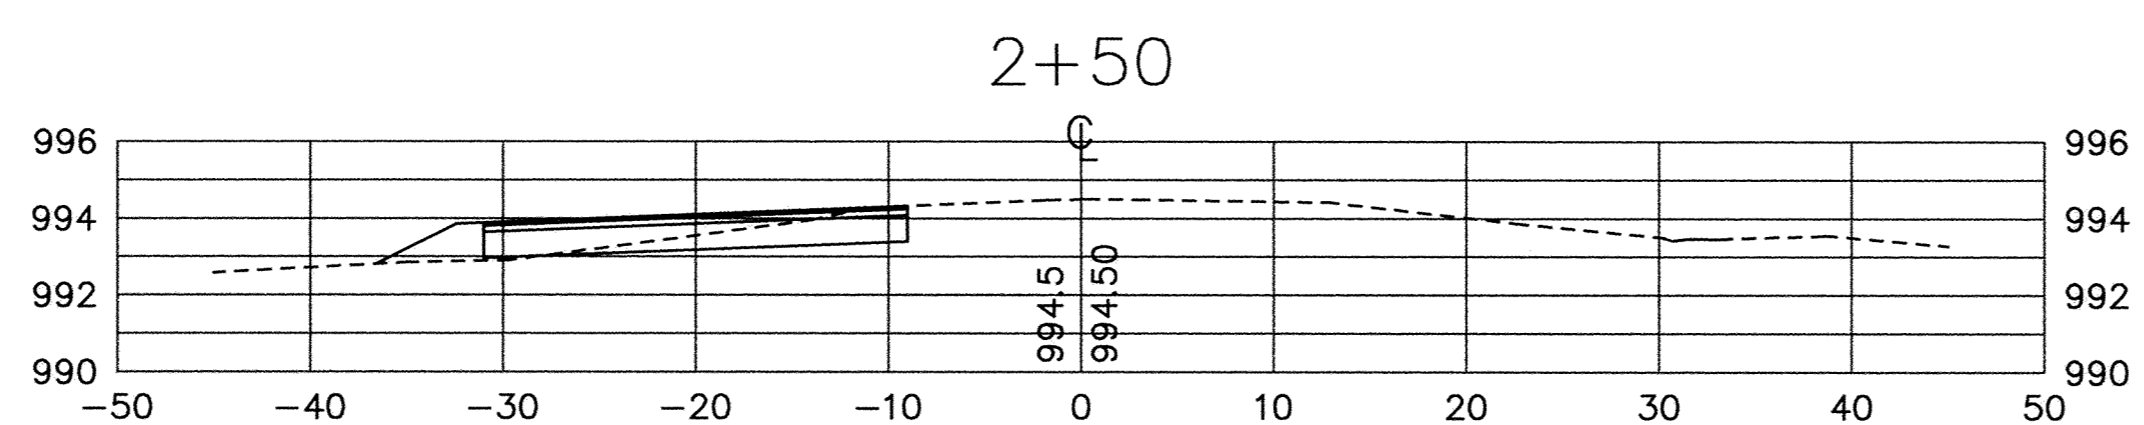

RECORD PLAN
MARCH 1997

I HEREBY CERTIFY THAT THIS PLAN, SPECIFICATION, OR REPORT WAS PREPARED BY ME OR UNDER MY DIRECT SUPERVISION AND THAT I AM A DULY REGISTERED PROFESSIONAL ENGINEER UNDER THE LAWS OF THE STATE OF MINNESOTA.

Greg M... ..
DATE 4/15/96 REG. NO. 15316



1326 ENERGY PARK DRIVE
ST. PAUL, MINNESOTA 55108
(612) 644-4389

REVISIONS	DATE	DESCRIPTION	DESIGNED	CHECKED	DRAWN
0					

GRAPHIC SCALE
0 10
0 VERT. 5

CITY OF ELK RIVER
HILLSIDE CROSSING II
STREET CONSTRUCTION
197TH AVE. EAST OF T.H. 169
CROSS SECTIONS 0+00 TO 5+00

DATE DATE SHEET 25 OF 31 SHEETS PROJECT NO. PROJECT