
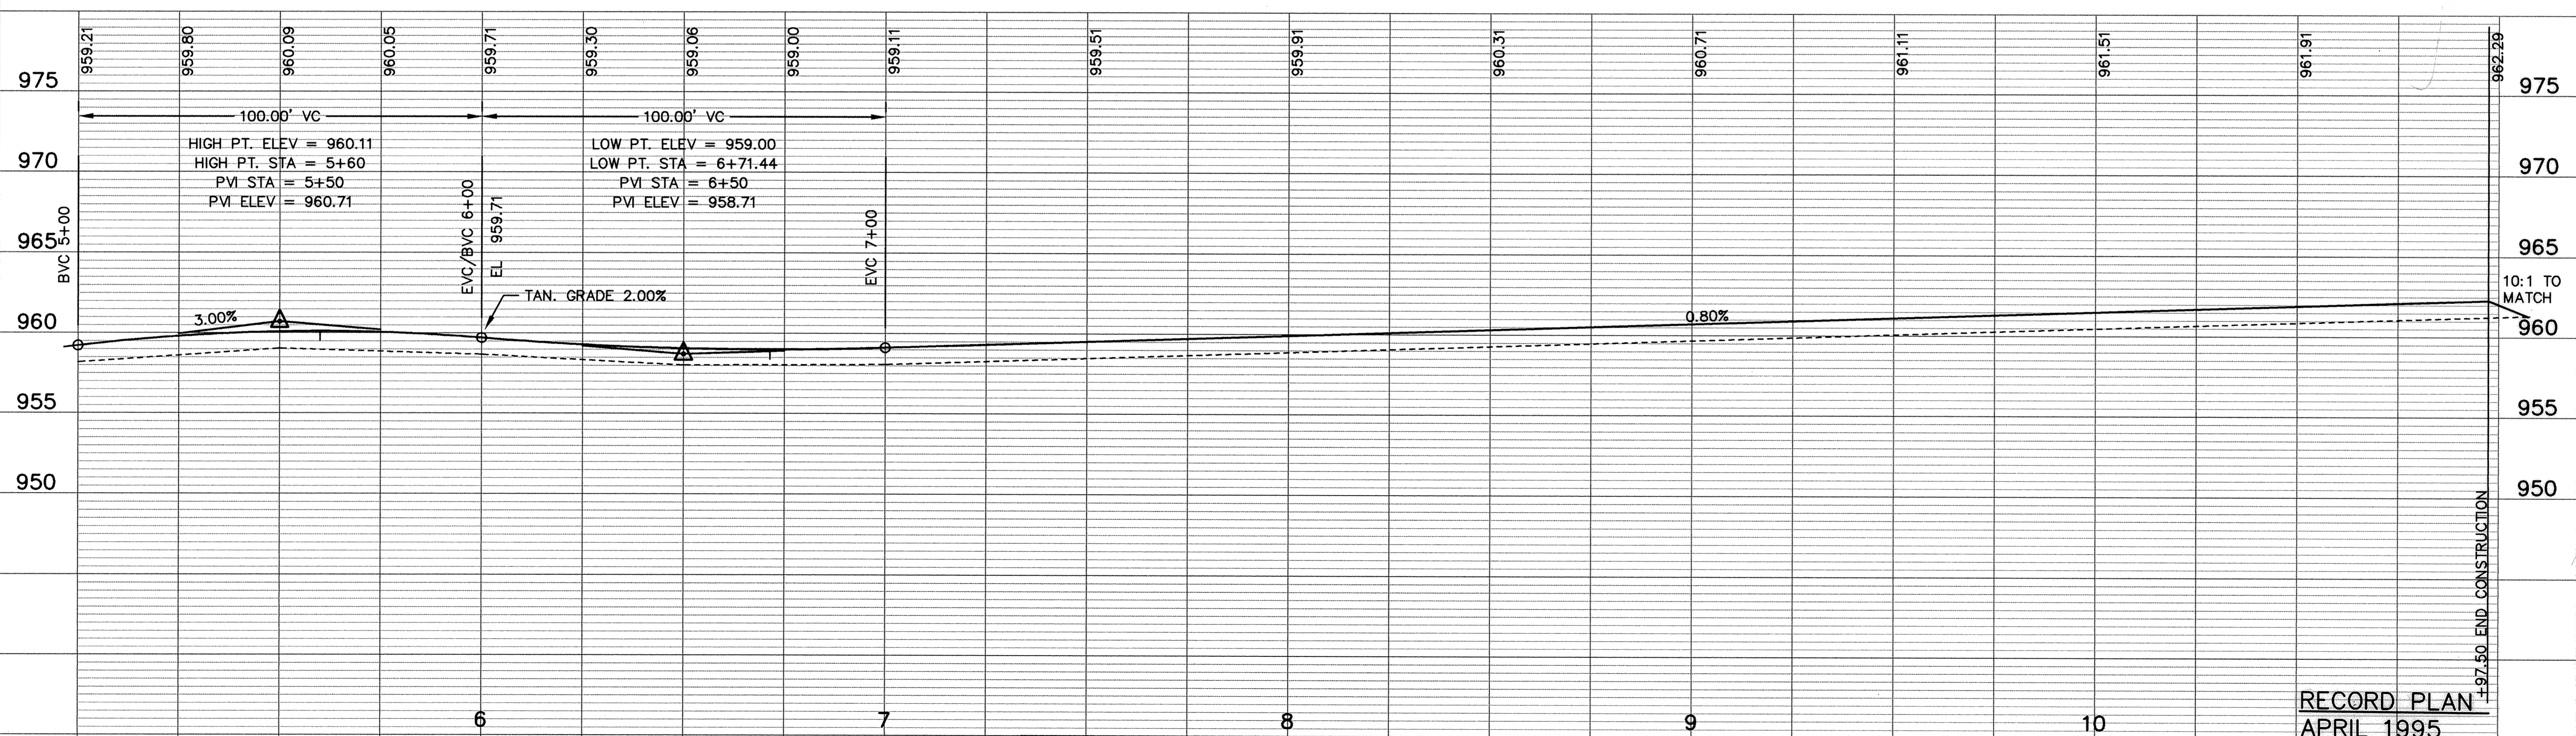


# EVANS STREET

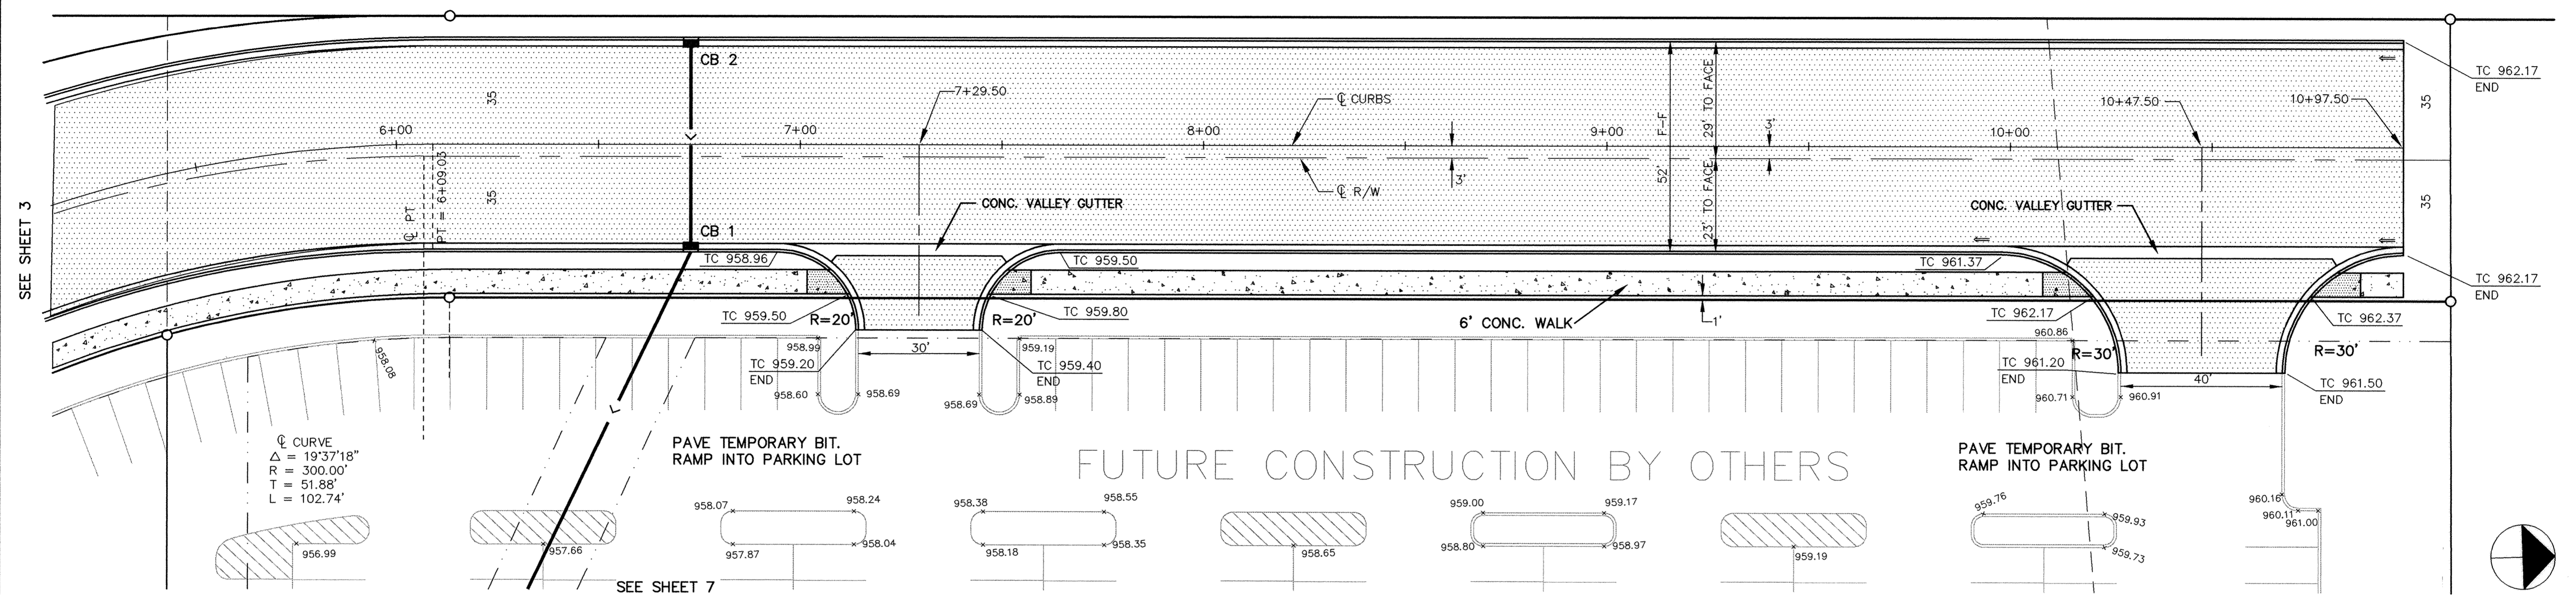

<p>1. I HEREBY CERTIFY THAT THIS PLAN, SPECIFICATION, OR REPORT WAS PREPARED BY ME OR UNDER MY DIRECT SUPERVISION AND THAT I AM A FULLY REGISTERED PROFESSIONAL ENGINEER UNDER THE LAWS OF THE STATE OF MINNESOTA.</p> <p><i>David Mauer</i> DATE: 8/9/94 REG. NO. 15316</p>		<p>1326 ENERGY PARK DRIVE ST. PAUL, MINNESOTA 55108 (612) 644-4389</p> <p>9800 SHELARD PARKWAY MINNEAPOLIS, MINNESOTA 55441 (612) 546-0432</p>	<table border="1" style="width:100%; border-collapse: collapse;"> <tr> <th>REVISIONS</th> <th>DATE</th> <th>DESCRIPTION</th> </tr> <tr> <td> </td> <td> </td> <td> </td> </tr> </table>	REVISIONS	DATE	DESCRIPTION				<table border="1" style="width:100%; border-collapse: collapse;"> <tr> <td>DESIGNED</td> <td>JL</td> </tr> <tr> <td>CHECKED</td> <td>JL</td> </tr> <tr> <td>DRAWN</td> <td>JL</td> </tr> <tr> <td colspan="2">GRAPHIC SCALES</td> </tr> <tr> <td>0</td> <td>HOR. 20'</td> </tr> <tr> <td>0</td> <td>VERT. 5'</td> </tr> </table>	DESIGNED	JL	CHECKED	JL	DRAWN	JL	GRAPHIC SCALES		0	HOR. 20'	0	VERT. 5'	<p><b>RECORD PLAN</b> APRIL 1995</p> <p>CITY OF ELK RIVER STREET CONSTRUCTION EVANS STREET</p> <p>5+50 TO 10+97.50</p>
REVISIONS	DATE	DESCRIPTION																					
DESIGNED	JL																						
CHECKED	JL																						
DRAWN	JL																						
GRAPHIC SCALES																							
0	HOR. 20'																						
0	VERT. 5'																						
<p>ER226-2</p>			<p>DATE AUG 1994 SHEET 4 OF 12 SHEETS PROJECT NO. 230-226</p>		<p>901</p>																		

DRAWING NUMBER  
 HILLSC.95  
 4  
 DRAWING NUMBER  
 901