


SAICO PRODUCTS • NEW HOPE, MINNESOTA
REPRODUCTION BY PART NUMBER 8532
SAICO PRODUCTS • NEW HOPE, MINNESOTA
REPRODUCTION BY PART NUMBER 8532
SAICO PRODUCTS • NEW HOPE, MINNESOTA
REPRODUCTION BY PART NUMBER 8532
SAICO PRODUCTS • NEW HOPE, MINNESOTA
REPRODUCTION BY PART NUMBER 8532

HILLSIDE CROSSING

PROPOSED BUILDING

N 7870.9466
E 9201.9560

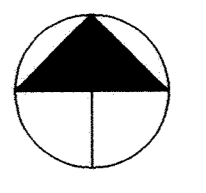

BACK=945.3

BLOCK 1

BACK=947.0

GARAGE=

949.2

MH 4

SEE SHEET 6

4+00

0+00

1+00

2+00


8" VALVE

2+30
8"-45° BEND
8"-22 1/2° BEND

3+00

SEE SHEET 9

SEE SHEET 11

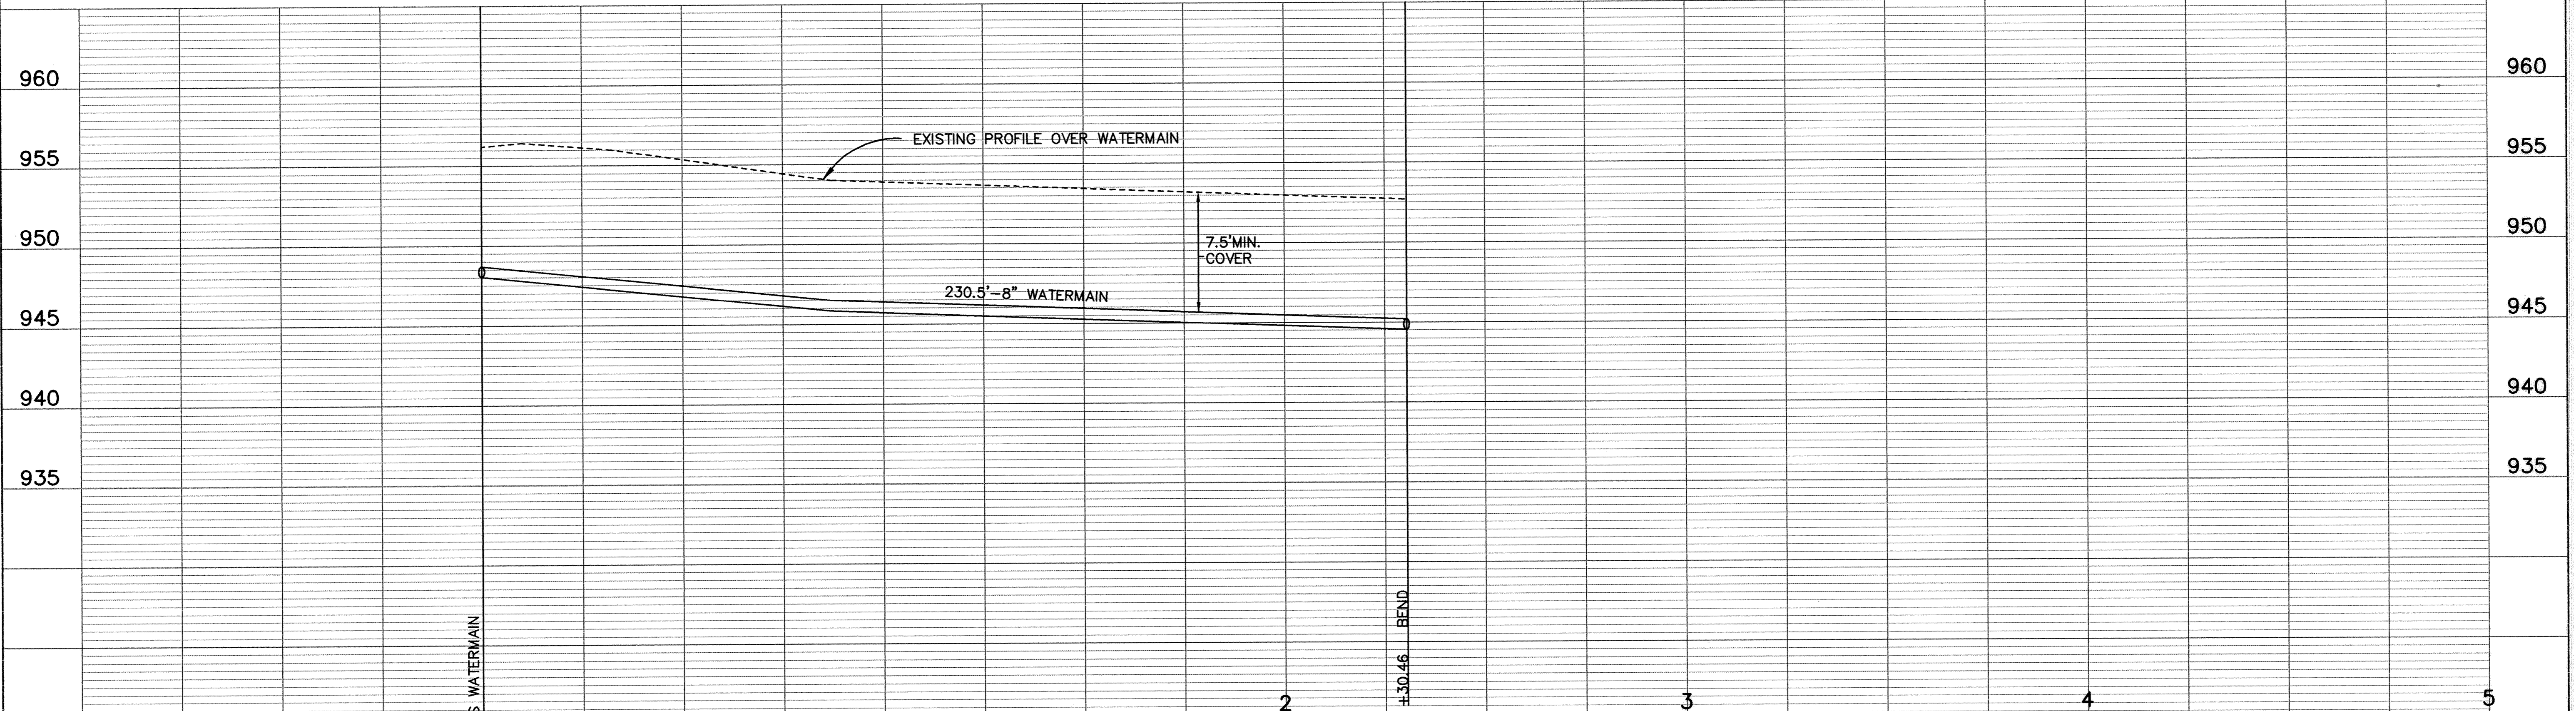

ER226-14

I HEREBY CERTIFY THAT THIS PLAN, SPECIFICATION, OR REPORT WAS PREPARED BY ME OR UNDER MY DIRECT SUPERVISION AND THAT I AM A DULY REGISTERED PROFESSIONAL ENGINEER UNDER THE LAWS OF THE STATE OF MINNESOTA.

Kevin J. Mauer
DATE 8/9/94 REG. NO. 15316



1326 ENERGY PARK DRIVE
ST. PAUL, MINNESOTA 55108
(612) 644-4389

9800 SHELARD PARKWAY
MINNEAPOLIS, MINNESOTA 55441
(612) 546-0432

DATE	DESCRIPTION	DESIGNED	CHECKED	DRAWN

REVISIONS

GRAPHIC SCALE
0 20
VERT. 5

CITY OF ELK RIVER
SANITARY SEWER, STORM SEWER AND WATERMAIN
HILLSIDE CROSSING
RECORD PLAN
APRIL 1995

DATE AUG 1994 SHEET 8 OF 12 SHEETS PROJECT NO. 230-226