


OUTLOT A

DODGE STREET

NOTES:



1. VERIFY LOCATION AND ELEVATIONS OF EXISTING UTILITIES.
 2. CONTACT "GOPHER STATE ONE CALL" FOR LOCATIONS OF BURIED UTILITIES. CALL (651) 454-0002 OR 1 (800) 252-1166.
 3. 4" P.V.C., SDR 26, SANITARY SEWER SERVICES.
 4. 1", TYPE "K" COPPER, WATER SERVICE.
 5. VALVES TO BE PLACED 3' FROM HYDRANT.
 6. HYDRANTS TO BE 8'-6" BURY.
 7. SEE SHEET U3 FOR STORM SEWER SCHEDULE

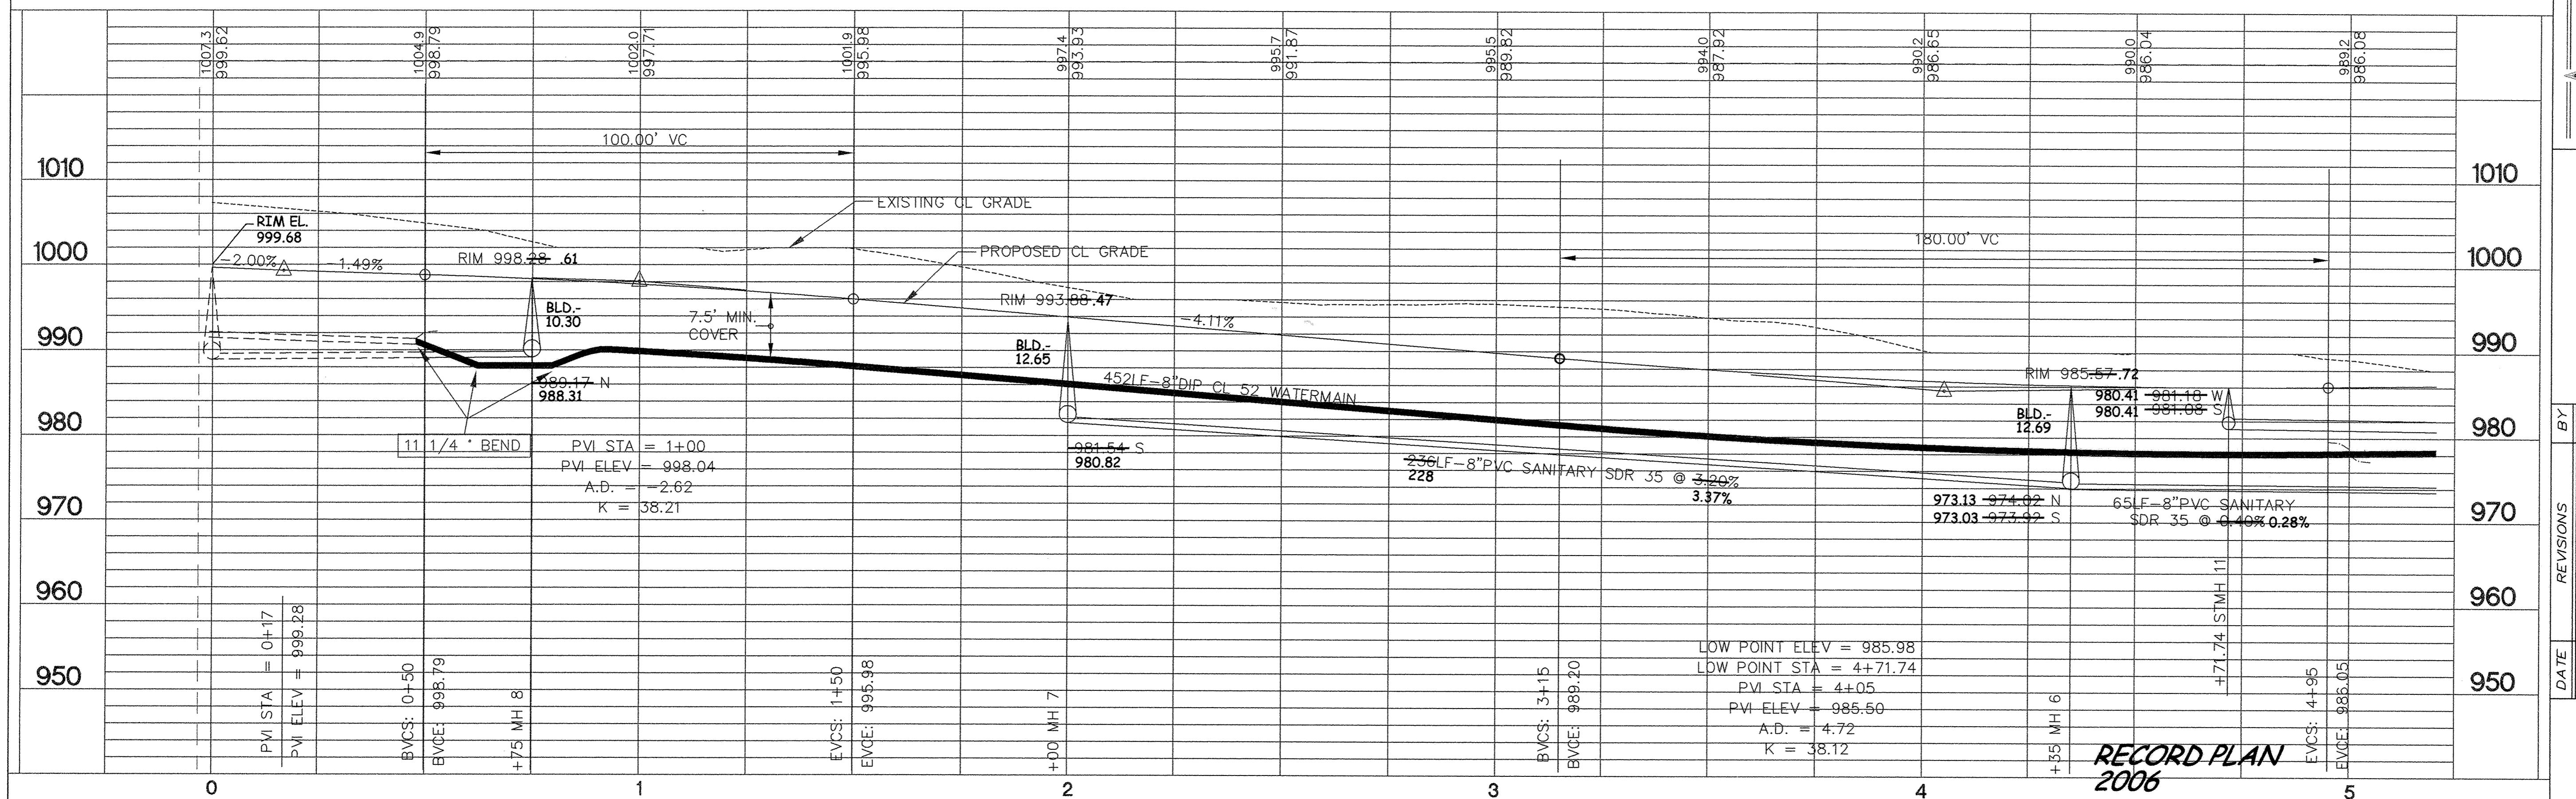

RECORD PLAN

2006

K	
DATE	12/1/02
SCALE	1" = 20'
PROJECT	R101.003
CHECKED	
APPROVED	
SANITARY SEWER, WATERMAIN, STORM SEWER AND STREET CONSTRUCTION HILLSIDE ESTATES 10TH ADDITION	
DODGE STREET	
STA. 0+00 TO 5+00	
CITY OF ELK RIVER, MINNESOTA	

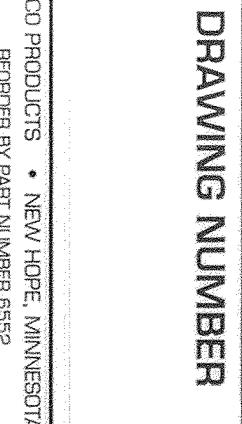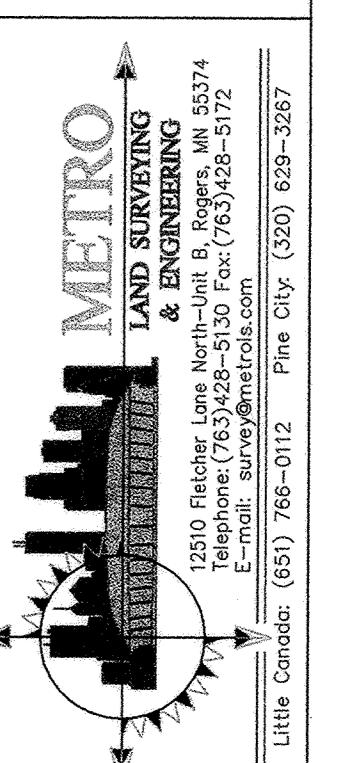

DRAWING NUMBER