

SAECO PRODUCTS • NEW HOPE, MINNESOTA
REPRODUCED BY PART NUMBER 8559
SAECO PRODUCTS • NEW HOPE, MINNESOTA
REPRODUCED BY PART NUMBER 8559
SAECO PRODUCTS • NEW HOPE, MINNESOTA
REPRODUCED BY PART NUMBER 8559
SAECO PRODUCTS • NEW HOPE, MINNESOTA
REPRODUCED BY PART NUMBER 8559



U.S. HIGHWAY NO. 169


COMMERCIAL
PHASE

HILLSIDE
ESTATES



FUTURE
DEVELOPMENT

193RD AVENUE N.W.
LIFT STATION
(SHT. 13-15)

- NOTES:
1. INSTALL SEWER AND WATER SERVICES TO VACANT LOTS. LOCATION TO BE DETERMINED AT TIME OF CONSTRUCTION.
 2. ALL STREET RADII SHALL BE 20' UNLESS NOTED OTHERWISE.
 3. ALL STATIONING REFERS TO CENTERLINE OF R.O.W.
 4. SEED BOULEVARD TO RIGHT-OF-WAY AS DIRECTED BY THE ENGINEER.

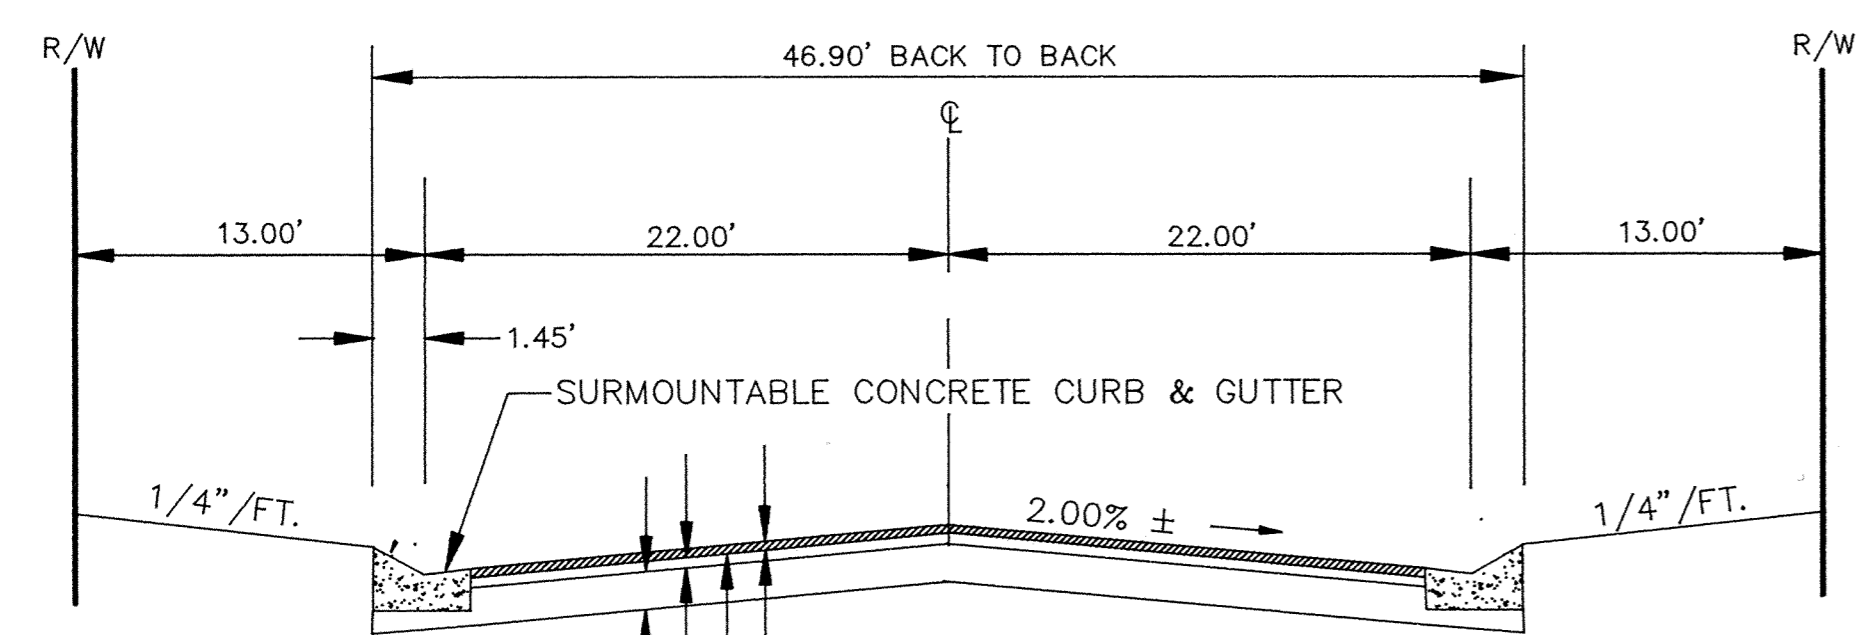

TYPICAL STREET SECTION
(70' R.O.W.)
193RD AVENUE N.W.

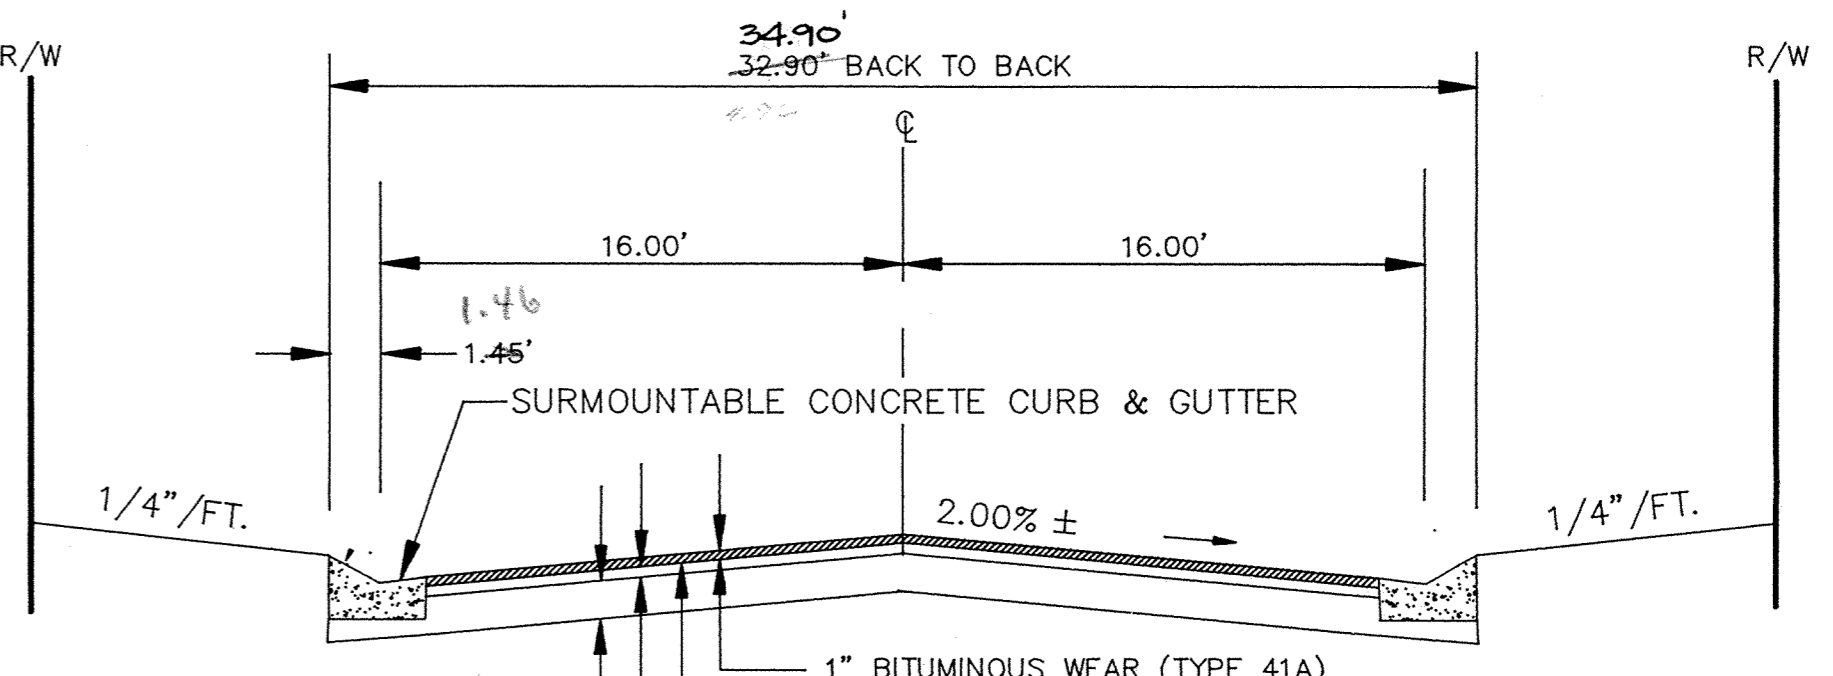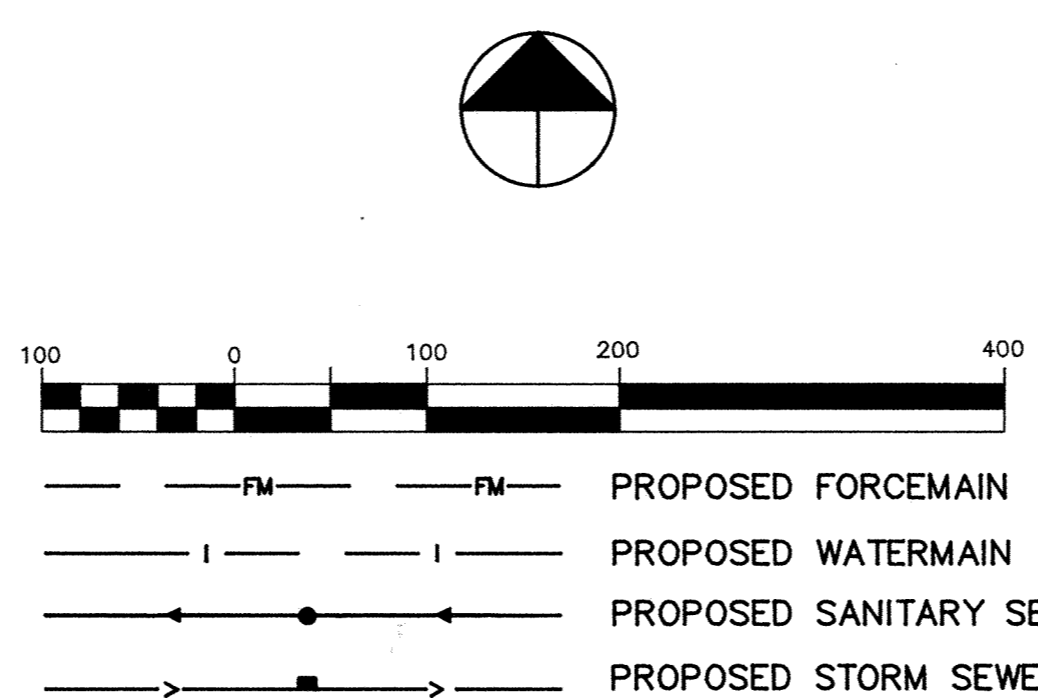

TYPICAL STREET SECTION
(60' R.O.W.)
DODGE STREET N.W.
CARSON CIRCLE N.W.
BALDWIN STREET N.W.
192ND AVENUE N.W.

RECORD PLAN
JUNE, 1993

I HEREBY CERTIFY THAT THIS PLAN, SPECIFICATION, OR REPORT WAS PREPARED BY ME OR UNDER MY DIRECT SUPERVISION AND THAT I AM A DULY REGISTERED PROFESSIONAL ENGINEER UNDER THE LAWS OF THE STATE OF MINNESOTA.

Lenny J. Mauser
DATE 6/8/92 REG. NO. 15316



CONSULTING ENGINEERS
Maier Stewart & Associates Inc.
9800 SHELARD PARKWAY (612) 546-0432 MINNEAPOLIS, MINNESOTA 55441
1959 SLOAN PLACE (612) 774-6021 ST. PAUL, MINNESOTA 55117

DATE	DESCRIPTION	DESIGNED	CHECKED

REVISIONS

CITY OF ELK RIVER LOCATION MAP HILLSIDE ESTATES	
DATE JUNE, 1992	SHEET 2 OF 19 SHEETS PROJECT NO. 230-140